

**HISTORY OF CONSTRUCTION FOR EXISTING CCR SURFACE IMPOUNDMENT  
PLANT YATES ASH POND B' (AP-B')  
40 CFR 257.73(c)(1)(i)-(xii)**

***(i) Site Name and Ownership Information:***

Site Name: Eugene A. Yates Power Plant

Site Location: Newnan, Georgia

Site Address: 708 Dyer Road  
Newnan, GA 30263

Owner: Georgia Power Company

Address: 241 Ralph McGill Boulevard  
Atlanta, GA 30308

CCR Impoundment Name: Plant Yates Ash Pond B' (AP-B')

NID ID: NA

EPA's "Disposal of Coal Combustion Residuals from Electric Utilities" Final Rule (40 C.F.R. Part 257 and Part 261), §257.73(c)(1), requires the owner or operator of an existing CCR surface impoundment to compile a history of construction. To the extent feasible, the following information is provided:

***(ii) Location of CCR Unit:***

33.455884, -84.890724

See Location Map in the Appendix

***(iii) Purpose of CCR Impoundment:***

The Eugene A. Yates Power Plant (Plant Yates) was once a seven unit, coal fired, power generation facility. Currently Plant Yates Units 1-5 are in the process of demolition and Plant Yates Units 6 and 7 have been converted to natural gas. AP-B' was designed to receive and store coal combustion residuals produced during the electric power generating process at Plant Yates. In 1977, the southern portion of AP-B' began to be used as an ash dewatering facility for coal combustion residuals dredged from Ash Pond 2. Plant Yates ceased burning coal in 2015 and thus ceased using AP-B' for purposes of coal combustion residuals dewatering at that time.

***(iv) Watershed Description:***

Plant Yates and AP-B' are located within the Acorn Creek-Chattahoochee River HUC 12 watershed which has a total area of 28,284 acres. The Acorn Creek-Chattahoochee River watershed is part of the larger Middle Chattahoochee-Lake Harding HUC 8 watershed which has an area of 1,950,182 acres. The inflow for AP-B' consists solely of the rainfall that falls within the limits of the surface impoundment.

**(v) Description of physical and engineering properties of CCR unit foundation/abutments:** AP-B' is located in the Piedmont Physiographic Province of Georgia. The Piedmont is characterized by igneous and metamorphic rocks. According to the *Geologic Map of Georgia, 1976*, Plant Yates is located in an Undifferentiated Granite formation of the Piedmont. The residual soils in the Piedmont are a result of weathering of the underlying bedrock. Piedmont residual soils and alluvial soils (due to its proximity to the Chattahoochee River) are present within the footprint of AP-B'. The alluvial soils consist of firm to very stiff silts and clays which were underlain by partially weathered rock and residual soils. The residual soils consist mainly of silty sands.

Foundation material of AP-B' generally consists of residual soils with alluvial zones below the fill. The alluvial zone is made up of two to three feet of silty sands with some gravel. The residual zone beneath the alluvium ranged from 4 to 39 feet and consists primarily of silty sands at depth with surface zones of sandy silts with some clay content in the higher elevations. Beneath the residual zone, there is a layer of partially weathered rock.

**(vi) Summary of Site Preparation and Construction Activities:**

AP-B' was constructed in 1976 by AMAX Fly Ash Corporation, who was at the time providing coal ash handling services at Plant Yates. Professional engineers with Lawrence Dabney & Associates designed the pond, which was constructed with a top elevation of 770 ft, a total storage volume of 480,000 cubic yards and a surface area of 29.8 acres. The dam elevation was raised to elevation 780 ft during the summer of 1977. Further construction occurred during October of 1977, when the pond was subdivided to create areas for ash dewatering. During the 1977 construction, soft embankment soils were undercut and replaced with clayey soils compacted to 95% of the standard Proctor maximum dry density. The geotechnical reports for this work are included in Appendix B.

Starting in 1978, ash dewatered in AP-B' was stored in the adjacent R6 Solid Waste Facility. As part of the 1977 embankment augmentation, a diversion channel was constructed to receive flow from storm culverts north of the pond and to route this flow around the perimeter of AP-B'. At this time, the auxiliary overflow spillway was also constructed. The embankments were raised at a later date to EL 784 ft.

**(vii) Engineering Diagrams:**


The following engineering diagrams and drawings relevant to the construction, location and topography of AP-B' can be found in the Appendix:

- 1977 Topographic Site Plans, B' Pond Modifications
- 1978 AP-B' dry storage area location and road layout
- 1987 Pond B' Typical Section
- 1987 Ash Handling General Plan
- 1995 Compilation Drawing of Ash Impoundments

**(viii) Description of Instrumentation:**

There are three piezometers located within the vicinity of AP-B' which are used to monitor water levels around the impoundment.

**(ix) Area-capacity curves:**

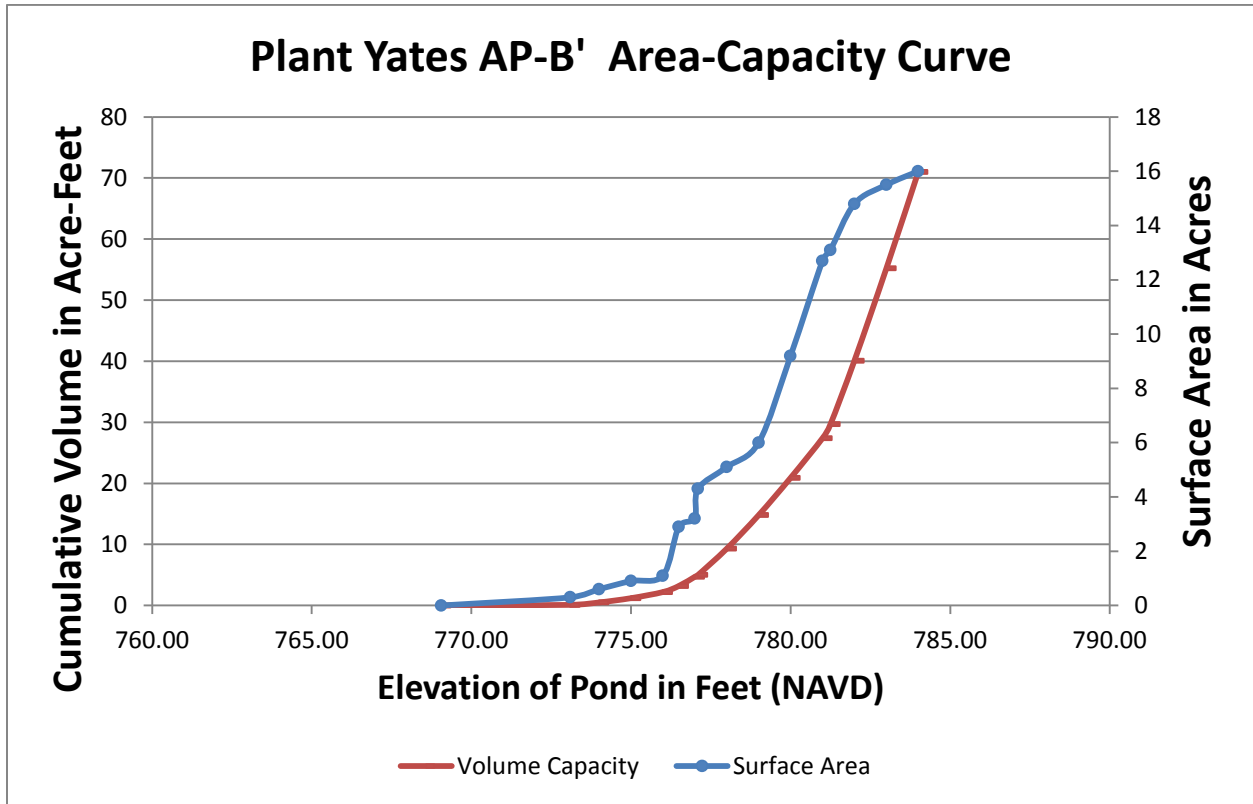

**(x) Spillway/Diversion design features and capacity calculations:**

Surface water runoff is transported from AP-B' via two primary spillways that discharge into Ash Pond 3 via open channel flow. The pond is divided into a north and a south cell, each having a primary spillway. The north cell spillway is a 24-in diameter CMP culvert with an upstream invert elevation of 773.49 ft and a downstream invert elevation of 772.99 ft. The south cell spillway is a 36-in diameter CMP culvert with an upstream invert elevation of 769.06 ft and a downstream invert elevation of 768.24 ft. The auxiliary spillway for AP-B' consists of an open-channel trapezoidal ditch having a control section width of 70 feet. The crest of the auxiliary spillway is at an elevation of 783.07 ft. During the 100-year design storm, the maximum elevation in the pond is 776.5 ft. At this elevation, the north cell principal spillway carries approximately 14 cubic feet per second (cfs). At the same elevation the south cell principal spillway carries approximately 69 cfs. At an overtopping elevation of 780 ft, the north spillway carries 38 cfs, the south spillway carries 102 cfs, and the auxiliary spillway carries 176 cfs.


***(xi) Provisions for surveillance, maintenance and repair:***

Inspections of dikes are critical components and are conducted on a regular basis – at least annually by professional dam safety engineers and at least weekly by trained plant personnel. In addition, inspections are performed after periods of heavy rainfall and storms. The inspections provide assurance that structures are sound and that action is taken, as needed, based on the findings. Weekly safety inspections include numerous items including pond levels, weather conditions and rainfall since the prior inspection, conditions of slopes and drains, erosion, animal damage, ant hills, alignment of retaining structures and more. During annual inspections, dam safety engineers assess instrument readings, inspect any maintenance or remediation performed since the previous inspection, check the status of work recommended at prior inspections, ensure that the posting of emergency notification information is up to date and evaluate any items noted during plant personnel inspections.

***(xii) Known record of structural instability:***

There are no known instances of structural instability at the CCR unit.

## Appendix

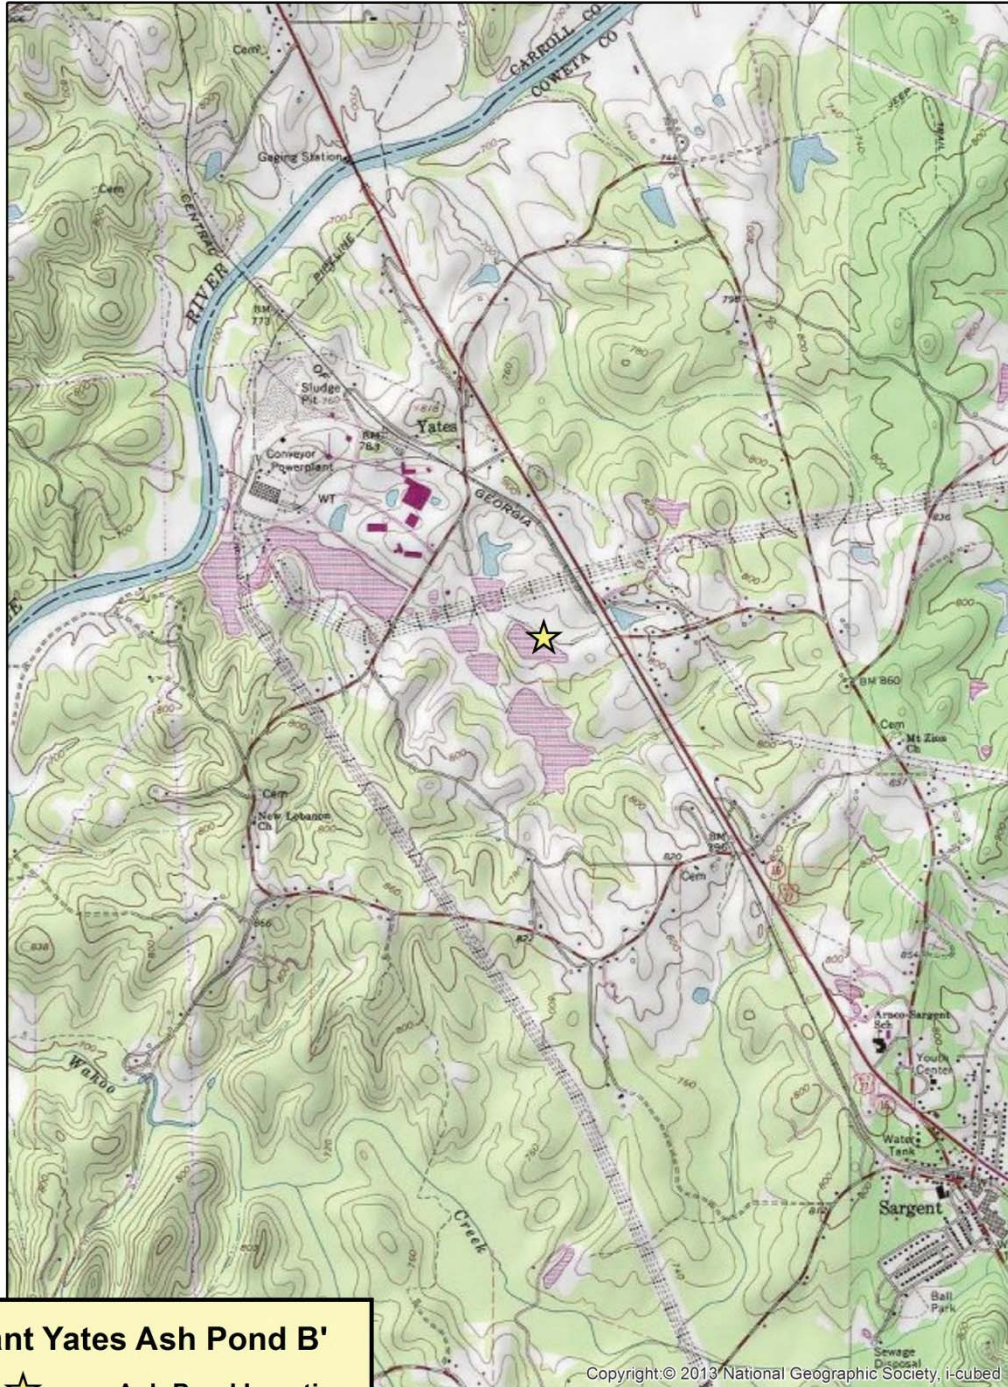


**Plant Yates Ash Pond B'**

N ☆ Ash Pond Location  
USA Topo Maps

Copyright © 2013 National Geographic Society, i-cubed



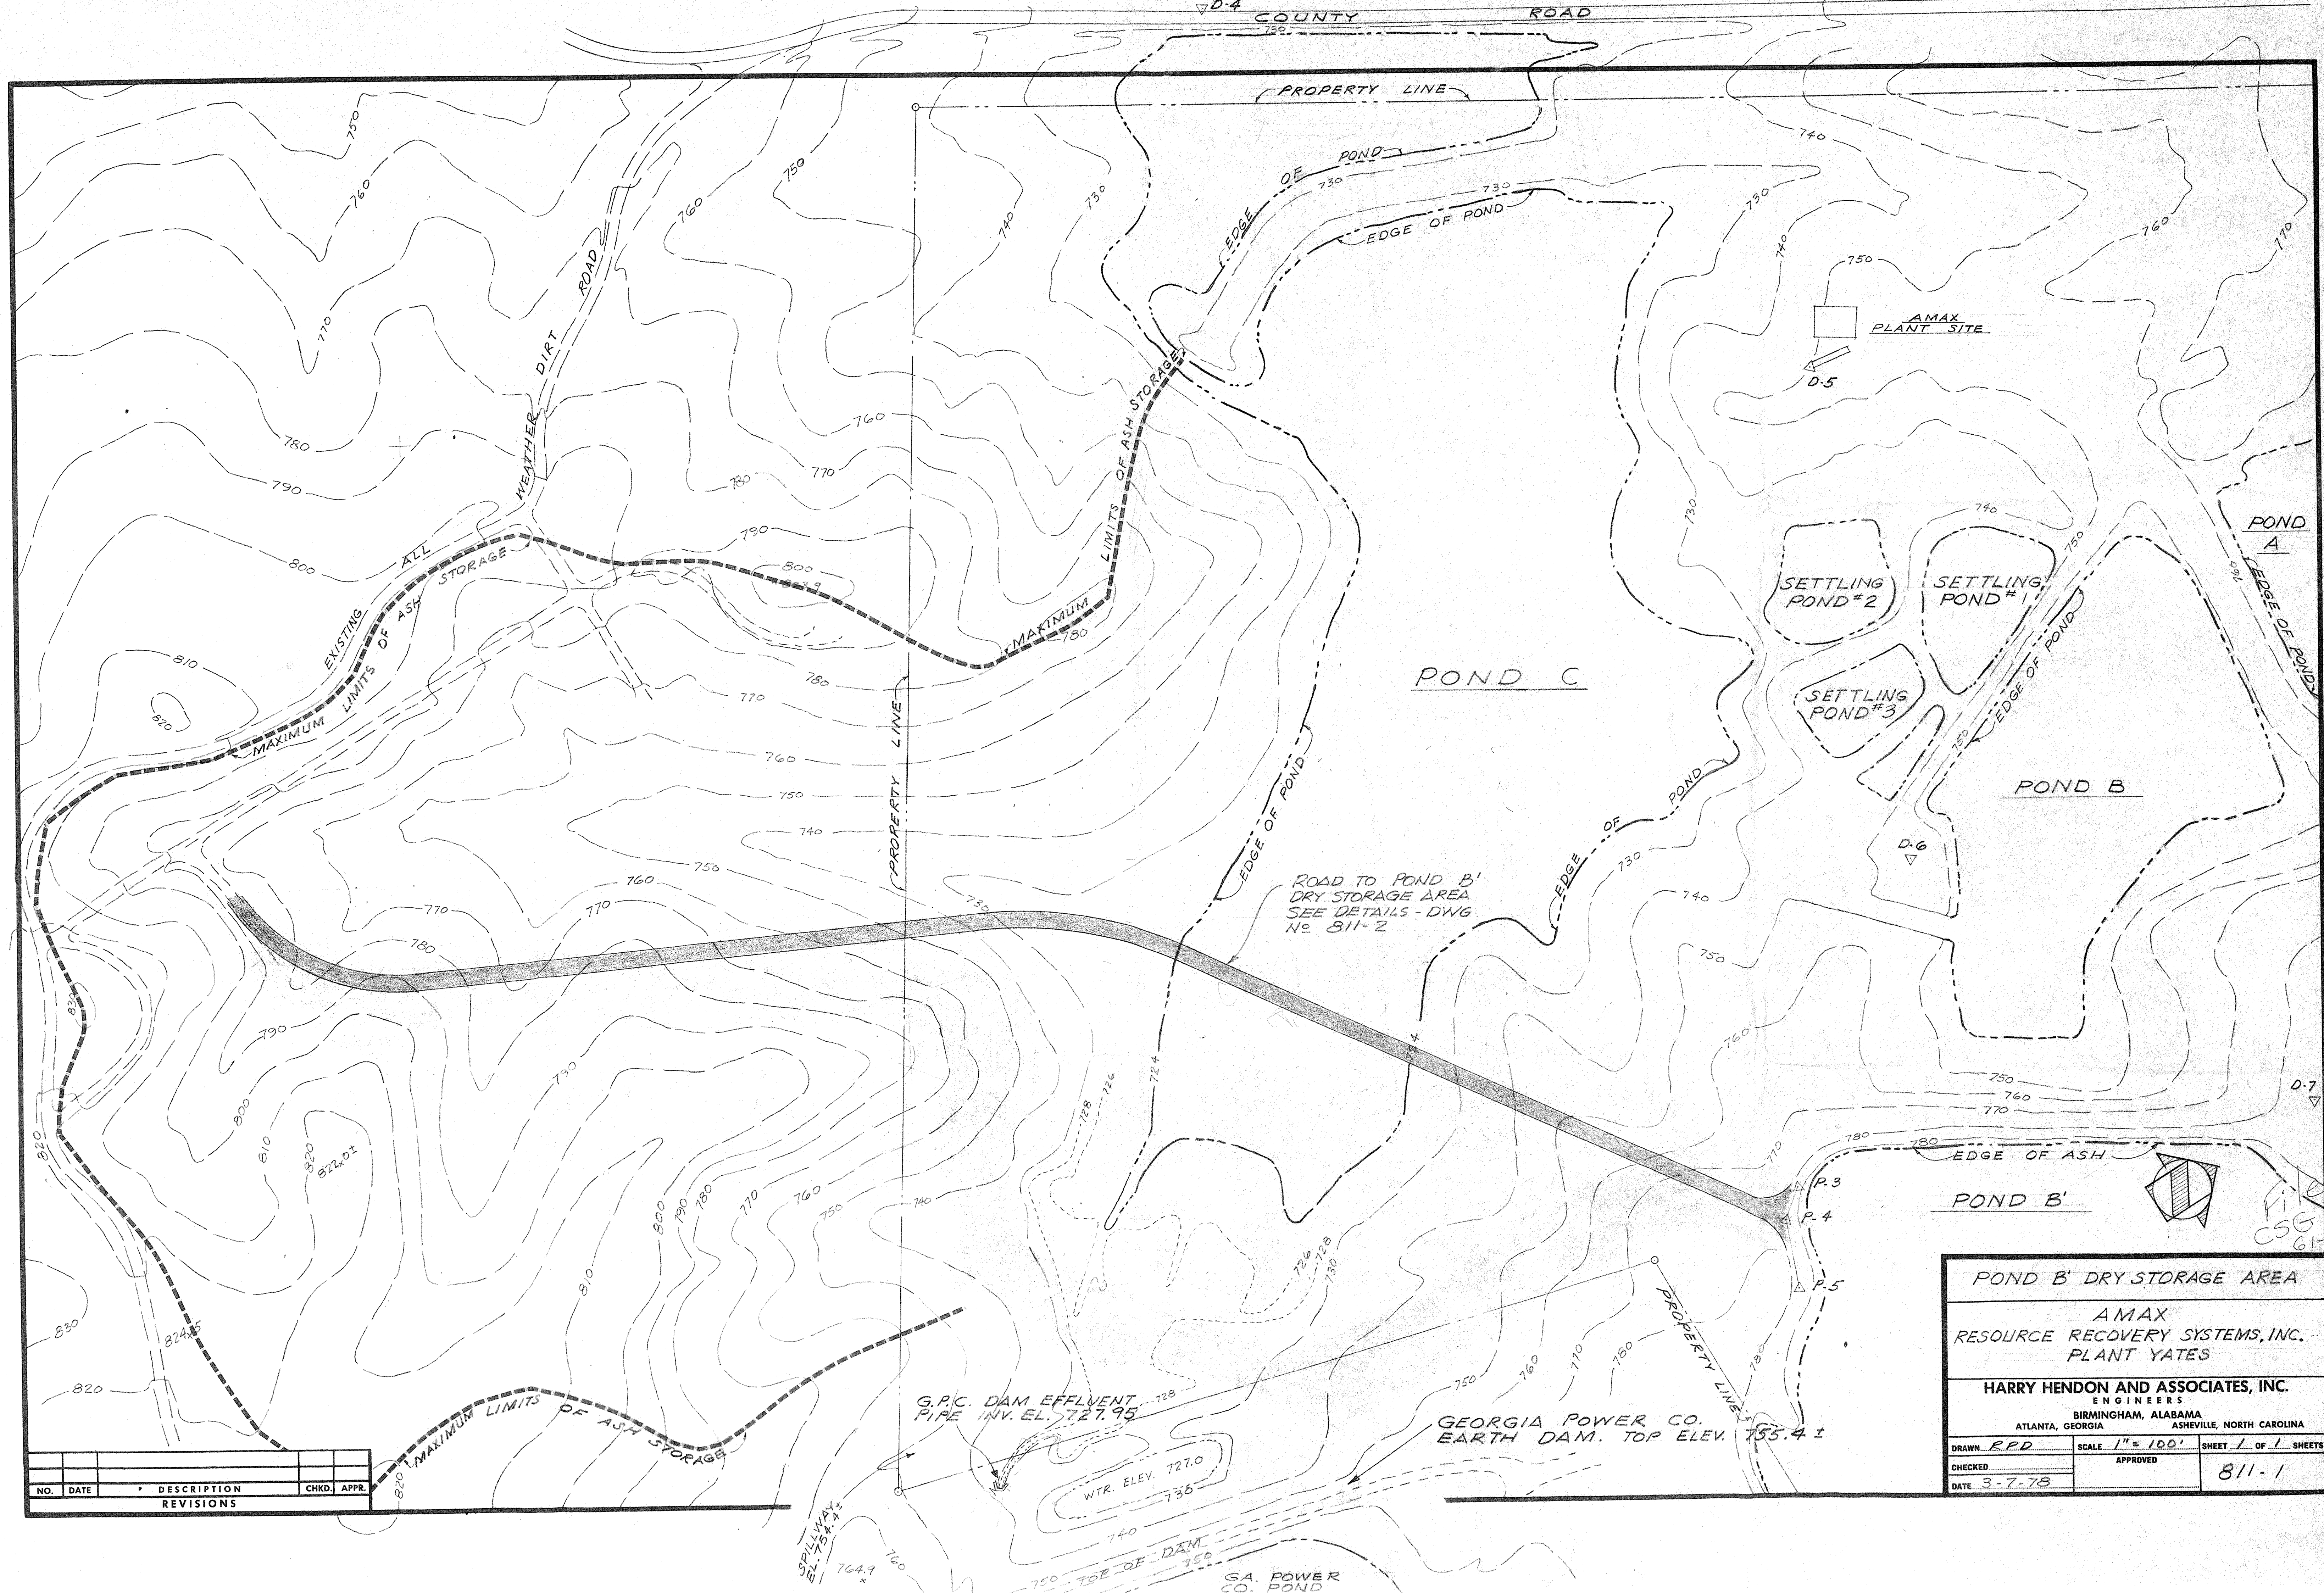

NO.	DATE	DESCRIPTION	CHKD.	APPR.
REVISIONS				

**POND B' DRY STORAGE AREA**

AMAX  
RESOURCE RECOVERY SYSTEMS, INC.  
PLANT YATES

**HARRY HENDON AND ASSOCIATES, INC.**  
ENGINEERS  
BIRMINGHAM, ALABAMA  
ATLANTA, GEORGIA ASHEVILLE, NORTH CAROLINA

DRAWN RPD	SCALE 1" = 100'	SHEET 1 OF 1 SHEETS
CHECKED	APPROVED	811-1
DATE 3-7-78		

ROAD TO POND B'  
DRY STORAGE AREA  
SEE DETAILS - DWG  
No 811-2


G.P.C. DAM EFFLUENT  
PIPE INV. EL. 727.95

GEORGIA POWER CO.  
EARTH DAM. TOP ELEV. 755.4 ±

WTR. ELEV. 727.0

GA. POWER  
CO. POND

CSG  
61-H2

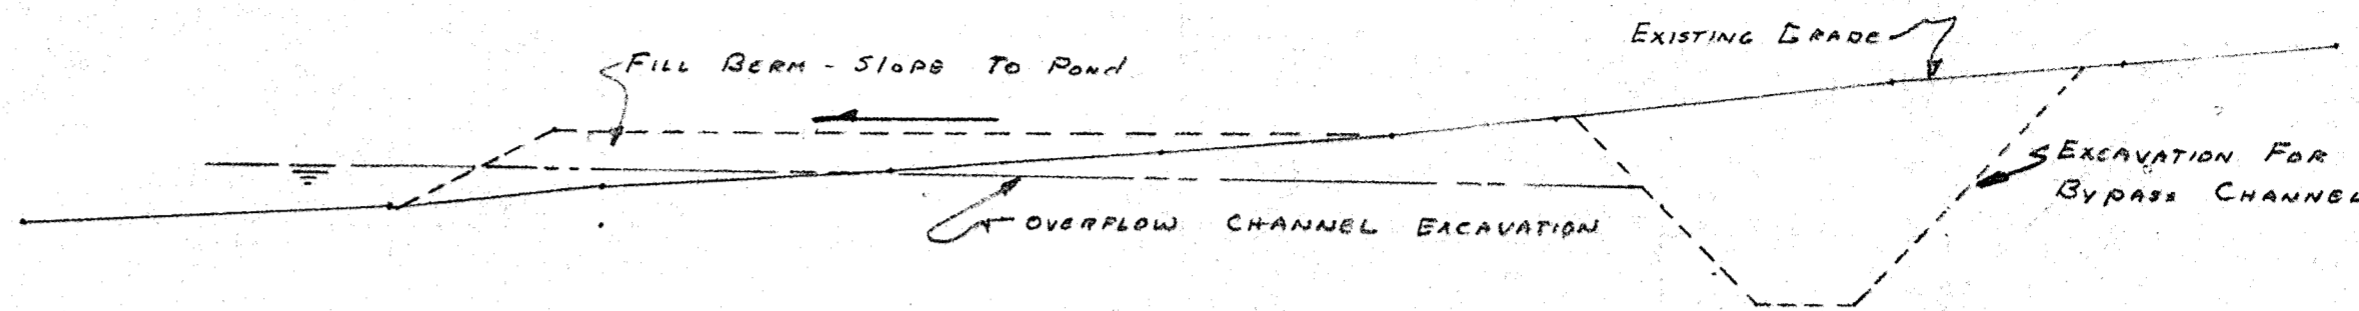

SECTION C-C  
1" = 20' H.V.


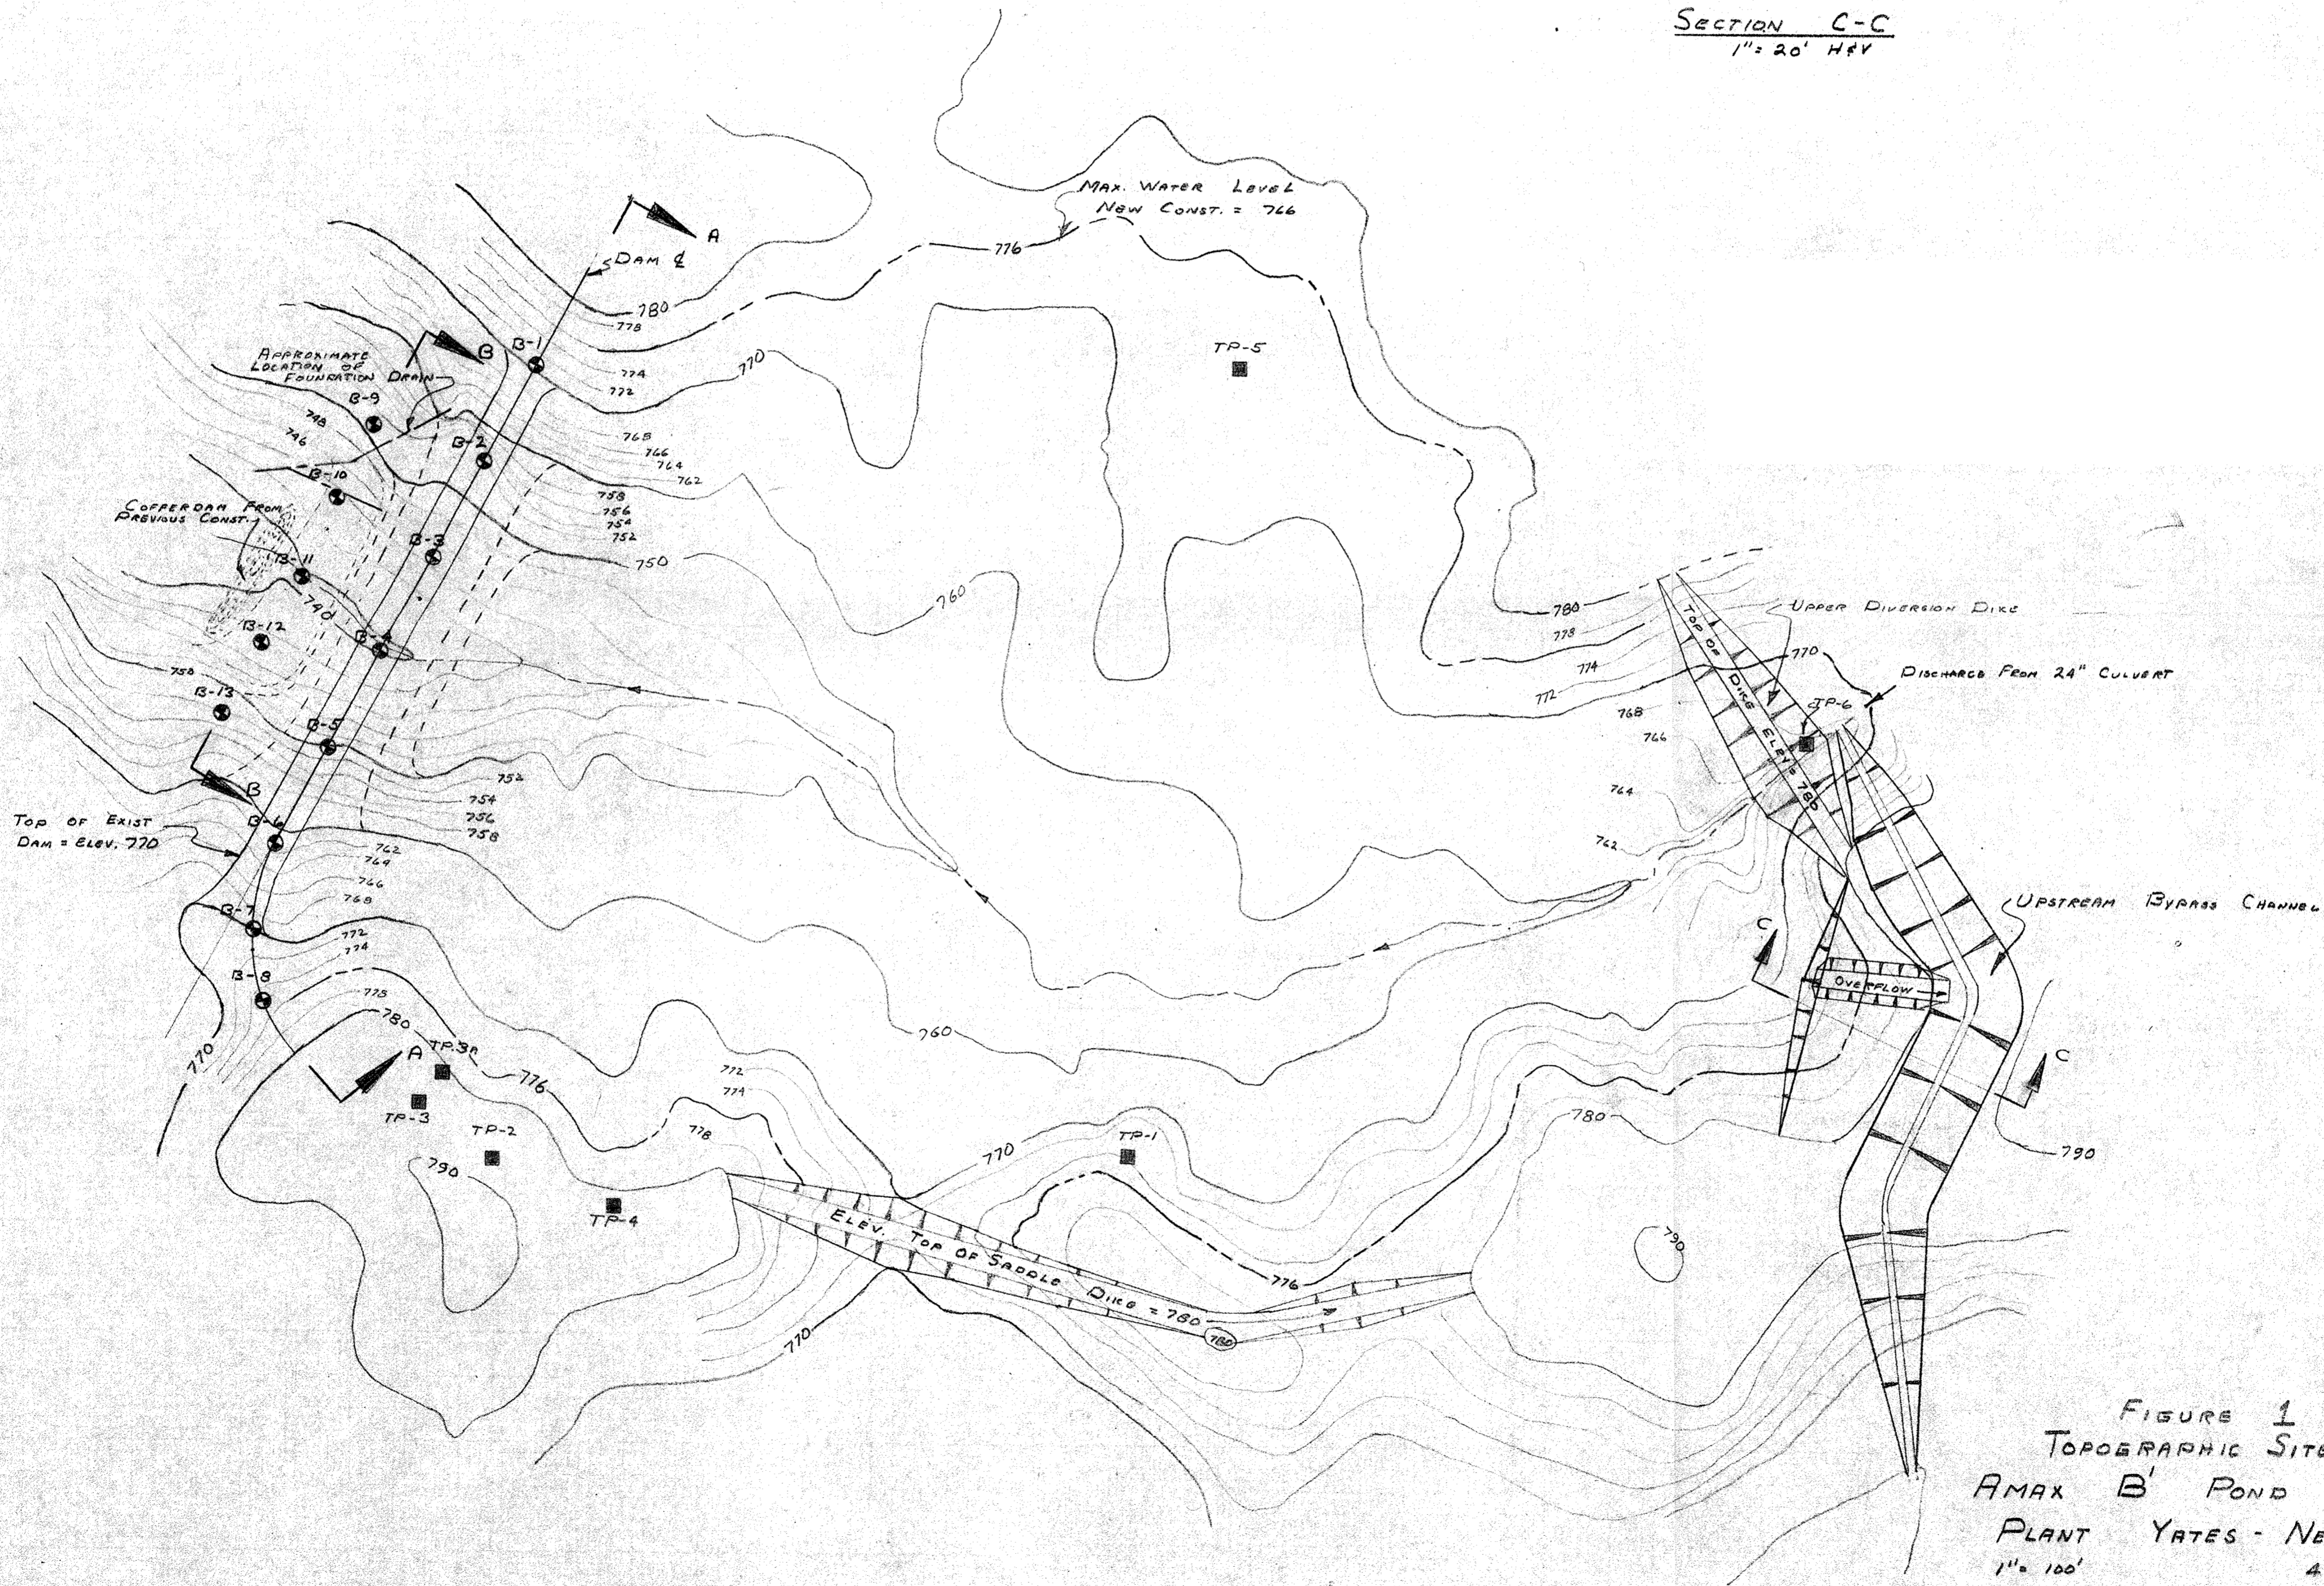


FIGURE 1  
TOPOGRAPHIC SITE PLAN  
A MAX B' POND MODIFICATIONS  
PLANT YATES - NEWNAM, GA.  
1" = 100' 4/15/77  
ADD



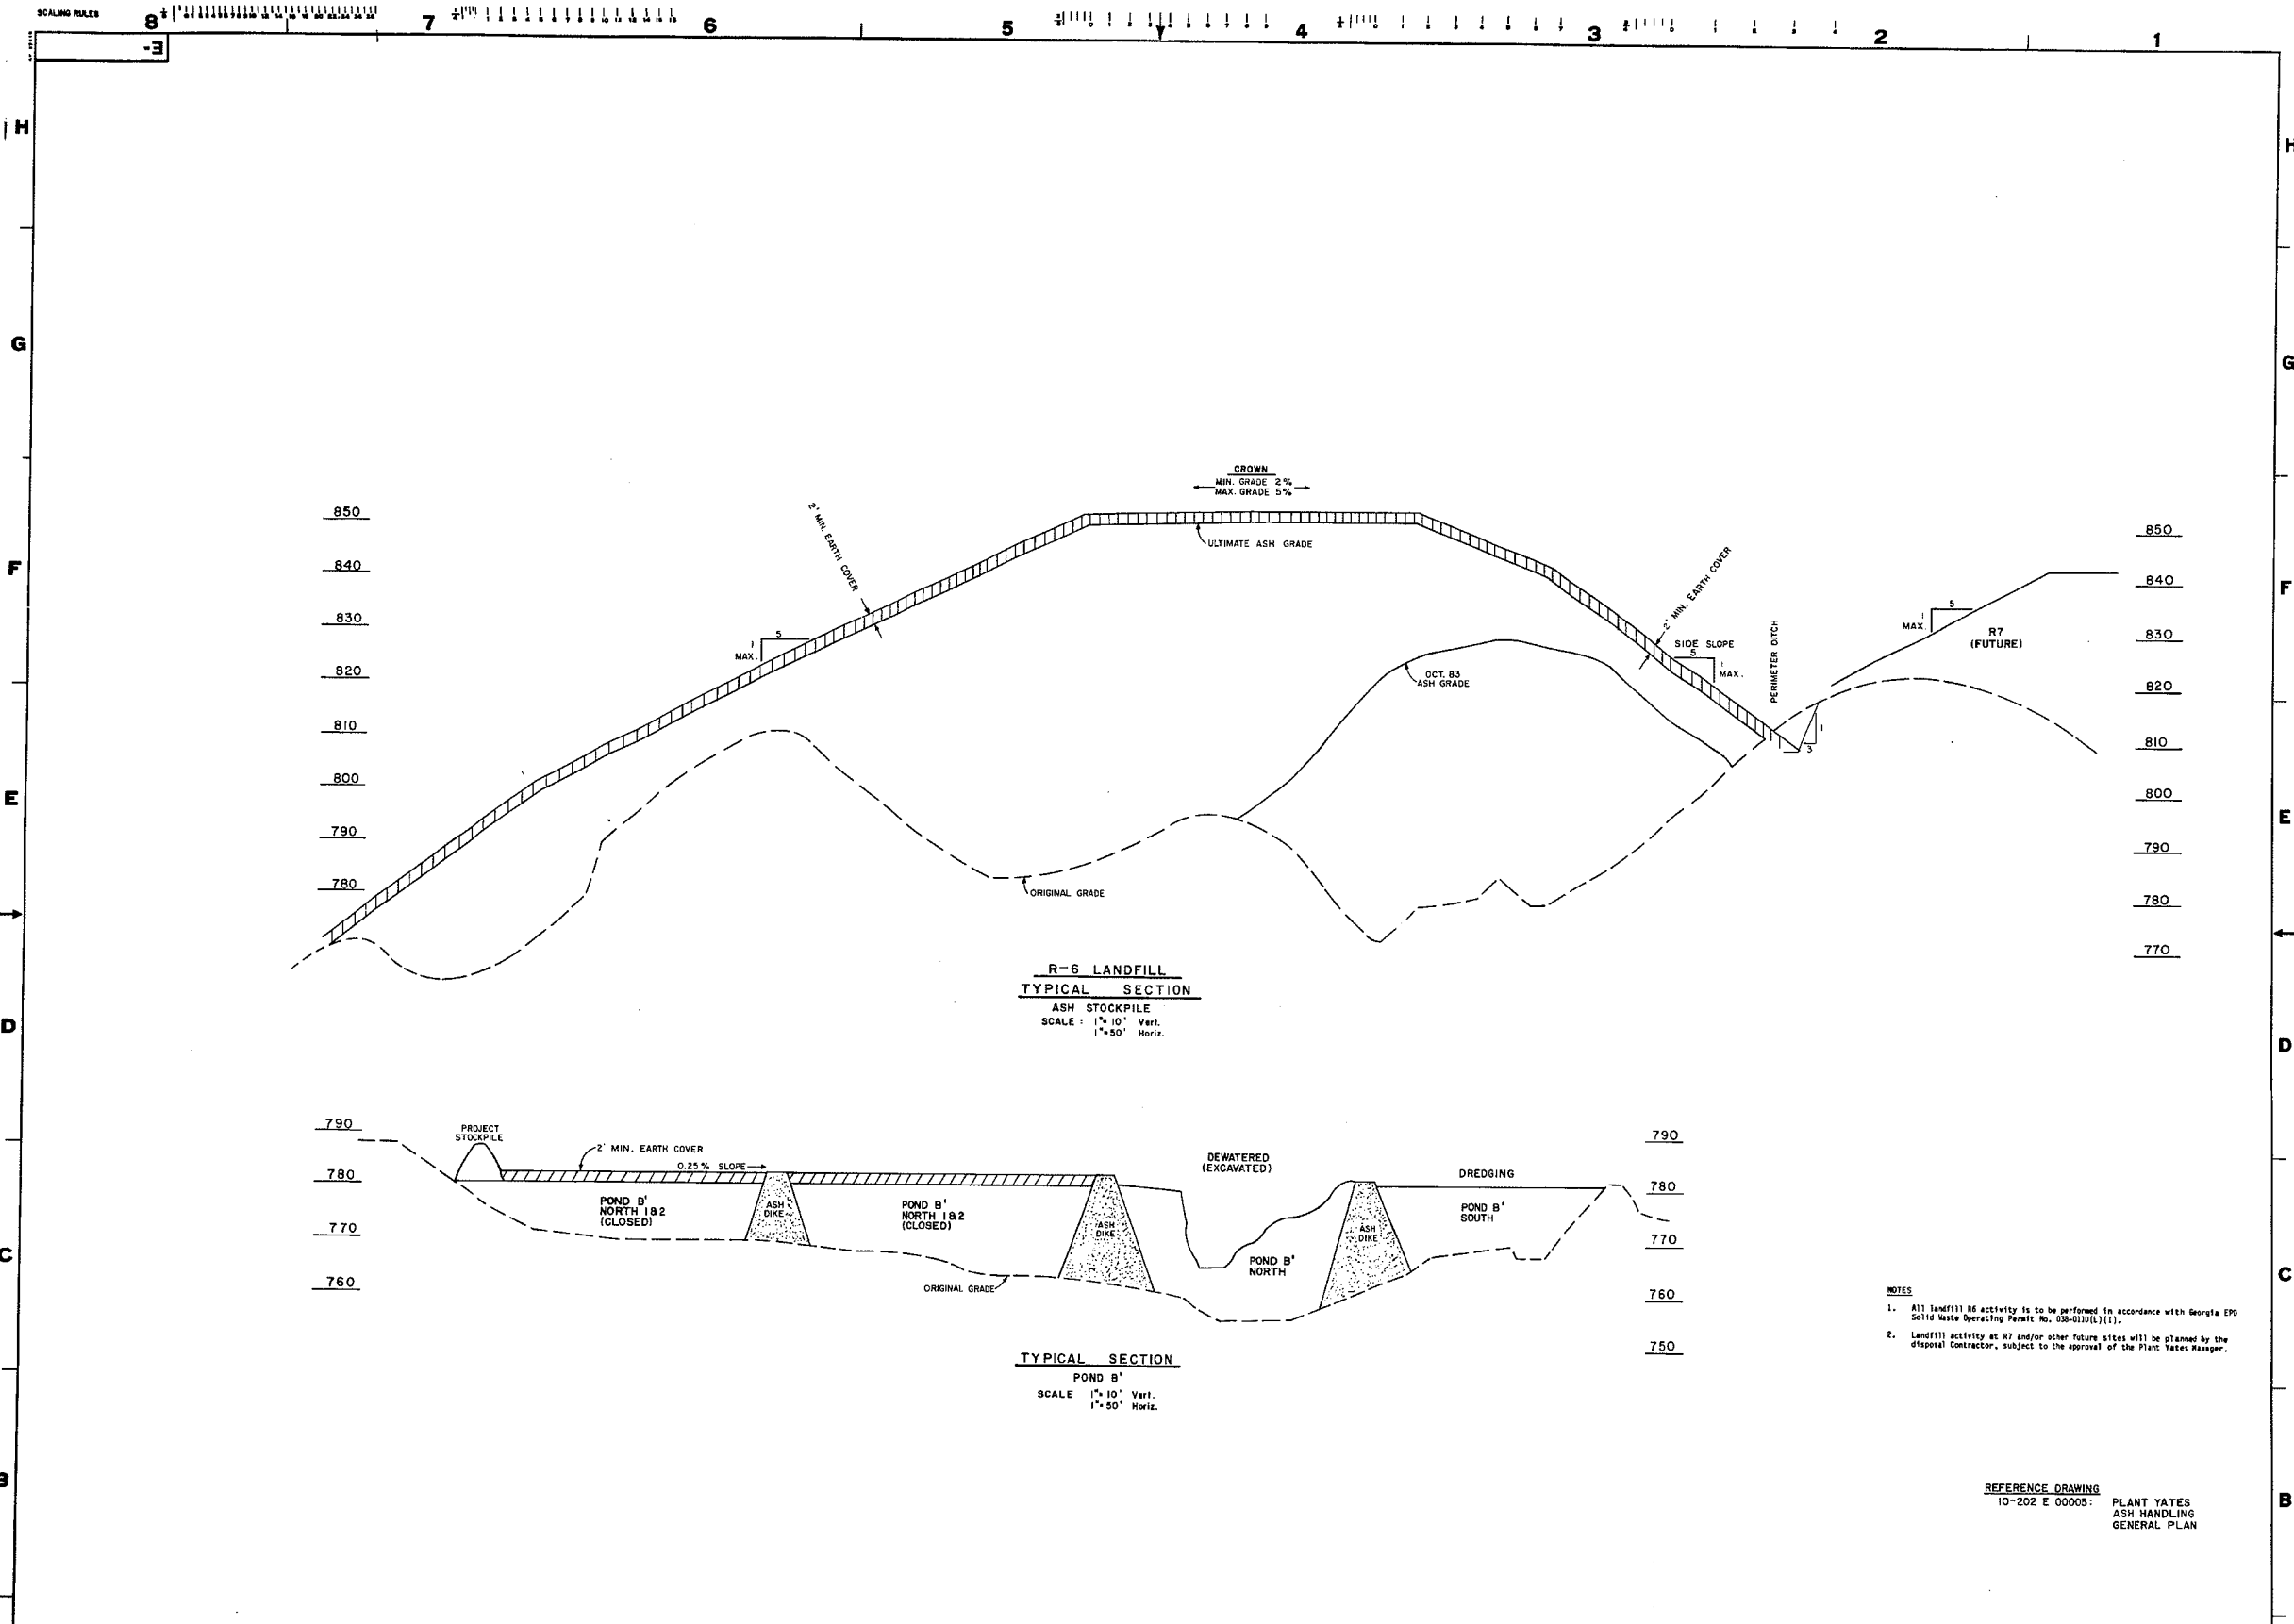

- NOTES**
- All landfill R6 activity is to be performed in accordance with Georgia EPD Solid Waste Operating Permit No. OSW-0170(L)(1).
  - Landfill activity at R7 and/or other future sites will be planned by the disposal contractor, subject to the approval of the Plant Yates Manager.

REFERENCE DRAWING  
10-202 E 00005: PLANT YATES  
ASH HANDLING  
GENERAL PLAN


REVISION	DATE	REVISION	DATE	REVISION	DATE	REVISION	DATE	REVISION	DATE	REVISION	DATE	REVISION	DATE	REVISION	DATE	REVISION	DATE

GEORGIA POWER CO., ATLANTA GA.  
ENGRG. AND CONSTR. SERVICES DEPT.

ISSUED FOR INQUIRY

PLANT YATES  
LANDFILL AND HOLDING POND DETAILS

DESIGNED: AWM DRAWN: DPG CHECKED: [Signature]  
SCALE: AS SHOWN LOCATION: [Blank] DRAWING NUMBER: 10-202 E-00006 REV: 0

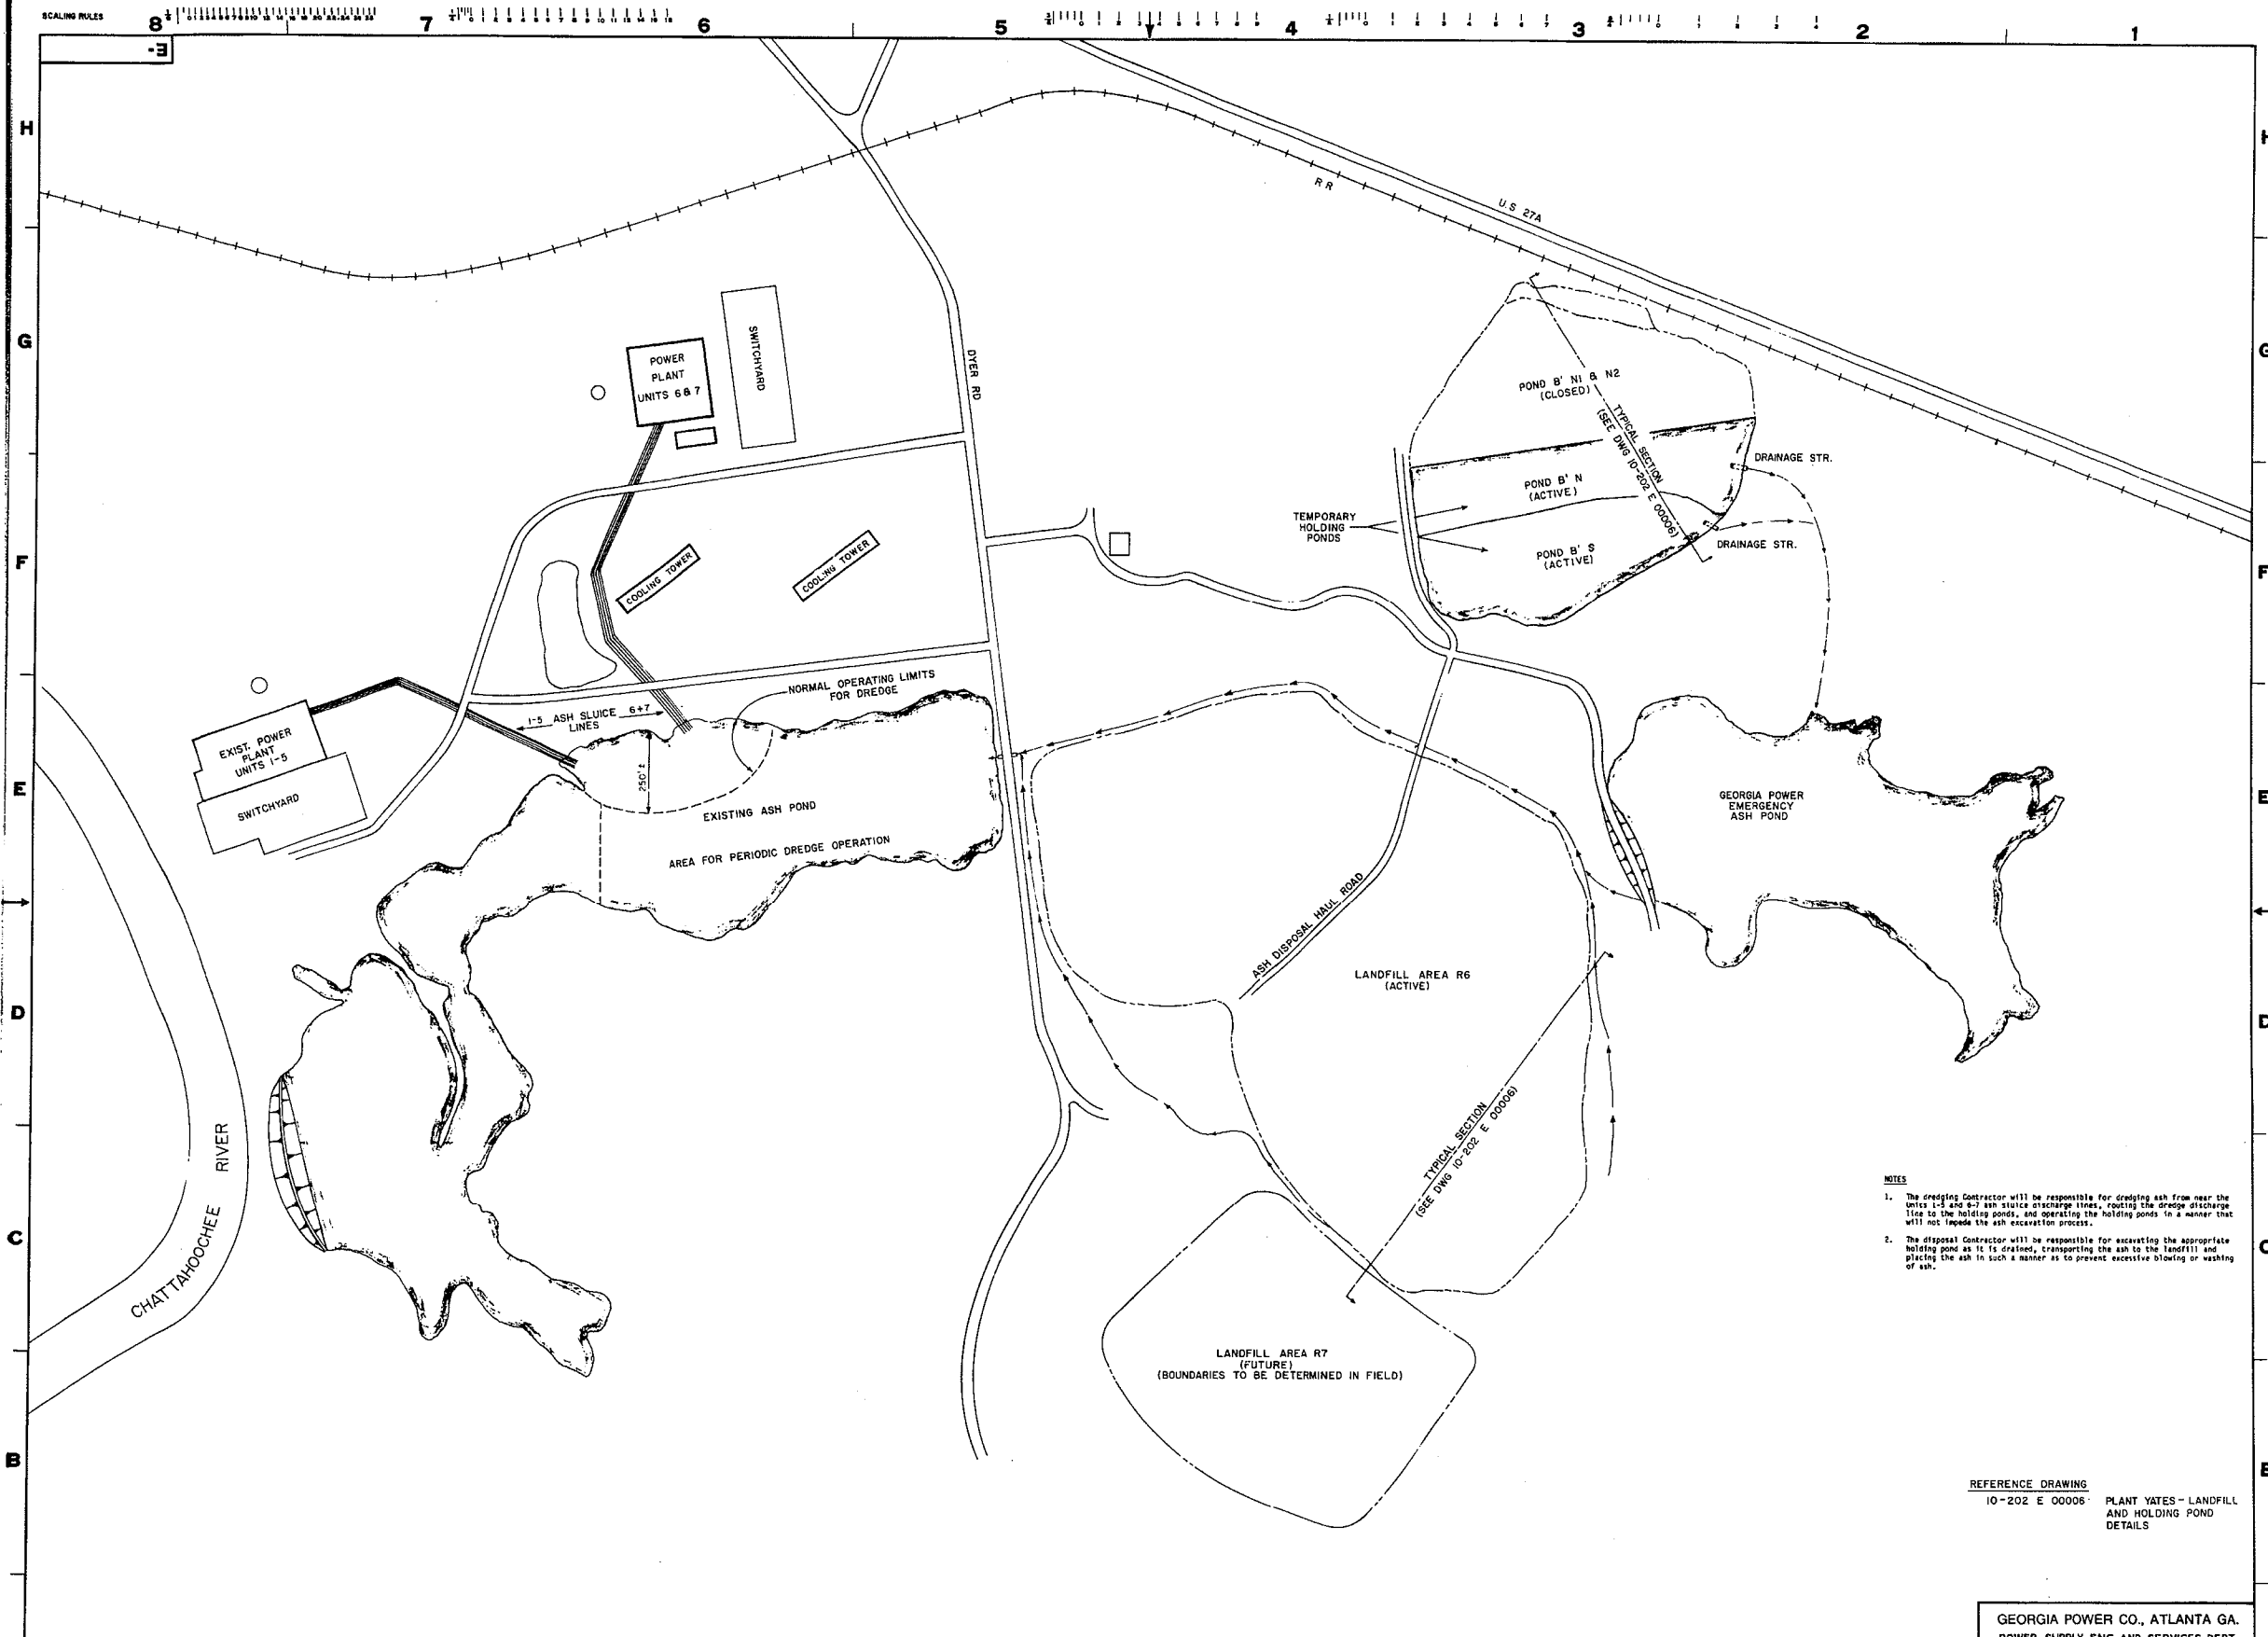

- NOTES**
1. The dredging Contractor will be responsible for dredging ash from near the units 1-5 and 6-7 ash sluice discharge lines, routing the dredge discharge line to the holding ponds, and operating the holding ponds in a manner that will not impede the ash excavation process.
  2. The disposal Contractor will be responsible for excavating the appropriate holding pond as it is drained, transporting the ash to the landfill and placing the ash in such a manner as to prevent excessive blowing or washing of ash.

REFERENCE DRAWING  
 10-202 E 00006 PLANT YATES - LANDFILL AND HOLDING POND DETAILS

GEORGIA POWER CO., ATLANTA GA.  
 POWER SUPPLY ENG. AND SERVICES DEPT.

PLANT YATES  
 ASH HANDLING-GENERAL PLAN

DESIGNED AWM	DRAWN DPG	CHECKED
SCALE 1" = 200'	CLASSIFICATION	LOCATION
AWM	10-202	E-00005
DATE 11-25-07	ISSUE FOR INQUIRY	REV. 0

REVISION	DATE	REVISION	DATE	REVISION	DATE	REVISION	DATE	REVISION	DATE	REVISION	DATE	REVISION	DATE	REVISION	DATE


PROPOSED LOCATION OF U.S. 27 ALT. ASH POND

SELECTED PLANT YATES GEOTECHNICAL & WELL LOCATIONS			
BORING No.	NORTHING	EASTING	SURFACE EL. @ T.O.B.
No. 3	1835.00	3440.00	
No. 4	1505.00	3020.00	
No. 5	532.00	3960.00	
No. 6	2615.00	3505.00	
No. 7	2275.00	4372.00	
DH-56	3000.00	1050.00	729.00
B-43	2105.00	4315.00	767.10
B-606	1742.31	2040.99	729.21
C-3	1025.00	408.00	721.00
T-1	1345.00	623.00	695.00
B-2	-1298.00	5245.00	728.30
B-8	-1075.00	5300.00	737.90
B-13	-1490.00	5200.00	741.70
DH-70	2500.00	2100.00	763.80
B'-2	290.00	5485.00	770.00
B'-4	130.00	5385.00	770.00
B'-8	-185.00	5260.00	775.00
DH-90	2000.00	1050.00	709.10
MW-1	2105.00	3430.00	-758.00
MW-2	2140.00	3880.00	-758.00
MW-3	1735.00	3885.00	-758.00

- LEGEND:**
- ▲ DH-56 - GEOTECHNICAL BORINGS
  - ⊙ No.3 - POTABLE WATER WELLS
  - ▲ MW-1 - MONITORING WELLS

- REFERENCES:**
- GEORGIA POWER COMPANY
- 10208 E11629 PLANT YATES UNITS 1-7 GENERAL ARRANGEMENT PLANT SITE, 1"=200'
  - 10208 E005 PLANT YATES UNITS 1-7 ASH HANDLING - GENERAL PLAN

- GENERAL NOTES:**
- ALL COORDINATES SHOWN ARE PLANT GRID.
  - THIS DRAWING WAS COMPILED FROM SELECTED INFORMATION CONTAINED ON THE DRAWINGS SHOWN IN THE LIST OF REFERENCES FOR INCLUSION IN A REPORT ENTITLED "A CHRONOLOGICAL HISTORY OF THE ASH PONDS AND ASH DISPOSAL AT PLANT YATES, NEWNAN, GEORGIA, JUNE, 1995, BY SOUTHERN COMPANY SERVICES, INC. FOR GEORGIA POWER CO., ENVIRONMENTAL AFFAIRS.
  - NO FIELD SURVEYS WERE PERFORMED FOR LOCATION OF INSTRUMENTATION ON THIS DRAWING.
  - LOCATION AND SHAPE OF ASH PONDS A, B & C ARE APPROXIMATE.

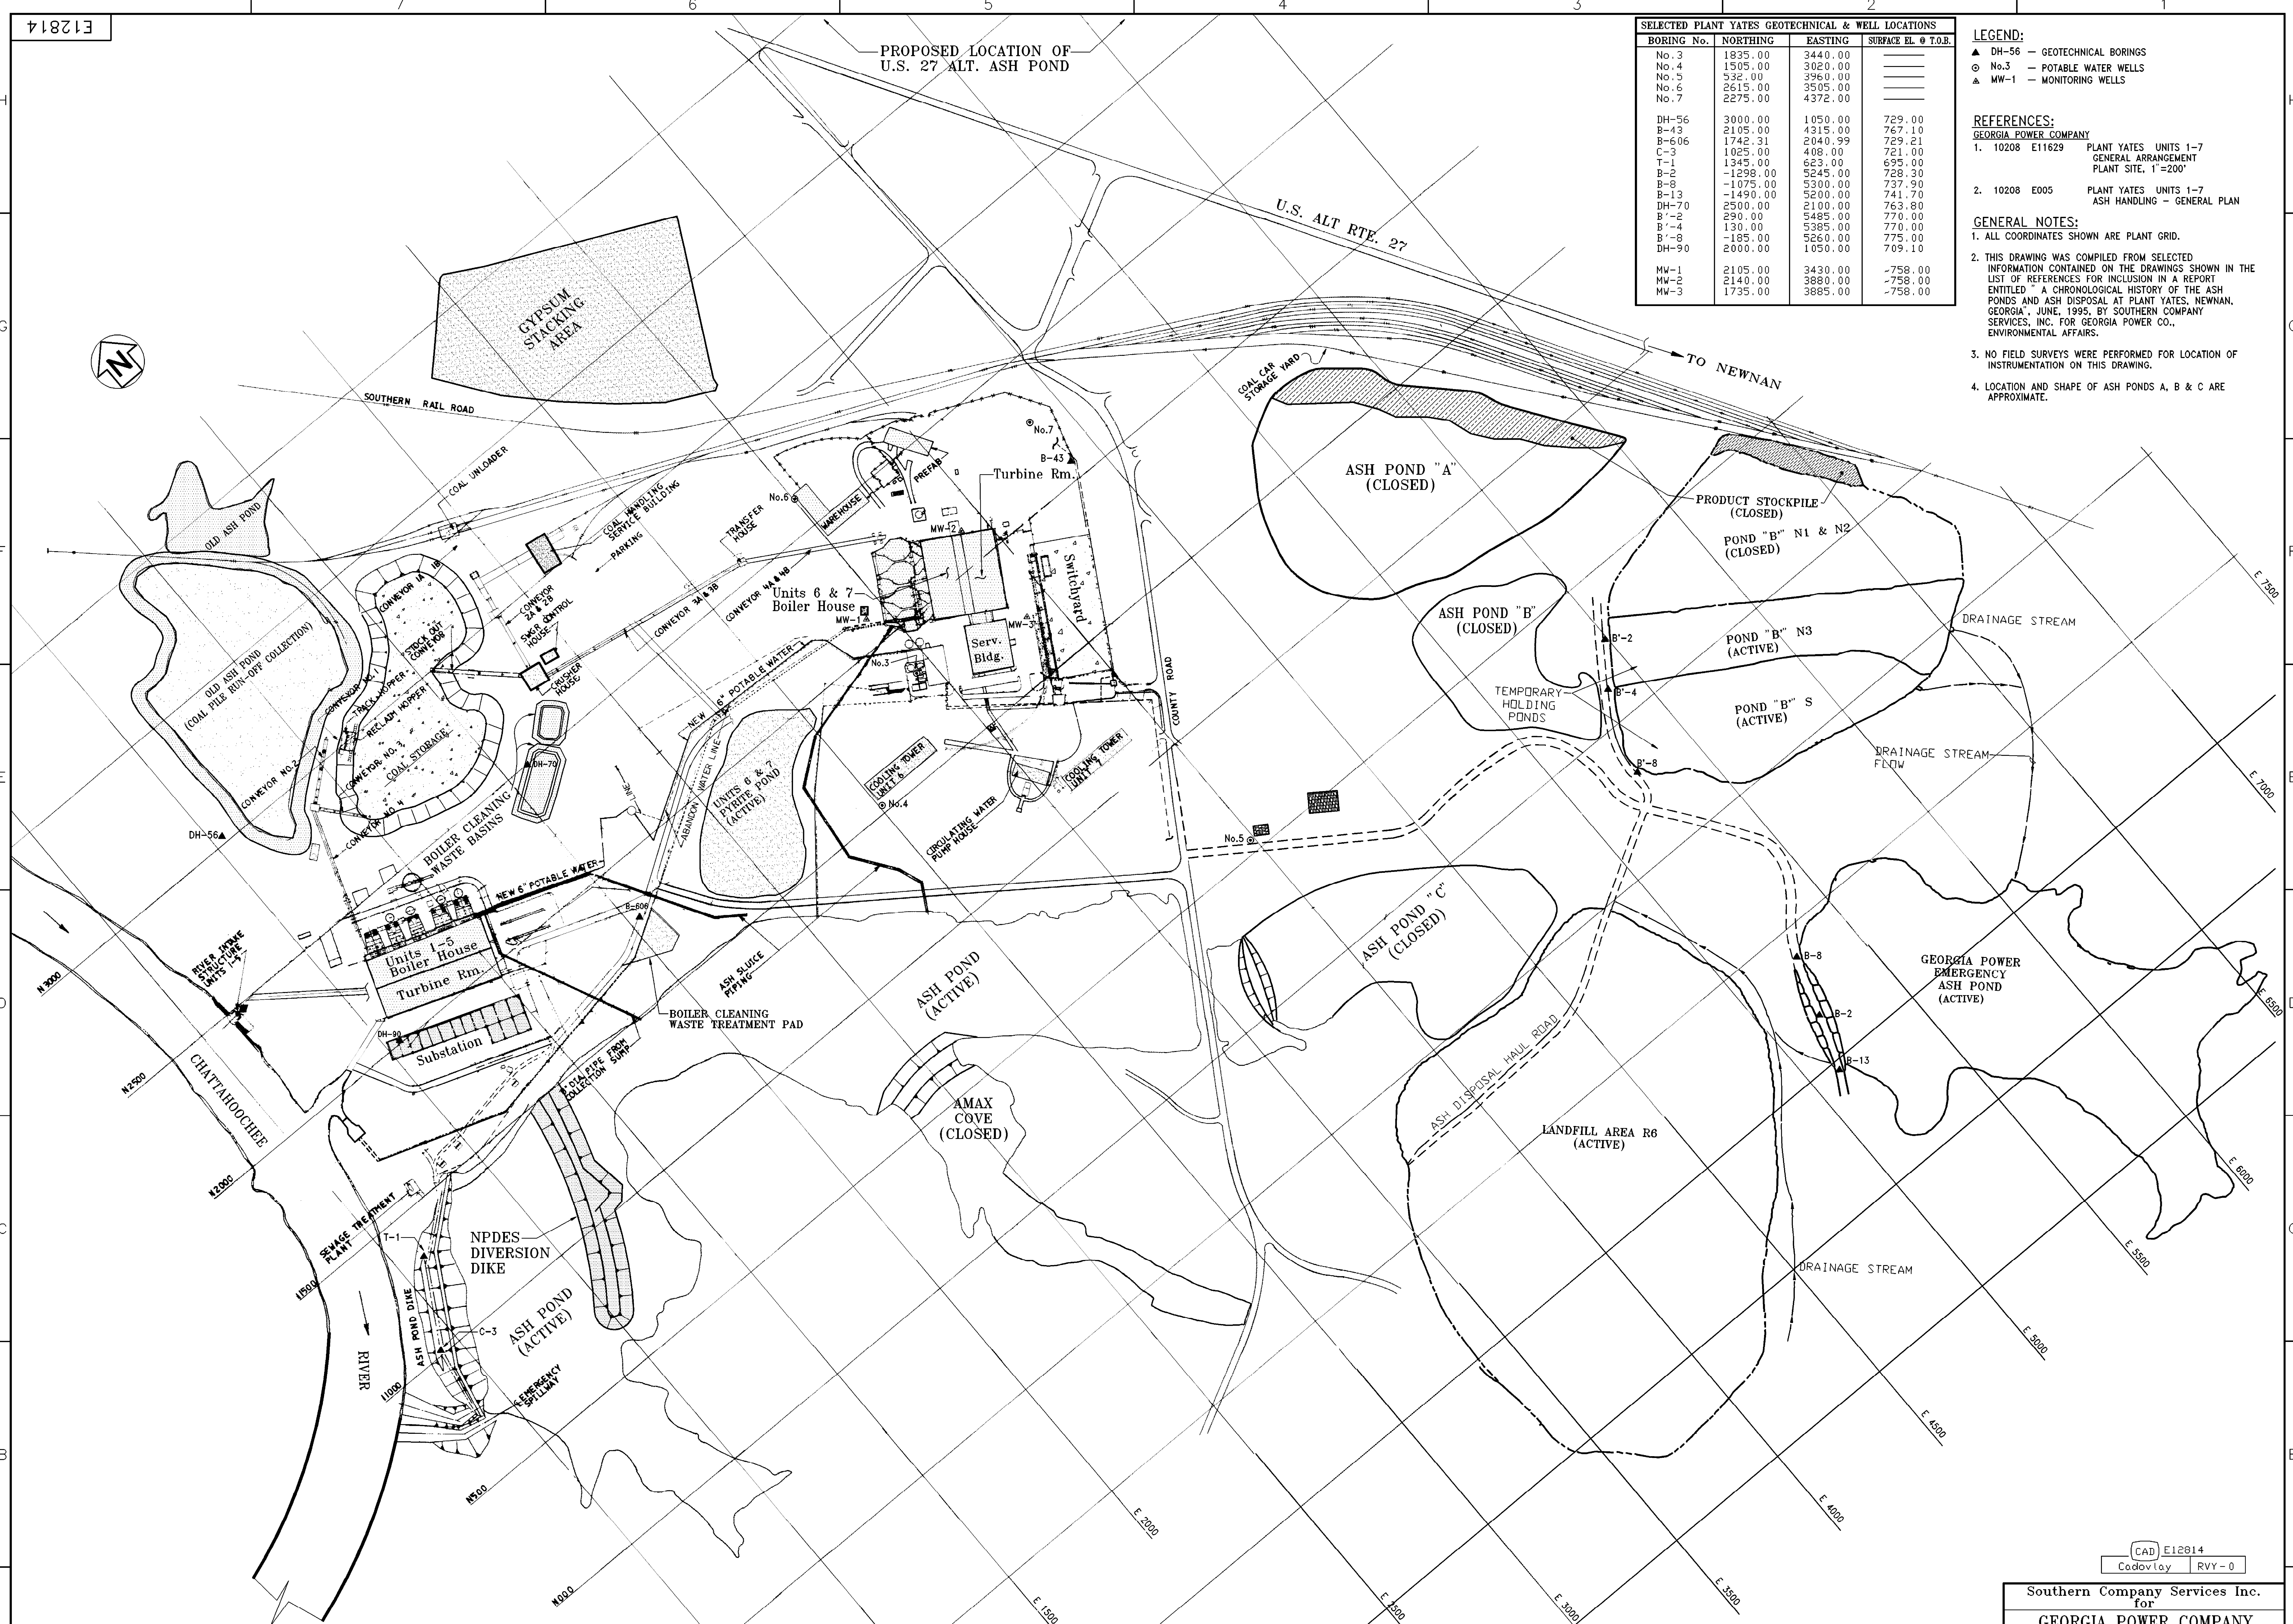

REVISION	DATE	REVISION	DATE	REVISION	DATE	REVISION	DATE	REVISION	DATE	REVISION	DATE	REVISION	DATE	REVISION	DATE

CAD E12814  
 Cadovlay RVY-0

**Southern Company Services Inc.**  
 for  
**GEORGIA POWER COMPANY**

**PLANT YATES**  
 COMPILATION OF ASH POND,  
 ASH STORAGE, MONITORING WELLS and  
 BOILER CLEANING WASTE BASINS LOCATIONS

DESIGNED R.WOOD    DRAWN R.VOYUNG    CHECKED R.W.  
 SCALE    LOCATION    DRAWING NUMBER    REV.  
 1"=200'    10202    E12814    0

REA #: EN95005    EWO: 3490ET  
 ISSUED FOR RECORD SUMMARY  
 DATE 6-5-95