


**MAY 2025**



Georgia  
Power

Geosyntec   
consultants



Georgia  
Power


2	MAY 2025	UPDATE COMPLIANCE MONITORING NETWORK	JJV	RB
1	MAY 2024	MINOR MOD SUBMITTAL TO GA EPD	JJV	RB
0	AUG. 2021	SUBMITTAL TO GA EPD	JJV/KH	RB
REV	DATE	DESCRIPTION	DRN	APP

COVER SHEET

PLANT BOWEN ASH POND 1 (AP-1)

CLOSURE DRAWINGS

BARTOW COUNTY, GEORGIA



1255 ROBERTS BOULEVARD, NW, SUITE 200

KENNESAW, GEORGIA 30144 USA

PHONE: 678.202.9500

WWW.GEOSYNTEC.COM

PROJ. NO.	GR8601	DWG.	GR8601-001	EDIT	5/5/2025
SCALE	AS SHOWN	<div style="font-size: 2em; font-weight: bold; margin: 0;">DRAWING</div> <div style="font-size: 3em; font-weight: bold; margin: 0;">1 OF 50</div>			
DATE	AUGUST 2021				



P:\CADD\PROJECTS\GEORGIA POWER\BOWEN POWER PLANT\PERMIT\ASH POND CLOSURE (GR6601)DRAWINGS\GR6601-102

LINETYPE LEGEND

	EDGE OF ROAD / EXISTING BUILDINGS
	RAILROAD TRACKS
	POWER TRANSMISSION LINE EASEMENT
	GAS LINE AND EASEMENT
	EXISTING PIPE
	TREE LINE
	STREAMS / WATER LINE / CREEK
	EXISTING GROUND
	APPROXIMATE TOP OF BEDROCK (NOTE 10)
	APPROXIMATE BOTTOM OF CCR
	PREDICTED POST-CLOSURE SEASONAL HIGH GROUNDWATER POTENTIOMETRIC SURFACE (NOTE 9)
	BOTTOM OF EXCAVATION
	PERMIT BOUNDARY
	PROPERTY BOUNDARY (NOTE 5)
	APPROXIMATE EXISTING LIMIT OF AP-1 / LIMIT OF LINER
	LEACHATE COLLECTION CORRIDOR
	LEACHATE FORCEMAIN
	FINAL COVER TOP DECK DIVERSION BERM
	FINAL COVER TOP DECK LET-DOWN CHANNEL
	FINAL COVER SIDESLOPE DRAINAGE BENCH
	FINAL COVER DOWNCHUTE CHANNEL
	STORMWATER CHANNEL
	TEXTURED HDPE OR LLDPE GEOMEMBRANE
	CLOSURETURF® SYSTEM
	DOUBLE-SIDED GEOCOMPOSITE
	NON-WOVEN GEOTEXTILE SEPARATOR OR CUSHION
	GEOSYNTHETIC CLAY LINER
	LIMIT OF DISTURBANCE
	CONTACT WATER DIVERSION
	STORMWATER (NON-CONTACT WATER) DIVERSION

SYMBOL LEGEND

	EXTRUSION WELD
	GROUNDWATER MONITORING WELL
	SLOPE GRADE
	SLOPE INDICATOR
	SLOPE LABEL
	TRAILER / BUILDING / TANK
	VEGETATION
	GROUNDWATER OR WATER SURFACE
	STORMWATER FLOW DIRECTION
	STORMWATER CHANNEL OUTLET FLUME
	LEACHATE SUMP
	LEACHATE FORCEMAIN AIR RELEASE MANHOLE
	LEACHATE FORCEMAIN CLEANOUT MANHOLE
	LEACHATE FORCEMAIN JUNCTION MANHOLE
	TEMPORARY CONTACT-WATER COLLECTION LOCATION


HATCH PATTERN LEGEND

	LINED STORMWATER POND
	CONCRETE
	FINE SAND FILTER LAYER
	FINE GRAVEL DRAINAGE LAYER
	MEDIUM GRAVEL DRAINAGE LAYER
	COARSE GRAVEL DRAINAGE LAYER
	FINE-SCREENED COMPACTED CLAY LINER
	COARSE-SCREENED COMPACTED CLAY LINER
	PROTECTIVE COVER SOIL / TRENCH BACKFILL / STRUCTURAL FILL
	PIPE EMBEDMENT FILL / COMPACTED GRANULAR SUBBASE
	VEGETATIVE COVER LAYER
	CCR
	AGGREGATE
	RIPRAP
	CONSOLIDATED AREA FOUNDATION IMPROVEMENTS
	OTHER AREA FOUNDATION IMPROVEMENTS
	100-YEAR FLOODPLAIN
	WETLANDS
	COVERED CCR AREA (NON-CONTACT WATER)
	TEMPORARY CCR STOCKPILE AREA
	CONTACT WATER COLLECTION AREA
	COMPACTED CLAYEY SOIL
	LINED CONTACT WATER POND

CONTOUR LEGEND

	EXISTING GROUND ELEVATION (FEET) (NOTE 1)
	APPROXIMATE BOTTOM OF CCR SURFACE ELEVATION (FEET)
	EXCAVATION SURFACE ELEVATION (FEET)
	TOP OF LINER ELEVATION (FEET)
	TOP OF CCR ELEVATION FOR SOIL-GEOSYNTHETIC COMPOSITE COVER (FEET)
	TOP OF FINAL COVER SYSTEM / TOP OF CCR FOR ALTERNATIVE COVER SYSTEM (CLOSURETURF® COVER) / FINISHED GRADE ELEVATION (FEET)
	PREDICTED POST-CLOSURE SEASONAL HIGH GROUNDWATER POTENTIOMETRIC SURFACE ELEVATION (FEET)

DETAIL AND SECTION IDENTIFICATION LEGEND

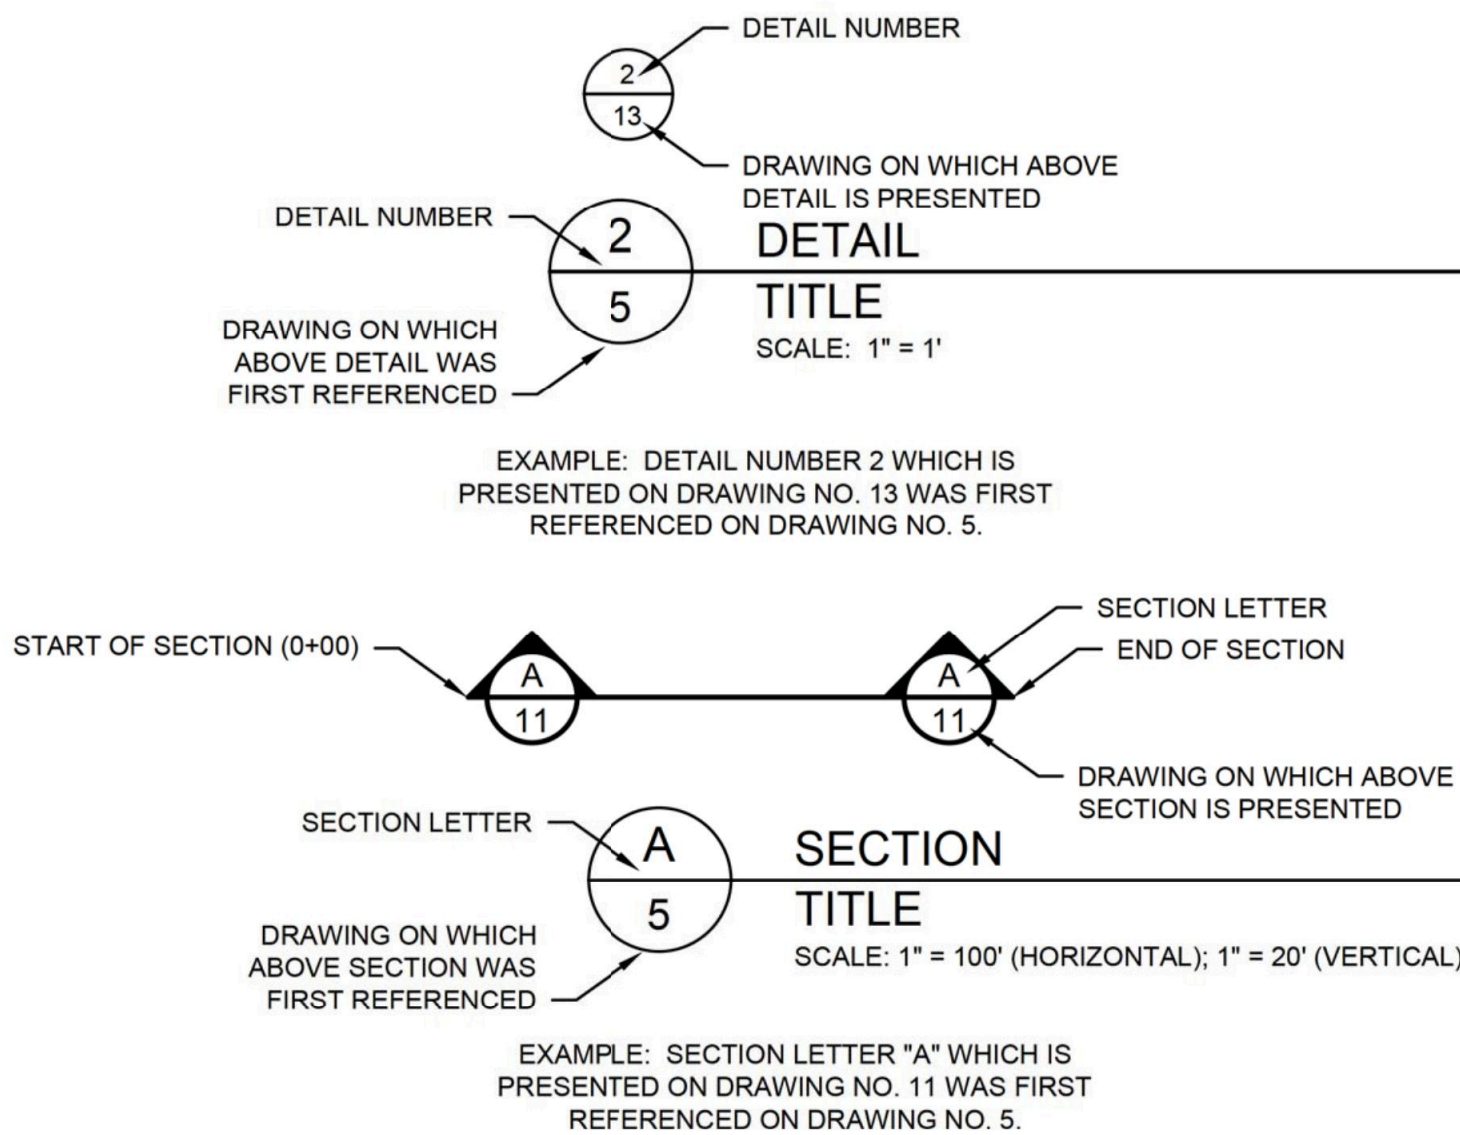

ABBREVIATIONS

AASHTO	AMERICAN ASSOCIATION OF STATE HIGHWAY AND TRANSPORTATION OFFICIALS
AC	ACRES
APP	APPROVED BY
CAD	COMPUTER-AIDED DRAFTING
ASTM	AMERICAN SOCIETY FOR TESTING AND MATERIALS
C-TRM	COMPOSITE TURF REINFORCEMENT MAT
CCR	COAL COMBUSTION RESIDUALS
CL	CENTERLINE
CQA	CONSTRUCTION QUALITY ASSURANCE
DIA	DIAMETER
DRN	DRAWN BY
DWG	DRAWING
E	EAST OR EASTING
EL	ELEVATION
EPA	ENVIRONMENTAL PROTECTION AGENCY
FEMA	FEDERAL EMERGENCY MANAGEMENT AGENCY
FT	FEET
GDOT	GEORGIA DEPARTMENT OF TRANSPORTATION
GPC	GEORGIA POWER COMPANY
GSWCC	GEORGIA SOIL AND WATER CONSERVATION COMMISSION
GSWP	GENERAL SERVICE WATER POND
H:V	HORIZONTAL TO VERTICAL LENGTH RATIO FOR A SLOPE
HDPE	HIGH DENSITY POLYETHYLENE
HECP	HYDRAULIC EROSION CONTROL PRODUCTS
HPTRM	HIGH PERFORMANCE TURF REINFORCEMENT MAT
HWY	HIGHWAY
IN	INCH
INV	INVERT
LBS	POUNDS
LF	LINEAR FOOT
LLDPE	LINEAR LOW DENSITY POLYETHYLENE
LOD	LIMITS OF DISTURBANCE
MAX	MAXIMUM
MIN	MINIMUM
MSL	MEAN SEA LEVEL
N	NORTH / NORTHING
NAD	NORTH AMERICAN DATUM
NAVD88	NORTH AMERICAN VERTICAL DATUM OF 1988
NE	NORTHEAST
NO.	NUMBER
NPDES	NATIONAL POLLUTANT DISCHARGE ELIMINATION SYSTEM
N.S.A.	NATIONAL STONE ASSOCIATION
NTS	NOT TO SCALE
NW	NORTHWEST
OC	ON CENTER
OZ	OUNCE
PC	PERIMETER CHANNEL
PROJ	PROJECT
RCP	REINFORCED CONCRETE PIPE
RD	ROAD
RECP	ROLLED EROSION CONTROL PRODUCTS
REV	REVISION
RP	RECYCLE POND
S	SOUTH
SCS	SOUTHERN COMPANY SERVICES
SF	SILT FENCE
SWP	STORMWATER PIPE
TRM	TURF REINFORCEMENT MAT
TYP	TYPICAL
UV	ULTRAVIOLET
W	WEST OR WIDTH
W.S.	WATER SURFACE
WWTS	WASTEWATER TREATMENT SYSTEM
%	PERCENT OR PERCENTILE

GENERAL SITE NOTES



- IN THE VICINITY OF AP-1, TOPOGRAPHY, UTILITIES, EXISTING ROADS, STREAMS, AND TREELINES SHOWN ON THIS DRAWING SET IS FROM A LIDAR TOPOGRAPHIC SURVEY DATED 4/1/2017, PROVIDED AS AN ELECTRONIC COMPUTER-AIDED DRAFTING DRAWING FILE BY SOUTHERN COMPANY SERVICES.
- BEYOND THE AP-1 AREA MAPPED WITH LIDAR TOPOGRAPHY AS DELINEATED ON THE DRAWINGS, TOPOGRAPHY IS FROM UNITED STATES GEOLOGIC SURVEY (USGS) DIGITAL MAPPING FILE, "NED 1 N35W085 ARCGRID GEORGIA".
- ELEVATIONS ARE SHOWN IN FEET ABOVE MEAN SEA LEVEL (FT, MSL), THE NORTH AMERICAN VERTICAL DATUM OF 1988 (NAVD88).
- GRID COORDINATE SYSTEM CORRESPONDS TO NORTH AMERICAN DATUM OF 1983 (NAD83), GEORGIA STATE PLANE, WEST ZONE, US FOOT.
- PROPERTY BOUNDARY IS APPROXIMATE AND WAS PROVIDED AS AN ELECTRONIC CAD DRAWING FILE BY SOUTHERN COMPANY SERVICES.
- MONITORING WELL COORDINATES, GROUND SURFACE ELEVATIONS, AND SCREENED INTERVALS WERE OBTAINED FROM THE "SEPTEMBER 2020 WELL INSTALLATION ADDENDUM MEMORANDUM" DATED 29 SEPTEMBER 2020, PREPARED BY GEOSYNTEC CONSULTANTS, INC.
- EXISTING LIMITS OF AP-1 AS PRESENTED IN THIS DRAWING SET ARE APPROXIMATE AND REPRESENT THE INTERIOR CREST OF THE CONTAINMENT DIKES. LIMITS ARE BASED ON A COMBINATION OF TOPOGRAPHIC MAP INTERPRETATION, EXAMINATION OF AS-BUILT PLANS OF CONTAINMENT DIKES, AND AIRPHOTO INTERPRETATION. FROM THIS INFORMATION, AN ESTIMATE WAS MADE OF THE LATERAL LOCATION AND VERTICAL PROFILE OF THE AP-1 LIMITS.
- BOTTOM OF CCR SURFACE IS APPROXIMATE AND IS BASED ON AN ELECTRONIC CAD DRAWING PROVIDED BY SOUTHERN COMPANY SERVICES OF THE AS-CONSTRUCTED (PRE-ASH) BOTTOM OF AP-1 FROM TOPOGRAPHY DATED 10/30/1969, WITH UPDATES TO THE SURFACE MADE BY GEOSYNTEC USING ELEVATION DATA OF THE CCR-RESIDUUM INTERFACE AS ESTIMATED FROM BORINGS DURING RECENT SUBSURFACE INVESTIGATIONS IN AP-1. ON INTERIOR DIKE SIDESLOPES, BOTTOM OF CCR SURFACE WAS CREATED USING A TWO HORIZONTAL TO ONE VERTICAL (2H:1V) SLOPE.
- PREDICTED POST-CLOSURE SEASONAL HIGH GROUNDWATER POTENTIOMETRIC SURFACE OBTAINED FROM GROUNDWATER FLOW MODELING RESULTS AS DOCUMENTED IN THE "HYDROGEOLOGIC ASSESSMENT REPORT (REVISION 3)" (PART B, SECTION 2 OF THIS PERMIT APPLICATION).
- TOP OF BEDROCK SURFACE IS APPROXIMATE AND WAS DEVELOPED BY GEOSYNTEC USING AVAILABLE SUBSURFACE INFORMATION FROM PREVIOUS SITE INVESTIGATIONS.
- DURING CLOSURE CONSTRUCTION, CONTRACTOR WILL VERIFY BOTH LATERAL AND VERTICAL EXTENT OF CCR IN THE FIELD.
- EXCAVATION SURFACE IS APPROXIMATE AND WAS DEVELOPED BASED ON THE ESTIMATED BOTTOM OF CCR AND TO MEET THE FOLLOWING CRITERIA: (I) EXCAVATE AT LEAST SIX INCHES BELOW THE BOTTOM OF CCR SURFACE IN ALL AREAS OF AP-1; (II) CONDUCT ADDITIONAL EXCAVATION AS NEEDED BENEATH THE FLOOR AREAS OF THE CONSOLIDATED LINED FOOTPRINT AND BENEATH THE BASE OF THE NEW NORTH AND SOUTH CONTAINMENT DIKES TO PROVIDE AN 8-FT (MIN) COMPACTED SOIL BUFFER ZONE BELOW THE LINER SYSTEM; AND (III) CONDUCT ADDITIONAL EXCAVATION IN THE AREAS SOUTH AND NORTH OF THE CONSOLIDATED LINED FOOTPRINT (CLOSURE-BY-REMOVAL AREAS) AS NEEDED TO GRADE TO DRAIN UNDER FINAL CLOSED CONDITIONS.
- EXCAVATION GRADES WILL BE ADJUSTED AS NECESSARY DURING CLOSURE CONSTRUCTION BASED ON APPLYING THE ABOVE CRITERIA TO THE ACTUAL FIELD-LOCATED BOTTOM OF CCR, AS WELL AS BASED ON FOUNDATION EVALUATIONS AND IMPROVEMENTS CONDUCTED IN ACCORDANCE WITH THE "FOUNDATION IMPROVEMENT PLAN" (INCLUDED IN THE "CLOSURE PLAN" IN PART A, SECTION 7 OF THIS PERMIT APPLICATION).
- MATERIAL PROPERTIES FOR THE FILL SOIL, LINER SYSTEM, LEACHATE COLLECTION SYSTEM, AND FINAL COVER SYSTEM ARE PROVIDED IN THE "CONSTRUCTION QUALITY ASSURANCE (CQA) PLAN" (PART A, SECTION 5 OF THIS PERMIT APPLICATION).
- DEWATERING OF CCR DURING CLOSURE CONSTRUCTION WILL BE PERFORMED AS NEEDED.
- INTERIM STORM WATER MANAGEMENT DURING CLOSURE CONSTRUCTION - INCLUDING MANAGEMENT OF CONTACT WATER AND "CLEAN" (I.E., NON-CONTACT) STORMWATER - WILL BE CONDUCTED IN ACCORDANCE WITH THE STORMWATER AND CONTACT WATER MANAGEMENT PROCEDURES DESCRIBED IN THE "CLOSURE PLAN" (PART A, SECTION 7 OF THIS PERMIT APPLICATION). IN SUMMARY, CONTACT WATER WILL BE PUMPED OR CONVEYED BY GRAVITY TO DESIGNATED STORAGE AREAS IN AP-1, WHERE IT WILL BE PUMPED TO AN ON-SITE WASTEWATER TREATMENT SYSTEM (WWTS) OR OTHERWISE PROPERLY MANAGED IN ACCORDANCE WITH THE PLANT'S NPDES PERMIT REQUIREMENTS AND THEN DISCHARGED OFF-SITE VIA NPDES OUTFALL NO. 01A. NON-CONTACT STORMWATER WILL BE DISCHARGED TO RECEIVING WATER BODIES WITHOUT TREATMENT.
- DUST CONTROL DURING CLOSURE CONSTRUCTION WILL BE MANAGED AS DESCRIBED IN THE "CLOSURE PLAN" (PART A, SECTION 7 OF THIS PERMIT APPLICATION).
- INTERNAL HAUL ROADS, ACCESS RAMPS, AND INTERIM STORMWATER FEATURE LOCATIONS WILL BE EVALUATED AS PART OF THE DETAILED DESIGN. ADDITIONAL BERMS AND EXTERIOR DIVERSIONS WILL BE CONSTRUCTED, AS NEEDED, TO ADEQUATELY MANAGE STORMWATER RUNOFF.
- VOLUME OF IN-PLACE CCR TO BE REMOVED FROM AP-1 IS ESTIMATED TO DECREASE (SHRINK) BY APPROXIMATELY 10 PERCENT UPON DEWATERING, PLACEMENT, AND COMPACTION WITHIN THE CONSOLIDATED LINED FOOTPRINT. AS PHASED CLOSURE CONSTRUCTION PROGRESSES, ACTUAL CCR QUANTITIES AND SHRINKAGE FACTORS WILL BE TRACKED AND COMPARED TO THE REMAINING CAPACITY, AND THE SIZE OF THE CONSOLIDATED LINED FOOTPRINT AND/OR ELEVATIONS OF THE FINAL COVER GRADES WILL BE REVISED ACCORDINGLY TO ACCOMMODATE THE ACTUAL SITE-SPECIFIC CCR VOLUME, WHILE MAINTAINING COMPLIANCE WITH APPLICABLE DESIGN CRITERIA.



PERMIT DRAWING  
NOT FOR CONSTRUCTION

0	AUG. 2021	SUBMITTAL TO GA EPD	JV/KH	RB
REV	DATE	DESCRIPTION	DRN	APP
LEGENDS, ABBREVIATIONS, AND REFERENCE NOTES				
PLANT BOWEN ASH POND 1 (AP-1) CLOSURE DRAWINGS BARTOW COUNTY, GEORGIA				
<b>Geosyntec</b> consultants				
1255 ROBERTS BOULEVARD, NW, SUITE 200 KENNESAW, GEORGIA 30144 USA			PHONE: 678.202.9600 WWW.GEOSYNTEC.COM	
PROJ. NO.	GR6601	DWG.	GR6601-002	EDIT 08.16.21
SCALE	N/A	DRAWING 2 OF 50		
DATE	AUGUST 2021			



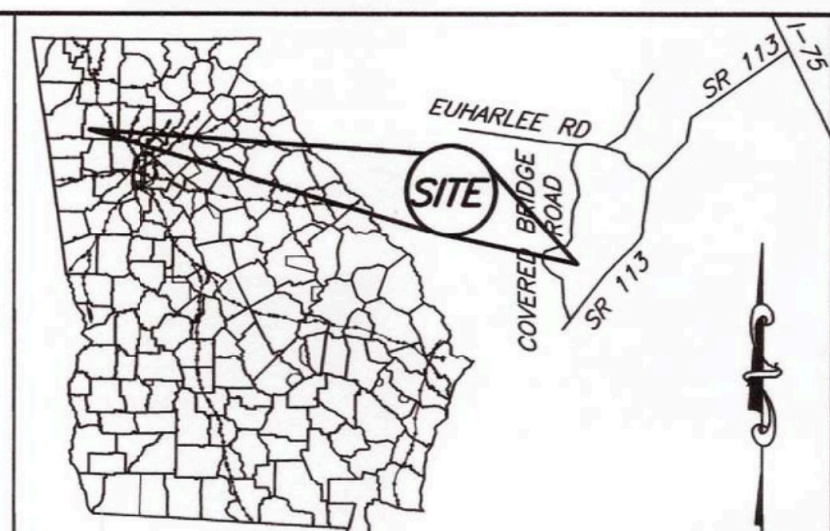

LOCATION MAP - NOT TO SCALE

- | MONUMENTATION LEGEND                     | UTILITY LEGEND            |
|--|---------------------------|
| ● Iron Pin Set                           | Ⓢ Electric Manhole        |
| ● Iron Pin Found                         | Ⓢ Electric Meter          |
| ● Monument Set                           | Ⓢ Gas Manhole             |
| ● 5" x 5" Concrete Monument Found        | Ⓢ Gas Valve               |
| ● Computed Point                         | Ⓢ Gas Meter               |
| Ⓢ Control or Traverse Point              | Ⓢ Sanitary Sewer Manhole  |
| Ⓢ Geodetic Control Point                 | Ⓢ Sanitary Sewer Cleanout |
| Ⓢ Benchmark or Temporary Benchmark (TBM) | Ⓢ Storm Sewer Manhole     |
|  | Ⓢ Telephone Manhole       |
|  | Ⓢ Water Manhole           |
|  | Ⓢ Water Valve             |
|  | Ⓢ Water Meter             |
|  | Ⓢ Fire Hydrant            |
|  | Ⓢ Well                    |
|  | Ⓢ Power Pole              |
|  | Ⓢ Transmission Tower      |
|  | Ⓢ Guy Wire                |

## PLAT ABBREVIATIONS

- NOTES AND REFERENCES**

  - 1) THE SURVEY SHOWN HEREON IS A SPECIAL PURPOSE SURVEY TO ESTABLISH THE BOUNDARY OF THE PLANT BOWEN ASH POND 1 PERMITTED LANDS PER THE REQUIREMENTS OF THE STATE OF GEORGIA, DEPARTMENT OF NATURAL RESOURCES, ENVIRONMENTAL PROTECTION DIVISION.
  - 2) BACKGROUND INFORMATION SHOWN HEREON TAKEN FROM FIELDWORK PERFORMED BY METRO ENGINEERING, INC. FOR AN AERIAL LAND TOPOGRAPHIC SURVEY, DATED 4/1/2017.
  - 3) RIGHT-OF-WAY INFORMATION FOR COVERED BRIDGE ROAD SHOWN HEREON TAKEN FROM FIELD WORK PERFORMED BY JACOBS ENGINEERING INC., FOR A SURVEY TITLED "PLANT BOWEN ASH POND DEDICATION OF COVERED BRIDGE ROAD, OLD STILESBORO ROAD, AND ATWOOD ROAD", DATED AUGUST 1, 2011, GPC MAP FILE NO. P-256-1.
  - 4) LOCATION OF RIGHT-OF-WAY MONUMENTS ALONG THE COMMON LINE BETWEEN THE PLANT BOWEN ASH POND 1 PERMITTED LANDS BOUNDARY AND THE RIGHT-OF-WAY OF COVERED BRIDGE ROAD WERE VERIFIED BY ADDITIONAL SURVEY FIELDWORK ON SEPTEMBER 28, 2018.
  - 5) REFERENCE WAS MADE TO THE FOLLOWING MAPS & SURVEYS;
    - A.) SURVEY PREPARED BY CLYDE N. ELDRIDGE AERIAL SURVEYS TITLED "TETOWAH RIVER PROJECT (N.K.A. PLANT BOWEN)", DATED MAY 10, 1967, GPC MAP FILE NO. E1-D.
    - B.) SURVEY PREPARED BY SMITH & SMITH SURVEYORS, P.C. TITLED "QUITCLAIM SURVEY FOR BARTOW COUNTY PORTION OF COVERED BRIDGE ROAD CONVEYED TO GEORGIA POWER COMPANY", DATED 5/30/2008, GPC MAP FILE NO. P119-8.

LEGAL DESCRIPTION  
PLANT Bowen - Ash Pond 1  
PERMITTED BOUNDARY AREA

NORTH TRACT OR PARCEL LAND LYING AND BEING IN LAND LOTS 764, 765, 820, 821, 822, 835, 836, 837, 892, 893, 894, 907, 908 and 909 of THE 17TH DISTRICT, 3RD SECTION OF BARTOWN COUNTY, CITY OF BARTOWN, GEORGIA, MORE PARTICULARLY DESCRIBED AS FOLLOWS:

BEGINNING AT A CONCRETE RIGHT-OF-WAY MONUMENT ON THE EAST SIDE OF COVERED BRIDGE ROAD (RIGHT-OF-WAY WITH VARIOUS) HAVING GEORGRAPHY PLANE WEST COORDINATES NAD 83(94) OF NORTH 1,505,539.09 AND EAST 2,065,857.75; THENCE SOUTH 305°59'16" EAST A DISTANCE OF 773.45 FEET TO A POINT; THENCE SOUTH 56°14'47" EAST A DISTANCE OF 69.73 FEET TO A POINT; THENCE SOUTH 76°39'05" EAST A DISTANCE OF 1076.61 FEET TO A POINT; THENCE SOUTH 06°29'22" EAST A DISTANCE OF 173.84 FEET TO A POINT; THENCE SOUTH 0°05'00" WEST A DISTANCE OF 10.02 FEET TO A POINT; THENCE SOUTH 76°39'05" WEST A DISTANCE OF 66.26 FEET TO A POINT; THENCE SOUTH 16°49'09" WEST A DISTANCE OF 88.84 FEET TO A POINT; THENCE SOUTH 26°57'53" WEST A DISTANCE OF 101.02 FEET TO A POINT; THENCE SOUTH 32°27'25" WEST A DISTANCE OF 340.69 FEET TO A POINT; THENCE SOUTH 32°32'11" WEST A DISTANCE OF 110.19 FEET TO A POINT; THENCE SOUTH 32°14'32" WEST A DISTANCE OF 185.80 FEET TO A POINT; THENCE SOUTH 17°02'00" WEST A DISTANCE OF 10.02 FEET TO A POINT; THENCE SOUTH 0°05'00" WEST A DISTANCE OF 10.02 FEET TO A POINT; THENCE SOUTH 22°39'27" WEST A DISTANCE OF 78.79 FEET TO A POINT; THENCE SOUTH 17°43'09" WEST A DISTANCE OF 49.93 FEET TO A POINT; THENCE SOUTH 13°38'04" WEST A DISTANCE OF 47.63 FEET TO A POINT; THENCE SOUTH 15°17'27" WEST A DISTANCE OF 34.98 FEET TO A POINT; THENCE SOUTH 09°38'17" WEST A DISTANCE OF 25.28 FEET TO A POINT; THENCE SOUTH 07°51'47" WEST A DISTANCE OF 92.48 FEET TO A POINT; THENCE SOUTH 0°05'00" WEST A DISTANCE OF 10.02 FEET TO A POINT; THENCE SOUTH 03°59'21" WEST A DISTANCE OF 32.24 FEET TO A POINT; THENCE SOUTH 02°30'06" WEST A DISTANCE OF 46.34 FEET TO A POINT; THENCE SOUTH 02°30'38" WEST A DISTANCE OF 114.37 FEET TO A POINT; THENCE SOUTH 02°33'49" WEST A DISTANCE OF 72.12 FEET TO A POINT; THENCE SOUTH 02°23'51" WEST A DISTANCE OF 45.42 FEET TO A POINT; THENCE SOUTH 02°26'24" WEST A DISTANCE OF 507.81 FEET TO A POINT; THENCE SOUTH 0°05'00" WEST A DISTANCE OF 10.02 FEET TO A POINT; THENCE SOUTH 0°05'00" WEST A DISTANCE OF 51.84 FEET TO A POINT; THENCE SOUTH 00°45'33" WEST A DISTANCE OF 321.53 FEET TO A POINT; THENCE SOUTH 00°06'50" EAST A DISTANCE OF 909.94 FEET TO A POINT; THENCE SOUTH 00°17'22" WEST A DISTANCE OF 214.11 FEET TO A POINT; THENCE SOUTH 00°40'09" WEST A DISTANCE OF 109.55 FEET TO A POINT; THENCE SOUTH 01°52'17" WEST A DISTANCE OF 130.90 FEET TO A POINT; THENCE SOUTH 34°31'55" WEST A DISTANCE OF 30.28 FEET TO A POINT; THENCE SOUTH 0°05'00" WEST A DISTANCE OF 10.02 FEET TO A POINT; THENCE NORTH 22°32'54" EAST A DISTANCE OF 241.19 FEET TO A POINT; THENCE NORTH 68°17'14" WEST A DISTANCE OF 2273.67 FEET TO A POINT; THENCE NORTH 01°34'19" WEST A DISTANCE OF 625.42 FEET TO A POINT; THENCE NORTH 06°19'01" WEST A DISTANCE OF 812.07 FEET TO A POINT; THENCE NORTH 01°52'17" EAST A DISTANCE OF 1452.94 FEET TO A POINT; THENCE NORTH 00°09'28" EAST A DISTANCE OF 1402.29 FEET TO A POINT; THENCE SOUTH 00°05'00" EAST A DISTANCE OF 10.02 FEET TO A POINT; THENCE RIGHT-OF-WAY MONUMENT ON THE RIGHT-OF-WAY OF COVERED BRIDGE ROAD; THENCE ALONG SAID RIGHT-OF-WAY SOUTH 79°19'06" EAST A DISTANCE OF 298.60 FEET TO A CONCRETE RIGHT-OF-WAY MONUMENT; THENCE SOUTH 87°33'15" EAST A DISTANCE OF 335.01 FEET TO THE POINT OF BEGINNING.

SAT TRACT CONTAINING 300.00 ACRES MORE OR LESS AND BEING MORE FULLY DEPICTED ON A PLAT OF SAID PREPARED BY JAMES W. TILLEY, JR., REGISTERED PROFESSIONAL SURVEYOR, BARTOWN, GEORGIA, DATED 10/15/2018, GPC MAP FILE NO. P469-1, SAID PLAT IS INCORPORATED HEREBY BY REFERENCE.

GEORGE POWER CO. ATLANTA GA									
-----------------------------	--	--	--	--	--	--	--	--	--

### SURVEY ACCURACY STATEMENT

LATITUDE: N34°07'45.09"  
LONGITUDE: W84°55'47.53"

F.I.R.M. FLOOD NOTE:  
A PORTION OF THE PROPERTY SHOWN HEREON IS  
LOCATED IN ZONE X AND ZONE A, PER FEDERAL  
INSURANCE RATE MAP OF BARTOW COUNTY, GEORGIA,  
PANEL 335 OF 385, MAP NUMBER 13015C0335G AND  
PANEL 245 OF 385, MAP NUMBER 13015C0245G,  
EFFECTIVE DATE: SEPTEMBER 28, 2007.




AS REQUIRED BY SECTION (D) OF O.C.G.A. SECTION 5-6-67, THIS PLAT HAS BEEN PREPARED BY A LAND SURVEYOR. THIS PLAT HAS BEEN APPROVED BY ALL APPLICABLE LOCAL JURISDICTIONS THAT REQUIRE PRIOR APPROVAL FOR RECORDING THIS TYPE OF PLAT OR ONE OR MORE OF THE APPLICABLE LOCAL JURISDICTIONS THAT REQUIRE RECORDING OF THIS TYPE OF PLAT. THE NAMES OF THE AGENCIES SIGNING OR APPROVING THIS PLAT, THE AGENCY OR OFFICE OF THAT INDIVIDUAL, AND THE DATE OF APPROVAL ARE LISTED IN THE APPROVAL TABLE SHOWN HEREON. FOR ANY APPLICABLE LOCAL JURISDICTION THAT DOES NOT REQUIRE PRIOR APPROVAL, THE NAME OF THAT JURISDICTION, THE NAME OF THE AGENCY OR OFFICE, AND THE NUMBER OF THE APPLICABLE ORDINANCE OR RESOLUTION PROVIDING THAT NO SUCH APPROVAL IS REQUIRED ARE LISTED IN THE APPROVAL TABLE SHOWN HEREON. SUCH APPROVALS, AFFIRMATIONS, OR ORDINANCE OR RESOLUTIONS ARE NOT GUARANTEES OF THE ACCURACY OF THE INFORMATION CONTAINED HEREON. THE PURCHASER OR USER OF THIS PLAT IS TO INTEND WITH THE APPROPRIATE GOVERNMENTAL AGENCIES BY HIS OR HER UNDERSTANDING LAND SURVEYOR CERTIFIES THAT THIS PLAT COMPLIES WITH THE MINIMUM TECHNICAL STANDARDS FOR PROPERTY SURVEYS IN GEORGIA AS SET FORTH IN THE RULES AND REGULATIONS OF THE BOARD OF REGISTRATION OF PROFESSIONAL ENGINEERS AND LAND SURVEYORS AND AS SET FORTH IN O.C.G.A. SECTION 5-6-67.

William H. Bechtler 9-23-2019  
 WILLIAM H. BECHTLER, GA PLS NO. 3055 DATE

LINE TABLE											
LINE	BEARING	DIST	LINE	BEARING	DIST	LINE	BEARING	DIST	LINE	BEARING	DIST
L1	S30°59'16"E	733.45	L12	S30°00'00"W	33.53	L23	S02°30'38"W	114.37	L34	S34°31'55"W	304.64
L2	S56°14'47"E	69.73	L13	S26°13'46"W	80.22	L24	S02°53'49"W	72.12	L35	N67°27'06"W	255.68
L3	S76°39'05"E	1076.61	L14	S22°39'27"W	78.79	L25	S02°23'51"W	452.42	L36	N22°32'54"E	241.19
L4	S06°29'22"E	173.84	L15	S17°43'09"W	49.93	L26	S02°26'24"W	507.81	L37	N68°17°14"	2273.67
L5	S01°38'41"W	38.52	L16	S13°38'04"W	47.63	L27	S02°51°01"W	251.35	L38	N01°34'19"W	625.42
L6	S10°01'24"W	66.26	L17	S11°57'22"W	34.98	L28	S02°01'12"E	51.84	L39	N06°19'01"W	812.07
L7	S16°49'09"W	88.84	L18	S09°38'17"W	25.28	L29	S00°45'33"W	321.53	L40	N00°02'59"E	1452.94
L8	S26°57'53"W	101.02	L19	S07°51'47"W	42.34	L30	S00°06'50"W	909.94	L41	N00°09'28"E	1482.29
L9	S32°27'25"W	340.69	L20	S04°40'42"W	56.46	L31	S00°01'27"W	214.11	L42	S69°35'38"E	1100.66
L10	S32°32'11"W	110.19	L21	S03°59'21"W	32.24	L32	S00°40'09"W	109.55	L43	N7°19'01"E	296.60
L11	S32°14'32"W	185.80	L22	S02°30'06"W	96.48	L33	S01°52'17"W	130.90	L44	S87°33'15"E	335.01



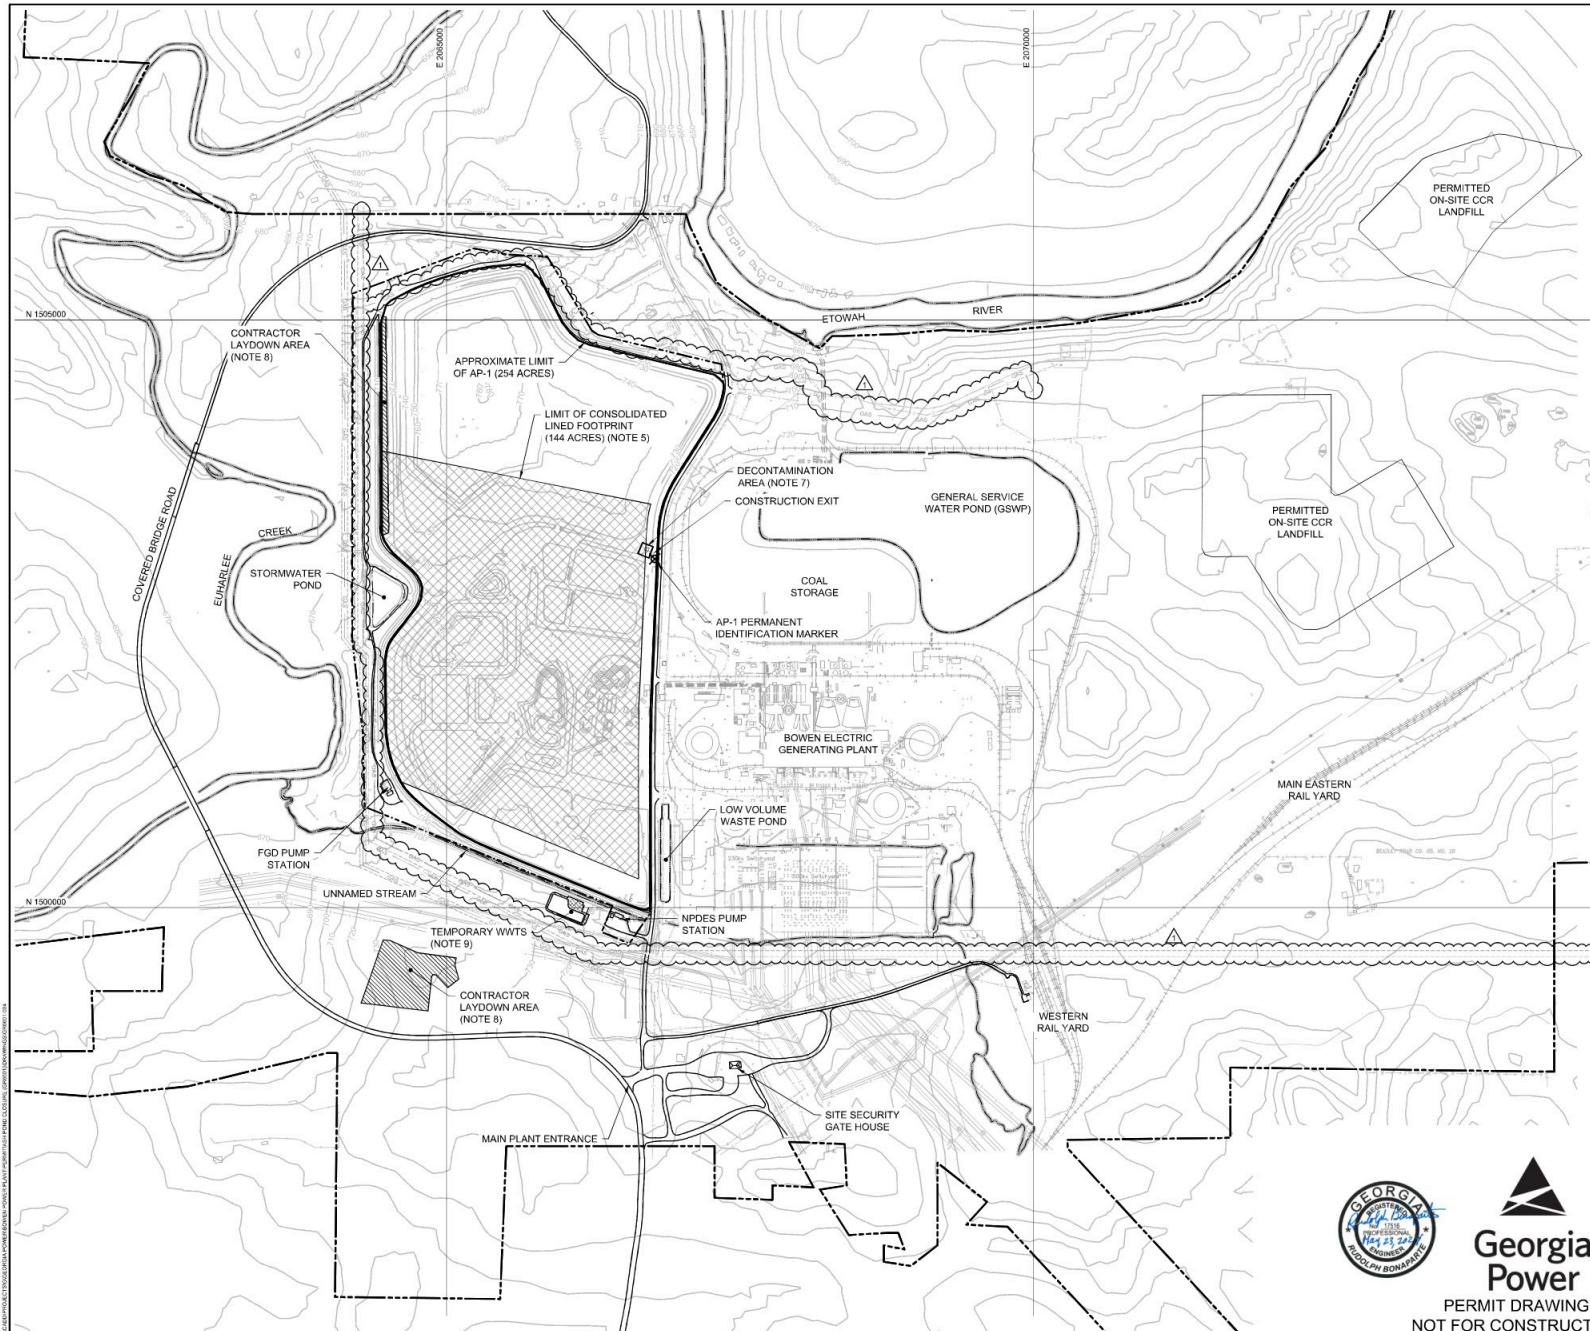

**LEGEND**

- EXISTING GROUND ELEVATION (FEET) (NOTE 1)
- MAIN SITE AND AP-1 ACCESS ROAD
- APPROXIMATE EXISTING LIMIT OF AP-1 (NOTE 1)
- LIMIT OF CONSOLIDATED LINED FOOTPRINT (NOTE 5)
- PROPERTY BOUNDARY
- PERMIT BOUNDARY (NOTE 6)
- TEMPORARY WWTS PAD



- NOTES:**
- SEE DRAWING 2 FOR LEGENDS, ABBREVIATIONS, AND GENERAL SITE NOTES.
  - ACREAGE OF AP-1 REPRESENTS THE TWO-DIMENSIONAL (2D) PLAN AREA WITHIN THE ESTIMATED AP-1 LIMITS ALSO REPRESENTING THE POTENTIAL LATERAL LIMITS OF CCR.
  - TOPOGRAPHIC CONTOUR INTERVALS ARE PRESENTED AT 10-FT INTERVALS ON THIS DRAWING. FOR CLARITY, SEE DRAWING 5 FOR TOPOGRAPHIC CONTOURS AT 2-FT CONTOUR INTERVALS.
  - SEE DRAWING 5 FOR AN EXISTING CONDITIONS PLAN IN THE VICINITY OF AP-1, SHOWN AT AN ENLARGED SCALE.
  - LIMIT OF CONSOLIDATED LINED FOOTPRINT REFERS TO LIMIT OF LINER.
  - ALONG EASTERN SIDE OF AP-1, PERMIT BOUNDARY IS ALIGNED WITH APPROXIMATE LIMIT OF AP-1, AND THUS OBLISCURED IN THIS AREA ON THIS DRAWING. REFER TO DRAWING 3 FOR THE PERMIT BOUNDARY SURVEY AND LEGAL DESCRIPTION.
  - A DECONTAMINATION STATION WILL BE ESTABLISHED AT THE APPROXIMATE LOCATION SHOWN. EQUIPMENT WILL BE DECONTAMINATED (I.E. CCR PARTICLES REMOVED) PRIOR TO EXITING THE AP-1 FOOTPRINT. AS PHASED CLOSURE CONSTRUCTION APPROACHES THIS AREA, THE DECONTAMINATION STATION MAY BE RELOCATED SLIGHTLY AS NEEDED TO ACCOMMODATE CONSTRUCTION OPERATIONS.
  - CONTRACTOR LAYDOWN AREAS FOR STAGING OF CONSTRUCTION MATERIALS AND EQUIPMENT WILL BE AT THE APPROXIMATE LOCATIONS SHOWN. EQUIPMENT MAY ALSO BE STAGED WITHIN THE AP-1 ADJACENT TO WORK AREAS.
  - A TEMPORARY WWTS WILL BE ESTABLISHED AT THE APPROXIMATE LOCATION SHOWN FOR TREATMENT OF LEACHATE AND CONTACT WATER GENERATED DURING CLOSURE CONSTRUCTION. AT THE COMPLETION OF CLOSURE CONSTRUCTION, LEACHATE WILL BE ROUTED TO A PERMANENT ON-SITE WWTS LOCATED OUTSIDE THE AP-1 PERMIT BOUNDARY, ON THE PLANT BOWEN PROPERTY.




1	MAY 2024	UPDATE AND ADD GAS PIPELINES	JZV	RSB
3	AUG. 2021	SUBMITTAL TO GA EPD	JAN/H	RSB
REV	DATE	DESCRIPTION	DWN	APP
SITE PLAN				
PLANT BOWEN ASH POND 1 (AP-1) CLOSURE DRAWINGS BARTOW COUNTY, GEORGIA				
<div>Geosyntec<sup>®</sup> consultants</div> <div>1305 ROBERTS ROAD, SUITE 200 KENNESAW, GEORGIA 30144 USA</div> <div>PHONE: 678.202.9500 WWW.GEOSYNTEC.COM</div>				
PROJ. NO.	GR6601	DWG.	GR6601-004	EDIT 5/23/24
SCALE	1" = 500'	DRAWING 4 OF 50		
DATE	AUGUST 2021			



**PERMIT DRAWING**  
**NOT FOR CONSTRUCTION**




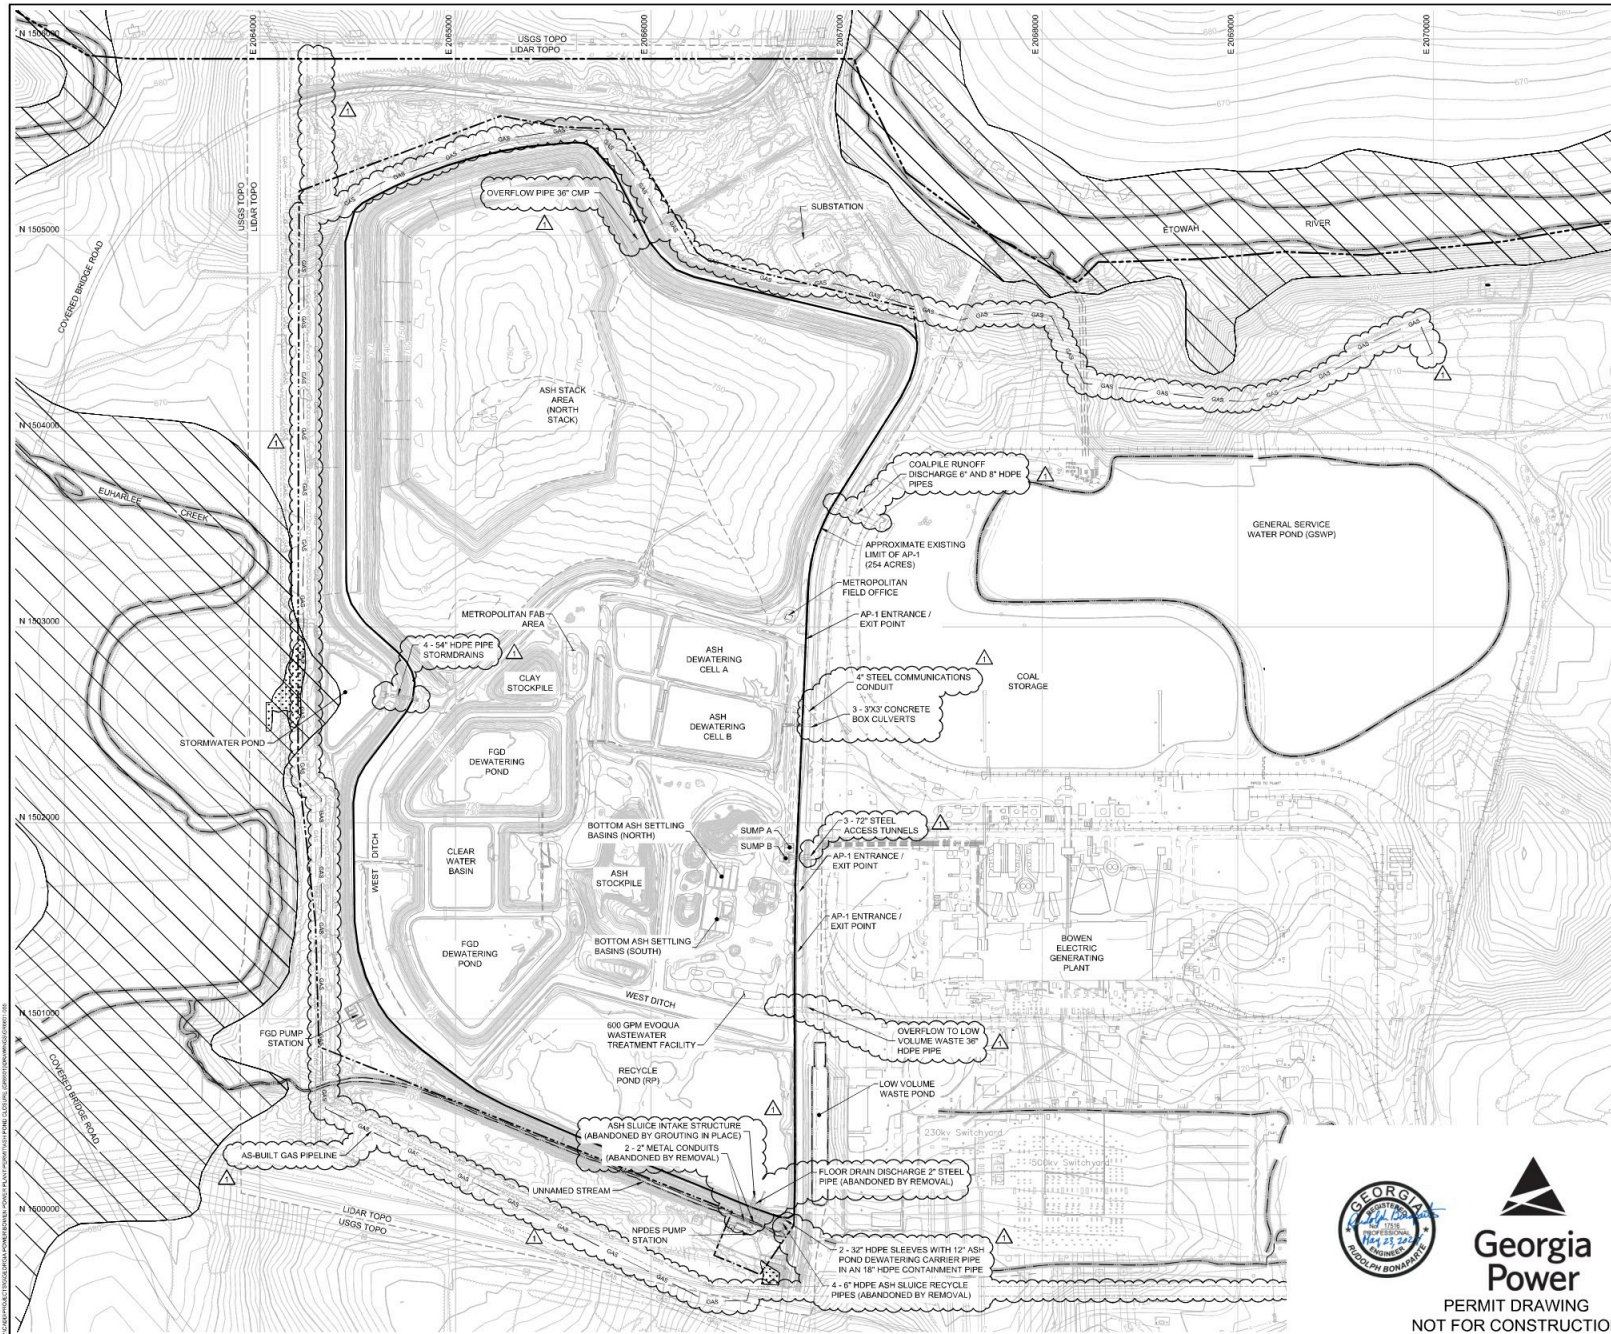

**LEGEND**

- EXISTING GROUND ELEVATION (FEET) (NOTE 1)
- EXISTING ROAD
- EXISTING PIPE
- PLANT BUILDINGS / STRUCTURES
- WATER LINE / CREEK
- APPROXIMATE EXISTING LIMIT OF AP-1 (NOTE 1)
- PERMIT BOUNDARY
- WETLAND (NOTE 4)
- 100-YEAR FLOODPLAIN (NOTE 4)
- EXISTING PIPE PENETRATION (NOTE 6)
- AS-BUILT GAS PIPELINE (NOTE 7)

- NOTES:**
- SEE DRAWING 2 FOR LEGENDS, ABBREVIATIONS, AND GENERAL SITE NOTES.
  - TOPOGRAPHIC CONTOURS ARE PRESENTED AT 2-FT INTERVALS.
  - WETLAND LOCATIONS ARE AS DELINEATED BY ECOLOGICAL SOLUTIONS, INC. IN JUNE 2018.
  - 100-YEAR FLOODPLAIN IS TAKEN FROM FEMA FLOOD INSURANCE RATE MAP NUMBERS 13015C0245G AND 13015C0335G, BOTH DATED 28 SEPTEMBER 2007.
  - ALONG EASTERN SIDE OF AP-1, PERMIT BOUNDARY IS APPROXIMATE WITH APPROXIMATE LIMIT OF AP-1, AND THUS OCCURRED IN THIS AREA ON THIS DRAWING. REFER TO DRAWING 3 FOR THE PERMIT BOUNDARY SURVEY AND LEGAL DESCRIPTION.
  - PIPE PENETRATIONS SHOWN ON THIS DRAWING ARE APPROXIMATE. IF PIPE ABANDONMENT IS NECESSARY TO SUPPORT CONSTRUCTION ACTIVITIES, PIPES WILL BE ABANDONED WITHIN THE LIMITS OF AP-1 USING ONE OF THE FOLLOWING PROCEDURES: (i) REMOVAL OF THE PIPES, (ii) FILLING WITH FLOWABLE FILL OR GROUTED IN PLACE AND THEN CAPPING (E.G. FLANGES) TO ENSURE A PROPER SEAL, OR (iii) OTHER EQUIVALENT ABANDONMENT PROCEDURE AS APPROVED BY ENGINEER AND OWNER.
  - THE GAS PIPELINE WAS INSTALLED BY ATLANTA GAS LIGHT COMPANY AND THE AS-BUILT DRAWING FOR THE PIPELINE WAS PROVIDED TO GPC ON 8 JANUARY 2024. THE PIPE IS SIX INCHES IN DIAMETER, WITH A MINIMUM OF FOUR FEET OF COVER, AND HAS A MINIMUM SETBACK OF 14 FEET FROM THE GROUNDWATER MONITORING WELLS.

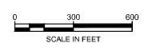

1	MAY 2024	UPDATE / ADD GAS PIPELINES AND PIPE PENETRATIONS	JDV	RSB
2	AUG 2021	SUBMITTAL TO GA EPD	JAN/HR	RSB
REV	DATE	DESCRIPTION	BY	APP

EXISTING SITE CONDITIONS AND TOPOGRAPHY				
PLANT BOWEN ASH POND 1 (AP-1) CLOSURE DRAWINGS BARTOW COUNTY, GEORGIA				
<div>Geosyntec<sup>®</sup> consultants</div>				
1305 ROBERTS ROAD, SUITE 200 KENNESAW, GEORGIA 30144 USA PHONE: 478.302.9500 WWW.GEOSYNTEC.COM				
PROJ. NO.	GR6601	DWG.	GR6601-005	EDIT 5/23/24
SCALE	1" = 300'		DRAWING 5 OF 50	
DATE	AUGUST 2021			



**Georgia Power**  
PERMIT DRAWING  
NOT FOR CONSTRUCTION





LEGEND	
	APPROXIMATE BOTTOM OF CCR SURFACE ELEVATION (FEET) (NOTES 2, 3, AND 4)
	PERMIT BOUNDARY (NOTE 5)
	APPROXIMATE EXISTING LIMIT OF AP-1 (NOTE 1)

- NOTES:
- SEE DRAWING 2 FOR LEGENDS, ABBREVIATIONS, AND GENERAL SITE NOTES.
  - CONTOURS SHOWN ON THIS DRAWING WITHIN LIMITS OF AP-1 REPRESENT BOTTOM OF AP-1 (I.E. BOTTOM OF CCR) GRADES. SEE NOTE 9 ON DRAWING 2. CONTOURS SHOWN ON THIS DRAWING BEYOND LIMITS OF AP-1 ARE EXISTING GROUND TOPOGRAPHY.
  - DURING CLOSURE CONSTRUCTION, CONTRACTOR WILL VERIFY BOTH LATERAL AND VERTICAL EXTENTS OF CCR IN THE FIELD.
  - AREAS WITHIN LATERAL EXTENT OF CCR IN AP-1 (AS FIELD-VERIFIED DURING CLOSURE CONSTRUCTION) WILL HAVE AN ADDITIONAL SIX-INCHES MINIMUM OF MATERIAL REMOVAL BELOW BOTTOM OF CCR EXCAVATED CCR (INCLUDING SIX-INCHES MINIMUM OF ADDITIONAL MATERIAL EXCAVATION) WILL BE PLACED IN THE CONSOLIDATED LINED AREA.
  - ALONG EASTERN SIDE OF AP-1, PERMIT BOUNDARY IS ALIGNED WITH APPROXIMATE LIMIT OF AP-1, AND THUS OBTAINED IN THIS AREA ON THIS DRAWING. REFER TO DRAWING 3 FOR THE PERMIT BOUNDARY SURVEY AND LEGAL DESCRIPTION.



1	MAY 2024	UPDATE AND ADD GAS PIPELINES	JAV	RSB			
3	AUG. 2021	SUBMITTAL TO GA EPD	JAN/H	RSB			
REV	DATE	DESCRIPTION	DRN	APP			
APPROXIMATE BOTTOM OF AP-1 GRADES							
PLANT BOWEN ASH POND 1 (AP-1) CLOSURE DRAWINGS BARTOW COUNTY, GEORGIA							
<div>Geosyntec<sup>®</sup> consultants</div> <div>1305 ROBERTS BOULEVARD, SUITE 200 KENNESAW, GEORGIA 30144 USA PHONE: 678.302.9500 WWW.GEOSYNTEC.COM</div>							
PROJ. NO.		GR6601		DWG.	GR6601-006	EDIT	5/23/24
SCALE		1" = 300'		DRAWING 6 OF 50			
DATE		AUGUST 2021					



PERMIT DRAWING  
NOT FOR CONSTRUCTION





# LEGEND

- EXCAVATION SURFACE ELEVATION (FEET)  
(NOTES 2 AND 3)
- PERMIT BOUNDARY (NOTE 4)
- APPROXIMATE EXISTING LIMIT OF AP-1 (NOTE 1)
- CONSOLIDATED AREA FOUNDATION  
IMPROVEMENTS (NOTE 3)
- OTHER AREA FOUNDATION IMPROVEMENTS  
(NOTE 3)

## NOTES:

- SEE DRAWING 2 FOR LEGENDS, ABBREVIATIONS, AND GENERAL SITE NOTES.
- EXCAVATION CONTOURS ON THIS DRAWING ARE THE SAME AS DRAWING 8. SEE NOTE 3, DRAWING 8 FOR BASIS FOR EXCAVATION CONTOURS.
- FOUNDATION IMPROVEMENTS WILL BE PERFORMED IN ACCORDANCE WITH THE FOUNDATION IMPROVEMENT PLAN INCLUDED WITH THIS PERMIT APPLICATION. A SUMMARY OF ACTIVITIES IS PROVIDED BELOW.
  - CONSOLIDATED LINED AREAS: AS HIGHLIGHTED ON THIS DRAWING, WITHIN THE FLOOR AREAS OF THE CONSOLIDATED LINED FOOTPRINT AND BENEATH THE BASE OF THE NEW NORTH AND SOUTH DIKES, AFTER REMOVAL OF CCR (AND SIX INCHES OF ADDITIONAL MATERIAL BELOW CCR), THE FOLLOWING ACTIVITIES WILL BE PERFORMED: (i) ADDITIONAL OVER-EXCAVATION AS PRESENTED AND DESCRIBED ON DRAWING 6; (ii) FOUNDATION EVALUATION AND MITIGATION IN ACCORDANCE WITH THE FOUNDATION IMPROVEMENT PLAN; (iii) COMPACTED SOIL FILL PLACEMENT TO ACHIEVE LINER SUBGRADE (BOTTOM OF CLAY LINER) GRADES.
  - OTHER AREAS: AS HIGHLIGHTED ON THIS DRAWING, WITHIN AP-1 IN THE OTHER AREAS BEYOND THE CONSOLIDATED LINED AREA (PRIMARILY TO THE NORTH AND SOUTH), AFTER REMOVAL OF CCR (AND SIX INCHES OF ADDITIONAL MATERIAL BELOW CCR), THE FOLLOWING ACTIVITIES WILL BE PERFORMED: (i) ADDITIONAL EXCAVATION AS PRESENTED AND DESCRIBED ON DRAWING 8; (ii) FOUNDATION EVALUATION AND MITIGATION IN ACCORDANCE WITH THE FOUNDATION IMPROVEMENT PLAN; (iii) COMPACTED SOIL FILL PLACEMENT AS NEEDED TO GRADE TO DRAIN UNDER FINAL CLOSED CONDITIONS.
- ALONG EASTERN SIDE OF AP-1, PERMIT BOUNDARY IS ALIGNED WITH APPROXIMATE LIMIT OF AP-1, AND THUS OBTAINED IN THIS AREA ON THIS DRAWING. REFER TO DRAWING 3 FOR THE PERMIT BOUNDARY SURVEY AND LEGAL DESCRIPTION.



0 300 600  
SCALE IN FEET

1	MAY 2024	UPDATE AND ADD GAS PIPELINES	JDV	RSB
2	AUG 2021	SUBMITTAL TO GA EPD	JAV/HH	RSB
REV	DATE	DESCRIPTION	BY	APP
FOUNDATION IMPROVEMENT PLAN				
PLANT BOWEN ASH POND 1 (AP-1) CLOSURE DRAWINGS BARTOW COUNTY, GEORGIA				
<b>Geosyntec</b> consultants				
<small>1305 ROBERTS ROAD, SUITE 200, KENNESAW, GEORGIA 30144 USA            PROJ. NO. GR6601 DWG. GR6601-007 EDIT 5/23/24            SCALE 1" = 300' DATE AUGUST 2021            PHONE: 478.202.9500            WWW.GEOSYNTEC.COM</small>				
DRAWING 7 OF 50				




PERMIT DRAWING  
NOT FOR CONSTRUCTION





- LEGEND**
- (670) --- EXCAVATION SURFACE ELEVATION (FEET) (NOTES 2 AND 3)
  - - - - - PERMIT BOUNDARY (NOTE 6)
  - - - - - APPROXIMATE EXISTING LIMIT OF AP-1 (NOTE 1)
  - - - - - APPROXIMATE LIMIT OF CONSOLIDATED AREA FOUNDATION IMPROVEMENTS

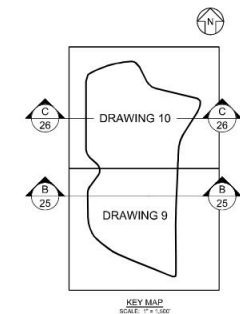

- NOTES:**
- SEE DRAWING 2 FOR LEGENDS, ABBREVIATIONS, AND GENERAL SITE NOTES.
  - CONTOURS SHOWN ON THIS DRAWING WITHIN LIMITS OF AP-1 REPRESENT ESTIMATED MINIMUM BOTTOM OF EXCAVATION GRADES. CONTOURS SHOWN ON THIS DRAWING BEYOND LIMITS OF AP-1 ARE EXISTING GROUND TOPOGRAPHY.
  - EXCAVATION SURFACE IS APPROXIMATE, AND WAS DEVELOPED BASED ON THE ESTIMATED BOTTOM OF CCR AND TO MEET THE FOLLOWING CRITERIA: (i) EXCAVATE AT LEAST SIX INCHES BELOW THE BOTTOM OF CCR SURFACE IN ALL AREAS OF AP-1; (ii) CONDUCT ADDITIONAL OVER EXCAVATION AS NEEDED BENEATH THE FLOOR AREAS OF THE CONSOLIDATED LINED FOOTPRINT AND BENEATH THE BASE OF THE NEW NORTH AND SOUTH CONTAINMENT DIKES TO CONDUCT FOUNDATION IMPROVEMENTS AND PROVIDE AN 8-FT (MM) COMPACTED SOIL BUFFER ZONE BELOW THE LINER SYSTEM; AND (iii) CONDUCT ADDITIONAL EXCAVATION IN THE AREAS SOUTH AND NORTH OF THE CONSOLIDATED LINED FOOTPRINT AS NEEDED TO GRADE TO DRAIN UNDER FINAL CLOSED CONDITIONS.
  - EXCAVATION GRADES WILL BE ADJUSTED AS NECESSARY DURING CLOSURE CONSTRUCTION BASED ON APPLYING THE ABOVE CRITERIA TO THE ACTUAL FIELD-LOCATED BOTTOM OF CCR, AS WELL AS BASED ON FOUNDATION EVALUATIONS AND IMPROVEMENTS CONDUCTED IN ACCORDANCE WITH THE "FOUNDATION IMPROVEMENT PLAN" INCLUDED WITH THIS PERMIT APPLICATION.
  - EXCAVATION CONTOURS SHOWN ON THIS DRAWING ARE APPROXIMATE. ACTUAL EXCAVATION GRADES MAY EXTEND DEEPER AND SMOOTHED AS NEEDED TO FACILITATE CONSTRUCTION AND ACCOMPLISH FOUNDATION IMPROVEMENTS, FOLLOWED BY COMPACTED FILL PLACEMENT AS NECESSARY, PER NOTE 3.
  - ALONG EASTERN SIDE OF AP-1, PERMIT BOUNDARY IS ALIGNED WITH APPROXIMATE LIMIT OF AP-1, AND THUS OBLISCURED IN THIS AREA ON THIS DRAWING. REFER TO DRAWING 3 FOR THE PERMIT BOUNDARY SURVEY AND LEGAL DESCRIPTION.

0 300 600  
SCALE IN FEET




**PERMIT DRAWING**  
**NOT FOR CONSTRUCTION**

1	MAY 2024	UPDATE AND ADD GAS PIPELINES	JDV	RS
2	AUG 2021	SUBMITTAL TO GA EPD	JAN/H	RS
REV	DATE	DESCRIPTION	DRN	APP
EXCAVATION PLAN - OVERALL				
PLANT BOWEN ASH POND 1 (AP-1) CLOSURE DRAWINGS BARTOW COUNTY, GEORGIA				
<div>Geosyntec<sup>®</sup> consultants</div> <div>1305 FORBES ROAD, SUITE 200, NEW SUITE 200, KENNESAW, GEORGIA 30144 USA PHONE: 478.232.9500 WWW.GEOSYNTEC.COM</div>				
PROJ. NO.	GR6601	DWG.	GR6601-008	EDIT 5/23/24
SCALE	1" = 300'	DRAWING 8 OF 50		
DATE	AUGUST 2021			





- LEGEND
- (670)--- EXCAVATION SURFACE ELEVATION (FEET) (NOTES 2 AND 3)
  - - - - - PERMIT BOUNDARY (NOTE 6)
  - - - - - APPROXIMATE EXISTING LIMIT OF AP-1 (NOTE 1)
  - - - - - APPROXIMATE LIMIT OF CONSOLIDATED AREA FOUNDATION IMPROVEMENTS

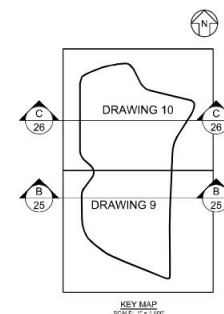

- NOTES:
- SEE DRAWING 2 FOR LEGENDS, ABBREVIATIONS, AND GENERAL SITE NOTES.
  - CONTOURS SHOWN ON THIS DRAWING WITHIN LIMITS OF AP-1 REPRESENT ESTIMATED MINIMUM BOTTOM OF EXCAVATION GRADES. CONTOURS SHOWN ON THIS DRAWING BEYOND LIMITS OF AP-1 ARE EXISTING GROUND TOPOGRAPHY.
  - EXCAVATION SURFACE IS APPROXIMATE, AND WAS DEVELOPED BASED ON THE ESTIMATED BOTTOM OF CCR AND TO MEET THE FOLLOWING CRITERIA: (i) EXCAVATE AT LEAST SIX INCHES BELOW THE BOTTOM OF CCR SURFACE IN ALL AREAS OF AP-1; (ii) CONDUCT ADDITIONAL OVER-EXCAVATION AS NEEDED BENEATH THE FLOOR AREAS OF THE CONSOLIDATED LINED FOOTPRINT AND BENEATH THE BASE OF THE NEW NORTH AND SOUTH CONTAINMENT DIKES TO CONDUCT FOUNDATION IMPROVEMENTS AND PROVIDE AN 8 FT MIN) COMPACTED SOIL BUFFER ZONE BELOW THE LINER SYSTEM; AND (iii) CONDUCT ADDITIONAL EXCAVATION IN THE AREAS SOUTH AND NORTH OF THE CONSOLIDATED LINED FOOTPRINT AS NEEDED TO GRADE TO DRAIN UNDER FINAL CLOSED CONDITIONS.
  - EXCAVATION GRADES WILL BE ADJUSTED AS NECESSARY DURING CLOSURE CONSTRUCTION BASED ON APPLYING THE ABOVE CRITERIA TO THE ACTUAL FIELD-LOCATED BOTTOM OF CCR, AS WELL AS BASED ON FOUNDATION EVALUATIONS AND IMPROVEMENTS CONDUCTED IN ACCORDANCE WITH THE FOUNDATION IMPROVEMENT PLAN\* INCLUDED WITH THIS PERMIT APPLICATION.
  - EXCAVATION CONTOURS SHOWN ON THIS DRAWING ARE APPROXIMATE. ACTUAL EXCAVATION GRADES MAY EXTEND DEEPER AND BE SMOOTHED AS NEEDED TO FACILITATE CONSTRUCTION AND ACCOMPLISH FOUNDATION IMPROVEMENTS, FOLLOWED BY COMPACTED FILL PLACEMENT AS NECESSARY. PER NOTE 3.
  - ALONG EASTERN SIDE OF AP-1, PERMIT BOUNDARY IS ALIGNED WITH APPROXIMATE LIMIT OF AP-1, AND THUS OBTAINED IN THIS AREA ON THIS DRAWING. REFER TO DRAWING 3 FOR THE PERMIT BOUNDARY SURVEY AND LEGAL DESCRIPTION.



1	MAY 2024	UPDATE AND ADD GAS PIPELINES	JZV	RSB
2	AUG 2021	SUBMITTAL TO GA EPD	JAN/H	RSB
REV	DATE	DESCRIPTION	DRN	APP
EXCAVATION PLAN - SOUTH AP-1				
PLANT BOWEN ASH POND 1 (AP-1)				
CLOSURE DRAWINGS				
BARTOW COUNTY, GEORGIA				
<div>Geosyntec consultants</div>				
1355 ROBERTS ROAD, SUITE 200 KENNESAW, GEORGIA 30144 USA			PHONE: 478.202.9530 WWW.GEOSYNTEC.COM	
PROJ. NO.	GR6601	DWG.	GR6601-009	EDIT 5/23/24
SCALE	1" = 150'	DRAWING 9 OF 50		
DATE	AUGUST 2021			




PERMIT DRAWING  
NOT FOR CONSTRUCTION








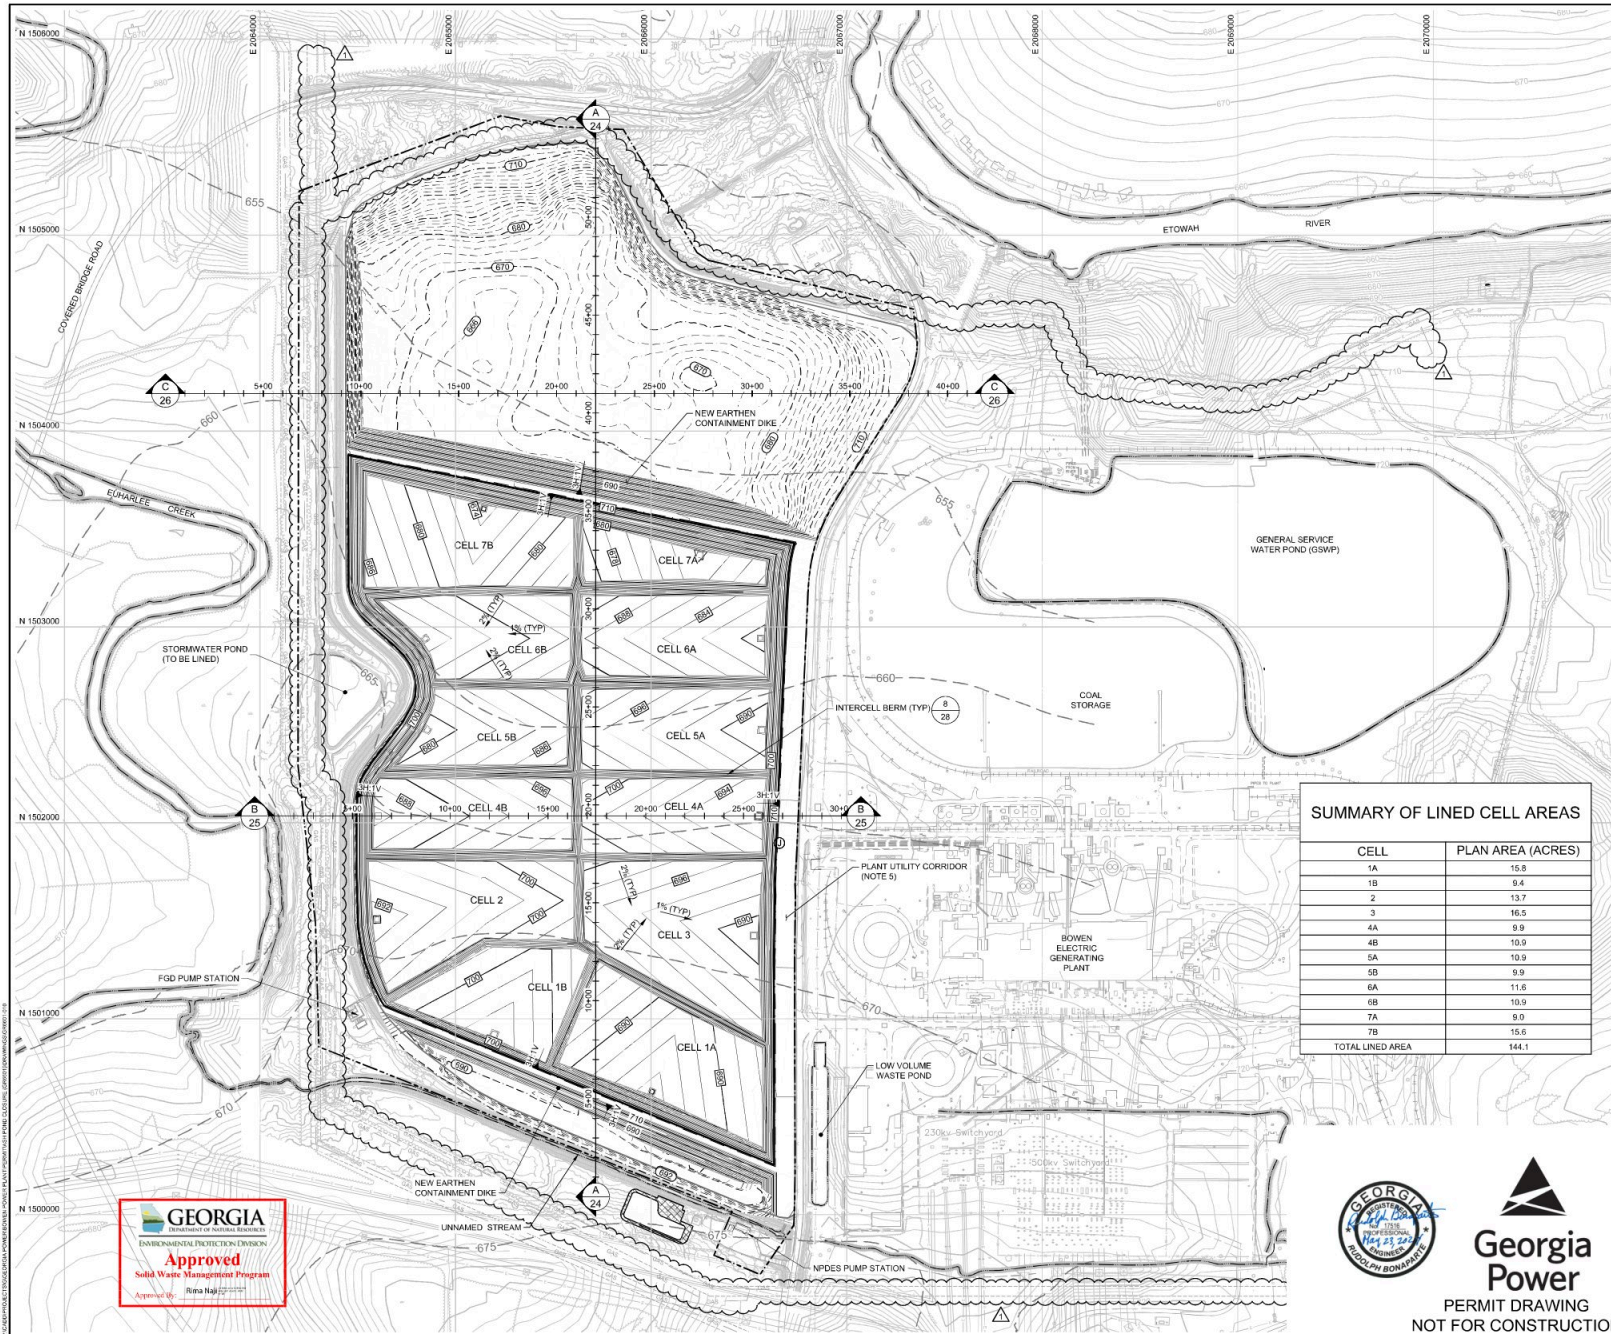

- LEGEND**
- 710 EXISTING GROUND ELEVATION (FEET) (NOTE 1)
  - 670 EXCAVATION SURFACE ELEVATION (FEET)
  - 660 TOP OF LINER ELEVATION (FEET)
  - 660 LIMIT OF LINER (NOTE 2)
  - APPROXIMATE EXISTING LIMIT OF AP-1 (NOTE 1)
  - 660 PREDICTED POST-CLOSURE SEASONAL HIGH GROUNDWATER POTENTIOMETRIC SURFACE ELEVATION (FEET) (NOTE 1)
  - TEMPORARY WWTs PAD

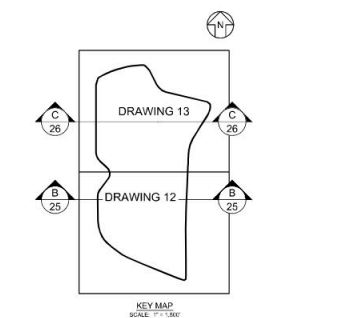

- NOTES:**
- SEE DRAWING 2 FOR LEGENDS, ABBREVIATIONS, AND GENERAL SITE NOTES.
  - TOP OF LINER GRADES SHOWN ON THIS DRAWING REPRESENT THE TOP OF THE GEOMEMBRANE COMPONENT OF THE LINER SYSTEM WITHIN THE CONSOLIDATED LINED FOOTPRINT AREA. WITHIN THE REMAINDER OF AP-1 OUTSIDE THE CONSOLIDATED LINED FOOTPRINT AREA, GRADES REPRESENT EXISTING GROUND TOPOGRAPHY. LOW POINTS OF CELLS WILL NOT BE LOWERED WITHOUT GA EPO APPROVAL. MINOR CHANGES TO LINER GRADES SHOWN ON THIS DRAWING MAY BE MADE DURING DETAILED DESIGN (E.G., RAISED TO PROVIDE SEPARATION FROM THE PREDICTED POST-CLOSURE SEASONAL HIGH GROUNDWATER POTENTIOMETRIC SURFACE PRESENTED IN THE HYDROGEOLOGIC ASSESSMENT REPORT (REVISION 37 (PART 8, SECTION 2 OF THIS PERMIT APPLICATION)). LINER GRADES MAY BE RAISED AS NECESSARY DURING CONSTRUCTION BASED ON CONDITIONS ENCOUNTERED.
  - CLOSURE WILL BE CONDUCTED IN PHASES, RESULTING IN PLAN TO CONSTRUCT LINED CELLS AND PLACE COR IN ASCENDING NUMERICAL ORDER, AS NEEDED TO FACILITATE CLOSURE CONSTRUCTION TIMING AND SEQUENCING. MULTIPLE CELLS MAY BE CONSTRUCTED AND OPERATED AT A TIME. CELLS MAY ALSO BE CONSTRUCTED OUT-OF-SEQUENCE, WITH MINOR ADJUSTMENTS TO INTERCELL BOUNDARIES, OR SUBSIDED INTO PARTIAL CELL AREAS TO FACILITATE CLOSURE ACTIVITIES. REFER TO DRAWINGS 30 THROUGH 37 FOR THE CLOSURE PHASING PLANS.
  - REFER TO DRAWINGS 33 THROUGH 37 FOR THE LEACHATE MANAGEMENT SYSTEM PLAN AND DETAILS.
  - THE PLANT UTILITY CORRIDOR REFERS TO A 100-FT WIDE CORRIDOR IMMEDIATELY EAST OF THE CONSOLIDATED LINED AREA THAT WILL BE CONSTRUCTED IN CONJUNCTION WITH THE CLOSURE PROJECT. CORRIDOR MAY BE USED FOR PLANT-RELATED UTILITIES AND INFRASTRUCTURE.

SUMMARY OF LINED CELL AREAS	
CELL	PLAN AREA (ACRES)
1A	15.8
1B	9.4
2	13.7
3	16.5
4A	9.9
4B	10.9
5A	10.9
5B	9.9
6A	11.8
6B	10.9
7A	9.0
7B	15.6
TOTAL LINED AREA	144.1




PERMIT DRAWING  
NOT FOR CONSTRUCTION

1	MAY 2024	UPDATE AND ADD GAS PIPELINES	JDV	RSB
2	AUG. 2021	SUBMITTAL TO GA EPO	JAN/H	RSB
REV	DATE	DESCRIPTION	DWN	APP
TOP OF LINER GRADING PLAN - OVERALL				
PLANT BOWEN ASH POND 1 (AP-1) CLOSURE DRAWINGS BARTOW COUNTY, GEORGIA				
<div>Geosyntec<sup>®</sup> consultants</div> <div>1105 ROBERTS ROAD, SUITE 200 NEW SMYRNA BEACH, FL 32169-3000 WWW.GEOSYNTEC.COM PHONE: 407.302.9500</div>				
PROJ. NO. GR6601		DWG. GR6601-010	EDIT	5/23/24
SCALE 1" = 300'		DRAWING 11 OF 50		
DATE AUGUST 2021				








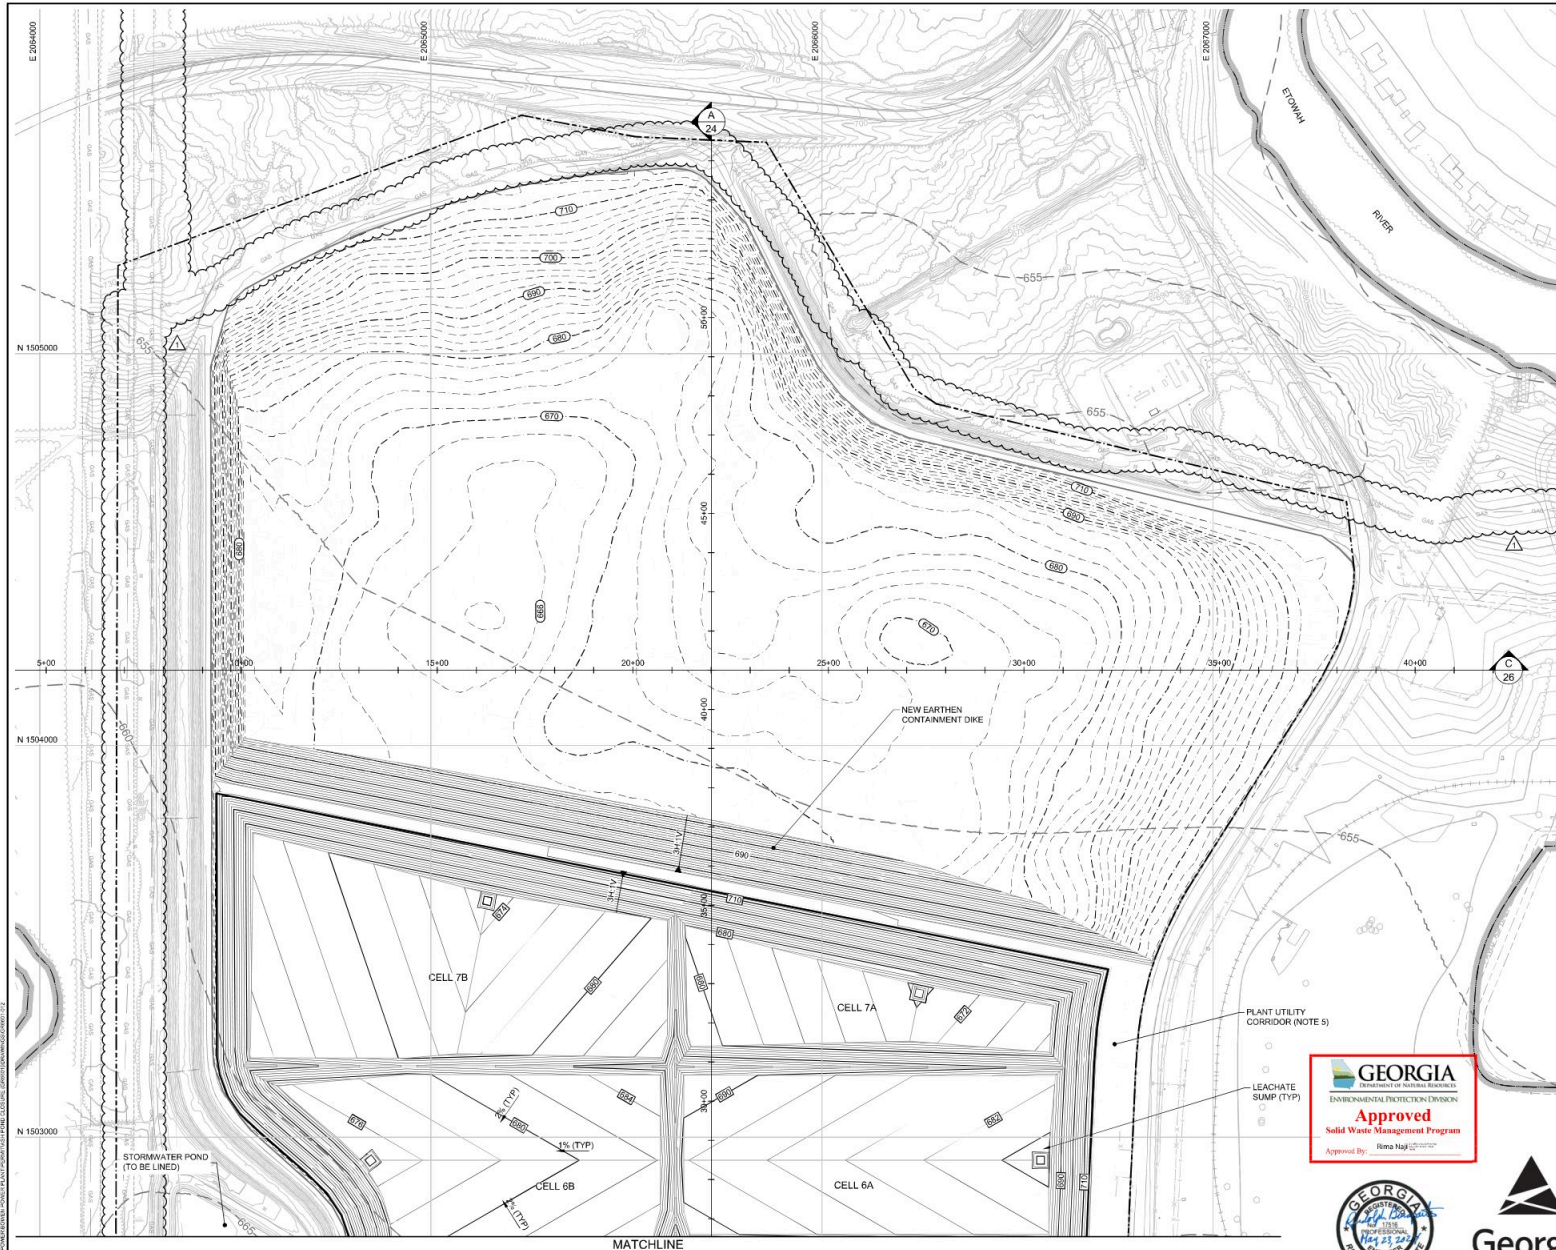

- LEGEND**
- 710 ——— EXISTING GROUND ELEVATION (FEET) (NOTE 1)
  - PERMIT BOUNDARY
  - 670 ——— EXCAVATION SURFACE ELEVATION (FEET)
  - 680 ——— TOP OF LINER ELEVATION (FEET)
  - LIMIT OF RETROFIT LINER
  - APPROXIMATE EXISTING LIMIT OF AP-1 (NOTE 1)
  - 660 ——— PREDICTED POST-CLOSURE SEASONAL HIGH GROUNDWATER POTENTIAL SURFACE ELEVATION (FEET) (NOTE 1)
  - LEACHATE SUMP

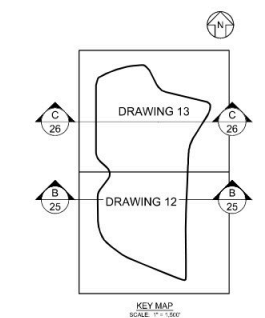

- NOTES:**
- SEE DRAWING 2 FOR LEGENDS, ABBREVIATIONS, AND GENERAL SITE NOTES.
  - TOP OF LINER GRADES SHOWN ON THIS DRAWING REPRESENT THE TOP OF THE GEOMEMBRANE COMPONENT OF THE LINER SYSTEM WITHIN THE CONSOLIDATED LINED FOOTPRINT AREA. WITHIN THE REMAINDER OF AP-1 (OUTSIDE THE CONSOLIDATED LINED FOOTPRINT AREA), GRADES REPRESENT EXISTING NORTH AND SOUTH CONTAINMENT DIKE SLOPES, WHICH TIE IN TO THE ESTIMATED BOTTOM OF EXCAVATION GRADES. CONTOURS SHOWN ON THIS DRAWING BEYOND LIMITS OF AP-1 ARE EXISTING GROUND TOPOGRAPHY. LOW POINTS OF CELLS WILL NOT BE LOWERED WITHOUT GA EPO APPROVAL. MINOR CHANGES TO LINER GRADES SHOWN ON THIS DRAWING MAY BE MADE DURING DETAILED DESIGN (E.G., RAISED TO PROVIDE SEPARATION FROM THE PREDICTED POST-CLOSURE SEASONAL HIGH GROUNDWATER POTENTIAL SURFACE PRESENTED IN THE HYDROGEOLOGIC ASSESSMENT REPORT (REVISION 37) (PART B, SECTION 2 OF THIS PERMIT APPLICATION)). LINER GRADES MAY BE RAISED AS NECESSARY DURING CONSTRUCTION BASED ON CONDITIONS ENCOUNTERED.
  - CLOSURE WILL BE CONDUCTED IN PHASES, RESULTING IN PLAN TO CONSTRUCT LINED CELLS AND PLACE COR IN ASCENDING NUMERICAL ORDER, AS NEEDED TO FACILITATE CLOSURE CONSTRUCTION TIMING AND SEQUENCING. MULTIPLE CELLS MAY BE CONSTRUCTED AND OPERATED AT A TIME. CELLS MAY ALSO BE CONSTRUCTED OUT-OF-SEQUENCE, WITH MINOR ADJUSTMENTS TO INTERCELL BOUNDARIES, OR SUBDIVIDED INTO PARTIAL CELL AREAS TO FACILITATE CLOSURE ACTIVITIES. REFER TO DRAWINGS 20 THROUGH 23 FOR THE CLOSURE PHASING PLANS.
  - REFER TO DRAWINGS 33 THROUGH 37 FOR THE LEACHATE MANAGEMENT SYSTEM PLAN AND DETAILS.
  - THE PLANT UTILITY CORRIDOR REFERS TO A 100-FT WIDE CORRIDOR IMMEDIATELY EAST OF THE CONSOLIDATED LINED AREA THAT WILL BE CONSTRUCTED IN CONJUNCTION WITH THE CLOSURE PROJECT. CORRIDOR MAY BE USED FOR PLANT-RELATED UTILITIES AND INFRASTRUCTURE.




**Georgia Power**  
PERMIT DRAWING  
NOT FOR CONSTRUCTION

1	MAY 2024	UPDATE AND ADD GAS PIPELINES	JZV	RSB
2	AUG. 2021	SUBMITTAL TO GA EPD	JAV/HH	RSB
REV	DATE	DESCRIPTION	DWN	APP
TOP OF LINER GRADING PLAN - NORTH AP-1				
PLANT BOWEN ASH POND 1 (AP-1) CLOSURE DRAWINGS BARTOW COUNTY, GEORGIA				
<div>Geosyntec<sup>®</sup> consultants</div> <div>1305 ROBERTS ROAD, SUITE 200 KENNESAW, GEORGIA 30144 USA</div> <div>PHONE: 478.302.9500 WWW.GEOSYNTEC.COM</div>				
PROJ. NO.	GR6601	DWG.	GR6601-012	EDIT 5/23/24
SCALE	1" = 150'	DRAWING 13 OF 50		
DATE	AUGUST 2021			





LEGEND	
— 670 —	FINISHED GROUND ELEVATION (FEET)
- - - - -	PERMIT BOUNDARY
○ 770 ○	TOP OF CCR GRADE ELEVATION FOR SOIL-GEOSYNTHETIC COMPOSITE COVER (FEET)
— 100 —	LIMIT OF DISTURBANCE

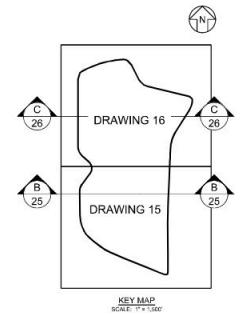

- NOTES:
- SEE DRAWING 2 FOR LEGENDS, ABBREVIATIONS, AND GENERAL SITE NOTES.
  - TOP OF CCR GRADES SHOWN ON THIS DRAWING REPRESENT THE TOP OF CCR ELEVATIONS FOR THE SOIL-GEOSYNTHETIC COMPOSITE FINAL COVER OPTION. BEYOND THE FINAL COVER LIMITS, PROPOSED FINISHED GRADES ARE SHOWN, WHICH TIE-IN TO EXISTING GROUND TOPOGRAPHY AT THE LIMIT OF DISTURBANCE. SEE DRAWING 2, GENERAL SITE NOTE 19.
  - REFER TO DRAWINGS 20 THROUGH 23 FOR THE CLOSURE PHASING PLANS.
  - REFER TO DRAWINGS 38 THROUGH 49 FOR THE STORMWATER MANAGEMENT SYSTEM AND EROSION AND SEDIMENT CONTROL PLAN AND DETAILS.
  - FOR CLARITY, FINAL CLOSURE STORMWATER MANAGEMENT FEATURES ARE NOT SHOWN ON THIS DRAWING. REFER TO DRAWING 38 FOR A DRAWING SHOWING THE LAYOUT PLAN AND IDENTIFICATION OF THESE FEATURES.
  - THE PLANT UTILITY CORRIDOR REFERS TO A 100-FT WIDE CORRIDOR IMMEDIATELY EAST OF THE CONSOLIDATED LINED AREA THAT WILL BE CONSTRUCTED IN CONJUNCTION WITH THE CLOSURE PROJECT. CORRIDOR MAY BE USED FOR PLANT-RELATED UTILITIES AND INFRASTRUCTURE.
  - IN ADDITION TO PERMANENT STORMWATER PONDS SHOWN, TEMPORARY LINED STORMWATER PONDS WILL BE UTILIZED DURING CONSTRUCTION AS NEEDED.



1	MAY 2024	UPDATE AND ADD GAS PIPELINES	JZV	IRB
2	AUG 2021	SUBMITTAL TO GA EPD	JAN/H	IRB
REV	DATE	DESCRIPTION	DWN	APP

TOP OF CCR GRADING PLAN - OVERALL

PLANT BOWEN ASH POND 1 (AP-1)  
CLOSURE DRAWINGS  
BARTOW COUNTY, GEORGIA




**Geosyntec**  
consultants

1305 ROBERTS ROAD, SUITE 200, KENNESAW, GEORGIA 30144 USA		PHONE: 478.302.9500 WWW.GEOSYNTEC.COM	
PROJ. NO.	GR6601	DWG.	GR6601-013
SCALE	1" = 300'	EDIT	5/23/24
DATE	AUGUST 2021	DRAWING 14 OF 50	



**Georgia Power**  
PERMIT DRAWING  
NOT FOR CONSTRUCTION



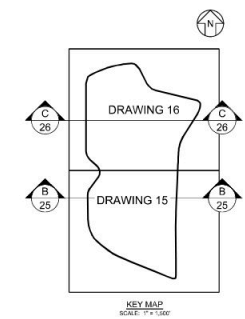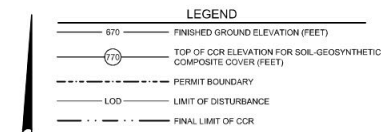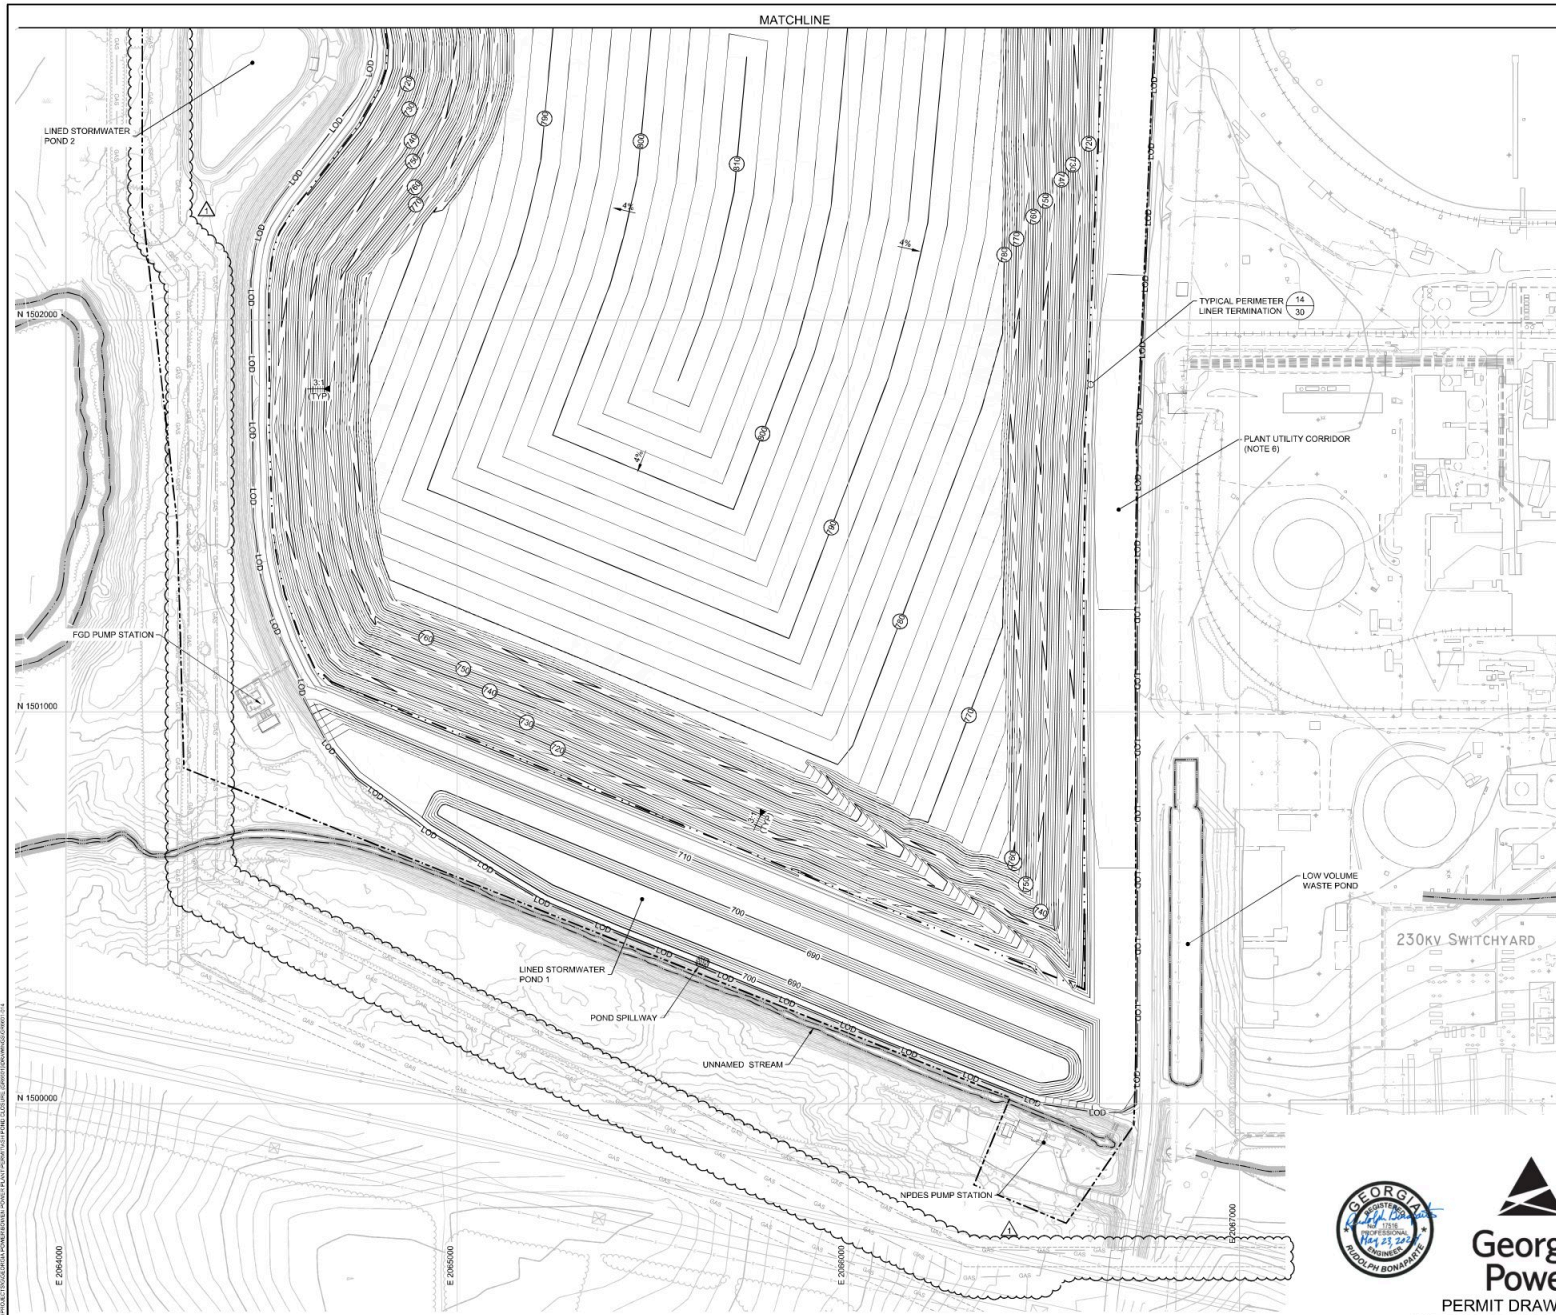



- NOTES:
- SEE DRAWING 2 FOR LEGENDS, ABBREVIATIONS, AND GENERAL SITE NOTES.
  - TOP OF CCR GRADES SHOWN ON THIS DRAWING REPRESENT THE TOP OF CCR ELEVATIONS FOR THE SOIL-GEOSYNTHETIC COMPOSITE FINAL COVER OPTION. BEYOND THE FINAL COVER LIMITS, PROPOSED FINISHED GRADES ARE SHOWN, WHICH TIE-IN TO EXISTING GROUND TOPOGRAPHY AT THE LIMIT OF DISTURBANCE. SEE DRAWING 2, GENERAL SITE NOTE 15.
  - REFER TO DRAWINGS 20 THROUGH 23 FOR THE CLOSURE PHASING PLANS.
  - REFER TO DRAWINGS 38 THROUGH 49 FOR THE STORMWATER MANAGEMENT SYSTEM AND EROSION AND SEDIMENT CONTROL PLAN AND DETAILS.
  - FOR CLARITY, FINAL CLOSURE STORMWATER MANAGEMENT FEATURES ARE NOT SHOWN ON THIS DRAWING. REFER TO DRAWING 38 FOR A DRAWING SHOWING THE LAYOUT PLAN AND IDENTIFICATION OF THESE FEATURES.
  - THE PLANT UTILITY CORRIDOR REFERS TO A 100-FT WIDE CORRIDOR IMMEDIATELY EAST OF THE CONSOLIDATED LINED AREA THAT WILL BE CONSTRUCTED IN CONJUNCTION WITH THE CLOSURE PROJECT. CORRIDOR MAY BE USED FOR PLANT-RELATED UTILITIES AND INFRASTRUCTURE.
  - IN ADDITION TO PERMANENT STORMWATER PONDS SHOWN, TEMPORARY LINED STORMWATER PONDS WILL BE UTILIZED DURING CONSTRUCTION AS NEEDED.



PERMIT DRAWING  
NOT FOR CONSTRUCTION

1	MAY 2024	UPDATE AND ADD GAS PIPELINES	JZV	RSB
2	AUG. 2021	SUBMITTAL TO GA EPD	JAV/HH	RSB
REV	DATE	DESCRIPTION	DWN	APP
TOP OF CCR GRADING PLAN - SOUTH				
PLANT BOWEN ASH POND 1 (AP-1) CLOSURE DRAWINGS BARTOW COUNTY, GEORGIA				
<div>Geosyntec<sup>®</sup> consultants</div> <div>1355 ROBERTS ROAD, SUITE 200 KENNESAW, GEORGIA 30144 USA</div> <div>PHONE: 478.202.9500 WWW.GEOSYNTEC.COM</div>				
PROJ. NO.	GR6601	DWG.	GR6601-014	EDIT 5/23/24
SCALE	1" = 150'	DRAWING 15 OF 50		
DATE	AUGUST 2021			



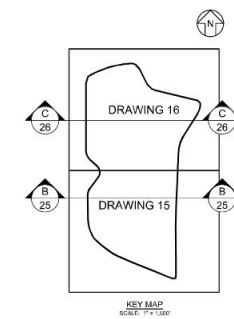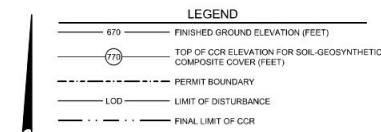

- NOTES:
- SEE DRAWING 2 FOR LEGENDS, ABBREVIATIONS, AND GENERAL SITE NOTES.
  - TOP OF CCR GRADES SHOWN ON THIS DRAWING REPRESENT THE TOP OF CCR ELEVATIONS FOR THE SOIL-GEOSYNTHETIC COMPOSITE FINAL COVER OPTION. BEYOND THE FINAL COVER LIMITS, PROPOSED FINISHED GRADES ARE SHOWN, WHICH TIE-IN TO EXISTING GROUND TOPOGRAPHY AT THE LIMIT OF DISTURBANCE. SEE DRAWING 2, GENERAL SITE NOTE 10.
  - REFER TO DRAWINGS 20 THROUGH 23 FOR THE CLOSURE PHASING PLANS.
  - REFER TO DRAWINGS 38 THROUGH 49 FOR THE STORMWATER MANAGEMENT SYSTEM AND EROSION AND SEDIMENT CONTROL PLAN AND DETAILS.
  - FOR CLARITY, FINAL CLOSURE STORMWATER MANAGEMENT FEATURES ARE NOT SHOWN ON THIS DRAWING. REFER TO DRAWING 38 FOR A DRAWING SHOWING THE LAYOUT PLAN AND IDENTIFICATION OF THESE FEATURES.
  - THE PLANT UTILITY CORRIDOR REFERS TO A 100-FT WIDE CORRIDOR IMMEDIATELY EAST OF THE CONSOLIDATED LINED AREA THAT WILL BE CONSTRUCTED IN CONJUNCTION WITH THE CLOSURE PROJECT. CORRIDOR MAY BE USED FOR PLANT-RELATED UTILITIES AND INFRASTRUCTURE.
  - IN ADDITION TO PERMANENT STORMWATER PONDS SHOWN, TEMPORARY LINED STORMWATER PONDS WILL BE UTILIZED DURING CONSTRUCTION AS NEEDED.




PERMIT DRAWING  
NOT FOR CONSTRUCTION

1	MAY 2024	UPDATE AND ADD GAS PIPELINES	JZV	RSB
2	AUG 2021	SUBMITTAL TO GA EPD	JAV/HM	RSB
REV	DATE	DESCRIPTION	DRN	APP
TOP OF CCR GRADING PLAN - NORTH				
PLANT BOWEN ASH POND 1 (AP-1) CLOSURE DRAWINGS BARTOW COUNTY, GEORGIA				
<b>Geosyntec</b> consultants				
<small>1355 ROBERTS ROAD, SUITE 200 KENNESAW, GEORGIA 30144 USA</small>				
<small>PROJ. NO. GR6601</small>		<small>DWG. GR6601-015</small>		<small>EDIT 5/23/24</small>
<small>SCALE 1" = 150'</small>		<small>DATE AUGUST 2021</small>		
DRAWING 16 OF 50				<small>PHONE: 478.302.9500 WWW.GEOSYNTEC.COM</small>





LEGEND	
	TOP OF FINAL COVER SYSTEM / TOP OF CCR FOR ALTERNATIVE COVER SYSTEM (CLOSURETURB COVER) FINISHED GRADE ELEVATION (FEET)
	PERMIT BOUNDARY
	LOD LIMIT OF DISTURBANCE
	FINAL LIMIT OF CCR

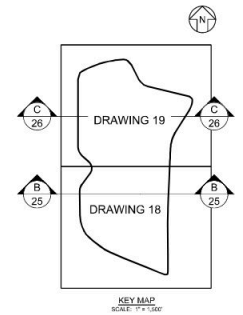

- NOTES:
- SEE DRAWING 2 FOR LEGENDS, ABBREVIATIONS, AND GENERAL SITE NOTES.
  - TOP OF FINAL COVER GRADES SHOWN ON THIS DRAWING REPRESENT BOTH THE TOP OF SOIL-GEOSYNTHETIC COMPOSITE FINAL COVER SYSTEM AND THE TOP OF CLOSURETURB ALTERNATIVE FINAL COVER SYSTEM ELEVATIONS WITHIN THE FINAL COVER LIMITS. THESE GRADES ALSO REPRESENT THE TOP OF CCR ELEVATIONS FOR THE CLOSURETURB ALTERNATIVE FINAL COVER SYSTEM BEYOND THE FINAL COVER LIMITS. PROPOSED FINISHED GRADES ARE SHOWN, WHICH TIE-IN TO EXISTING GROUND TOPOGRAPHY AT THE LIMIT OF DISTURBANCE. SEE DRAWING 2, GENERAL SITE NOTE 19, BASED ON FIELD CONDITIONS ENCOUNTERED. THE ELEVATION OF THE FINAL COVER MAY VARY, PROVIDED THAT THE ENGINEERING DESIGN CRITERIA ARE MET. THE MAXIMUM FINAL COVER ELEVATION WILL NOT BE EXCEEDED WITHOUT GA EPD AUTHORIZATION.
  - REFER TO DRAWINGS 20 THROUGH 23 FOR THE CLOSURE PHASING PLANS.
  - REFER TO DRAWINGS 38 THROUGH 48 FOR THE STORMWATER MANAGEMENT SYSTEM AND EROSION AND SEDIMENT CONTROL PLAN AND DETAILS.
  - FOR CLARITY, FINAL CLOSURE STORMWATER MANAGEMENT FEATURES ARE NOT SHOWN ON THIS DRAWING. REFER TO DRAWING 38 FOR A DRAWING SHOWING THE LAYOUT PLAN AND IDENTIFICATION OF THESE FEATURES.
  - THE PLANT UTILITY CORRIDOR REFERS TO A 100-FT WIDE CORRIDOR IMMEDIATELY EAST OF THE CONSOLIDATED LINED AREA THAT WILL BE CONSTRUCTED IN CONJUNCTION WITH THE CLOSURE PROJECT. CORRIDOR MAY BE USED FOR PLANT-RELATED UTILITIES AND INFRASTRUCTURE.
  - IN ADDITION TO PERMANENT STORMWATER PONDS SHOWN, TEMPORARY LINED STORMWATER PONDS WILL BE UTILIZED DURING CONSTRUCTION AS NEEDED.

SCALE IN FEET  
0 300 600

1	MAY 2024	UPDATE AND ADD GAS PIPELINES	JDV	RSB
9	AUG 2021	SUBMITTAL TO GA EPD	JAN/H	RSB
REV	DATE	DESCRIPTION	DWN	APP

FINAL CLOSURE GRADING PLAN - OVERALL

PLANT BOWEN ASH POND 1 (AP-1)  
CLOSURE DRAWINGS  
BARTOW COUNTY, GEORGIA

**Geosyntec**  
consultants

1305 ROBERTS ROAD, SUITE 200, KENNESAW, GEORGIA 30144 USA		PHONE: 478.202.9500 WWW.GEOSYNTEC.COM	
PROJ. NO.	GR6601	DWG.	GR6601-017
SCALE	1" = 300'	EDIT	5/23/24
DATE	AUGUST 2021	DRAWING 17 OF 50	



**Georgia Power**

PERMIT DRAWING  
NOT FOR CONSTRUCTION






**LEGEND**

- TOP OF FINAL COVER SYSTEM / TOP OF CCR FOR ALTERNATIVE COVER SYSTEM (CLOSURETURB COVER) FINISHED GRADE ELEVATION (FEET)
- PERMIT BOUNDARY
- LIMIT OF DISTURBANCE
- FINAL LIMIT OF CCR

**GEORGIA**  
DEPARTMENT OF NATURAL RESOURCES  
ENVIRONMENTAL PROTECTION DIVISION  
**Approved**  
Solid Waste Management Program  
Approved By: Rima Naj 2/23/2024

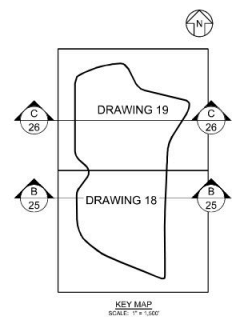



- NOTES:
- SEE DRAWING 2 FOR LEGENDS, ABBREVIATIONS, AND GENERAL SITE NOTES.
  - TOP OF FINAL COVER GRADES SHOWN ON THIS DRAWING REPRESENT BOTH THE TOP OF SOIL-GEOSYNTHETIC COMPOSITE FINAL COVER SYSTEM AND THE TOP OF CLOSURETURB ALTERNATIVE FINAL COVER SYSTEM ELEVATIONS WITHIN THE FINAL COVER LIMITS. THESE GRADES ALSO REPRESENT THE TOP OF CCR ELEVATIONS FOR THE CLOSURETURB ALTERNATIVE FINAL COVER SYSTEM BEYOND THE FINAL COVER LIMITS. PROPOSED FINISHED GRADES ARE SHOWN, WHICH TIE-IN TO EXISTING GROUND TOPOGRAPHY AT THE LIMIT OF DISTURBANCE. SEE DRAWING 2, GENERAL SITE NOTE 19, BASED ON FIELD CONDITIONS ENCOUNTERED. THE ELEVATION OF THE FINAL COVER MAY VARY, PROVIDED THAT THE ENGINEERING DESIGN CRITERIA ARE MET. THE MAXIMUM FINAL COVER ELEVATION WILL NOT BE EXCEEDED WITHOUT GA EPD AUTHORIZATION.
  - REFER TO DRAWINGS 20 THROUGH 23 FOR THE CLOSURE PHASING PLANS.
  - REFER TO DRAWINGS 38 THROUGH 48 FOR THE STORMWATER MANAGEMENT SYSTEM AND EROSION AND SEDIMENT CONTROL PLAN AND DETAILS.
  - FOR CLARITY, FINAL CLOSURE STORMWATER MANAGEMENT FEATURES ARE NOT SHOWN ON THIS DRAWING. REFER TO DRAWING 38 FOR A DRAWING SHOWING THE LAYOUT PLAN AND IDENTIFICATION OF THESE FEATURES.
  - THE PLANT UTILITY CORRIDOR REFERS TO A 100-FT WIDE CORRIDOR IMMEDIATELY EAST OF THE CONSOLIDATED LINED AREA THAT WILL BE CONSTRUCTED IN CONJUNCTION WITH THE CLOSURE PROJECT. CORRIDOR MAY BE USED FOR PLANT-RELATED UTILITIES AND INFRASTRUCTURE.
  - IN ADDITION TO PERMANENT STORMWATER PONDS SHOWN, TEMPORARY LINED STORMWATER PONDS WILL BE UTILIZED DURING CONSTRUCTION AS NEEDED.



**Georgia Power**  
PERMIT DRAWING  
NOT FOR CONSTRUCTION

1	MAY 2024	UPDATE AND ADD GAS PIPELINES	JDV	RSB
2	AUG 2021	SUBMITTAL TO GA EPD	JAV/HH	RSB
REV	DATE	DESCRIPTION	DWN	APP
FINAL CLOSURE GRADING PLAN - SOUTH AP-1				
PLANT BOWEN ASH POND 1 (AP-1) CLOSURE DRAWINGS BARTOW COUNTY, GEORGIA				
<div>Geosyntec<sup>®</sup> consultants</div> <div>1305 ROBERTS ROAD, SUITE 200 KENNESAW, GEORGIA 30144 USA PHONE: 478.202.9500 WWW.GEOSYNTEC.COM</div>				
PROJ. NO.	GR6601	DWG.	GR6601-016	EDIT 5/23/24
SCALE	1" = 150'	DRAWING 18 OF 50		
DATE	AUGUST 2021			



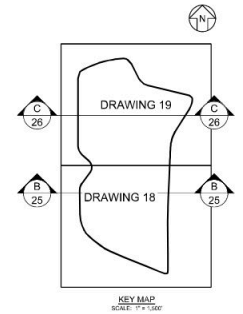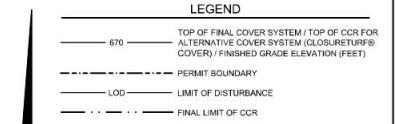


- NOTES:**
- SEE DRAWING 2 FOR LEGENDS, ABBREVIATIONS, AND GENERAL SITE NOTES.
  - TOP OF FINAL COVER GRADES SHOWN ON THIS DRAWING REPRESENT BOTH THE TOP OF SOIL-GEOSYNTHETIC COMPOSITE FINAL COVER SYSTEM AND THE TOP OF CLOSURETURF® ALTERNATIVE FINAL COVER SYSTEM ELEVATIONS WITHIN THE FINAL COVER LIMITS. THESE GRADES ALSO REPRESENT THE TOP OF CCR ELEVATIONS FOR THE CLOSURETURF® ALTERNATIVE FINAL COVER SYSTEM BEYOND THE FINAL COVER LIMITS. PROPOSED FINISHED GRADES ARE SHOWN, WHICH TIE-IN TO EXISTING GROUND TOPOGRAPHY AT THE LIMIT OF DISTURBANCE. SEE DRAWING 2, GENERAL SITE NOTE 19, BASED ON FIELD CONDITIONS ENCOUNTERED. THE ELEVATION OF THE FINAL COVER MAY VARY, PROVIDED THAT THE ENGINEERING DESIGN CRITERIA ARE MET. THE MAXIMUM FINAL COVER ELEVATION WILL NOT BE EXCEEDED WITHOUT GA EPD AUTHORIZATION.
  - REFER TO DRAWINGS 20 THROUGH 23 FOR THE CLOSURE PHASING PLANS.
  - REFER TO DRAWINGS 38 THROUGH 48 FOR THE STORMWATER MANAGEMENT SYSTEM AND EROSION AND SEDIMENT CONTROL PLAN AND DETAILS.
  - FOR CLARITY, FINAL CLOSURE STORMWATER MANAGEMENT FEATURES ARE NOT SHOWN ON THIS DRAWING. REFER TO DRAWING 38 FOR A DRAWING SHOWING THE LAYOUT PLAN AND IDENTIFICATION OF THESE FEATURES.
  - THE PLANT UTILITY CORRIDOR REFERS TO A 100-FT WIDE CORRIDOR IMMEDIATELY EAST OF THE CONSOLIDATED LINED AREA THAT WILL BE CONSTRUCTED IN CONJUNCTION WITH THE CLOSURE PROJECT. CORRIDOR MAY BE USED FOR PLANT-RELATED UTILITIES AND INFRASTRUCTURE.
  - IN ADDITION TO PERMANENT STORMWATER PONDS SHOWN, TEMPORARY LINED STORMWATER PONDS WILL BE UTILIZED DURING CONSTRUCTION AS NEEDED.




PERMIT DRAWING  
NOT FOR CONSTRUCTION

1	MAY 2024	UPDATE AND ADD GAS PIPELINES	JZV	RSB		
2	AUG 2021	SUBMITTAL TO GA EPD	JAV/H	RSB		
REV	DATE	DESCRIPTION	DRN	APP		
FINAL CLOSURE GRADING PLAN - NORTH AP-1						
PLANT BOWEN ASH POND 1 (AP-1) CLOSURE DRAWINGS BARTOW COUNTY, GEORGIA						
<div>Geosyntec consultants</div> <div>1305 ROBERTS ROAD, SUITE 200 KENNESAW, GEORGIA 30144 USA</div> <div>PHONE: 478.202.9500 WWW.GEOSYNTEC.COM</div>						
PROJ. NO.		GR6601	DWG.	GR6601-019	EDIT	5/23/24
SCALE		1" = 150'		DRAWING 19		OF 50
DATE		AUGUST 2021				




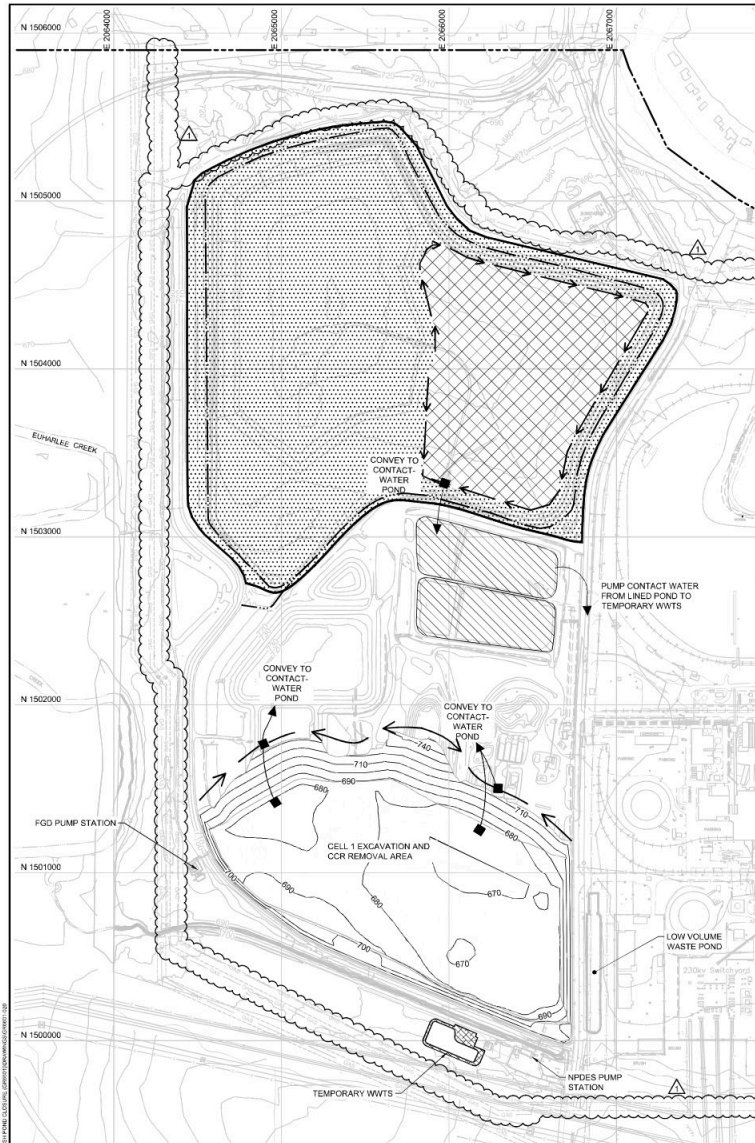

PHASE 1  
INITIAL CCR EXCAVATION

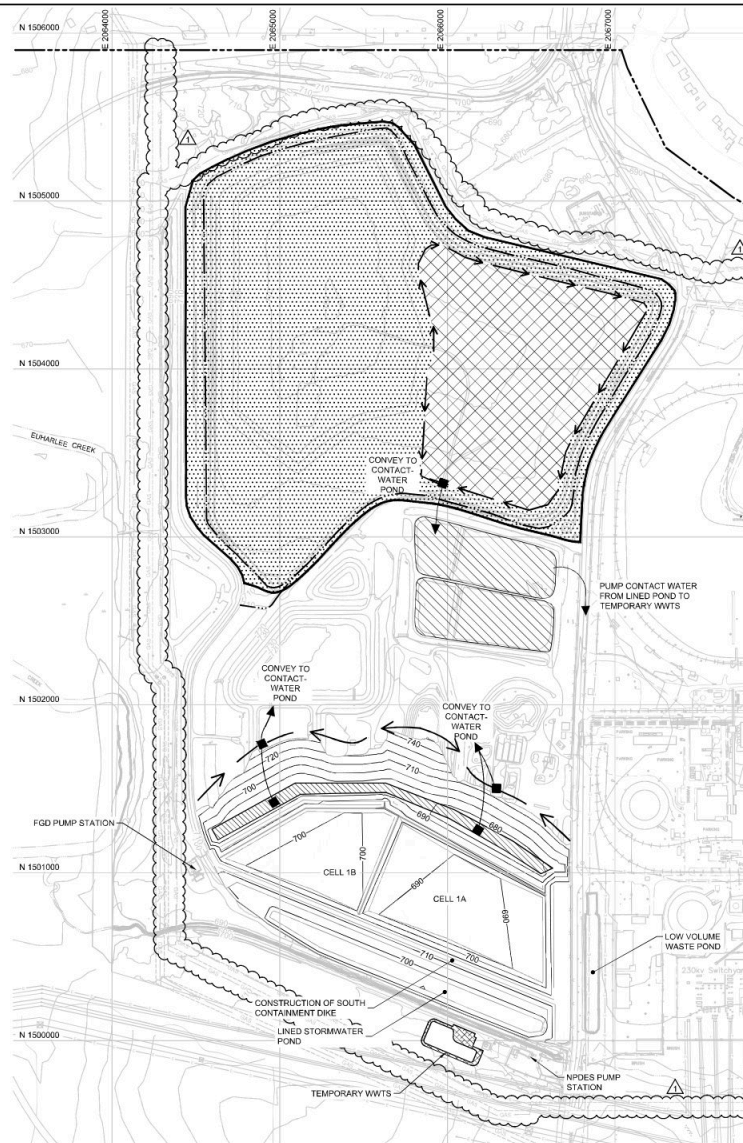

PHASE 2  
CELL 1 CONSTRUCTION

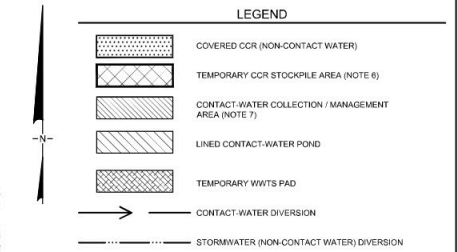

#### NOTES

- PHASING APPROACH IS CONCEPTUAL, AND WILL BE REFINED DURING DETAILED DESIGN. IN ADDITION, CONTRACTOR WILL HAVE DISCRETION TO ADJUST PHASE BOUNDARIES AND SEQUENCE, STOCKPILE LOCATIONS, AND CONTACT-WATER COLLECTION / MANAGEMENT AREAS, BASED ON FIELD CONDITIONS ENCOUNTERED AND TO FACILITATE CONSTRUCTION, AS APPROVED BY GEORGIA POWER COMPANY, WITH REQUIREMENT THAT DESIGN CRITERIA INCLUDING THOSE RELATED TO STORMWATER AND CONTACT WATER MANAGEMENT, ARE MET.
- STORMWATER AND CONTACT-WATER MANAGEMENT WILL BE CONDUCTED IN ACCORDANCE WITH THE PROCEDURES DESCRIBED IN THE 'CLOSURE PLAN' (PART A, SECTION 7 OF THIS PERMIT APPLICATION). DESIGN CRITERIA AND EVALUATION OF 'CASES RELATED TO THE CLOSURE PHASES PRESENTED HEREIN ARE PROVIDED IN A CALCULATION PACKAGE FOR INTERIM STORMWATER MANAGEMENT CONDITIONS, INCLUDED IN THE 'ENGINEERING REPORT' (PART B, SECTION 3 OF THIS PERMIT APPLICATION).
- DURING CLOSURE CONSTRUCTION, CONTACT WATER WILL BE PUMPED OR CONVEYED BY GRAVITY TO LINED CONTACT-WATER PONDS WITHIN AP-1, WHERE IT WILL BE TEMPORARILY STORED AND THEN PUMPED TO AN ON-SITE TEMPORARY WASTEWATER TREATMENT SYSTEM (WWTS) OR OTHERWISE PROPERLY MANAGED IN ACCORDANCE WITH THE PLANT'S NPDES PERMIT REQUIREMENTS. NON-CONTACT STORMWATER WILL BE MANAGED IN ACCORDANCE WITH APPLICABLE EROSION AND SEDIMENT CONTROL FEATURES AND REQUIREMENTS PROVIDED IN THIS SET OF CLOSURE DRAWINGS, AND THEN DISCHARGED THROUGH EXISTING OR NEW STORMWATER PONDS TO RECEIVING WATER BODIES WITHOUT TREATMENT.
- CONTRACTOR WILL BE REQUIRED TO TAKE REASONABLE MEASURES TO MINIMIZE STORMWATER RUN-ON INTO THE CONTACT-WATER COLLECTION / MANAGEMENT AREAS. MINIMIZATION TECHNIQUES MAY INCLUDE THE CONSTRUCTION OF TEMPORARY DIVERSION BERMS OR CHANNELS TO DIVERT STORMWATER AWAY FROM THE COLLECTION / MANAGEMENT AREAS.
- COVER SYSTEM WILL BE TEMPORARILY TERMINATED AT CLOSURE INCREMENT PHASE BOUNDARIES AS SHOWN IN DETAILS 12 AND 13 ON DRAWING 29 FOR FINAL COVER SYSTEM (SOIL-GEOSYNTHETIC COMPOSITE COVER) AND ALTERNATIVE COVER SYSTEM (CLOSURE TIER-2 COVER), RESPECTIVELY. CLOSURE INCREMENTS ARE APPROXIMATE FOR ILLUSTRATIVE PURPOSES, AND MAY BE ADJUSTED DURING CLOSURE.
- TEMPORARY CCR STOCKPILE AREA(S) SHOWN ARE CONCEPTUAL AND THEIR LOCATIONS AND SIZES WILL BE REFINED DURING DETAILED DESIGN.
- CONTACT-WATER COLLECTION / MANAGEMENT AREAS SHOWN ON THIS DRAWING MAY BE ADJUSTED OR SUPPLEMENTED DURING CONSTRUCTION AS NEEDED. CONTACT WATER WILL BE PROMPTLY TRANSFERRED TO THE LINED CONTACT-WATER POND TO MINIMIZE DURATION OF PONDING WITHIN AP-1 EXCAVATIONS.
- TEMPORARILY LINED STORMWATER PONDS (NON-CONTACT WATER) MAY BE UTILIZED DURING CONSTRUCTION AS NEEDED.
- FOR PHASES WHERE COVERED CCR SHADING ENCLOSES AN ACTIVE CCR PLACEMENT, THIS INDICATES WHERE A TEMPORARY OR FINAL COVER SYSTEM INCREMENT MAY BE INSTALLED ONCE FINISHED WASTE GRADES ARE ACHIEVED FOR THAT PHASE.




1	MAY 2024	UPDATE AND ADD GAS PIPELINES	J2V	RSB	
2	AUG. 2021	SUBMITTAL TO GA EPD	JAN/H	RSB	
REV	DATE	DESCRIPTION	DRN	APP	
CLOSURE PHASING PLANS I					
PLANT BOWEN ASH POND 1 (AP-1) CLOSURE DRAWINGS BARTOW COUNTY, GEORGIA					
<div>Geosyntec<sup>®</sup> consultants</div> <div>1305 ROBERTS BOULEVARD, SUITE 200 KENNESAW, GEORGIA 30144 USA</div> <div>PHONE: 678.202.9500 WWW.GEOSYNTEC.COM</div>					
PROJ. NO.	GR6601	DWG.	GR6601-020	EDIT	5/23/24
SCALE	1" = 350'				
DATE	AUGUST 2021				
		DRAWING 20			OF 50




PERMIT DRAWING  
NOT FOR CONSTRUCTION




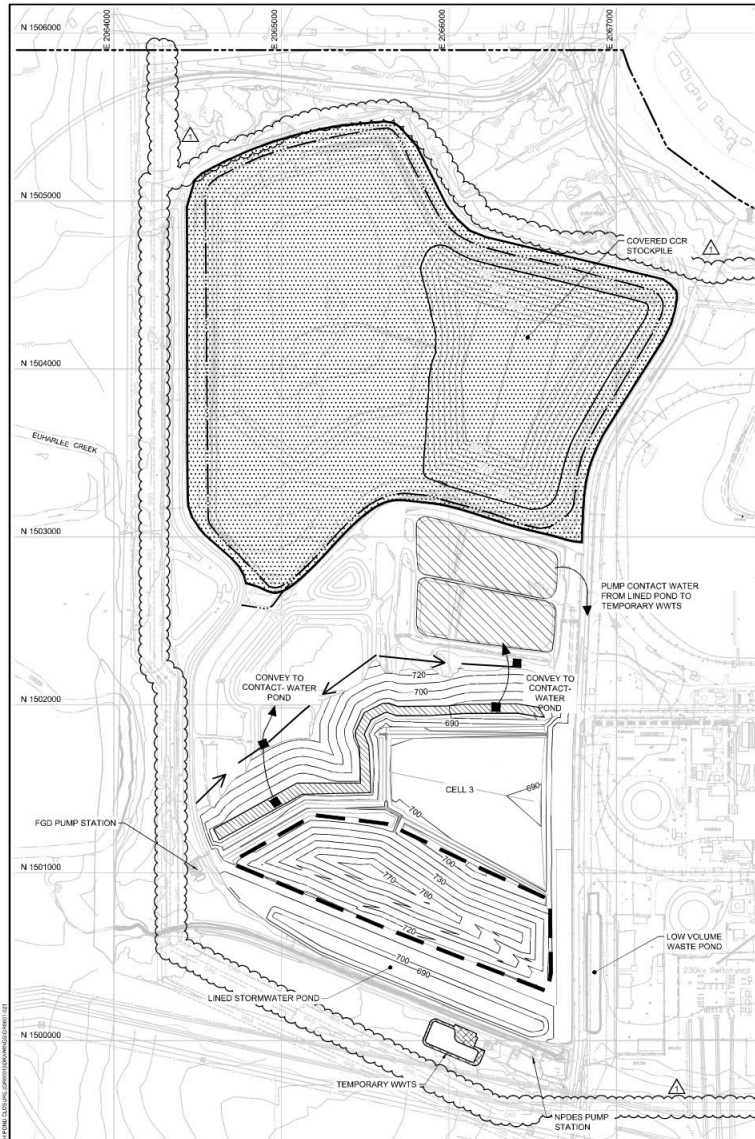

PHASE 3  
CELL 3 CONSTRUCTION AND  
CELL 1 FILLING

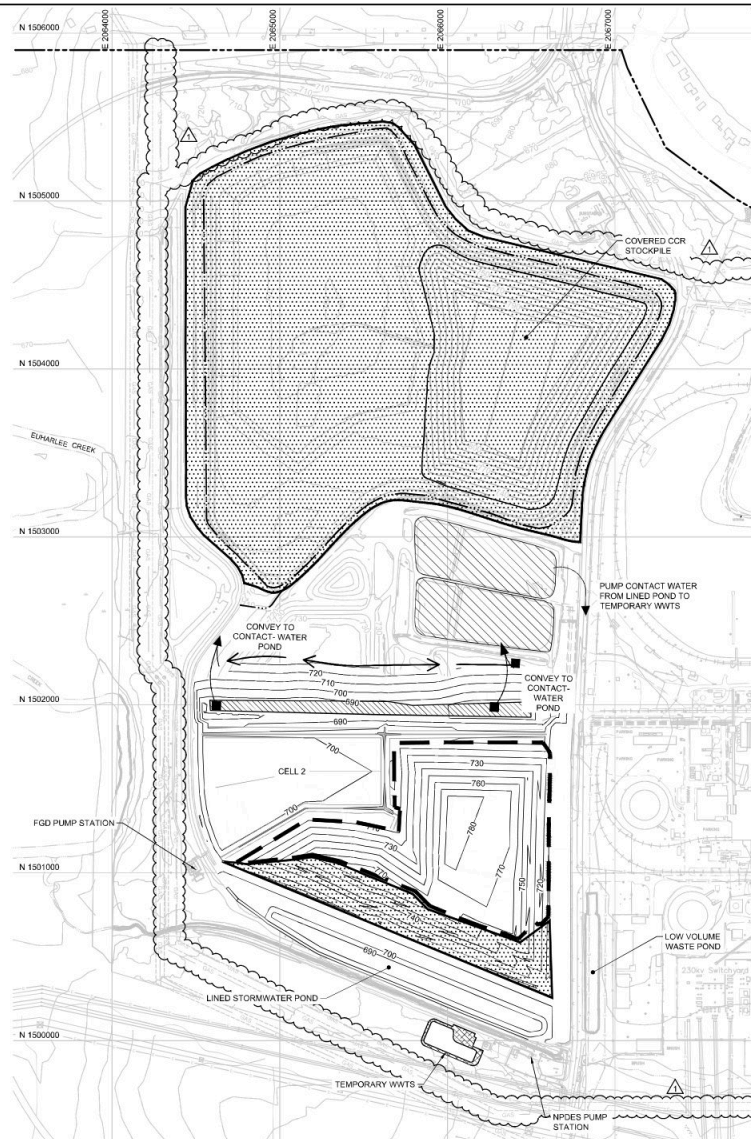


PHASE 4  
CELL 2 CONSTRUCTION AND  
CELLS 1 & 3 FILLING

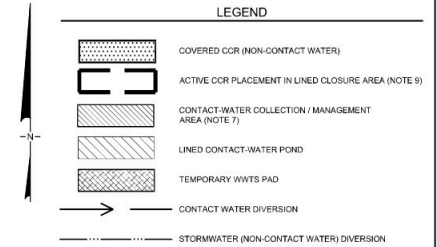

#### NOTES

1. THIS PHASING APPROACH IS CONCEPTUAL AND WILL BE REFINED DURING DETAILED DESIGN. IN ADDITION, CONTRACTOR WILL HAVE DISCRETION TO ADJUST PHASE BOUNDARIES AND SEQUENCE, STOCKPILE LOCATIONS, AND CONTACT-WATER COLLECTION / MANAGEMENT AREAS, BASED ON FIELD CONDITIONS ENCOUNTERED AND TO FACILITATE CONSTRUCTION, AS APPROVED BY GEORGIA POWER COMPANY, WITH REQUIREMENT THAT DESIGN CRITERIA INCLUDING THOSE RELATED TO STORMWATER AND CONTACT WATER MANAGEMENT, ARE MET.
2. STORMWATER AND CONTACT-WATER MANAGEMENT WILL BE CONDUCTED IN ACCORDANCE WITH THE PROCEDURES DESCRIBED IN THE 'CLOSURE PLAN' (PART A, SECTION 7 OF THIS PERMIT APPLICATION). DESIGN CRITERIA AND EVALUATION OF 'CASES RELATED TO THE CLOSURE PHASES PRESENTED HEREIN ARE PROVIDED IN A CALCULATION PACKAGE FOR INTERIM STORMWATER MANAGEMENT CONDITIONS, INCLUDED IN THE 'ENGINEERING REPORT' (PART B, SECTION 3 OF THIS PERMIT APPLICATION).
3. DURING CLOSURE CONSTRUCTION, CONTACT WATER WILL BE PUMPED OR CONVEYED BY GRAVITY TO LINED CONTACT-WATER PONDS WITHIN AP-1, WHERE IT WILL BE TEMPORARILY STORED AND THEN PUMPED TO AN ON-SITE TEMPORARY WASTEWATER TREATMENT SYSTEM (WWTs) OR OTHERWISE PROPERLY MANAGED IN ACCORDANCE WITH THE PLANT'S NPDES PERMIT REQUIREMENTS. NON-CONTACT STORMWATER WILL BE MANAGED IN ACCORDANCE WITH APPLICABLE EROSION AND SEDIMENT CONTROL FEATURES AND REQUIREMENTS PROVIDED IN THIS SET OF CLOSURE DRAWINGS, AND THEN DISCHARGED THROUGH EXISTING OR NEW STORMWATER PONDS TO RECEIVING WATER BODIES WITHOUT TREATMENT.
4. CONTRACTOR WILL BE REQUIRED TO TAKE REASONABLE MEASURES TO MINIMIZE STORMWATER RUN-ON INTO THE CONTACT-WATER COLLECTION / MANAGEMENT AREAS. MINIMIZATION TECHNIQUES MAY INCLUDE THE CONSTRUCTION OF TEMPORARY DIVERSION BERMS OR CHANNELS TO DIVERT STORMWATER AWAY FROM THE COLLECTION / MANAGEMENT AREAS.
5. COVER SYSTEM WILL BE TEMPORARILY TERMINATED AT CLOSURE INCREMENT PHASE BOUNDARIES AS SHOWN IN DETAILS 12 AND 13 ON DRAWING 29 FOR FINAL COVER SYSTEM (SOIL-GEOSYNTHETIC COMPOSITE COVER) AND ALTERNATIVE COVER SYSTEM (CLOSURE TURTLE COVER), RESPECTIVELY. CLOSURE INCREMENTS ARE APPROXIMATE FOR ILLUSTRATIVE PURPOSES, AND MAY BE ADJUSTED DURING CLOSURE.
6. TEMPORARY CCR STOCKPILE AREA(S) SHOWN ARE CONCEPTUAL AND THEIR LOCATIONS AND SIZES WILL BE REFINED DURING DETAILED DESIGN.
7. CONTACT-WATER COLLECTION / MANAGEMENT AREAS SHOWN ON THIS DRAWING MAY BE ADJUSTED OR SUPPLEMENTED DURING CONSTRUCTION AS NEEDED. CONTACT WATER WILL BE PROMPTLY TRANSFERRED TO THE LINED CONTACT-WATER POND TO MINIMIZE DURATION OF PONDING WITHIN AP-1 EXCAVATIONS.
8. TEMPORARY LINED STORMWATER PONDS (NON-CONTACT WATER) MAY BE UTILIZED DURING CONSTRUCTION AS NEEDED.
9. FOR PHASES WHERE COVERED CCR SHADING ENCLOSES AN ACTIVE CCR PLACEMENT, THIS INDICATES WHERE A TEMPORARY OR FINAL COVER SYSTEM INCREMENT MAY BE INSTALLED ONCE FINISHED WASTE GRADES ARE ACHIEVED FOR THAT PHASE.

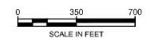


1	MAY 2024	UPDATE AND ADD GAS PIPELINES	JDV	RSB
3	AUG. 2021	SUBMITTAL TO GA EPD	JAN/H	RSB
REV.	DATE	DESCRIPTION	DRN	APP
CLOSURE PHASING PLANS 2				
PLANT BOWEN ASH POND 1 (AP-1) CLOSURE DRAWINGS BARTOW COUNTY, GEORGIA				
<div>Geosyntec<sup>®</sup> consultants</div> <div>1305 FORBES ROAD, SUITE 200 KENNESAW, GEORGIA 30144 USA PHONE: 478.202.9500 WWW.GEOSYNTEC.COM</div>				
PROJ. NO.	GR6601	DWG.	GR6601-021	EDIT 5/23/24
SCALE	1" = 350'			
DATE	AUGUST 2021			
DRAWING		21	OF	50




PERMIT DRAWING  
NOT FOR CONSTRUCTION




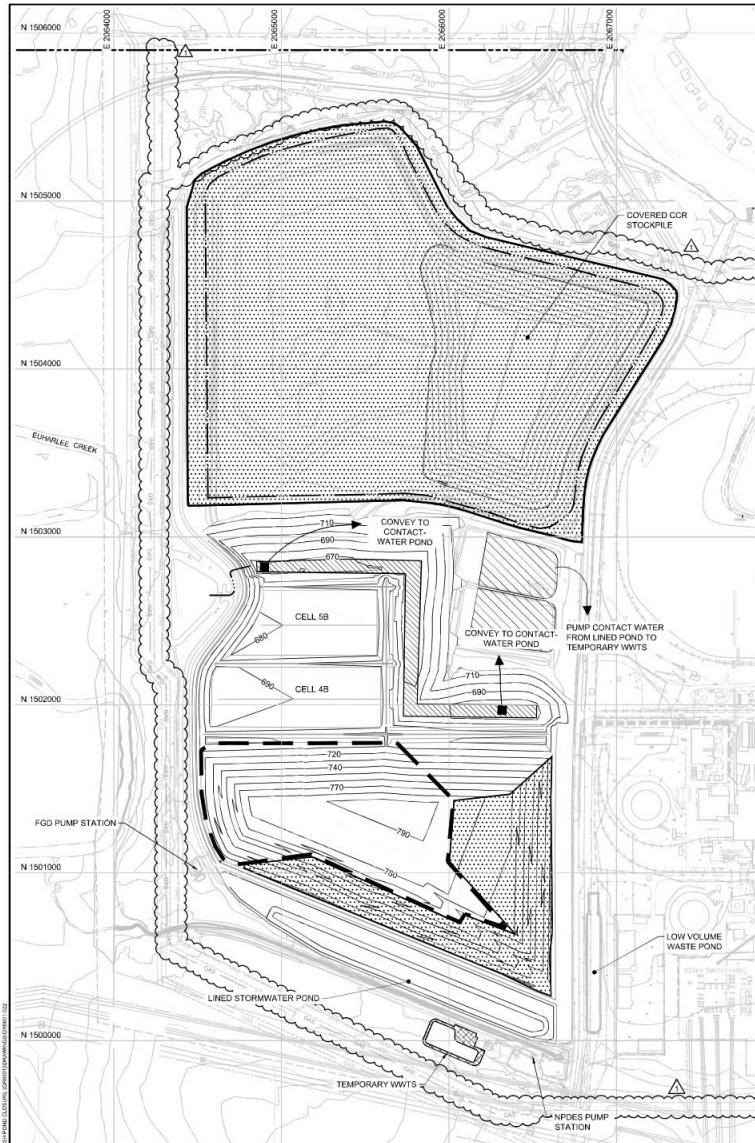

PHASE 5  
CELL 4B & 5B CONSTRUCTION AND  
CELL 2 FILLING

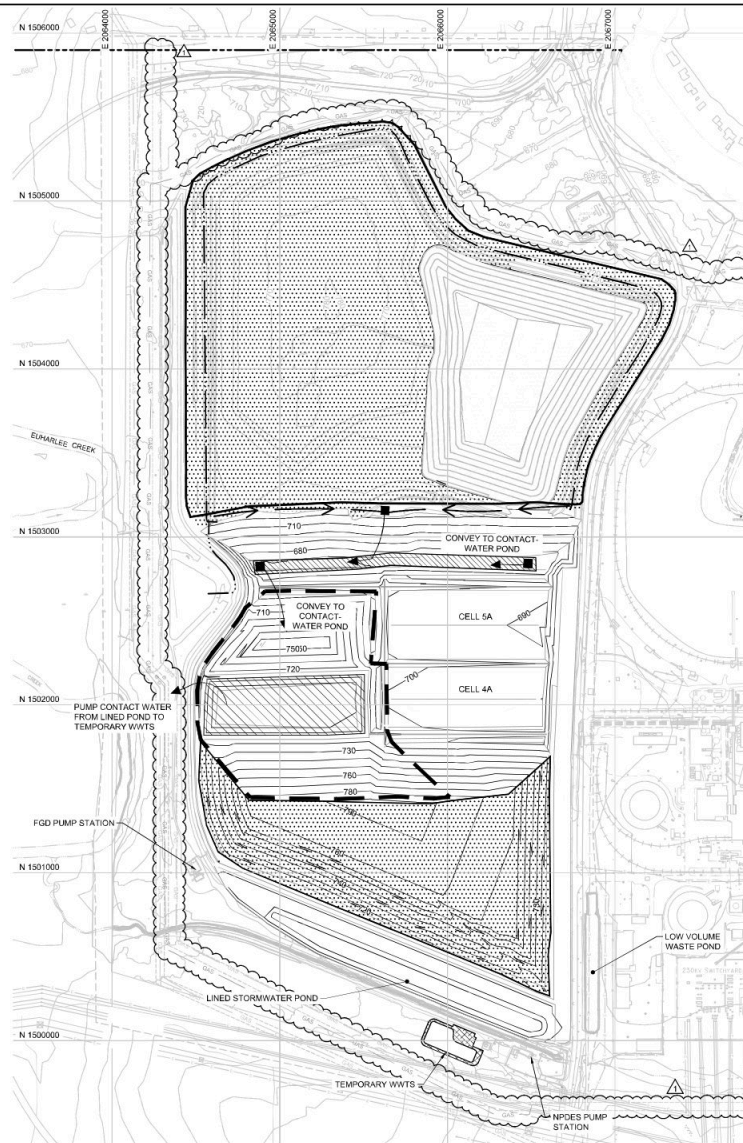

PHASE 6  
CELL 4A & 5A CONSTRUCTION AND  
CELL 4B & 5B FILLING

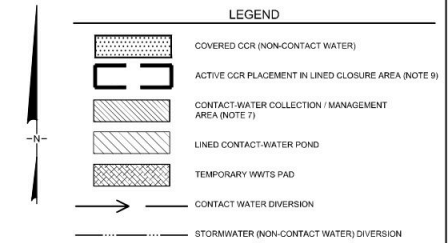

**NOTES**

1. THIS PHASING APPROACH IS CONCEPTUAL AND WILL BE REFINED DURING DETAILED DESIGN. IN ADDITION, CONTRACTOR WILL HAVE DISCRETION TO ADJUST PHASE BOUNDARIES AND SEQUENCE, STOCKPILE LOCATIONS, AND CONTACT-WATER COLLECTION / MANAGEMENT AREAS, BASED ON FIELD CONDITIONS ENCOUNTERED AND TO FACILITATE CONSTRUCTION, AS APPROVED BY GEORGIA POWER COMPANY, WITH REQUIREMENT THAT DESIGN CRITERIA INCLUDING THOSE RELATED TO STORMWATER AND CONTACT WATER MANAGEMENT, ARE MET.
2. STORMWATER AND CONTACT-WATER MANAGEMENT WILL BE CONDUCTED IN ACCORDANCE WITH THE PROCEDURES DESCRIBED IN THE "CLOSURE PLAN" (PART A, SECTION 7 OF THIS PERMIT APPLICATION). DESIGN CRITERIA AND EVALUATION OF CASES RELATED TO THE CLOSURE PHASES PRESENTED HEREIN ARE PROVIDED IN A CALCULATION PACKAGE FOR INTERIM STORMWATER MANAGEMENT CONDITIONS, INCLUDED IN THE "ENGINEERING REPORT" (PART B, SECTION 3 OF THIS PERMIT APPLICATION).
3. DURING CLOSURE CONSTRUCTION, CONTACT WATER WILL BE PUMPED OR CONVEYED BY GRAVITY TO LINED CONTACT-WATER PONDS WITHIN AP-1, WHERE IT WILL BE TEMPORARILY STORED AND THEN PUMPED TO AN ON-SITE TEMPORARY WASTEWATER TREATMENT SYSTEM (WWTS) OR OTHERWISE PROPERLY MANAGED IN ACCORDANCE WITH THE PLANT'S NPDES PERMIT REQUIREMENTS. NON-CONTACT STORMWATER WILL BE MANAGED IN ACCORDANCE WITH APPLICABLE EROSION AND SEDIMENT CONTROL FEATURES AND REQUIREMENTS PROVIDED IN THIS SET OF CLOSURE DRAWINGS, AND THEN DISCHARGED THROUGH EXISTING OR NEW STORMWATER PONDS TO RECEIVING WATER BODIES WITHOUT TREATMENT.
4. CONTRACTOR WILL BE REQUIRED TO TAKE REASONABLE MEASURES TO MINIMIZE STORMWATER RUN-ON INTO THE CONTACT-WATER COLLECTION / MANAGEMENT AREAS. MINIMIZATION TECHNIQUES MAY INCLUDE THE CONSTRUCTION OF TEMPORARY DIVERSION BERMS OR CHANNELS TO DIVERT STORMWATER AWAY FROM THE COLLECTION / MANAGEMENT AREAS.
5. COVER SYSTEM WILL BE TEMPORARILY TERMINATED AT CLOSURE INCREMENT PHASE BOUNDARIES AS SHOWN IN DETAILS 12 AND 13 ON DRAWING 29 FOR FINAL COVER SYSTEM (SOL-GEOSYNTHETIC COMPOSITE COVER) AND ALTERNATIVE COVER SYSTEM (CLOSURE TIER-6 COVER), RESPECTIVELY. CLOSURE INCREMENTS ARE APPROXIMATE FOR ILLUSTRATIVE PURPOSES, AND MAY BE ADJUSTED DURING CLOSURE.
6. TEMPORARY CCR STOCKPILE AREA(S) SHOWN ARE CONCEPTUAL AND THEIR LOCATIONS AND SIZES WILL BE REFINED DURING DETAILED DESIGN.
7. CONTACT-WATER COLLECTION / MANAGEMENT AREAS SHOWN ON THIS DRAWING MAY BE ADJUSTED OR SUPPLEMENTED DURING CONSTRUCTION AS NEEDED. CONTACT WATER WILL BE PROMPTLY TRANSFERRED TO THE LINED CONTACT-WATER POND TO MINIMIZE DURATION OF PONDING WITHIN AP-1 EXCAVATIONS.
8. TEMPORARY LINED STORMWATER PONDS (NON-CONTACT WATER) MAY BE UTILIZED DURING CONSTRUCTION AS NEEDED.
9. FOR PHASES WHERE COVERED CCR SHADING ENCLOSES AN ACTIVE CCR PLACEMENT, THIS INDICATES WHERE A TEMPORARY OR FINAL COVER SYSTEM INCREMENT MAY BE INSTALLED ONCE FINISHED WASTE GRADES ARE ACHIEVED FOR THAT PHASE.




1	MAY 2024	UPDATE AND ADD GAS PIPELINES	JDV	RSB
3	AUG. 2021	SUBMITTAL TO GA EPD	JAN/H	RSB
REV.	DATE	DESCRIPTION	DRN	APP
CLOSURE PHASING PLANS 3				
PLANT BOWEN ASH POND 1 (AP-1) CLOSURE DRAWINGS BARTOW COUNTY, GEORGIA				
Geosyntec <sup>®</sup> consultants			1205 FORBES ROAD, SUITE 200 KENNESAW, GEORGIA 30144 USA PHONE: 478.302.9500 WWW.GEOSYNTEC.COM	
PROJ. NO.	GR6601	DWG.	GR6601-022	EDIT 5/23/24
SCALE	1" = 350'	DRAWING 22 OF 50		
DATE	AUGUST 2021			




PERMIT DRAWING  
NOT FOR CONSTRUCTION




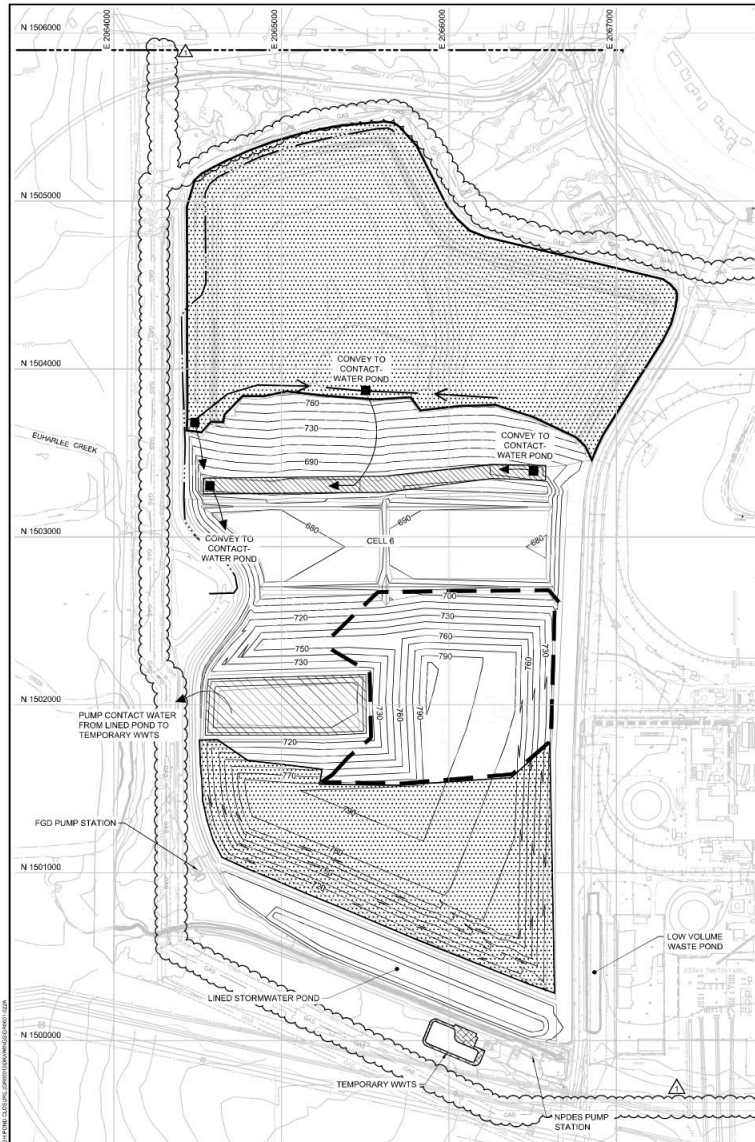

PHASE 7  
CELL 6 CONSTRUCTION AND CELL  
4A & 5A FILLING

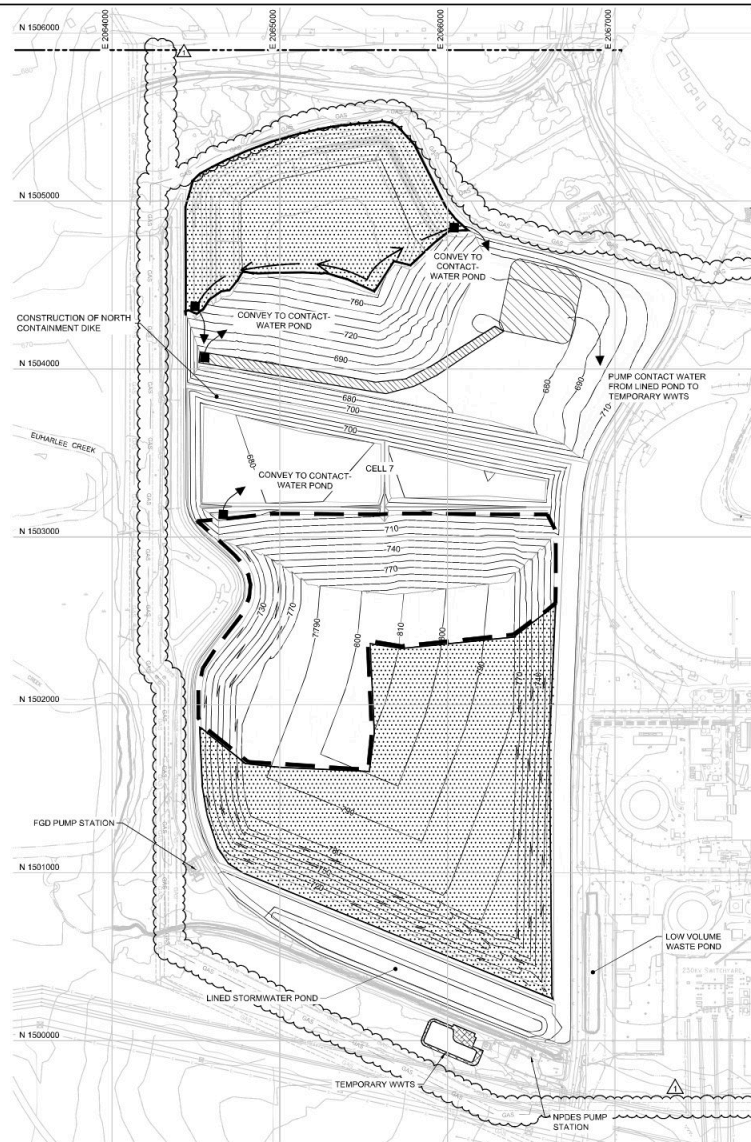

PHASE 8  
CELL 7 CONSTRUCTION AND CELL  
6 FILLING

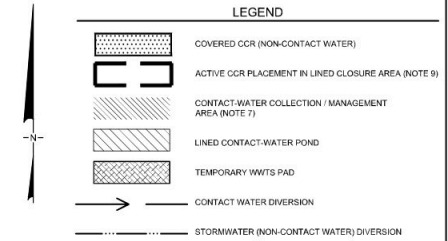

- NOTES:
1. THIS PHASING APPROACH IS CONCEPTUAL AND WILL BE REFINED DURING DETAILED DESIGN. IN ADDITION, CONTRACTOR WILL HAVE DISCRETION TO ADJUST PHASE BOUNDARIES AND SEQUENCE, STOOPIE LOCATIONS, AND CONTACT WATER COLLECTION / MANAGEMENT AREAS, BASED ON FIELD CONDITIONS ENCOUNTERED AND TO FACILITATE CONSTRUCTION, AS APPROVED BY GEORGIA POWER COMPANY, WITH REQUIREMENT THAT DESIGN CRITERIA INCLUDING THOSE RELATED TO STORMWATER AND CONTACT WATER MANAGEMENT, ARE MET.
  2. STORMWATER AND CONTACT WATER MANAGEMENT WILL BE CONDUCTED IN ACCORDANCE WITH THE PROCEDURES DESCRIBED IN THE CLOSURE PLAN (PART A, SECTION 7 OF THIS PERMIT APPLICATION). DESIGN CRITERIA AND EVALUATION OF CASES RELATED TO THE CLOSURE PHASES PRESENTED HEREIN ARE PROVIDED IN A CALCULATION PACKAGE FOR INTERIM STORMWATER MANAGEMENT CONDITIONS, INCLUDED IN THE ENGINEERING REPORT (PART B, SECTION 3 OF THIS PERMIT APPLICATION).
  3. DURING CLOSURE CONSTRUCTION, CONTACT WATER WILL BE PUMPED OR CONVEYED BY GRAVITY TO LINED CONTACT WATER PONDS WITHIN AP-1, WHERE IT WILL BE TEMPORARILY STORED AND THEN PUMPED TO AN ON-SITE TEMPORARY WASTEWATER TREATMENT SYSTEM (WWTS) OR OTHERWISE PROPERLY MANAGED IN ACCORDANCE WITH THE PLANT'S NPDES PERMIT REQUIREMENTS. NON-CONTACT STORMWATER WILL BE MANAGED IN ACCORDANCE WITH APPLICABLE EROSION AND SEDIMENT CONTROL FEATURES AND REQUIREMENTS PROVIDED IN THIS SET OF CLOSURE DRAWINGS, AND THEN DISCHARGED THROUGH EXISTING OR NEW STORMWATER PONDS TO RECEIVING WATER BODIES WITHOUT TREATMENT.
  4. CONTRACTOR WILL BE REQUIRED TO TAKE REASONABLE MEASURES TO MINIMIZE STORMWATER RUN-OFF INTO THE CONTACT WATER COLLECTION / MANAGEMENT AREAS. MINIMIZATION TECHNIQUES MAY INCLUDE THE CONSTRUCTION OF TEMPORARY DIVERSION BERM OR CHANNELS TO DIVERT STORMWATER AWAY FROM THE COLLECTION / MANAGEMENT AREAS.
  5. COVER SYSTEM WILL BE TEMPORARILY TERMINATED AT CLOSURE INCREMENT PHASE BOUNDARIES AS SHOWN IN DETAILS 12 AND 13 ON DRAWING 29 FOR FINAL COVER SYSTEM (SOIL-GEOSYNTHETIC COMPOSITE COVER) AND ALTERNATIVE COVER SYSTEM (CLOSURE TURF COVER), RESPECTIVELY. CLOSURE INCREMENTS ARE APPROXIMATE FOR ILLUSTRATIVE PURPOSES, AND MAY BE ADJUSTED DURING CLOSURE.
  6. CONTACT WATER COLLECTION / MANAGEMENT AREAS SHOWN ON THIS DRAWING MAY BE ADJUSTED OR SUPPLEMENTED DURING CONSTRUCTION AS NEEDED. CONTACT WATER WILL BE PROMPTLY TRANSFERRED TO THE LINED CONTACT WATER POND TO MINIMIZE DURATION OF PONDING WITHIN AP-1 EXCAVATIONS.
  7. TEMPORARY LINED STORMWATER PONDS (NON-CONTACT WATER) MAY BE UTILIZED DURING CONSTRUCTION AS NEEDED.
  8. FOR PHASES WHERE COVERED CCR SHADING ENCROACHES ON ACTIVE CCR PLACEMENT, THIS INDICATES WHERE A TEMPORARY OR FINAL COVER SYSTEM INCREMENT MAY BE INSTALLED ONCE FINISHED WASTE GRADES ARE ACHIEVED FOR THAT PHASE.



1	MAY 2024	UPDATE AND ADD GAS PIPELINES	J2V	RSB
2	AUG 2021	SUBMITTAL TO GA EPD	JAN/H	RSB
REV	DATE	DESCRIPTION	DRN	APP

CLOSURE PHASING PLANS 4

PLANT BOWEN ASH POND 1 (AP-1)  
CLOSURE DRAWINGS  
BARTOW COUNTY, GEORGIA



**Geosyntec**  
consultants

1305 ROBERTS ROAD, SUITE 200 KENNESAW, GEORGIA 30144 USA		PHONE: 478.302.9500 WWW.GEOSYNTEC.COM	
PROJ. NO.	GR6601	DWG.	GR6601-022A
SCALE	1" = 350'	EDIT	5/23/24
DATE	AUGUST 2021	DRAWING	23 OF 50



PERMIT DRAWING  
NOT FOR CONSTRUCTION



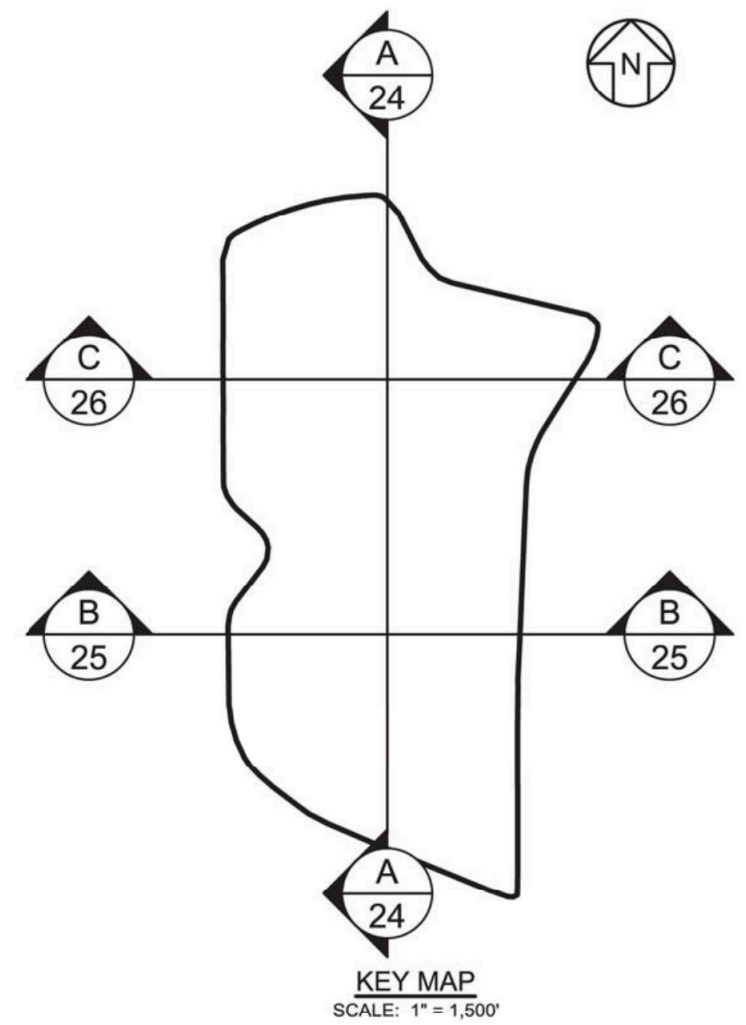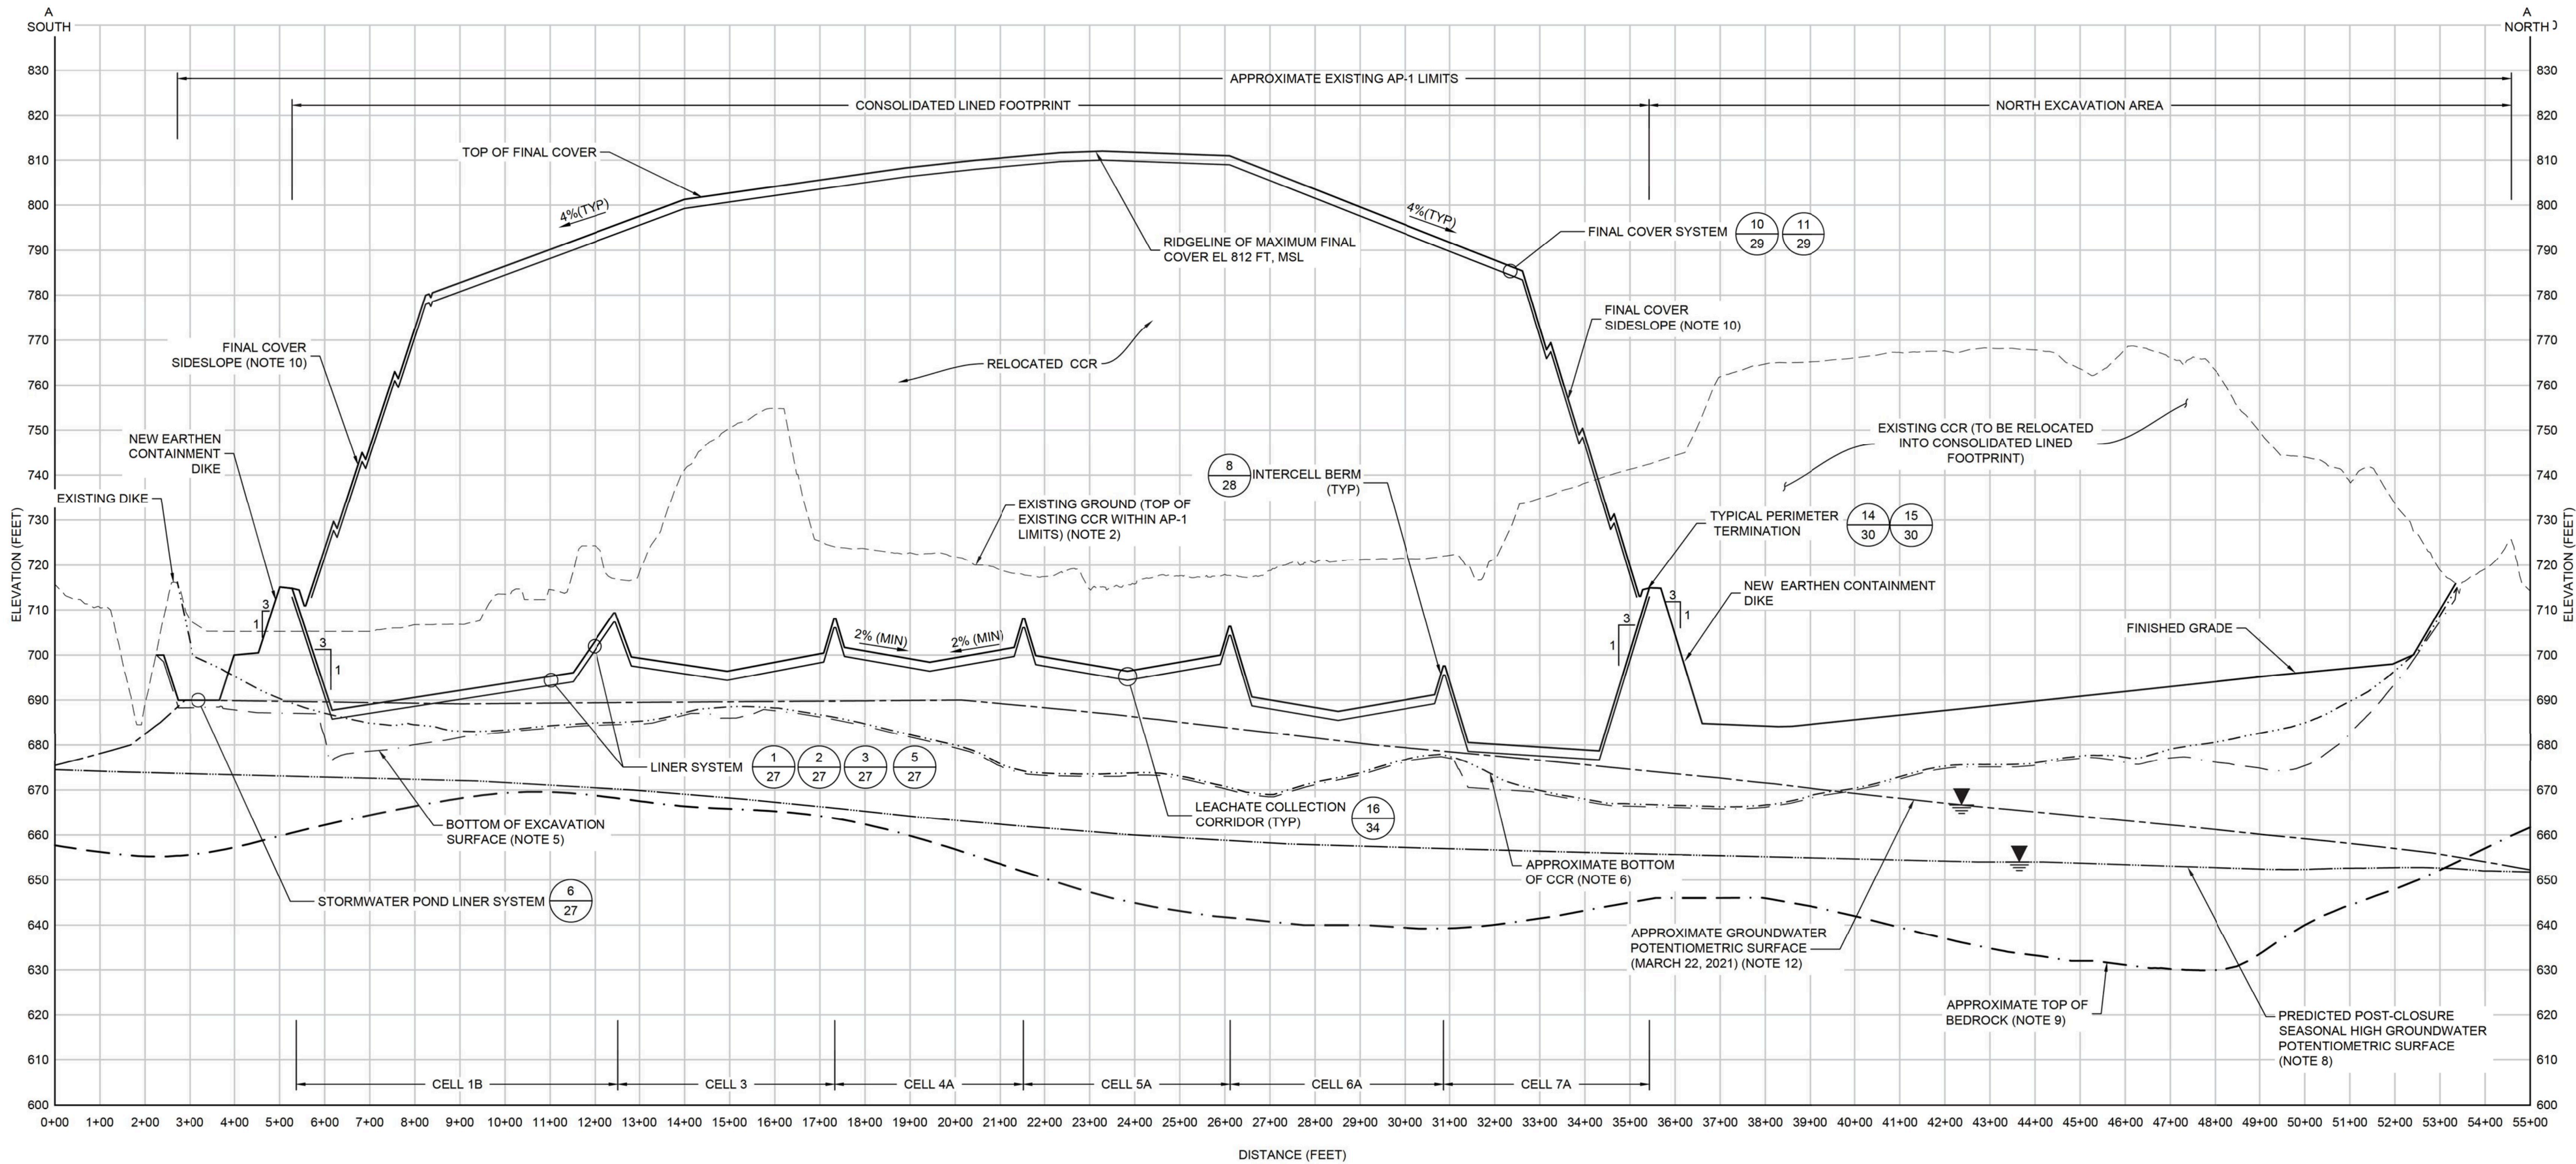

NOTES:

- SEE DRAWING 2 FOR LEGENDS, ABBREVIATIONS, AND GENERAL SITE NOTES.
- EXISTING GROUND SHOWN ON THIS DRAWING IS TAKEN FROM THE TOPOGRAPHIC BASE MAP SHOWN ON DRAWING 4.
- TOP OF LINER (GEOMEMBRANE COMPONENT OF THE LINER SYSTEM) SHOWN ON THIS DRAWING IS TAKEN FROM DRAWING 11.
- TOP OF FINAL COVER AND FINISHED GRADES BEYOND THE CONSOLIDATED LINED FOOTPRINT LIMITS SHOWN ON THIS DRAWING ARE TAKEN FROM DRAWING 17.
- EXCAVATION SURFACE ELEVATION REPRESENTS A MINIMUM EXCAVATION DEPTH, IS APPROXIMATE, AND IS TAKEN FROM DRAWING 8.
- APPROXIMATE BOTTOM OF CCR SHOWN ON THIS DRAWING IS TAKEN FROM DRAWING 6.
- TOP OF FINAL COVER SURFACE (AND MAXIMUM ELEVATION) IS BASED ON THE SOIL-GEOSYNTHETIC COVER SYSTEM ALTERNATIVE.
- PREDICTED POST-CLOSURE SEASONAL HIGH GROUNDWATER POTENTIOMETRIC SURFACE SHOWN ON THIS DRAWING OBTAINED FROM GROUNDWATER FLOW MODELING RESULTS AS DOCUMENTED IN THE "HYDROGEOLOGIC ASSESSMENT REPORT (REVISION 3)" INCLUDED WITH THIS PERMIT APPLICATION AND SHOWN ON DRAWINGS 11 THROUGH 13.
- TOP OF BEDROCK SURFACE IS APPROXIMATE AND WAS DEVELOPED BY GEOSYNTEC CONSULTANTS USING AVAILABLE SUBSURFACE INFORMATION FROM PREVIOUS SITE INVESTIGATIONS.
- TOP OF FINAL COVER DESIGN GRADES ARE SLOPED AT NO STEEPER THAN 3H:1V ON LANDFILL SIDESLOPES BETWEEN DRAINAGE BENCHES, AND AT A MINIMUM OF FOUR (4) PERCENT ON THE LANDFILL TOP AREAS. SLOPES AND FINAL COVER SYSTEM LAYER THICKNESS MAY APPEAR DISTORTED ON THESE CROSS SECTIONS DUE TO THE EXAGGERATED VERTICAL SCALE AND SKEWED ANGLE AT WHICH THESE SECTIONS WERE CUT COMPARED TO THE THREE-DIMENSIONAL TRUE SLOPE DIRECTIONS.
- LINER DESIGN GRADES ARE SLOPED AT NO STEEPER THAN 3H:1V ON DIKE AND INTERCELL BERM LINER SIDESLOPES, AND AT A MINIMUM OF TWO (2) PERCENT TOWARDS THE LEACHATE COLLECTION CORRIDORS ON THE CELL FLOOR AREAS. LEACHATE COLLECTION CORRIDORS ARE SLOPED AT A MINIMUM OF ONE (1) PERCENT TOWARDS THE SUMPS. SLOPES AND LAYER THICKNESS MAY APPEAR DISTORTED ON THESE CROSS SECTIONS DUE TO THE EXAGGERATED VERTICAL SCALE AND SKEWED ANGLE AT WHICH THESE SECTIONS WERE CUT COMPARED TO THE THREE-DIMENSIONAL TRUE SLOPE DIRECTIONS.
- APPROXIMATE GROUNDWATER POTENTIOMETRIC SURFACE IS FROM WATER LEVEL MEASUREMENTS DATED 22 MARCH 2021 IN WELLS/PIEZOMETERS SCREENED IN BEDROCK AS PRESENTED IN THE "HYDROGEOLOGIC ASSESSMENT REPORT (REVISION 3)" INCLUDED WITH THIS PERMIT APPLICATION. THE MARCH 2021 POTENTIOMETRIC SURFACE IS HIGHER THAN THAT ASSOCIATED WITH THE DEWATERED AND CLOSED CONDITION WITHIN AP-1, AS REFLECTED IN NOTE 8.



**SECTION A 11**  
**NORTH-SOUTH CROSS SECTION**  
SCALE: 1"=200' (HORIZONTAL); 1"=20' (VERTICAL)



PERMIT DRAWING  
NOT FOR CONSTRUCTION

0	AUG. 2021	SUBMITTAL TO GA EPD	JJ/VKH	RB
REV	DATE	DESCRIPTION	DRN	APP
SITE CROSS SECTIONS I				
PLANT BOWEN ASH POND 1 (AP-1) CLOSURE DRAWINGS BARTOW COUNTY, GEORGIA				
<b>Geosyntec</b> consultants				
1255 ROBERTS BOULEVARD, NW, SUITE 200 KENNESAW, GEORGIA 30144 USA PHONE: 678.202.9600 WWW.GEOSYNTEC.COM				
PROJ. NO.	GR6601	DWG.	GR6601-023	EDIT
SCALE	AS SHOWN	DRAWING 24 OF 50		
DATE	AUGUST 2021			



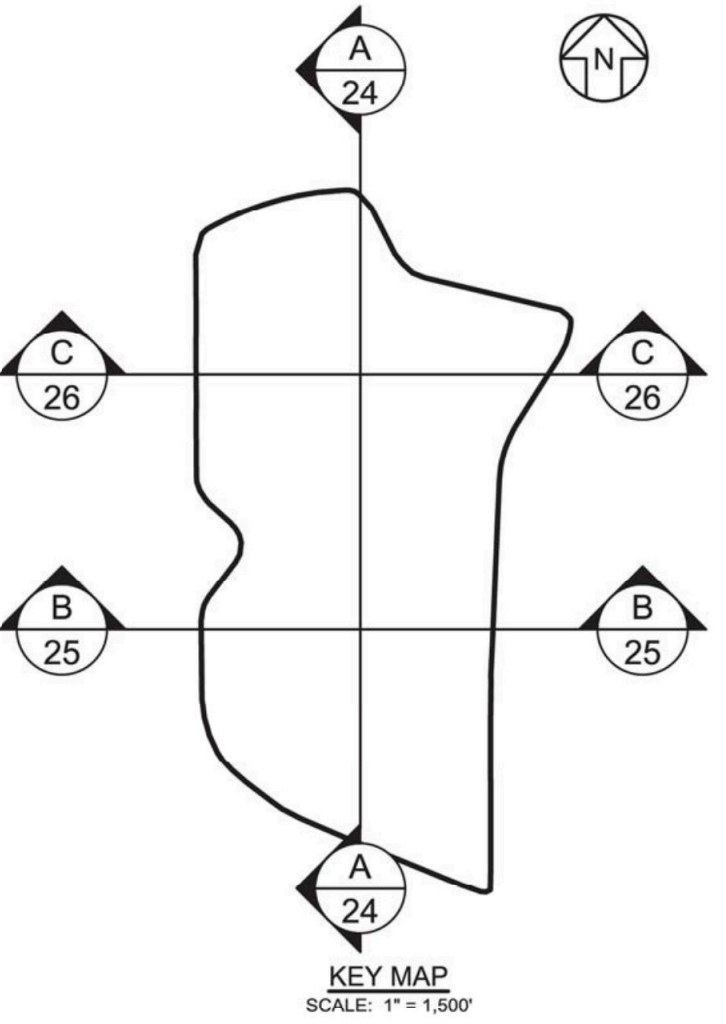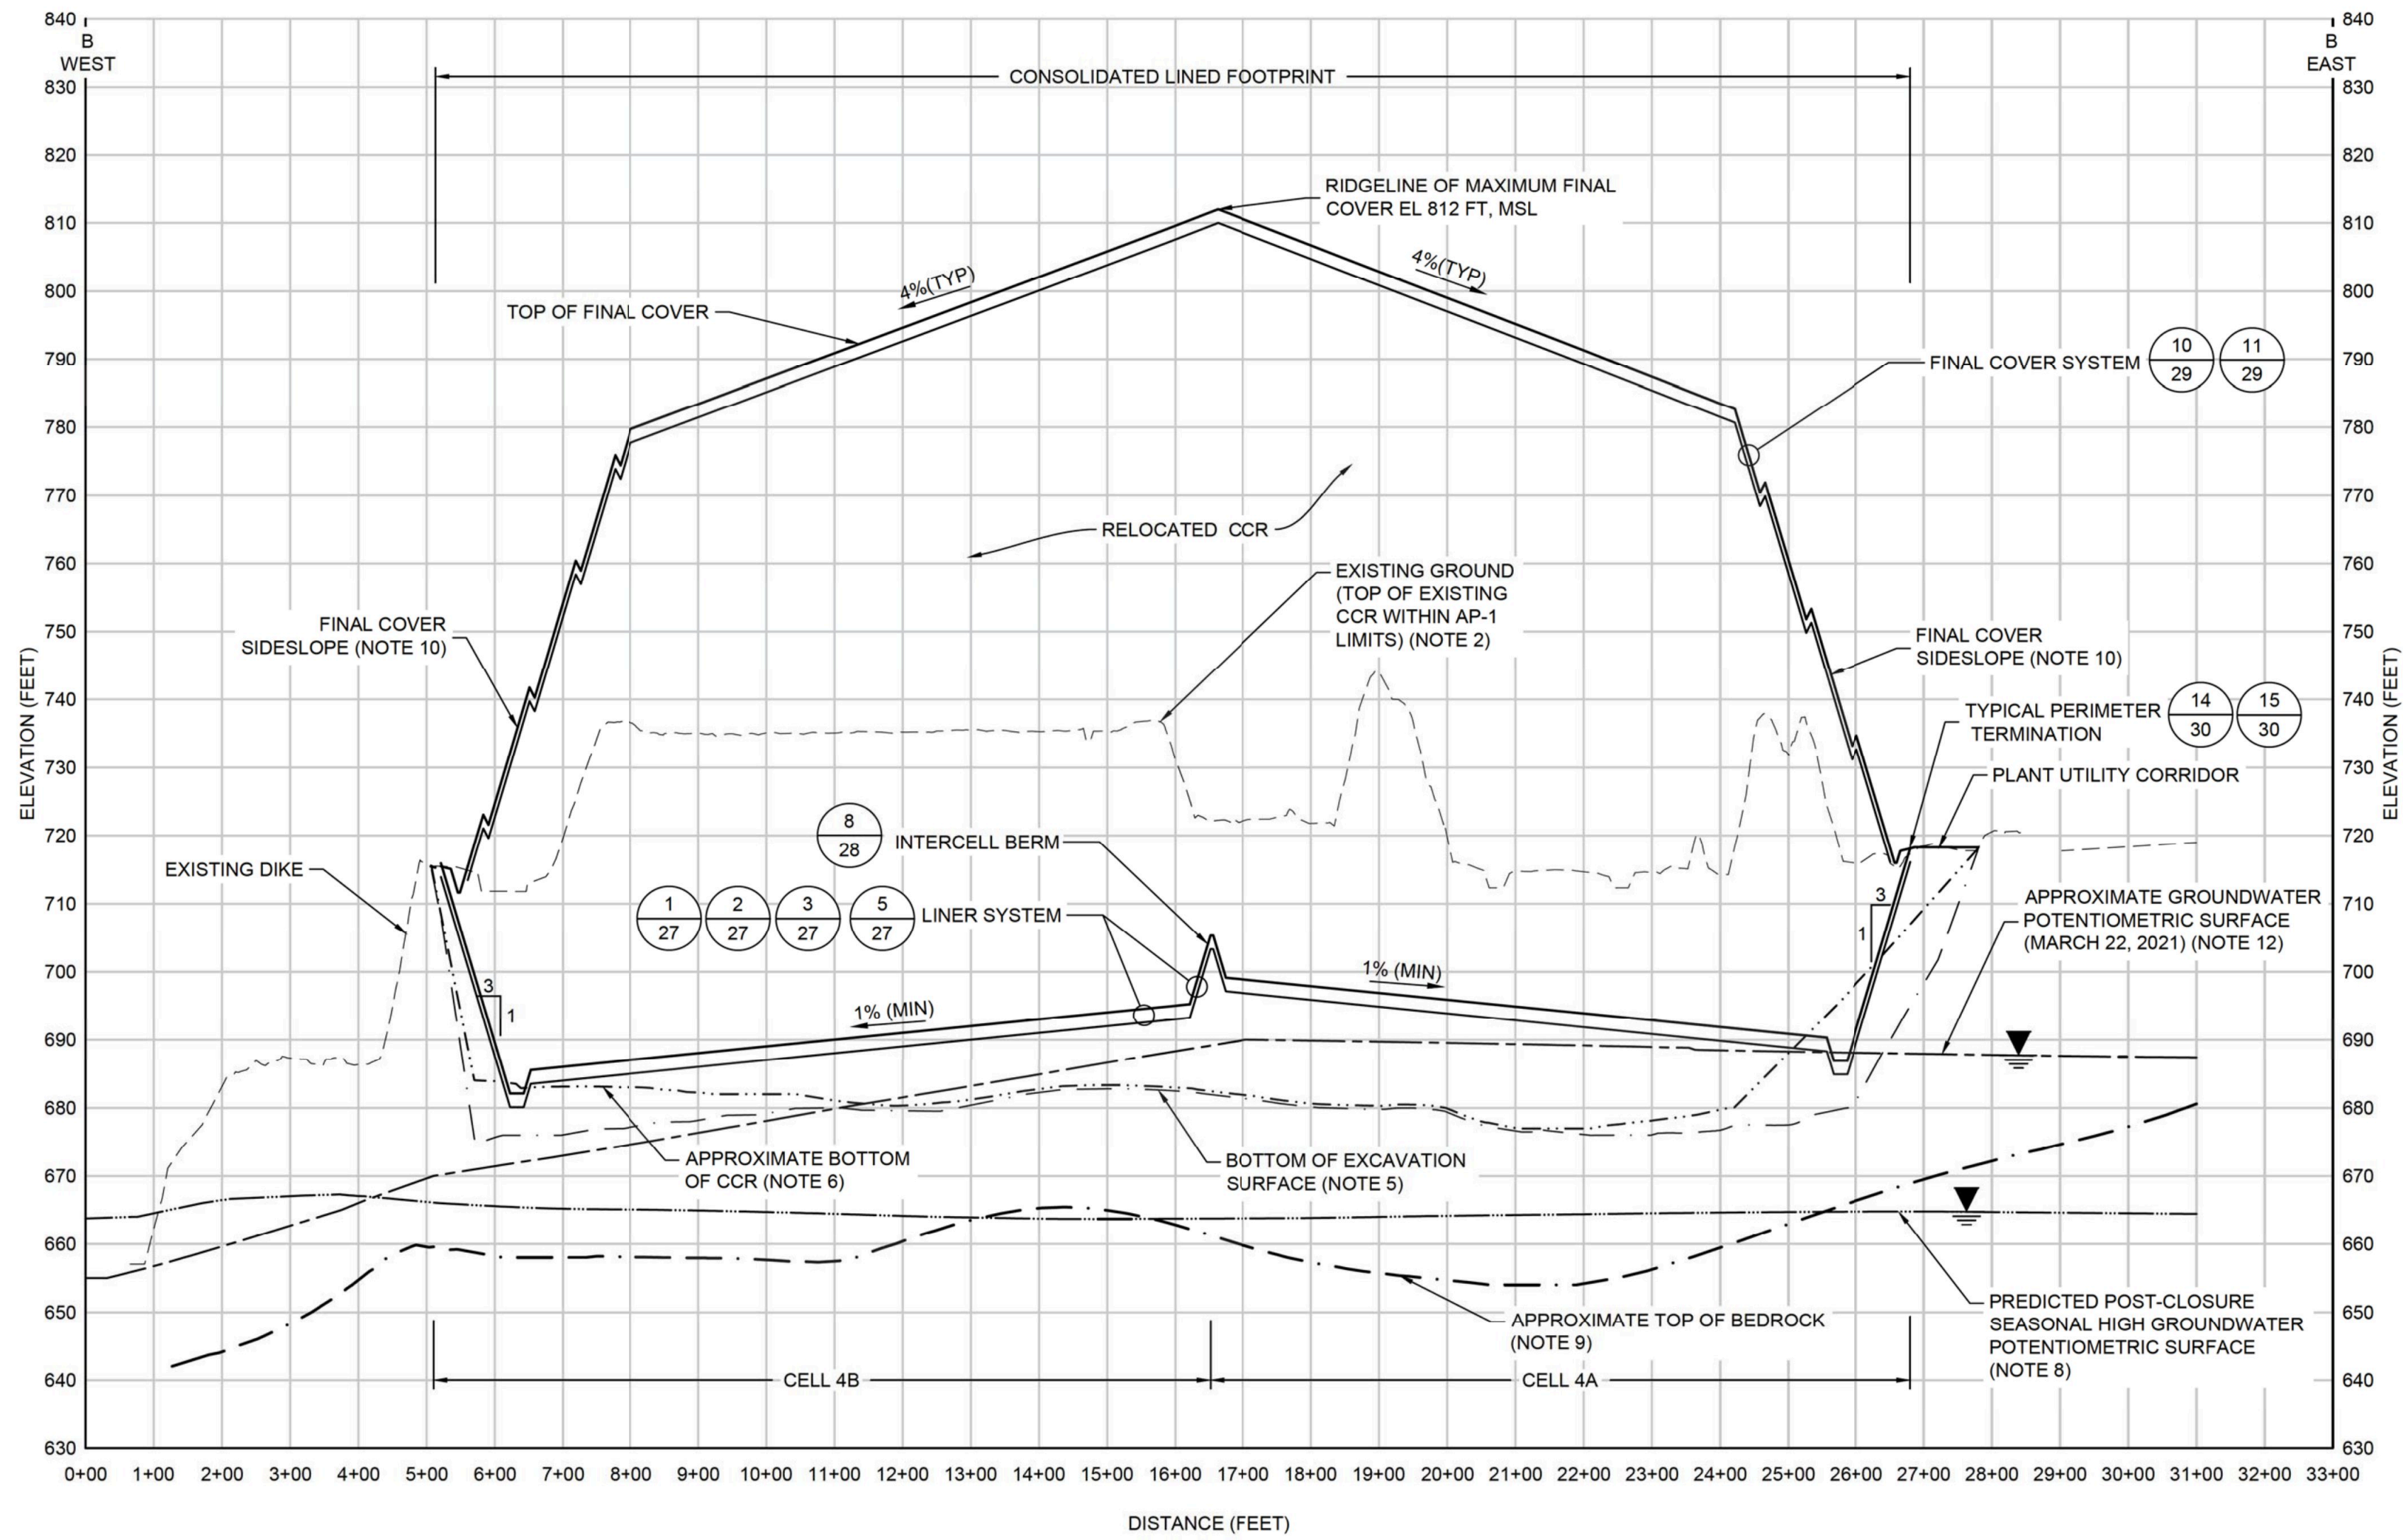

B  
11

SECTION  
EAST-WEST CROSS SECTION

SCALE: 1"=200' (HORIZONTAL); 1"=20' (VERTICAL)

NOTES:


- SEE DRAWING 2 FOR LEGENDS, ABBREVIATIONS, AND GENERAL SITE NOTES.
- EXISTING GROUND SHOWN ON THIS DRAWING IS TAKEN FROM THE TOPOGRAPHIC BASE MAP SHOWN ON DRAWING 4.
- TOP OF LINER (GEOMEMBRANE COMPONENT OF THE LINER SYSTEM) SHOWN ON THIS DRAWING IS TAKEN FROM DRAWING 11.
- TOP OF FINAL COVER AND FINISHED GRADES BEYOND THE CONSOLIDATED LINED FOOTPRINT LIMITS SHOWN ON THIS DRAWING ARE TAKEN FROM DRAWING 17.
- EXCAVATION SURFACE ELEVATION REPRESENTS A MINIMUM EXCAVATION DEPTH, IS APPROXIMATE, AND IS TAKEN FROM DRAWING 8.
- APPROXIMATE BOTTOM OF CCR SHOWN ON THIS DRAWING IS TAKEN FROM DRAWING 6.
- TOP OF FINAL COVER SURFACE (AND MAXIMUM ELEVATION) IS BASED ON THE SOIL-GEOSYNTHETIC COVER SYSTEM ALTERNATIVE.
- PREDICTED POST-CLOSURE SEASONAL HIGH GROUNDWATER POTENTIOMETRIC SURFACE SHOWN ON THIS DRAWING OBTAINED FROM GROUNDWATER FLOW MODELING RESULTS AS DOCUMENTED IN THE "HYDROGEOLOGIC ASSESSMENT REPORT (REVISION 3)" INCLUDED WITH THIS PERMIT APPLICATION AND SHOWN ON DRAWINGS 11 THROUGH 13.
- TOP OF BEDROCK SURFACE IS APPROXIMATE AND WAS DEVELOPED BY GEOSYNTEC CONSULTANTS USING AVAILABLE SUBSURFACE INFORMATION FROM PREVIOUS SITE INVESTIGATIONS.
- TOP OF FINAL COVER DESIGN GRADES ARE SLOPED AT NO STEEPER THAN 3H:1V ON LANDFILL SIDESLOPES BETWEEN DRAINAGE BENCHES, AND AT A MINIMUM OF FOUR (4) PERCENT ON THE LANDFILL TOP AREAS. SLOPES AND FINAL COVER SYSTEM LAYER THICKNESS MAY APPEAR DISTORTED ON THESE CROSS SECTIONS DUE TO THE EXAGGERATED VERTICAL SCALE AND SKEWED ANGLE AT WHICH THESE SECTIONS WERE CUT COMPARED TO THE THREE-DIMENSIONAL TRUE SLOPE DIRECTIONS.
- LINER DESIGN GRADES ARE SLOPED AT NO STEEPER THAN 3H:1V ON DIKE AND INTERCELL BERM LINER SIDESLOPES, AND AT A MINIMUM OF TWO (2) PERCENT TOWARDS THE LEACHATE COLLECTION CORRIDORS ON THE CELL FLOOR AREAS. LEACHATE COLLECTION CORRIDORS ARE SLOPED AT A MINIMUM OF ONE (1) PERCENT TOWARDS THE SUMPS. SLOPES AND LAYER THICKNESS MAY APPEAR DISTORTED ON THESE CROSS SECTIONS DUE TO THE EXAGGERATED VERTICAL SCALE AND SKEWED ANGLE AT WHICH THESE SECTIONS WERE CUT COMPARED TO THE THREE-DIMENSIONAL TRUE SLOPE DIRECTIONS.
- APPROXIMATE GROUNDWATER POTENTIOMETRIC SURFACE IS FROM WATER LEVEL MEASUREMENTS DATED 22 MARCH 2021 IN WELLS/PIEZOMETERS SCREENED IN BEDROCK AS PRESENTED IN THE "HYDROGEOLOGIC ASSESSMENT REPORT (REVISION 3)" INCLUDED WITH THIS PERMIT APPLICATION. THE MARCH 2021 POTENTIOMETRIC SURFACE IS HIGHER THAN THAT ASSOCIATED WITH THE DEWATERED AND CLOSED CONDITION WITHIN AP-1, AS REFLECTED IN NOTE 8.



PERMIT DRAWING  
NOT FOR CONSTRUCTION

0	AUG. 2021	SUBMITTAL TO GA EPD	JJ/VKH	RB
REV	DATE	DESCRIPTION	DRN	APP
SITE CROSS SECTIONS II				
PLANT BOWEN ASH POND 1 (AP-1) CLOSURE DRAWINGS BARTOW COUNTY, GEORGIA				
Geosyntec consultants				
1255 ROBERTS BOULEVARD, NW, SUITE 200 KENNESAW, GEORGIA 30144 USA PHONE: 678.202.9600 WWW.GEOSYNTEC.COM				
PROJ. NO.	GR6601	DWG.	GR6601-024	EDIT 8/16/21
SCALE	AS SHOWN	DRAWING 25 OF 50		
DATE	AUGUST 2021			



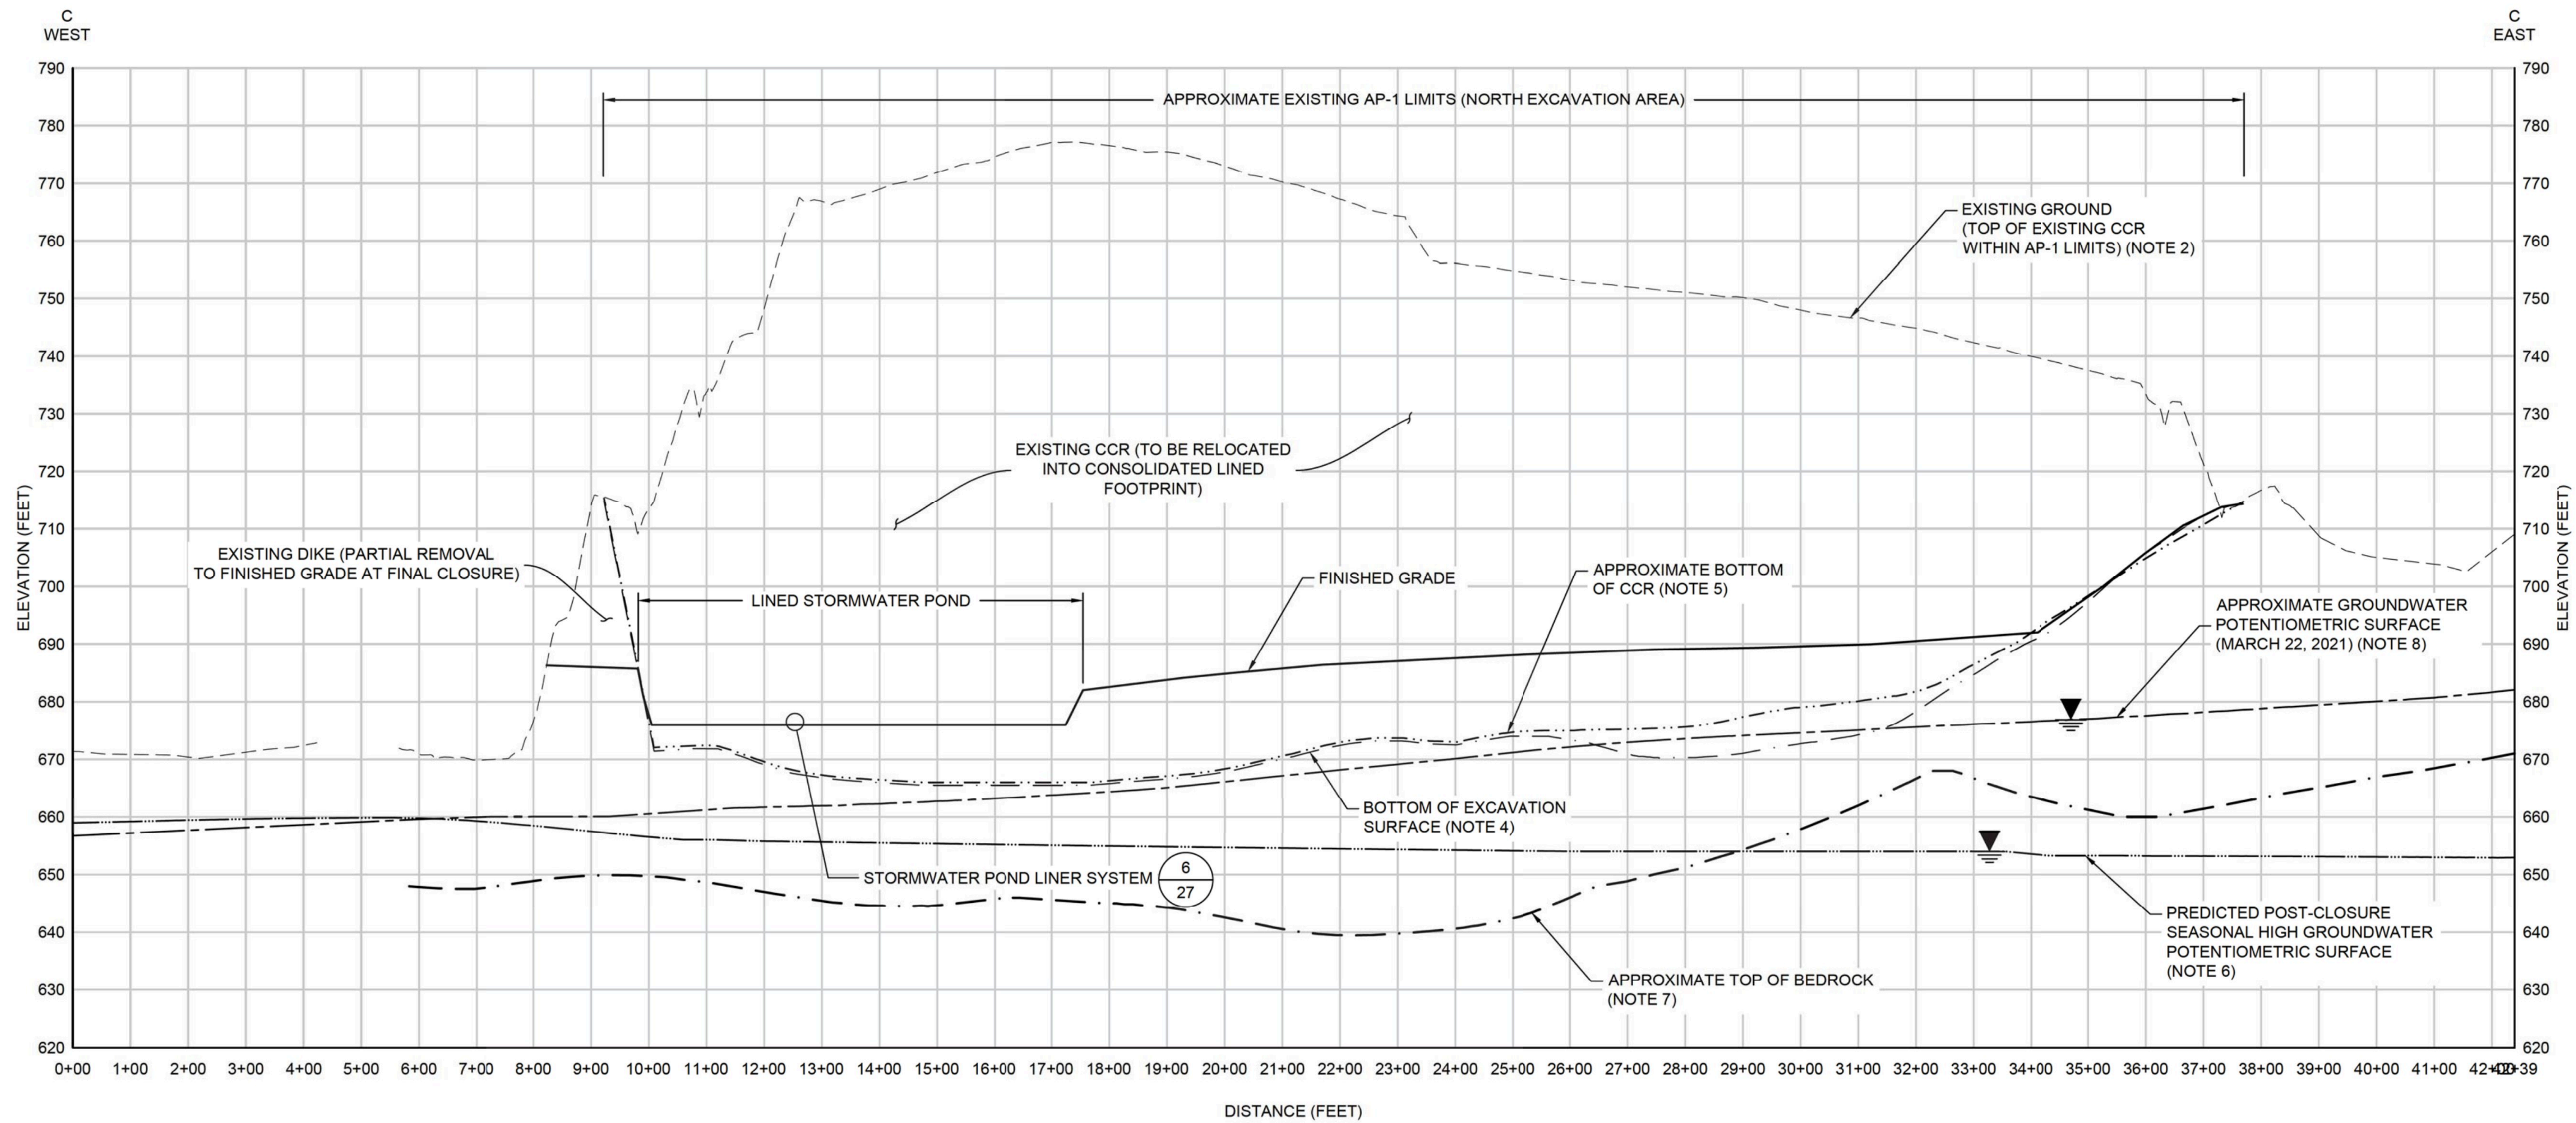

**C**  
**11**

**SECTION**  
**EAST-WEST CROSS SECTION**

SCALE: 1"=200' (HORIZONTAL); 1"=20' (VERTICAL)


NOTES:

1. SEE DRAWING 2 FOR LEGENDS, ABBREVIATIONS, AND GENERAL SITE NOTES.
2. EXISTING GROUND SHOWN ON THIS DRAWING IS TAKEN FROM THE TOPOGRAPHIC BASE MAP SHOWN ON DRAWING 4.
3. THE CONSOLIDATED LINED FOOTPRINT LIMITS SHOWN ON THIS DRAWING ARE TAKEN FROM DRAWING 17.
4. EXCAVATION SURFACE ELEVATION REPRESENTS A MINIMUM EXCAVATION DEPTH, IS APPROXIMATE, AND IS TAKEN FROM DRAWING 8.
5. APPROXIMATE BOTTOM OF CCR SHOWN ON THIS DRAWING IS TAKEN FROM DRAWING 6.
6. PREDICTED POST-CLOSURE SEASONAL HIGH GROUNDWATER POTENTIOMETRIC SURFACE SHOWN ON THIS DRAWING OBTAINED FROM GROUNDWATER FLOW MODELING RESULTS AS DOCUMENTED IN THE "HYDROGEOLOGIC ASSESSMENT REPORT (REVISION 3)" INCLUDED WITH THIS PERMIT APPLICATION AND SHOWN ON DRAWINGS 11 THROUGH 13.
7. TOP OF BEDROCK SURFACE IS APPROXIMATE AND WAS DEVELOPED BY GEOSYNTEC CONSULTANTS USING AVAILABLE SUBSURFACE INFORMATION FROM PREVIOUS SITE INVESTIGATIONS.
8. APPROXIMATE GROUNDWATER POTENTIOMETRIC SURFACE IS FROM WATER LEVEL MEASUREMENTS DATED 22 MARCH 2021 IN WELLS/PIEZOMETERS SCREENED IN BEDROCK AS PRESENTED IN THE "HYDROGEOLOGIC ASSESSMENT REPORT (REVISION 3)" INCLUDED WITH THIS PERMIT APPLICATION. THE MARCH 2021 POTENTIOMETRIC SURFACE IS HIGHER THAN THAT ASSOCIATED WITH THE DEWATERED AND CLOSED CONDITION WITHIN AP-1, AS REFLECTED IN NOTE 6.





0	AUG. 2021	SUBMITTAL TO GA EPD	JJ/VKH	RB
REV	DATE	DESCRIPTION	DRN	APP
SITE CROSS SECTIONS III				
PLANT BOWEN ASH POND 1 (AP-1) CLOSURE DRAWINGS BARTOW COUNTY, GEORGIA				
<b>Geosyntec</b> consultants				
1255 ROBERTS BOULEVARD, NW, SUITE 200 KENNESAW, GEORGIA 30144 USA PHONE: 678.202.9600 WWW.GEOSYNTEC.COM				
PROJ. NO.	GR6601	DWG.	GR6601-025	EDIT
SCALE	AS SHOWN	DRAWING 26 OF 50		
DATE	AUGUST 2021			





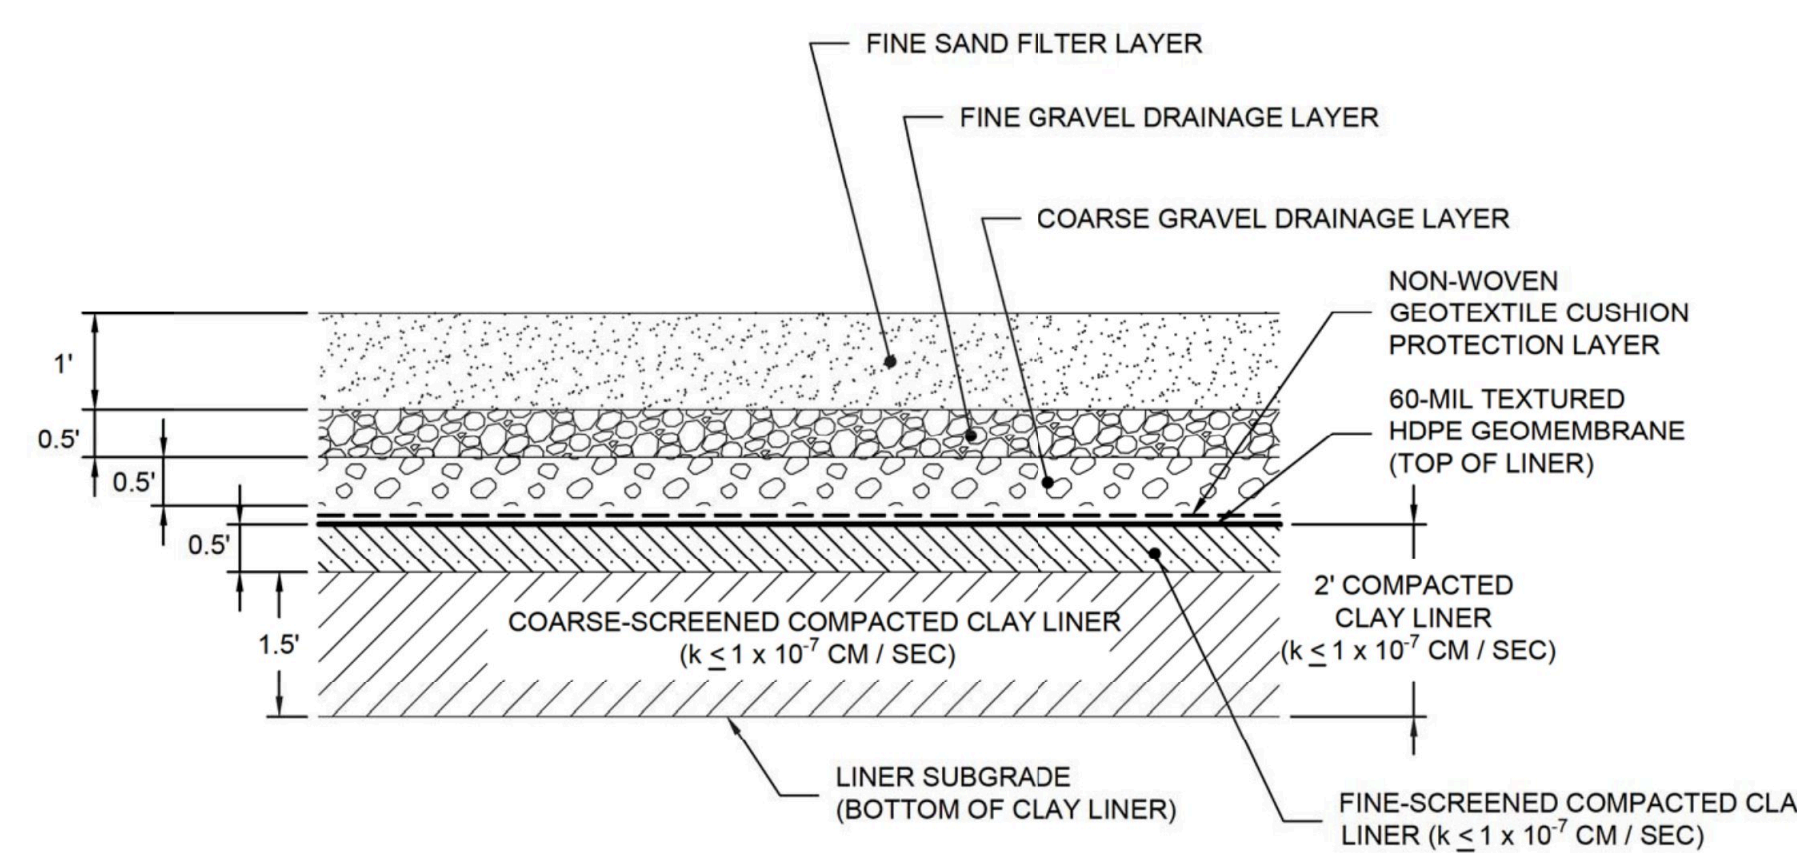



**1**  
24  
**DETAIL**  
**LINER SYSTEM OPTION L1 D1**

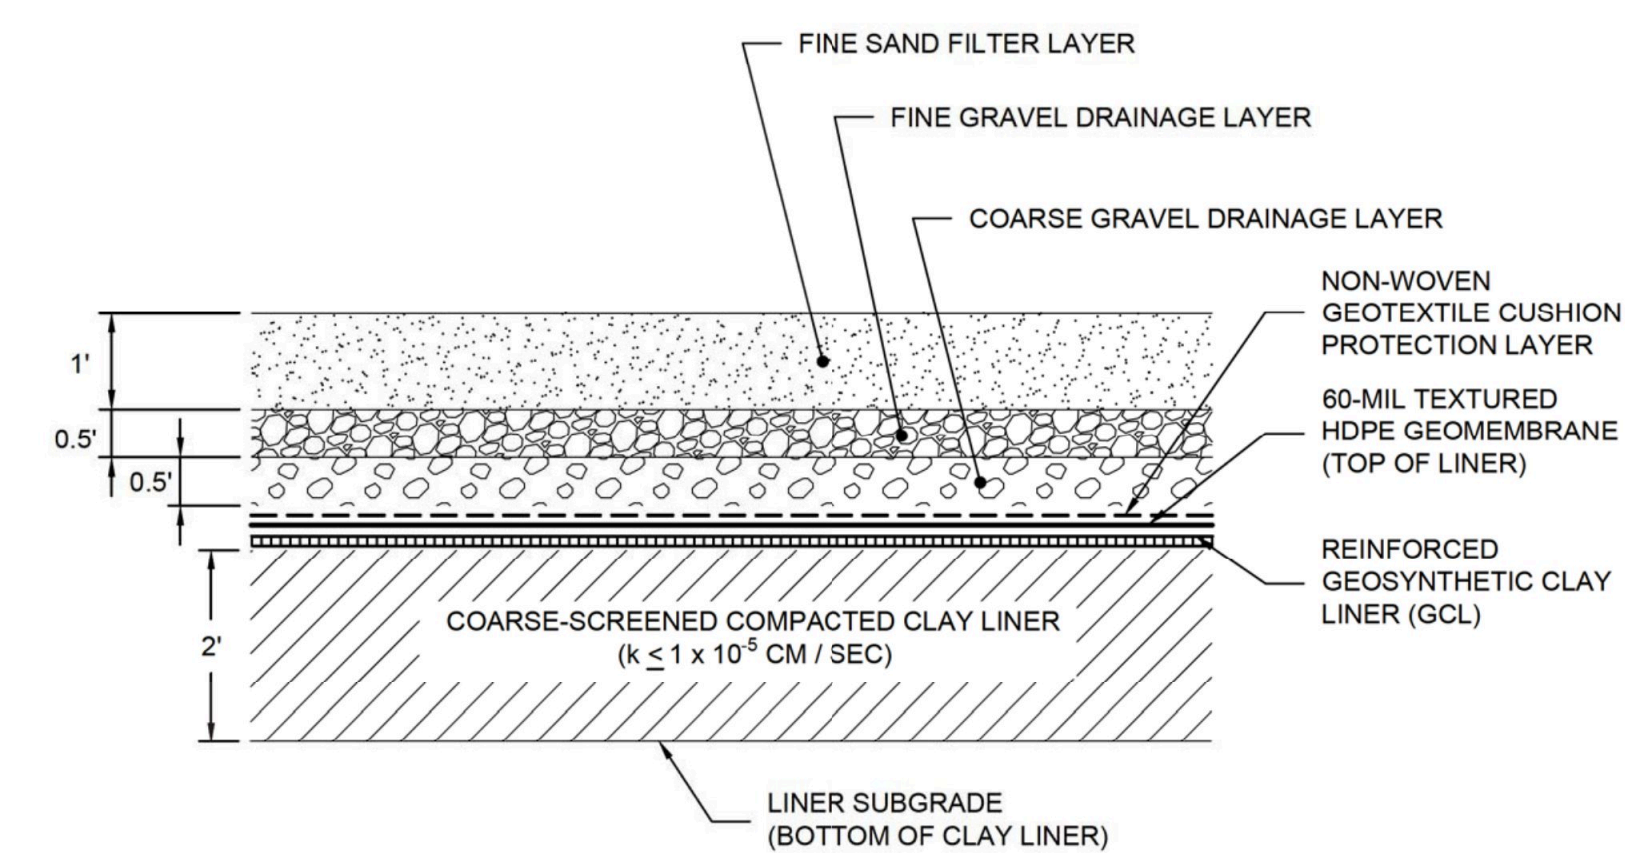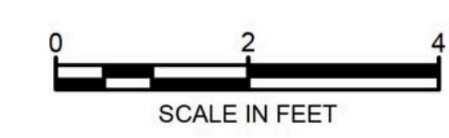



**2**  
24  
**DETAIL**  
**LINER SYSTEM OPTION L2**

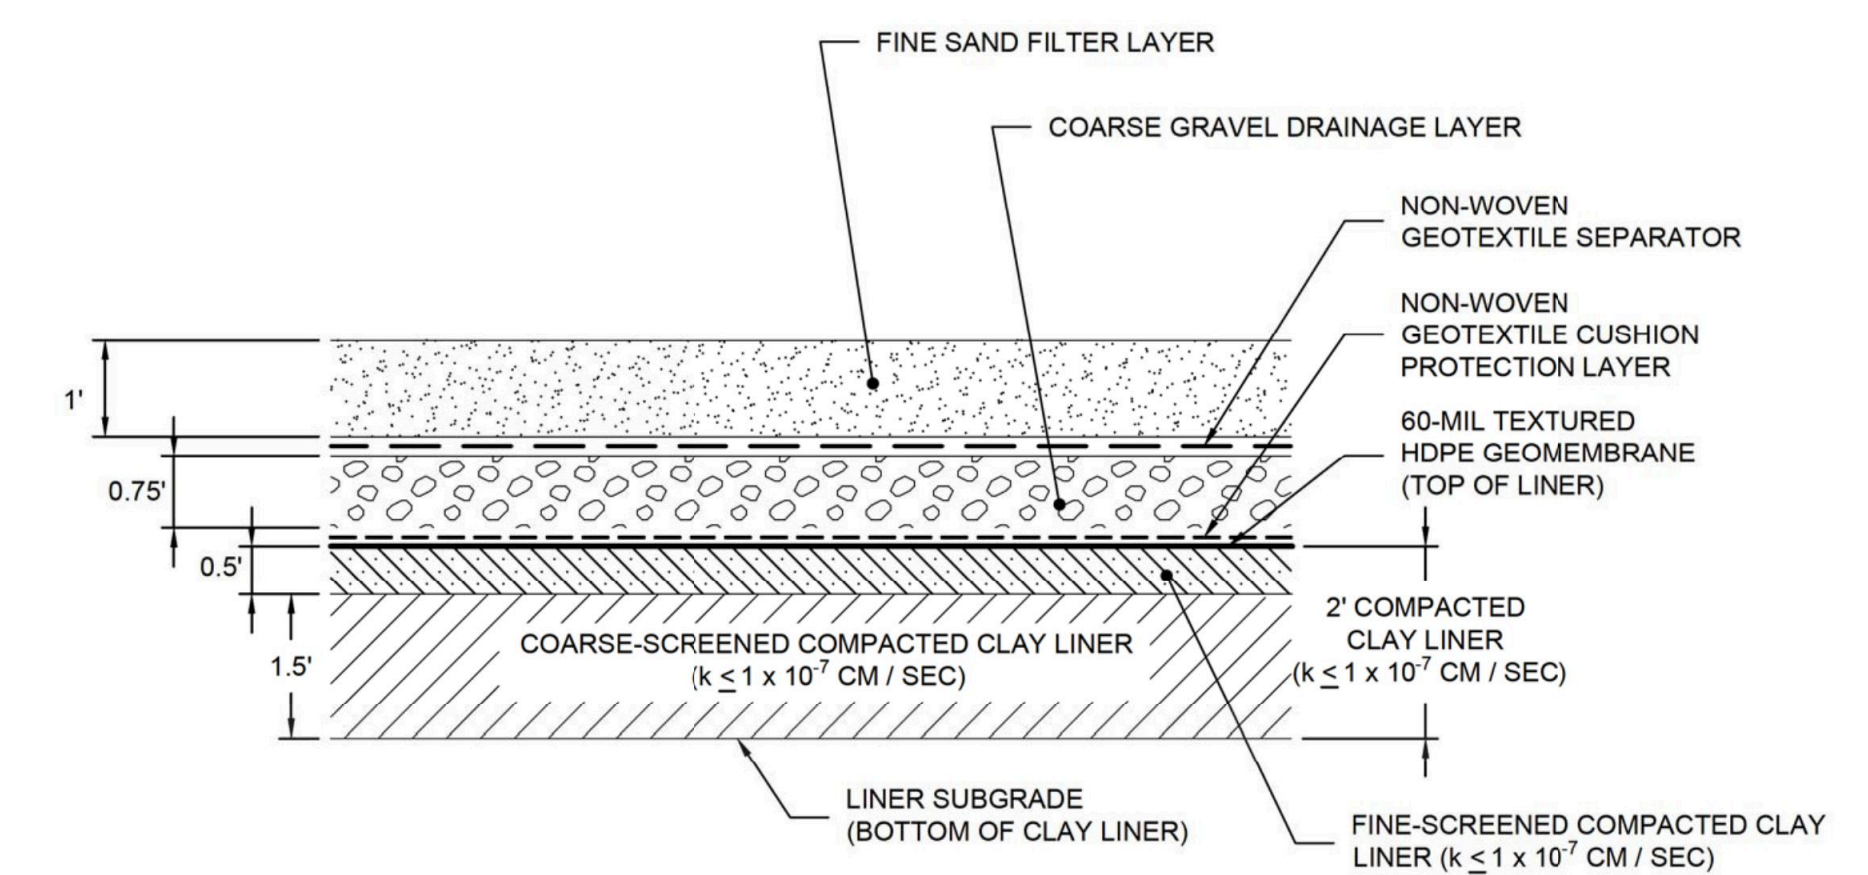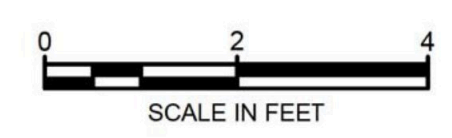



**3**  
24  
**DETAIL**  
**DRAINAGE SYSTEM OPTION D2**

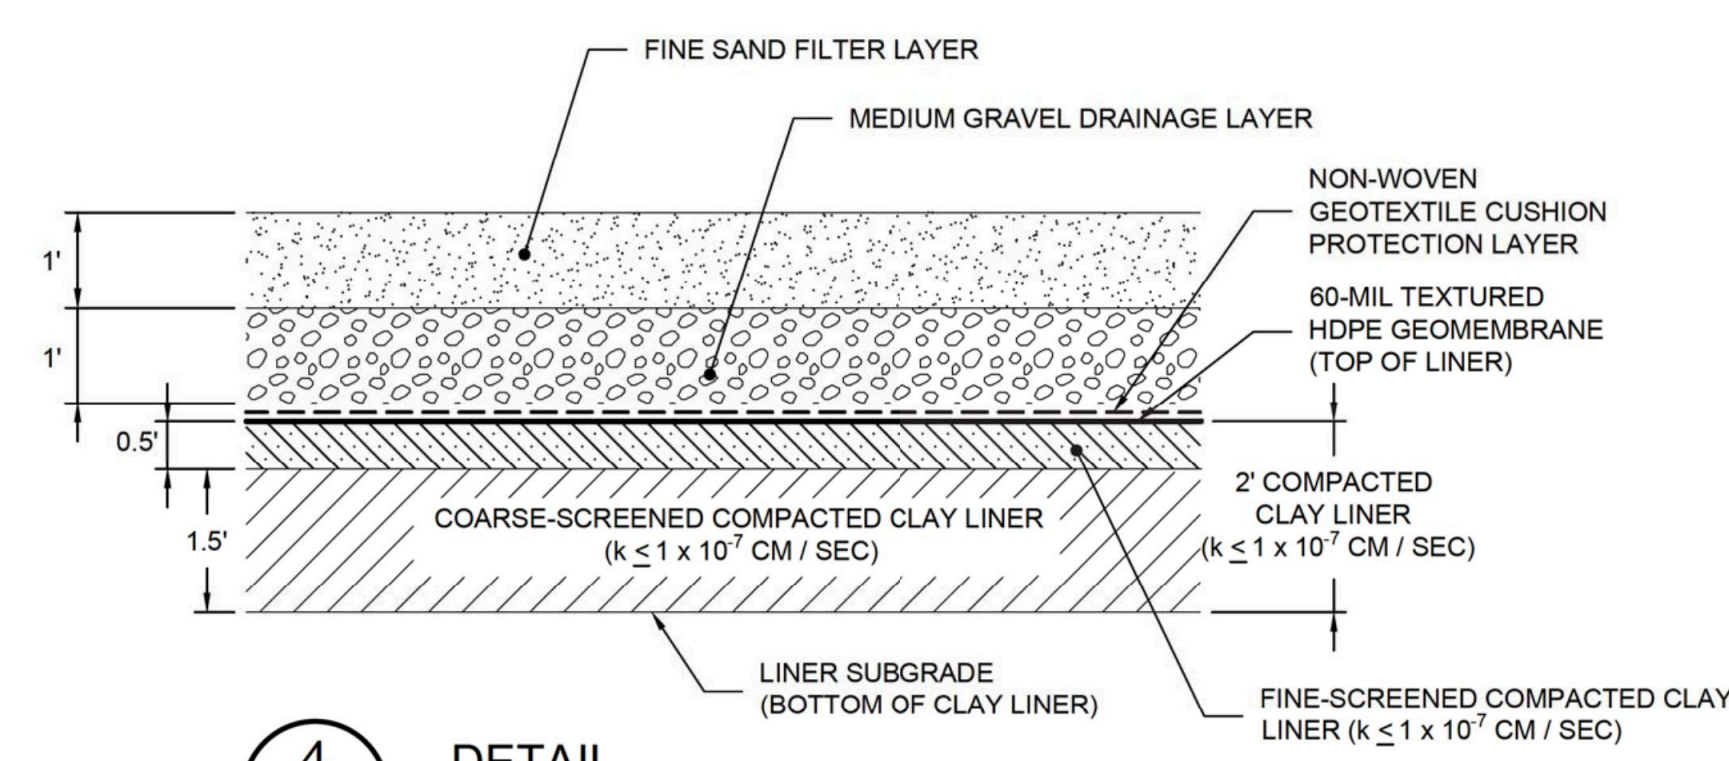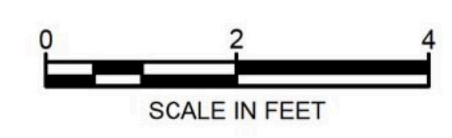



**4**  
27  
**DETAIL**  
**DRAINAGE SYSTEM OPTION D3**

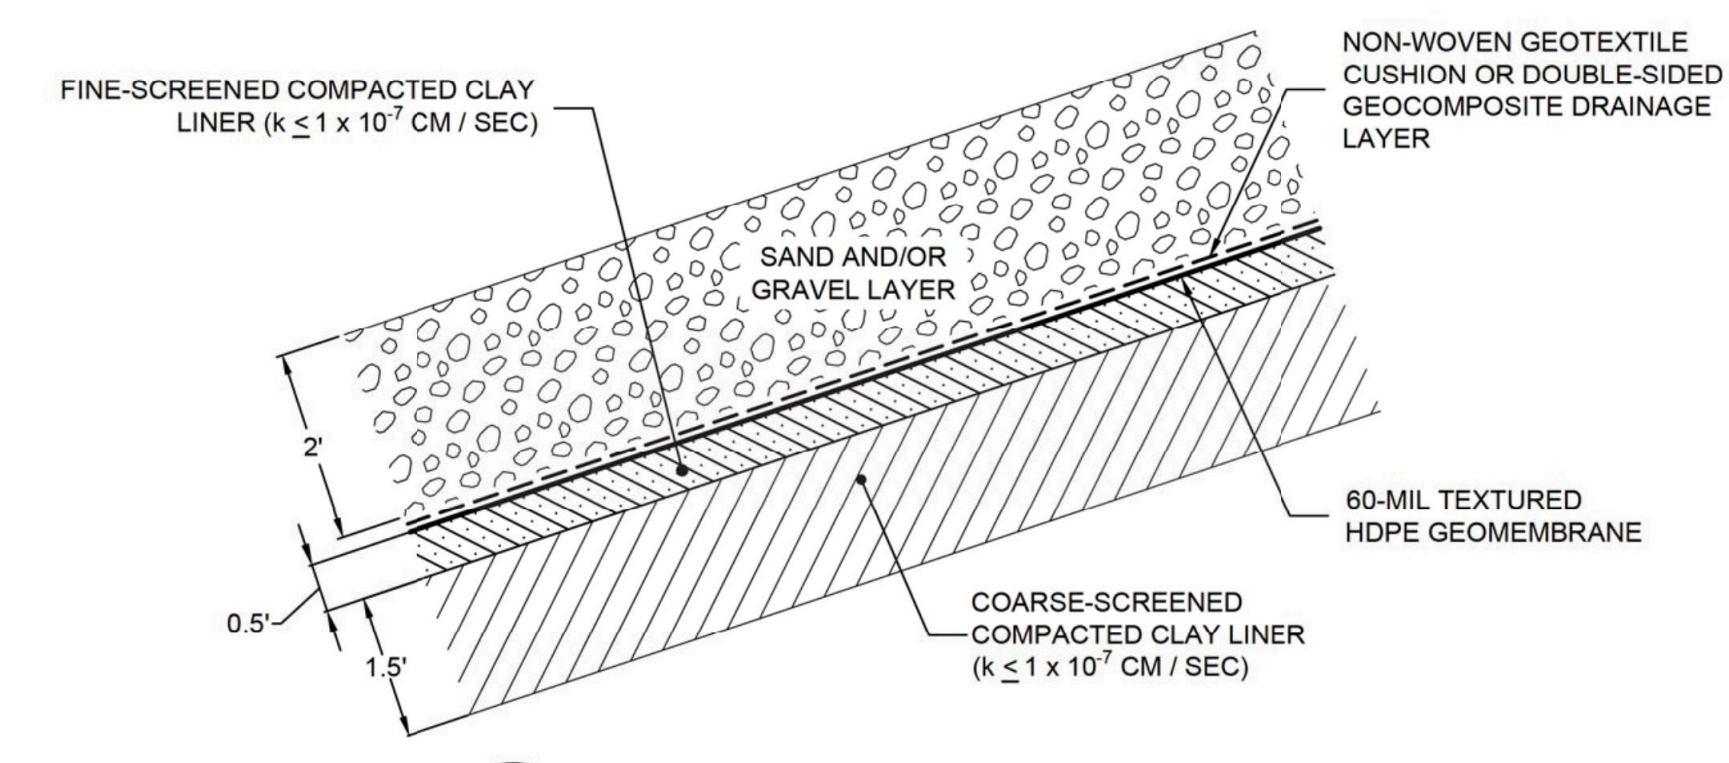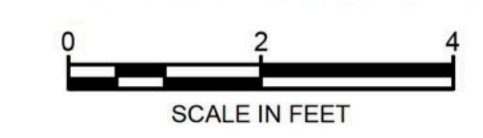


**5**  
24  
**DETAIL**  
**DRAINAGE SYSTEM OPTION D4**  
**3H:1V SIDESLOPES ONLY**

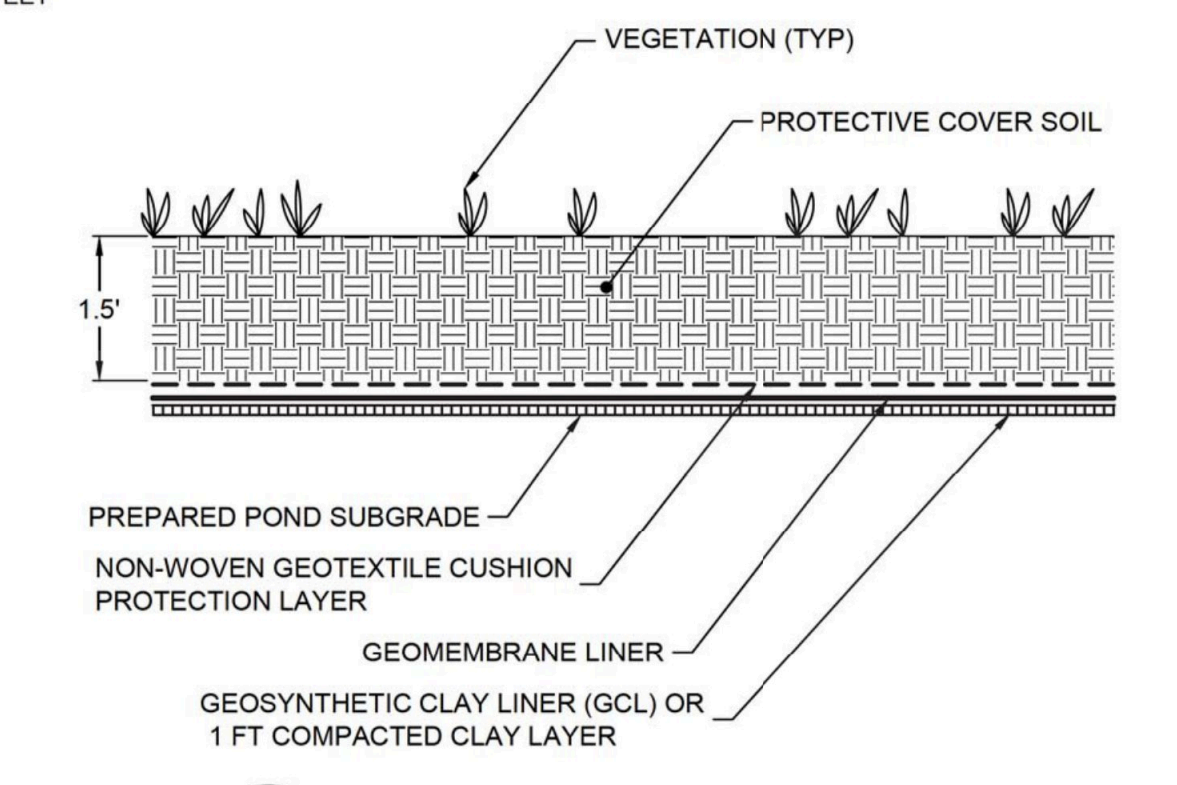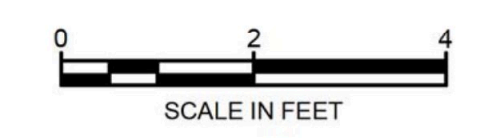

**6**  
24  
**DETAIL**  
**STORMWATER POND LINER SYSTEM**

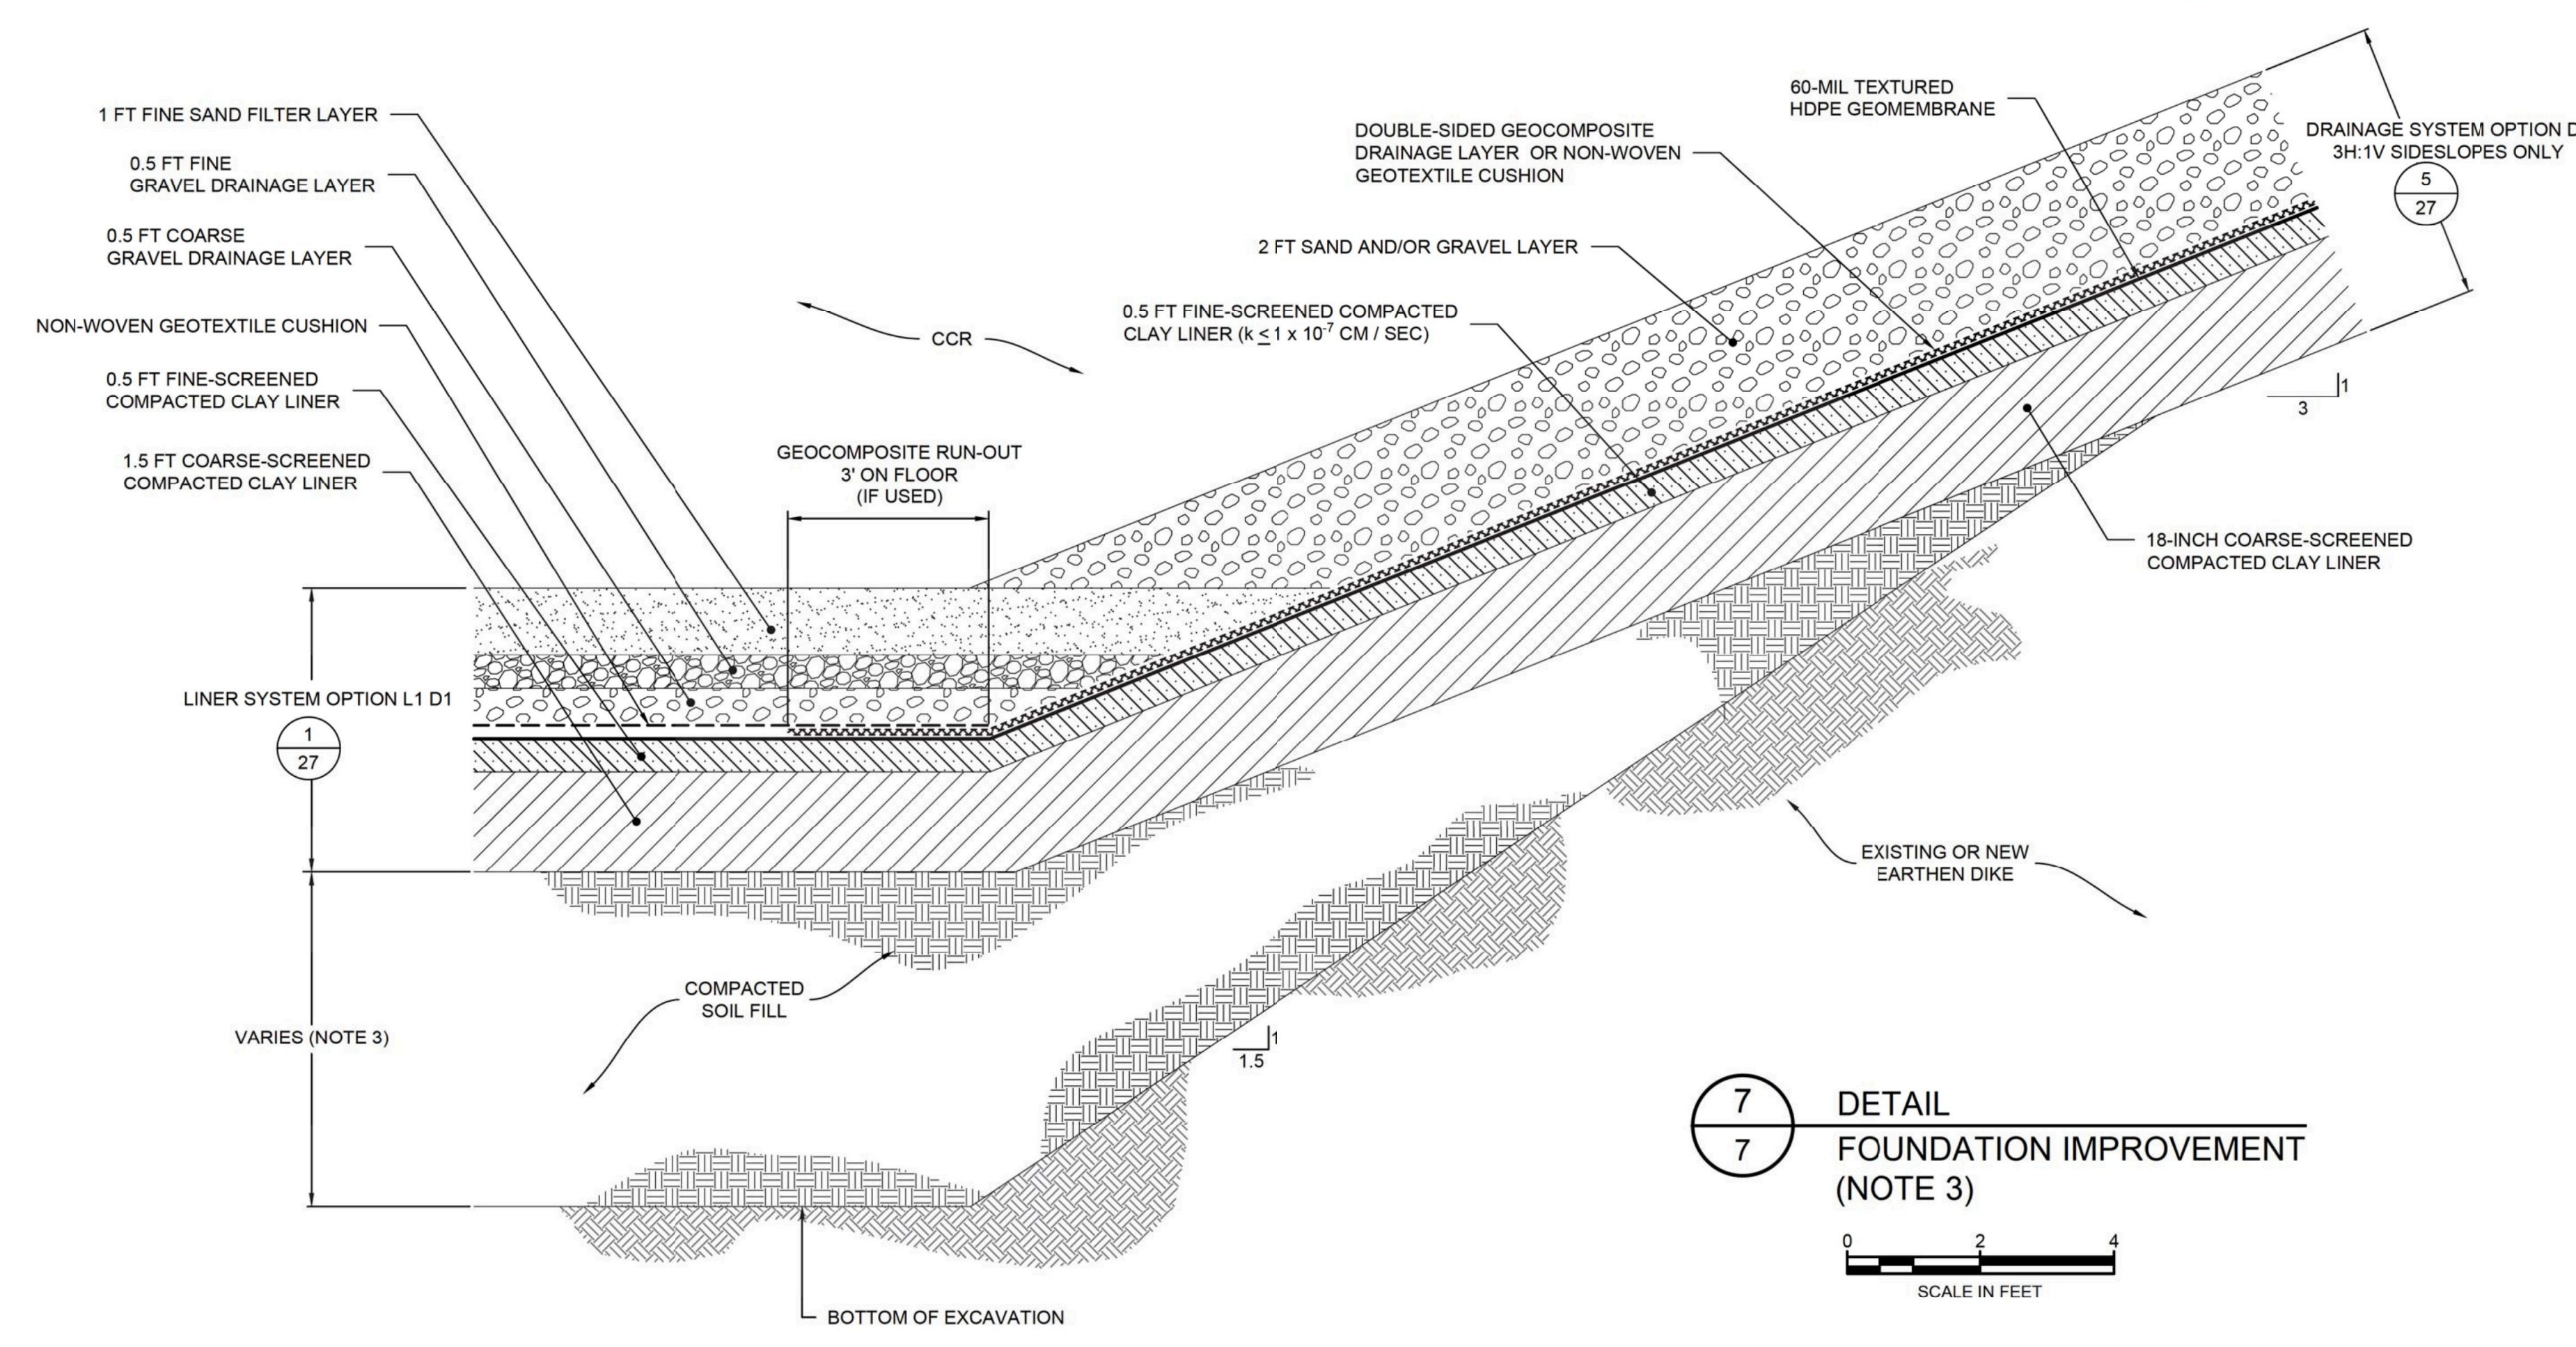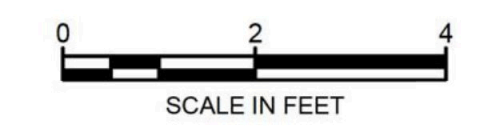

**7**  
7  
**DETAIL**  
**FOUNDATION IMPROVEMENT**  
**(NOTE 3)**

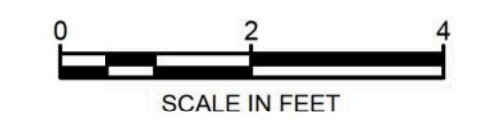

**NOTES:**

- GEOSYNTHETIC LAYER THICKNESSES EXAGGERATED FOR CLARITY.
- ADDITIONAL ACCEPTABLE LINER SYSTEMS WOULD COMBINE THE OPTION L2 (DETAIL 2) COMPOSITE LINER WITH THE OPTION D2 (DETAIL 3) OR D3 (DETAIL 4) LEACHATE COLLECTION SYSTEMS.
- FOUNDATION IMPROVEMENT FOR CONSOLIDATED LINED AREAS WILL BE PERFORMED IN ACCORDANCE WITH THE "FOUNDATION IMPROVEMENT PLAN" INCLUDED WITH THIS PERMIT APPLICATION. THICKNESS OF COMPACTED SOIL FILL ZONE BENEATH FLOOR LINER AREAS IS A MINIMUM OF 8 FT THICK AND VARIES AS NEEDED TO FILL BETWEEN THE BOTTOM EXCAVATION (DRAWING 8) AND THE LINER SUBGRADE.
- GRADATION REQUIREMENTS AND OTHER MATERIAL PROPERTIES FOR SOIL LAYERS WILL BE PROVIDED IN TECHNICAL SPECIFICATIONS DEVELOPED FOR DETAILED DESIGN.
- FOUNDATION IMPROVEMENT DETAIL SHOWN ON THIS DRAWING REFLECTS LINER SYSTEM OPTIONS AS INDICATED. IF OTHER LINER SYSTEM OPTIONS ARE USED, THE DESIGN APPROACH WILL REMAIN CONSISTENT WITH THIS DRAWING.





**PERMIT DRAWING**  
**NOT FOR CONSTRUCTION**




REV	DATE	DESCRIPTION	DRN	APP
0	AUG. 2021	SUBMITTAL TO GA EPD	JV/KH	RB
<b>LINER SYSTEM DETAILS I</b>				
<b>PLANT BOWEN ASH POND 1 (AP-1)</b> <b>CLOSURE DRAWINGS</b> <b>BARTOW COUNTY, GEORGIA</b>				
<b>Geosyntec</b> consultants <small>1255 ROBERTS BOULEVARD, NW, SUITE 200 KENNESAW, GEORGIA 30144 USA PHONE: 678.202.9600 WWW.GEOSYNTEC.COM</small>				
PROJ. NO.	GR6601	DWG.	GR6601-028	EDIT 08.16.21
SCALE	AS SHOWN	<b>DRAWING 27 OF 50</b>		
DATE	AUGUST 2021			

P:\CADD\PROJECTS\GEORGIA POWER\BOWEN POWER PLANT\TIE\ASH POND CLOSURE (GR6601) DRAWINGS\GR6601-028



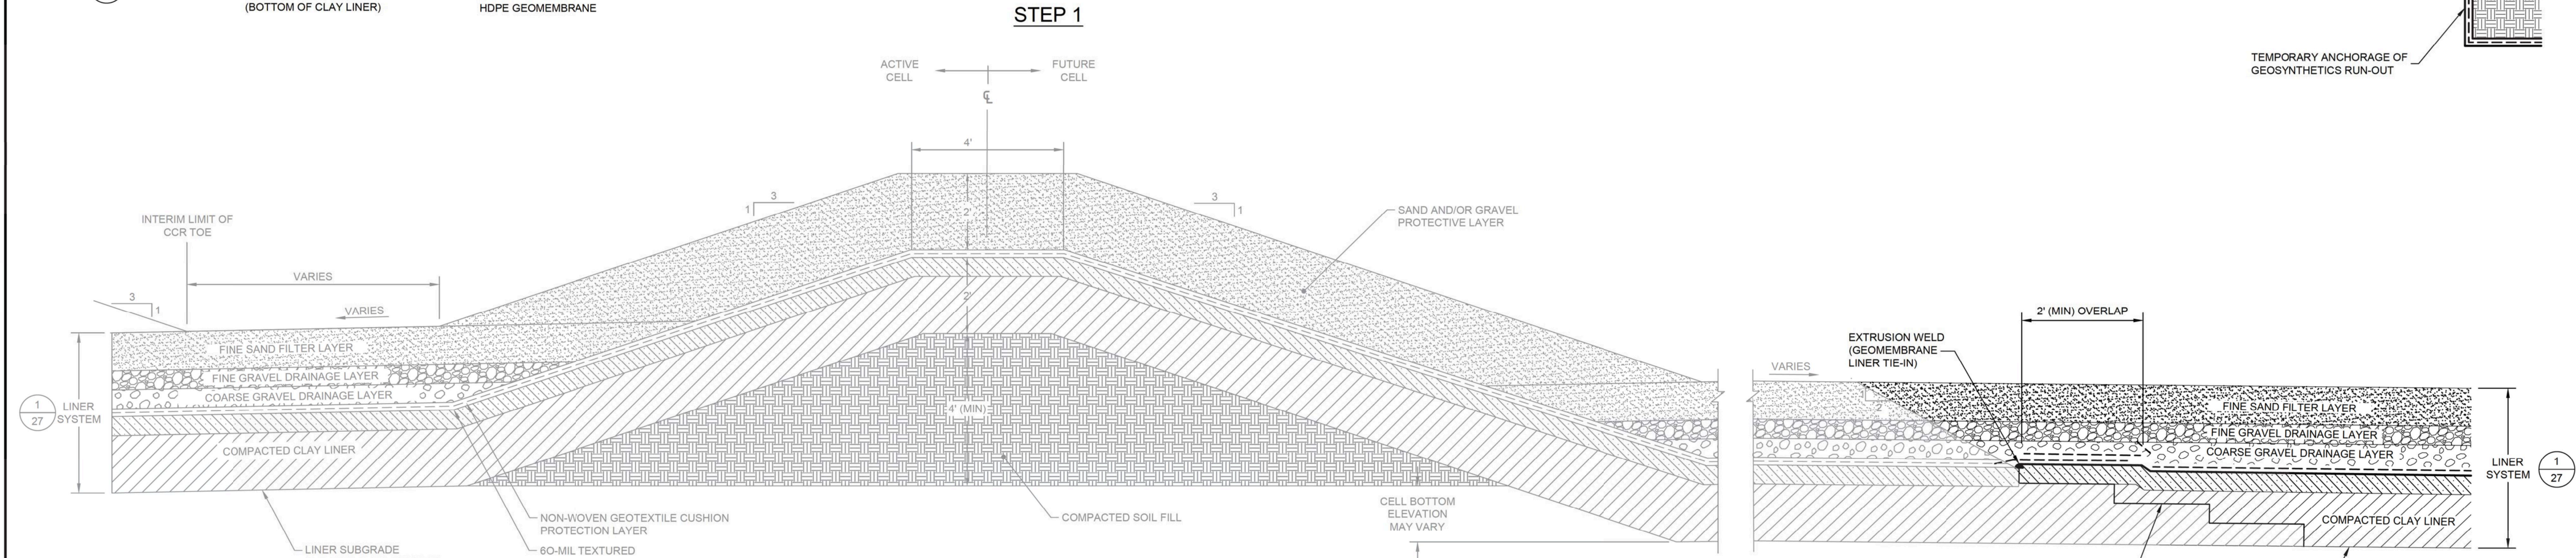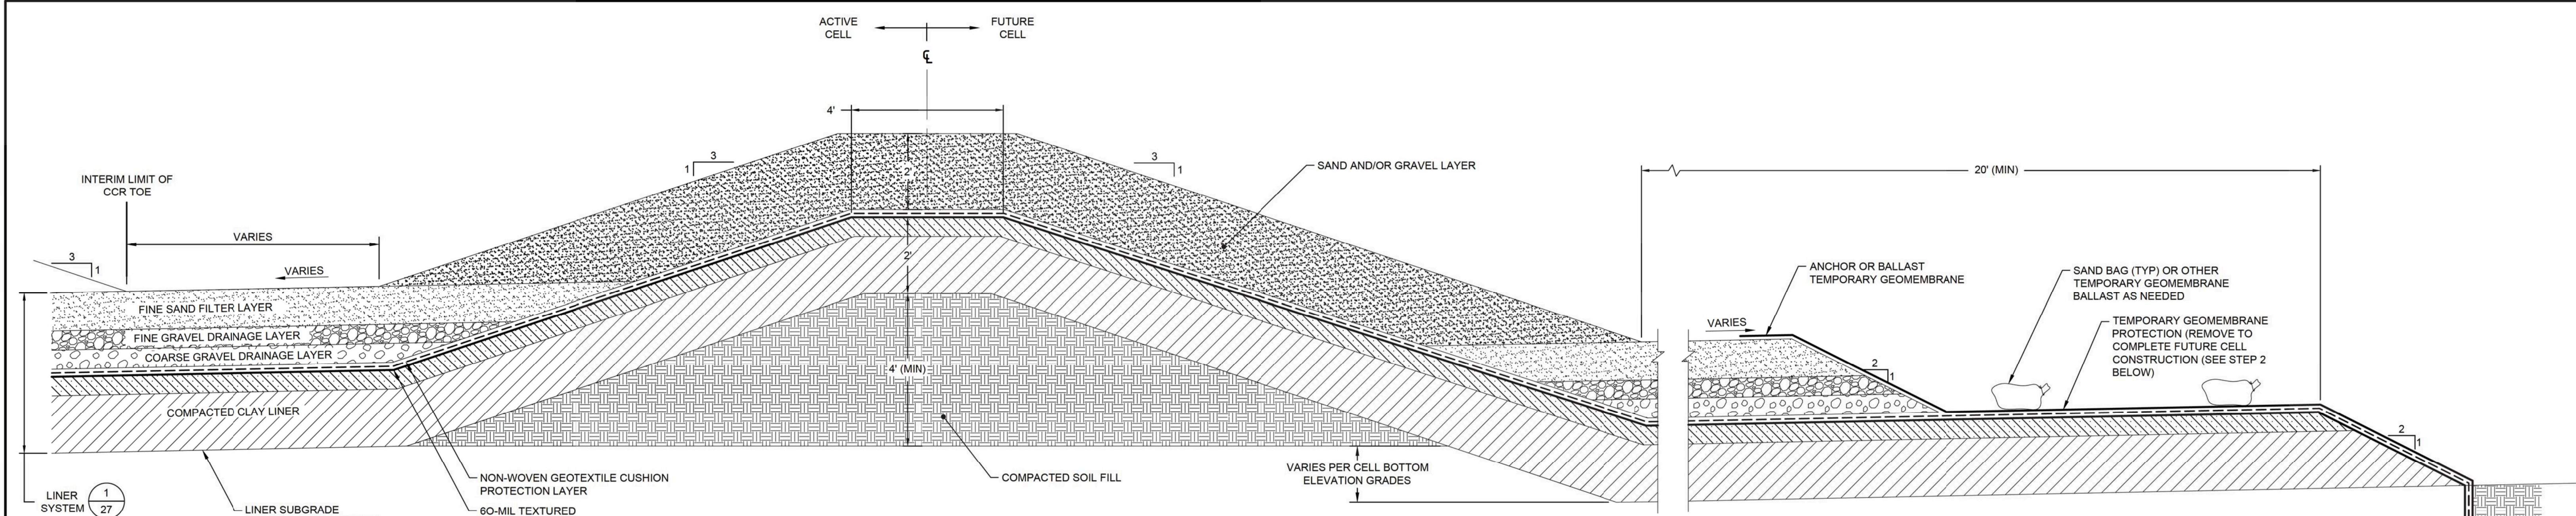

STEP 2

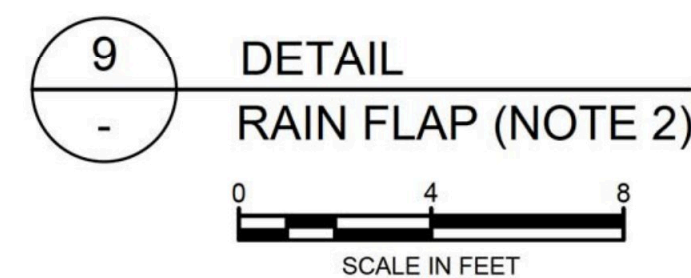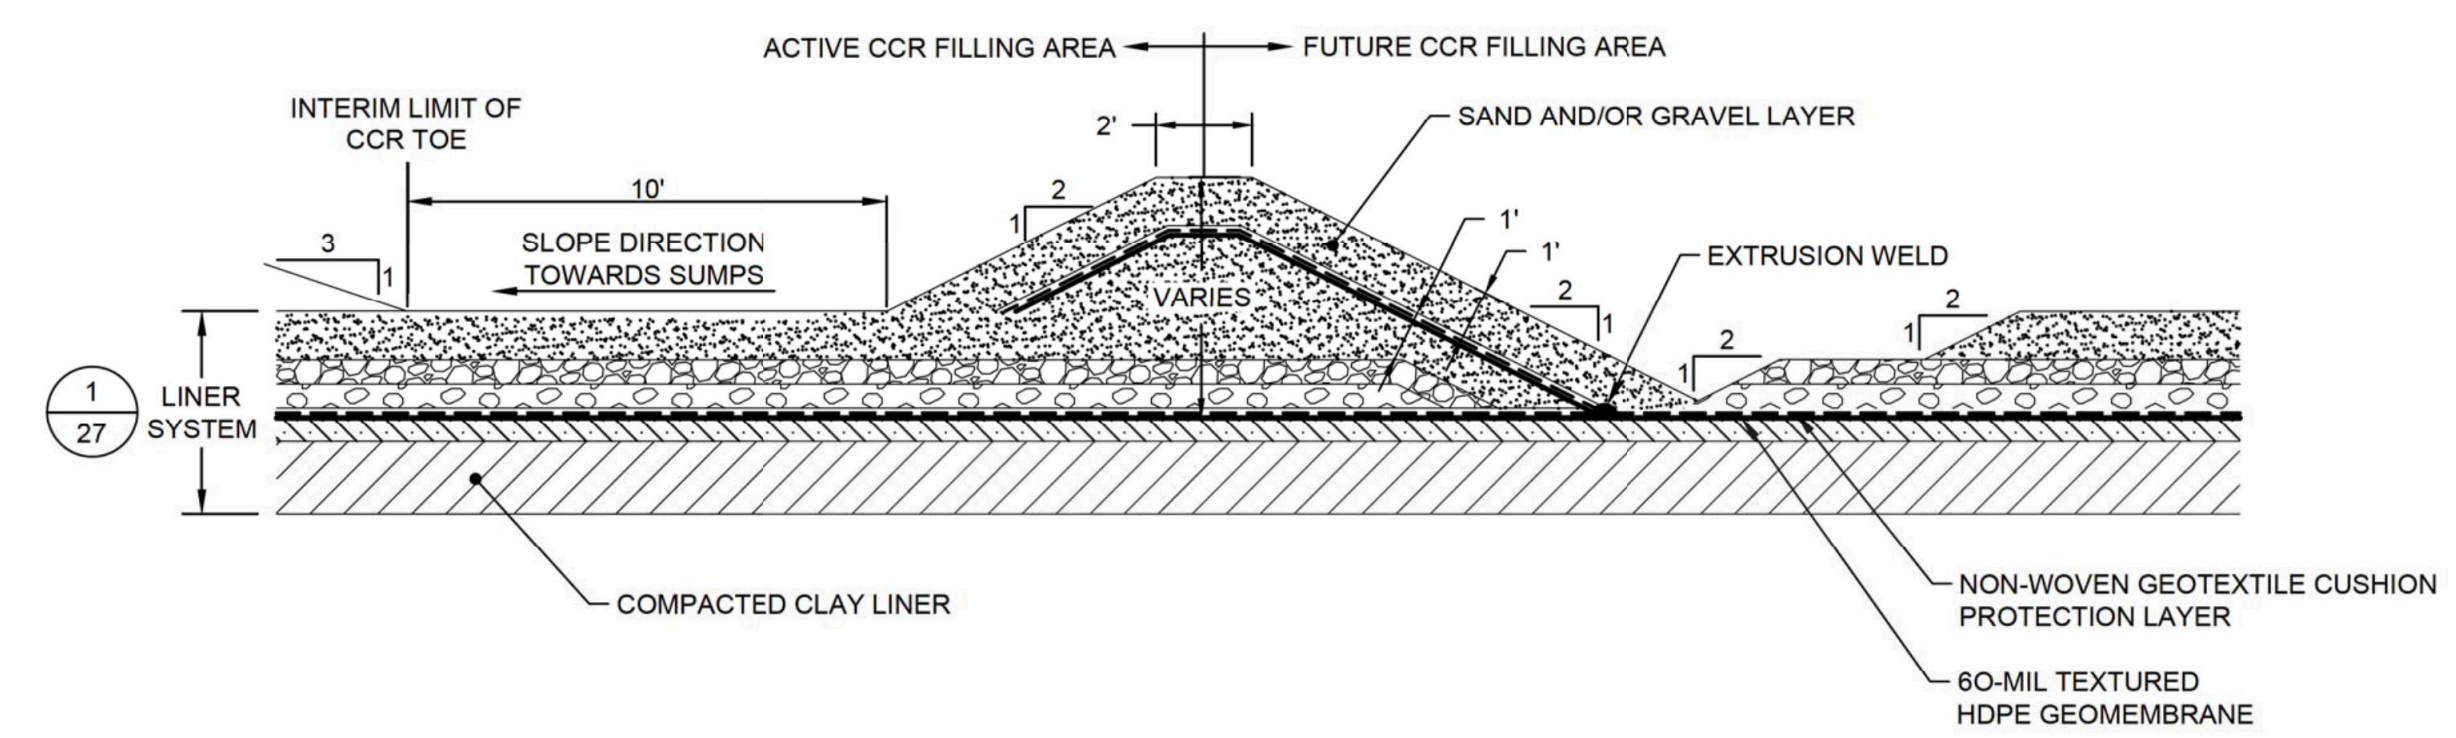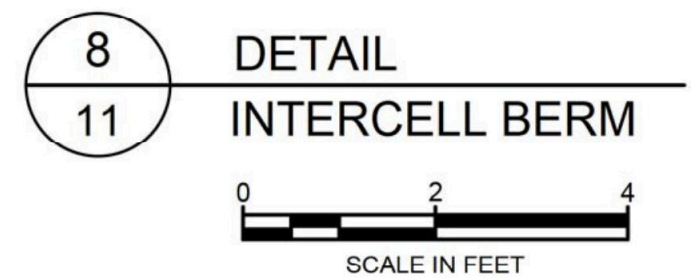


PERMIT DRAWING  
NOT FOR CONSTRUCTION

- NOTES:
- GEOSYNTHETIC LAYER THICKNESSES EXAGGERATED FOR CLARITY.
  - RAIN FLAP BERMS CAN BE USED TO LIMIT THE SIZE OF THE ACTIVE AREA DURING INITIAL STAGE OF FILLING. RAIN FLAP BERM LOCATIONS WILL BE SELECTED BASED ON ACTUAL CONDITIONS.
  - DETAILS ON THIS DRAWING ARE SHOWN BASED ON LINER SYSTEM OPTION L1D1 (DETAIL 1 ON DRAWING 27). IF OTHER LINER SYSTEMS ARE USED, THE DESIGN APPROACH WILL REMAIN CONSISTENT WITH THE INFORMATION PRESENTED ON THIS DRAWING.
  - GRADATION REQUIREMENTS AND OTHER MATERIAL PROPERTIES FOR SOIL LAYERS WILL BE PROVIDED IN TECHNICAL SPECIFICATIONS DEVELOPED FOR DETAILED DESIGN.




REV	DATE	DESCRIPTION	DRN	APP
0	AUG. 2021	SUBMITTAL TO GA EPD	JV/KH	RB
LINER SYSTEM DETAILS II				
PLANT BOWEN ASH POND 1 (AP-1) CLOSURE DRAWINGS BARTOW COUNTY, GEORGIA				
Geosyntec consultants				
1255 ROBERTS BOULEVARD, NW, SUITE 200 KENNESAW, GEORGIA 30144 USA PHONE: 678.202.9600 WWW.GEOSYNTEC.COM				
PROJ. NO.	GR6601	DWG.	GR6601-031	EDIT 08.16.21
SCALE	AS SHOWN	DRAWING 28 OF 50		
DATE	AUGUST 2021			

P:\CADD\PROJECTS\GEORGIA POWER\BOWEN POWER PLANT\BOWEN POND CLOSURE - GR6601\DRAWINGS\GR6601-031




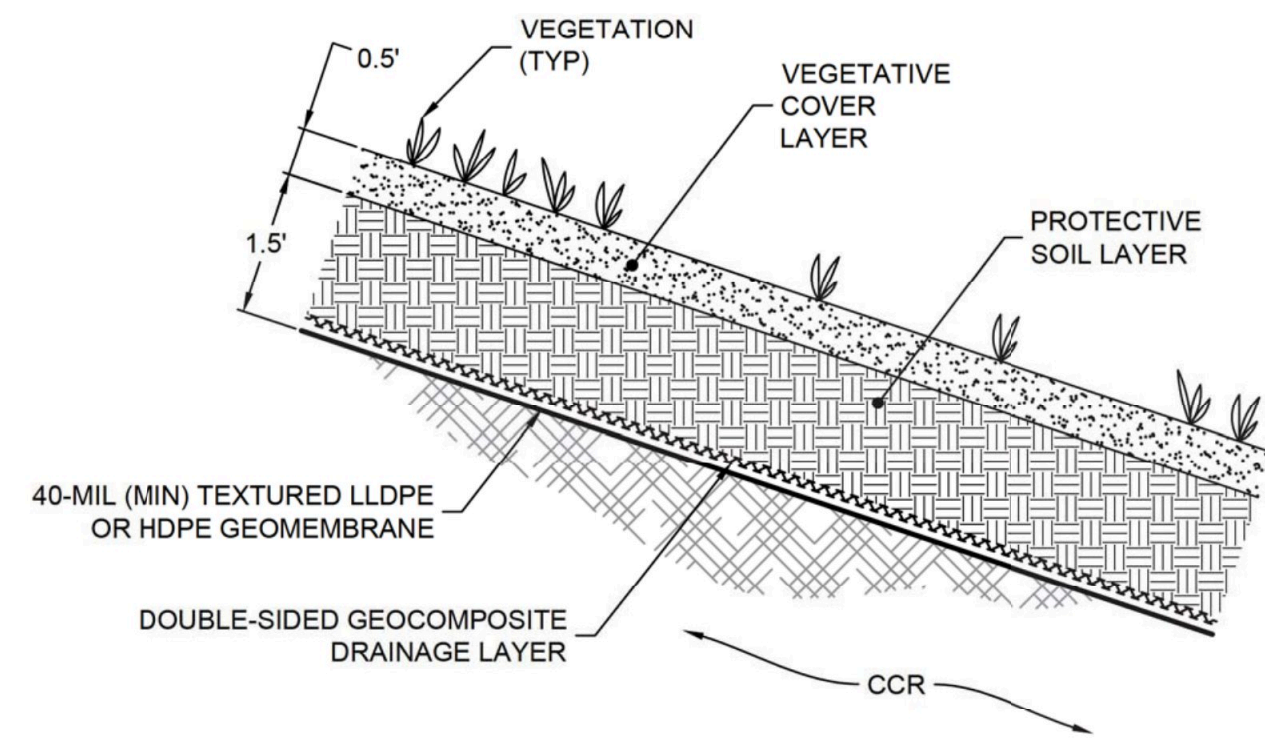


10  
24  
DETAIL  
FINAL COVER SYSTEM (SOIL-GEOSYNTHETIC COMPOSITE COVER OPTION)

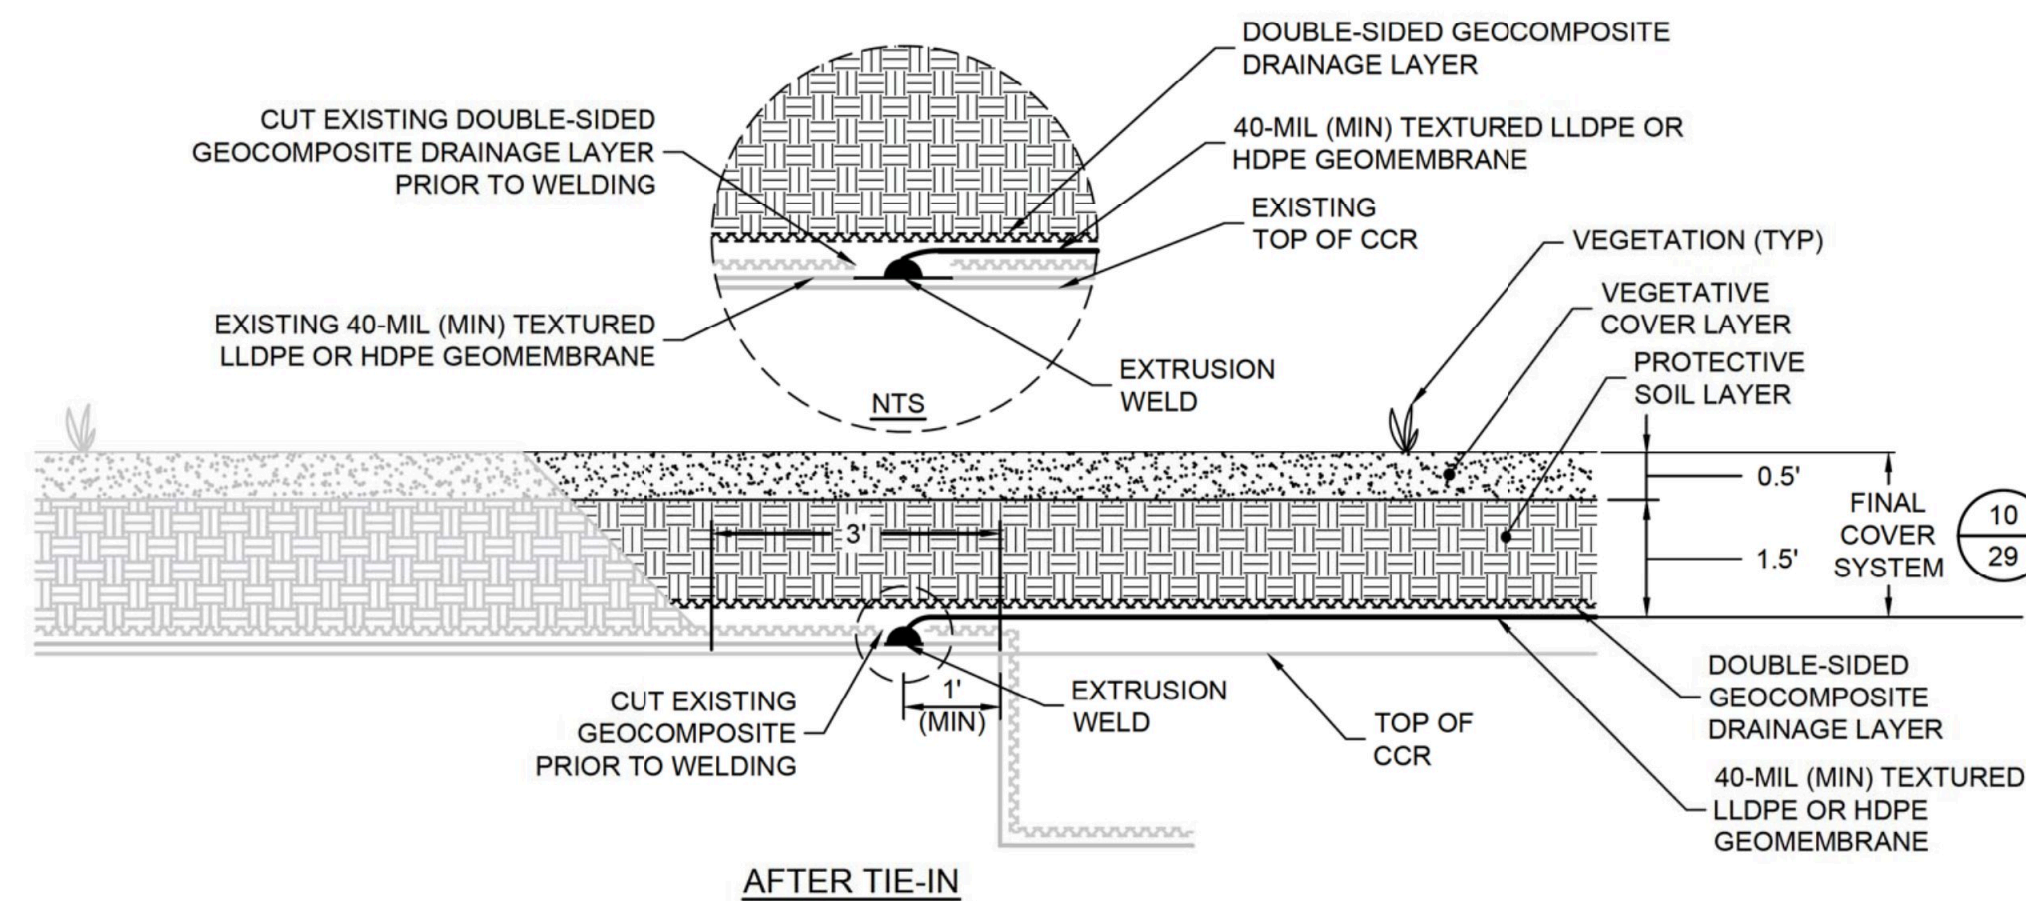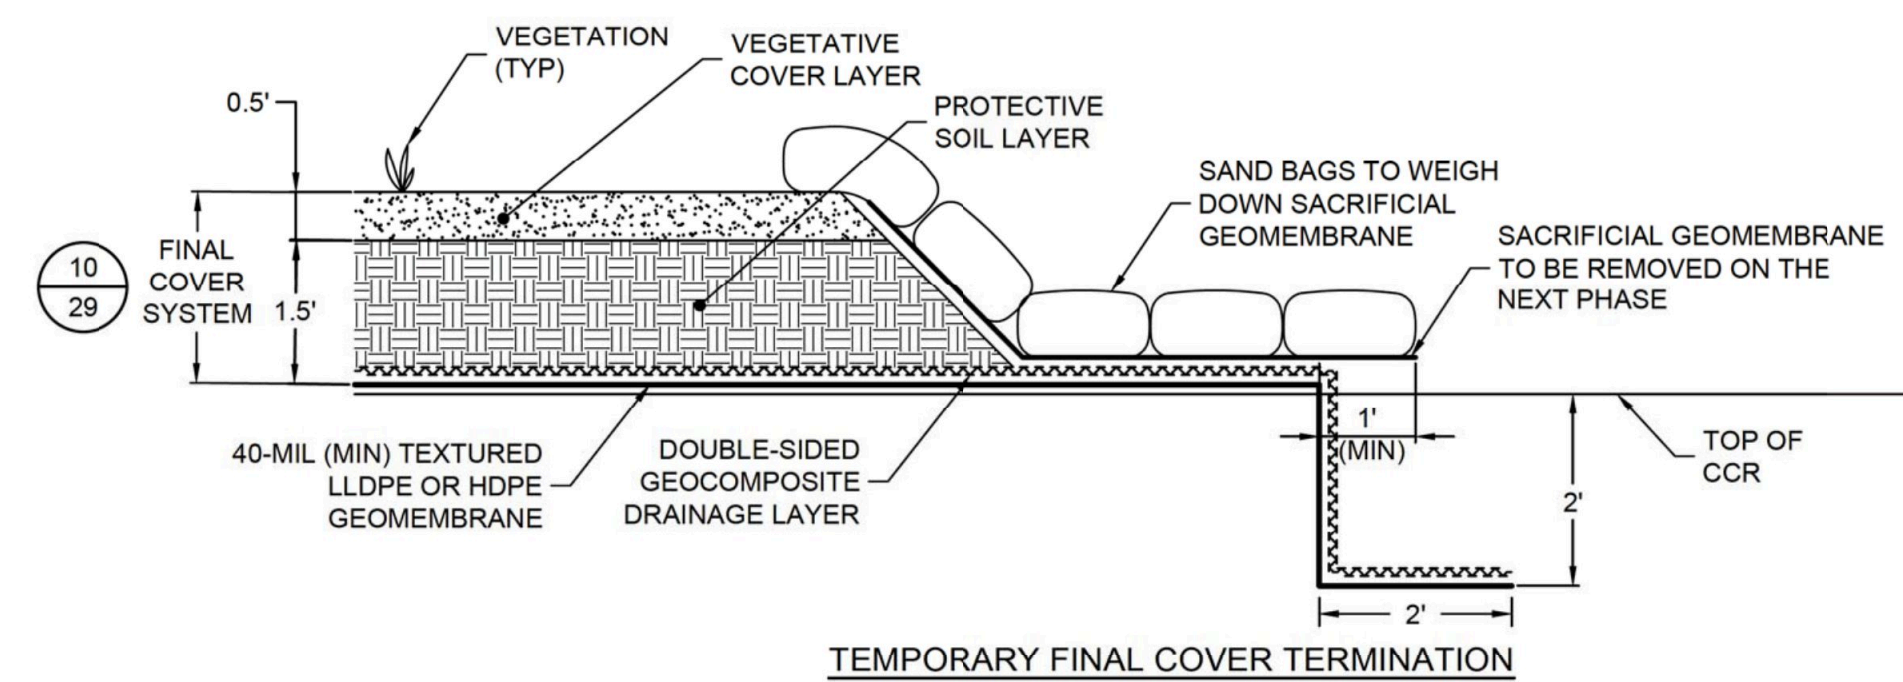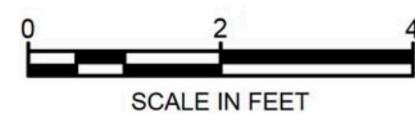


12  
-  
DETAIL  
FINAL COVER TIE-IN AT PHASE BOUNDARY

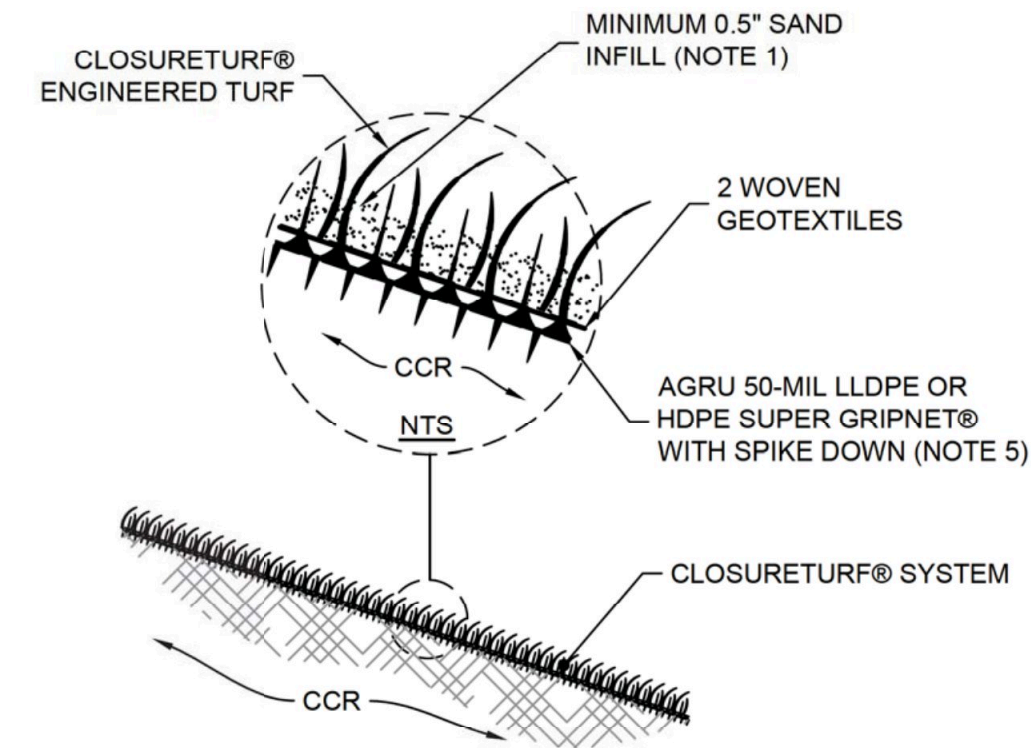

11  
24  
DETAIL  
FINAL COVER SYSTEM (CLOSURETURF® COVER OPTION)  
SCALE: NOT TO SCALE

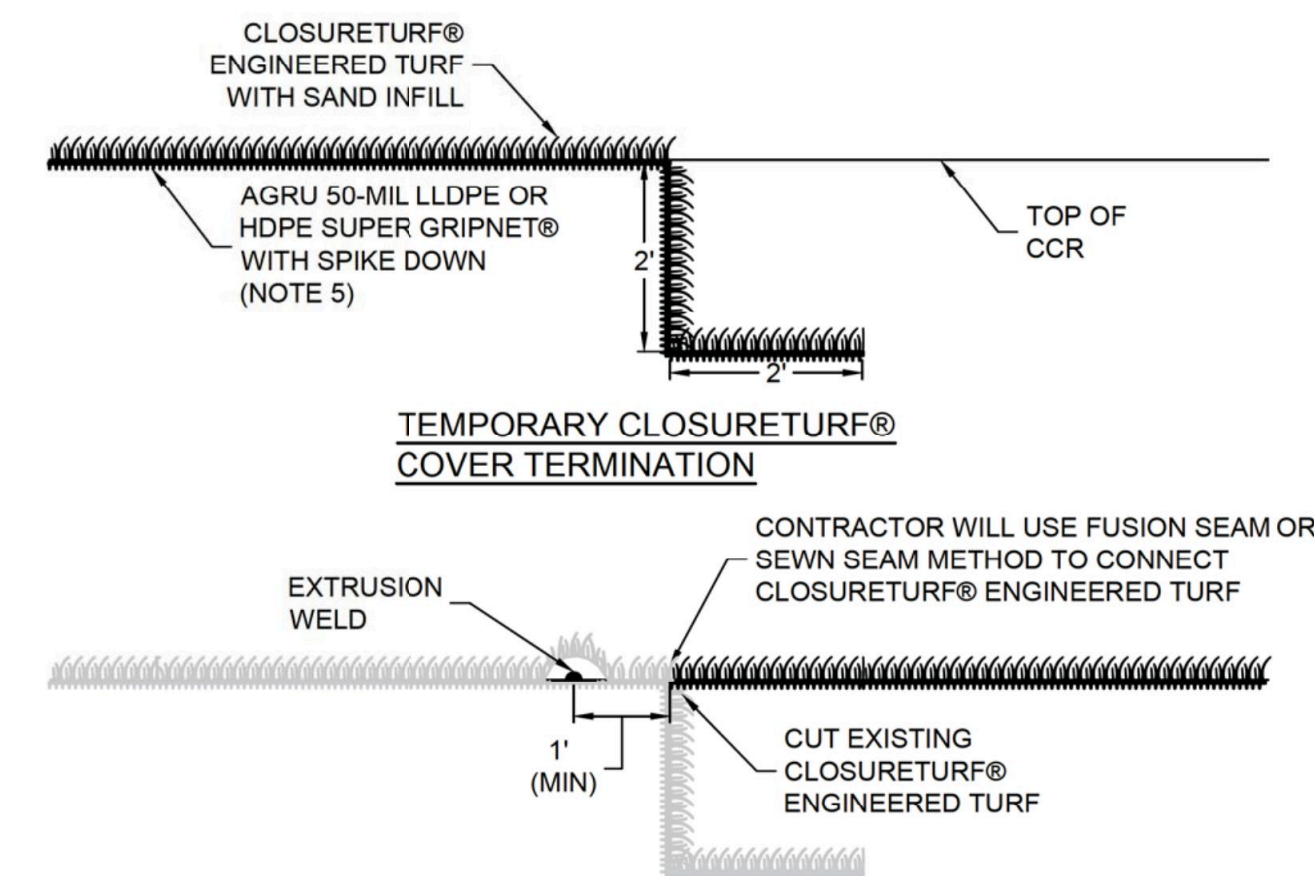

13  
-  
DETAIL  
ALTERNATIVE COVER TIE-IN AT PHASE BOUNDARY

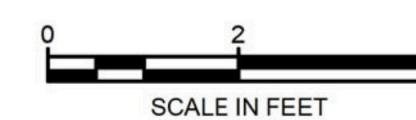


- NOTES:
- SAND INFILL IS TO BE USED WITH CLOSURETURF® ENGINEERED TURF IN ALL LOCATIONS EXCEPT WITHIN DRAINAGE FEATURES, WHICH WILL USE HYDROBINDER AND/OR RIPRAP AS SPECIFIED ON THE STORMWATER MANAGEMENT SYSTEM DETAILS.
  - GEOSYNTHETIC LAYER THICKNESSES EXAGGERATED FOR CLARITY.
  - SUBGRADE PREPARATION IN AREAS WHERE GEOMEMBRANE LINER WILL BE INSTALLED WILL CONSIST OF MOISTURE CONDITIONING, COMPACTION, AND SMOOTH ROLLING AS NEEDED.
  - GRADATION REQUIREMENTS AND OTHER MATERIAL PROPERTIES FOR SOIL LAYERS WILL BE PROVIDED IN TECHNICAL SPECIFICATIONS DEVELOPED FOR DETAILED DESIGN.
  - CLOSURETURF® DETAILS SHOWN WITH SUPER GRIPNET® GEOMEMBRANE OPTION. OTHER CLOSURETURF® GEOMEMBRANE OPTIONS (E.G. MICRODRAIN® OR MICROSPIKE®) MAY BE CONSIDERED AS PART OF THE DETAILED DESIGN.

REV	DATE	DESCRIPTION	DRN	APP
0	AUG. 2021	SUBMITTAL TO GA EPD	JJ/VKH	RB
FINAL COVER SYSTEM DETAILS				
PLANT BOWEN ASH POND 1 (AP-1) CLOSURE DRAWINGS BARTOW COUNTY, GEORGIA				
<b>Geosyntec</b> consultants				
1255 ROBERTS BOULEVARD, NW, SUITE 200 KENNESAW, GEORGIA 30144 USA PHONE: 678.202.9600 WWW.GEOSYNTEC.COM				
PROJ. NO.	GR6601	DWG.	GR6601-029	EDIT 08.16.21
SCALE	AS SHOWN	DRAWING 29 OF 50		
DATE	AUGUST 2021			




PERMIT DRAWING  
NOT FOR CONSTRUCTION



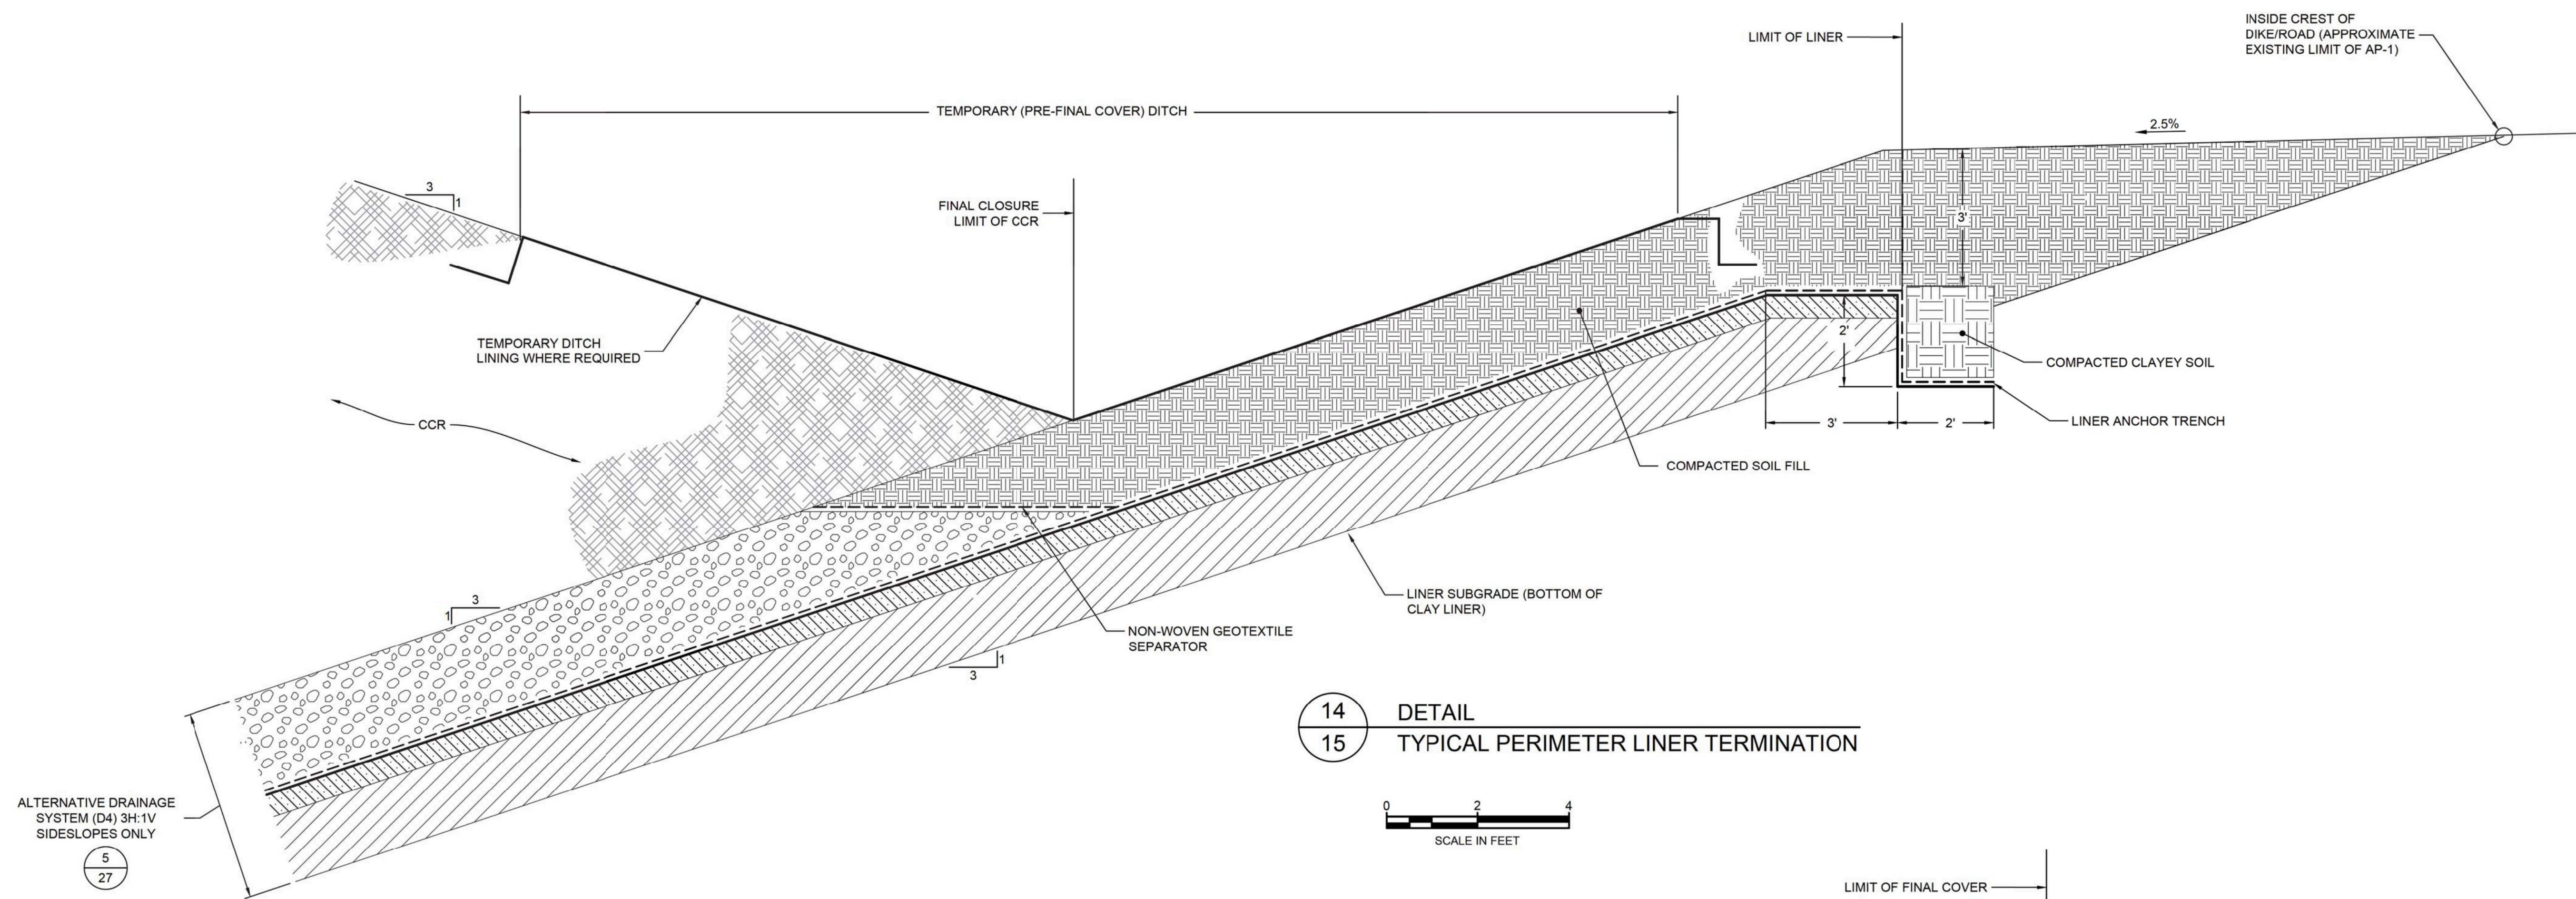


14  
15  
DETAIL  
TYPICAL PERIMETER LINER TERMINATION

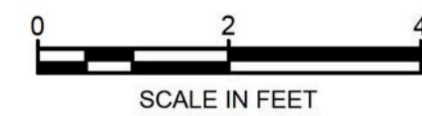


5  
27

ALTERNATIVE DRAINAGE  
SYSTEM (D4) 3H:1V  
SIDESLOPES ONLY

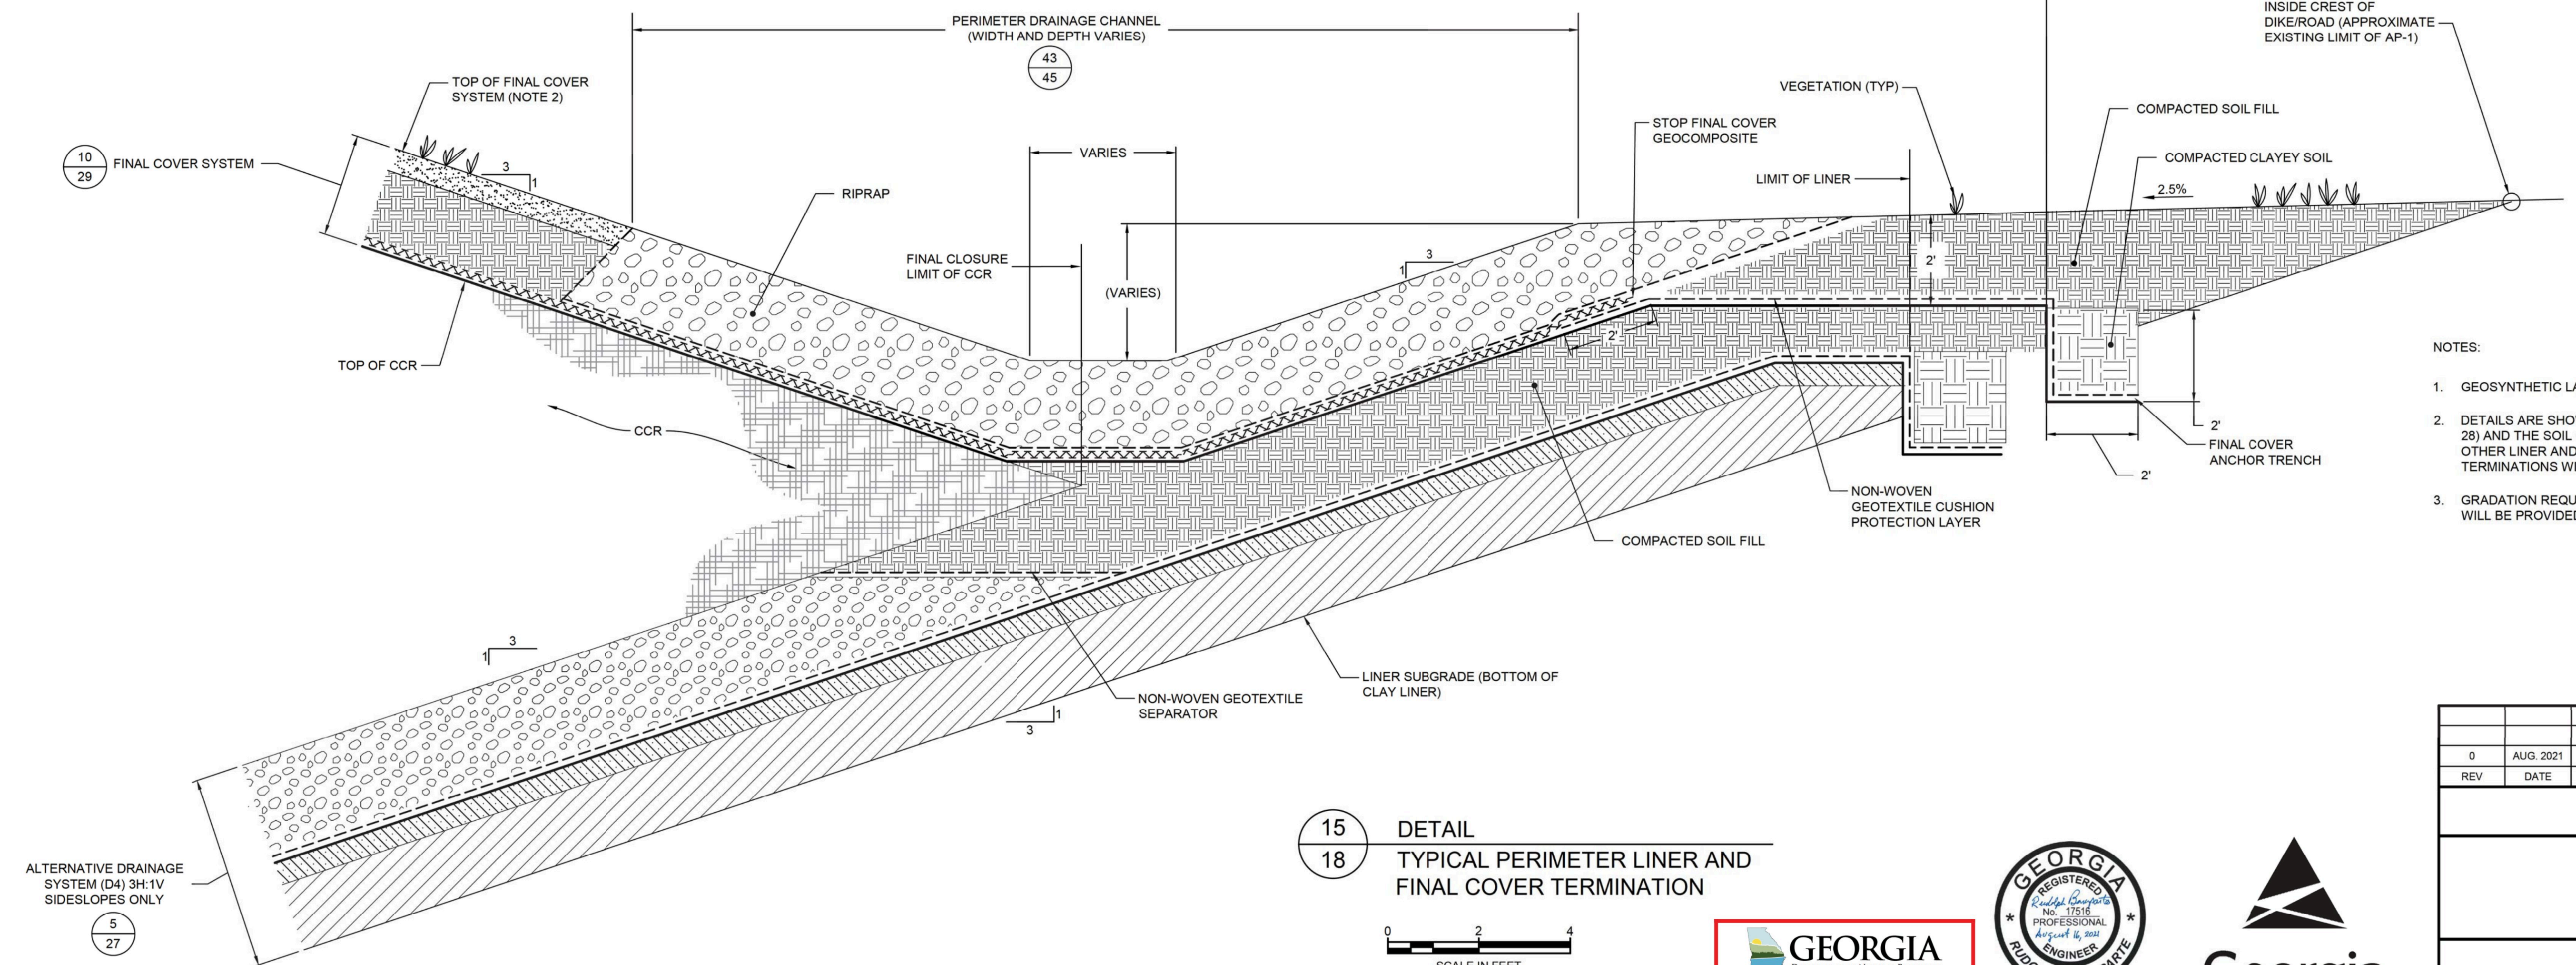

15  
18  
DETAIL  
TYPICAL PERIMETER LINER AND  
FINAL COVER TERMINATION

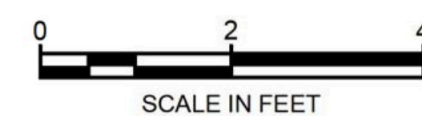


- NOTES:
1. GEOSYNTHETIC LAYER THICKNESSES EXAGGERATED FOR CLARITY.
  2. DETAILS ARE SHOWN FOR LINER SYSTEM COMPONENTS "L1" AND "D4" (SEE DRAWING 28) AND THE SOIL GEOSYNTHETIC FINAL COVER SYSTEM OPTION (SEE DRAWING 30). IF OTHER LINER AND/OR FINAL COVER SYSTEM OPTIONS ARE USED, THEIR TERMINATIONS WILL BE CONSISTENT WITH THESE SHOWN HERE.
  3. GRADATION REQUIREMENTS AND OTHER MATERIAL PROPERTIES FOR SOIL LAYERS WILL BE PROVIDED IN TECHNICAL SPECIFICATIONS DEVELOPED FOR DETAILED DESIGN.

0	AUG. 2021	SUBMITTAL TO GA EPD	JJ/KH	RB
REV	DATE	DESCRIPTION	DRN	APP
PERIMETER DETAILS				
PLANT BOWEN ASH POND 1 (AP-1) CLOSURE DRAWINGS BARTOW COUNTY, GEORGIA				
Geosyntec consultants				
1255 ROBERTS BOULEVARD, NW, SUITE 200 KENNESAW, GEORGIA 30144 USA PHONE: 678.202.9600 WWW.GEOSYNTEC.COM				
PROJ. NO.	GR6601	DWG.	GR6601-030	EDIT 08.16.21
SCALE	AS SHOWN	DRAWING 30 OF 50		
DATE	AUGUST 2021			





PERMIT DRAWING  
NOT FOR CONSTRUCTION



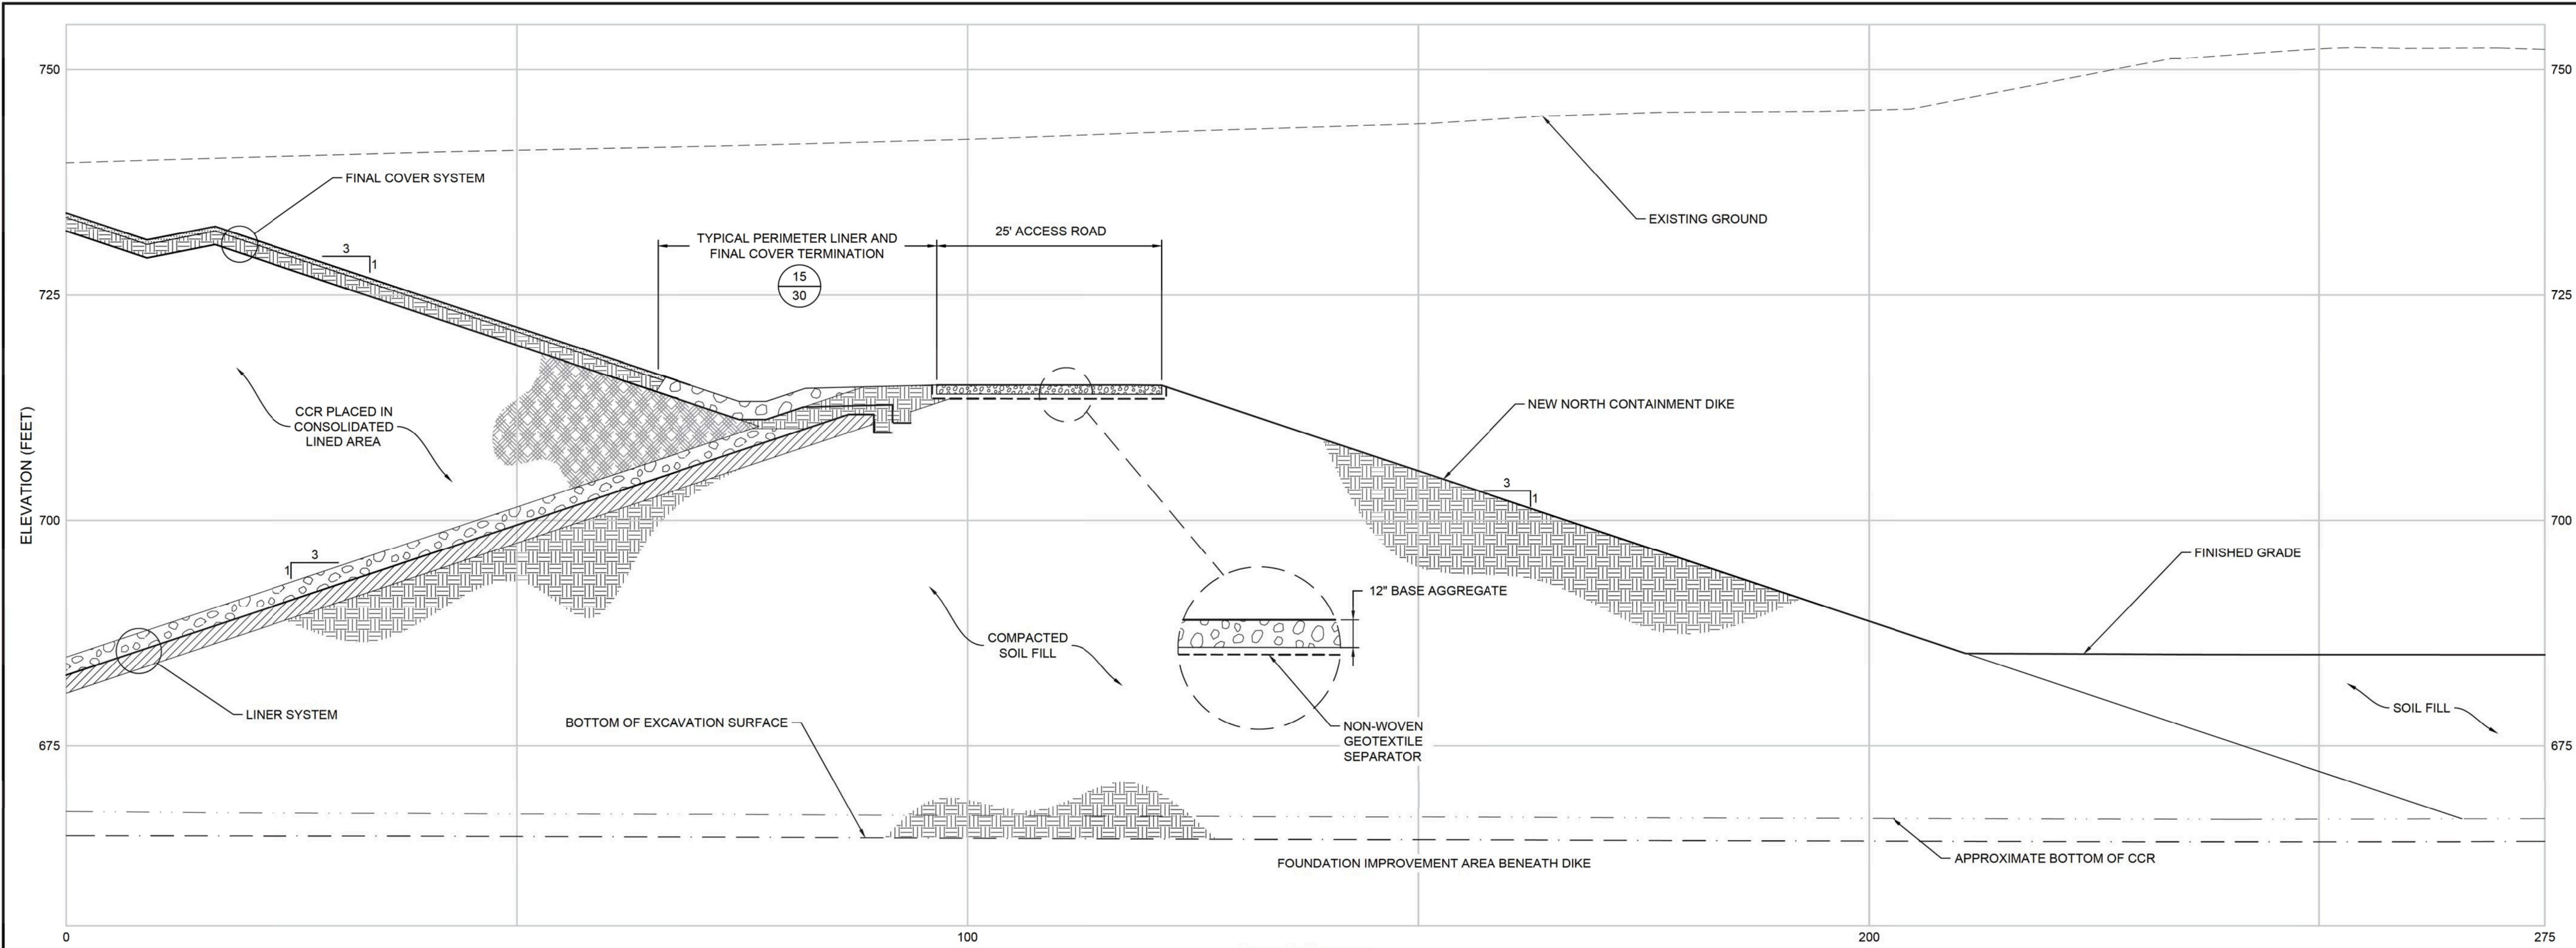

**D**  
**31**  
**SECTION**  
**NORTH PERIMETER**  
SCALE: 1" = 10'

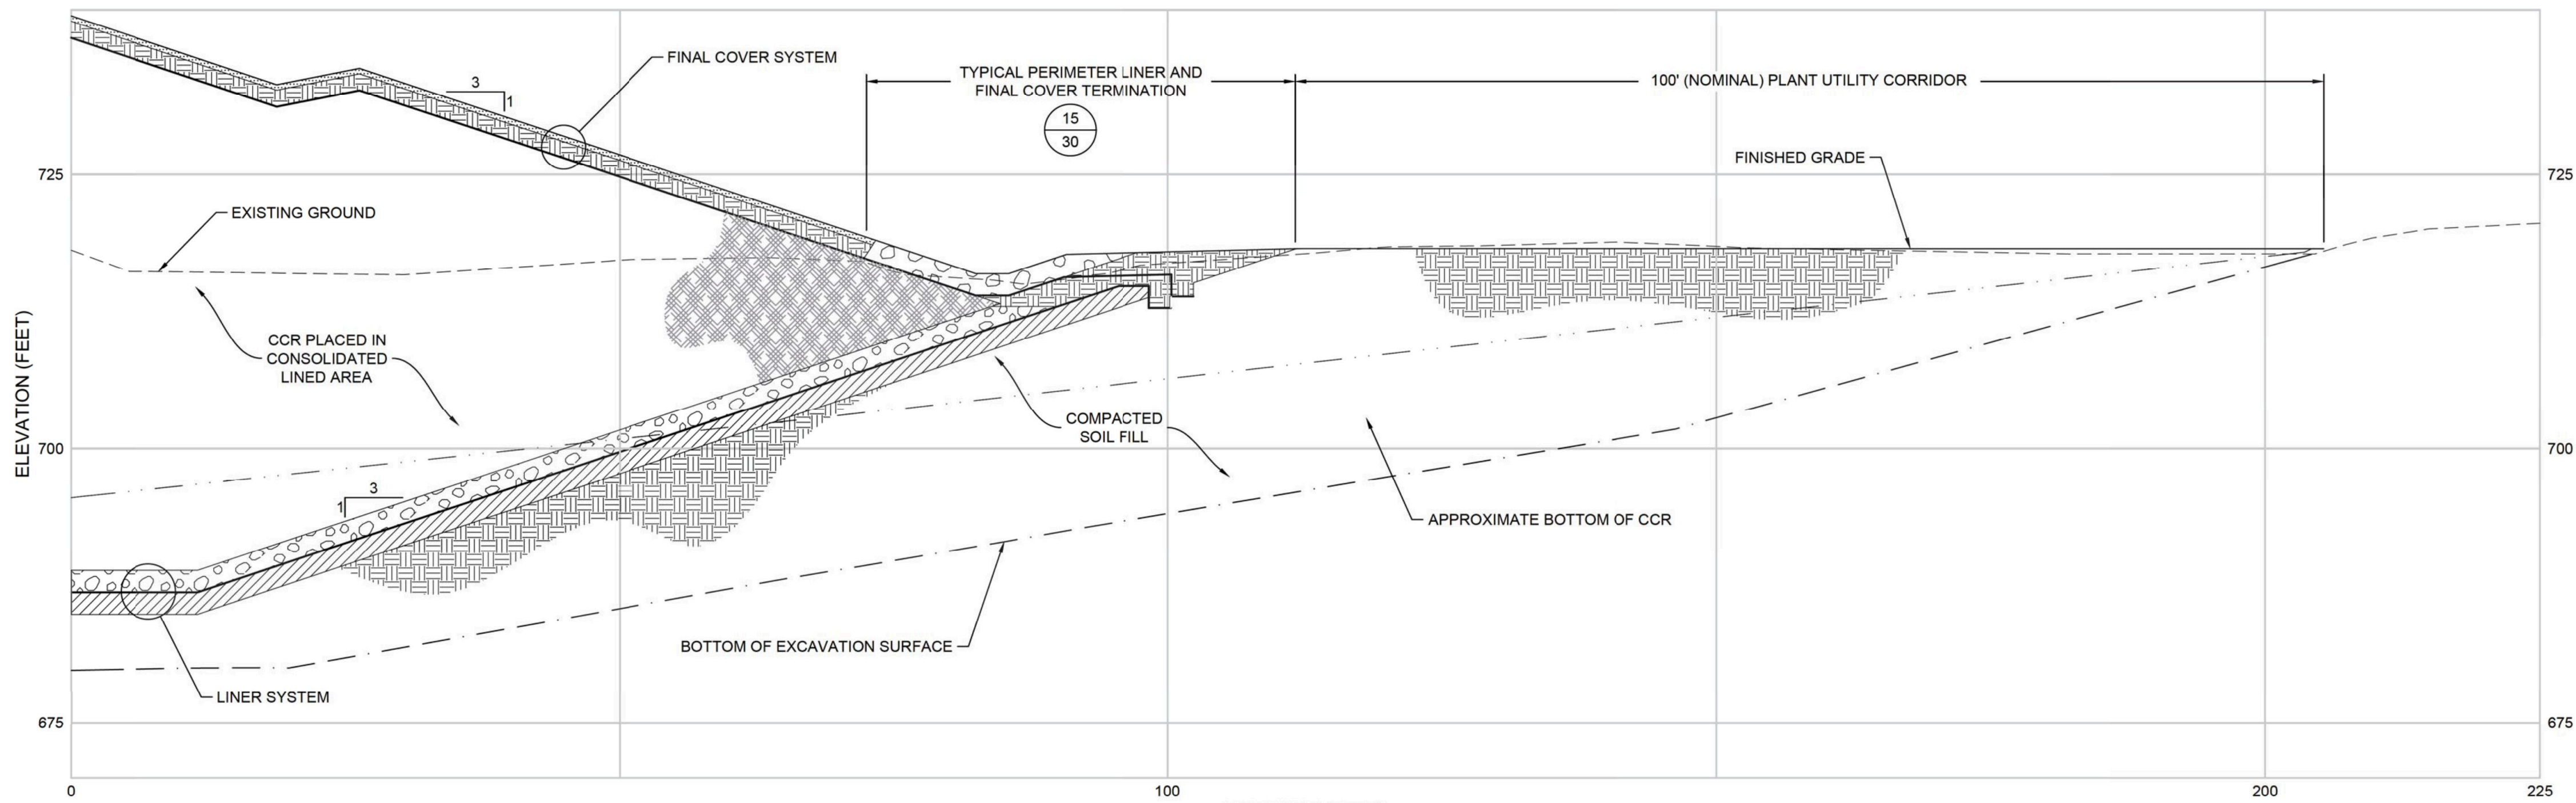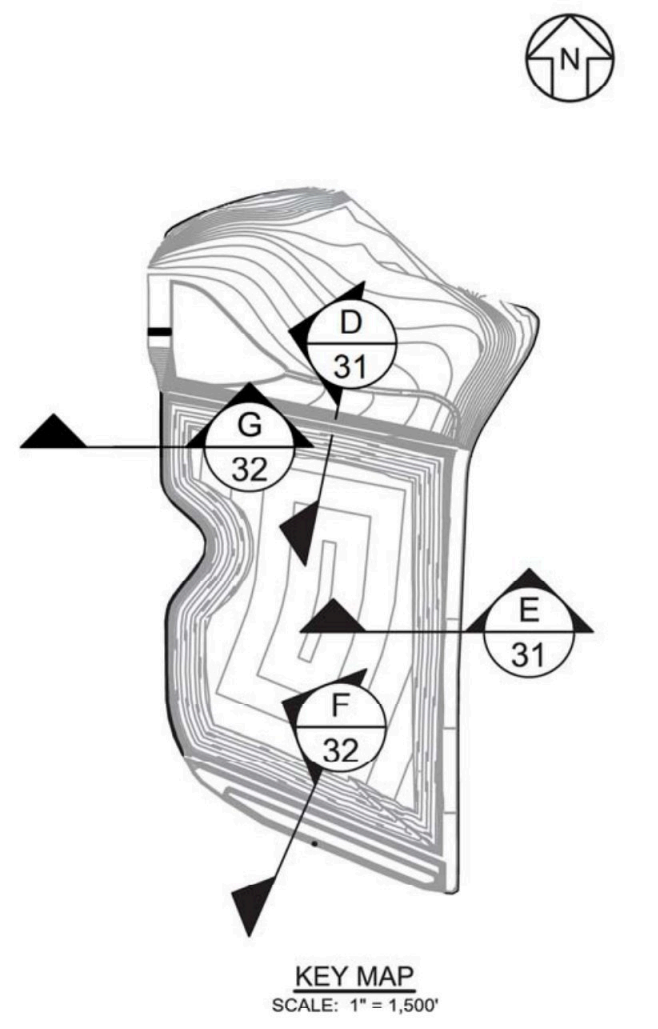

**E**  
**31**  
**SECTION**  
**EAST PERIMETER**  
SCALE: 1" = 10'




**Georgia Power**  
PERMIT DRAWING  
NOT FOR CONSTRUCTION


0	AUG. 2021	SUBMITTAL TO GA EPD	JJ/VKH	RB
REV	DATE	DESCRIPTION	DRN	APP
PERIMETER SECTIONS I				
PLANT BOWEN ASH POND 1 (AP-1) CLOSURE DRAWINGS BARTOW COUNTY, GEORGIA				
<b>Geosyntec</b> consultants				
1255 ROBERTS BOULEVARD, NW, SUITE 200 KENNESAW, GEORGIA 30144 USA PHONE: 678.202.8600 WWW.GEOSYNTEC.COM				
PROJ. NO.	GR6601	DWG.	GR6601-032	EDIT 08.16.21
SCALE	AS SHOWN	DRAWING 31 OF 50		
DATE	AUGUST 2021			

P:\CAD\PROJECTS\GEORGIA POWER\BOWEN POWER PLANT\PERMIT\ASH POND CLOSURE (GR6601)\DRAWINGS\GR6601-032




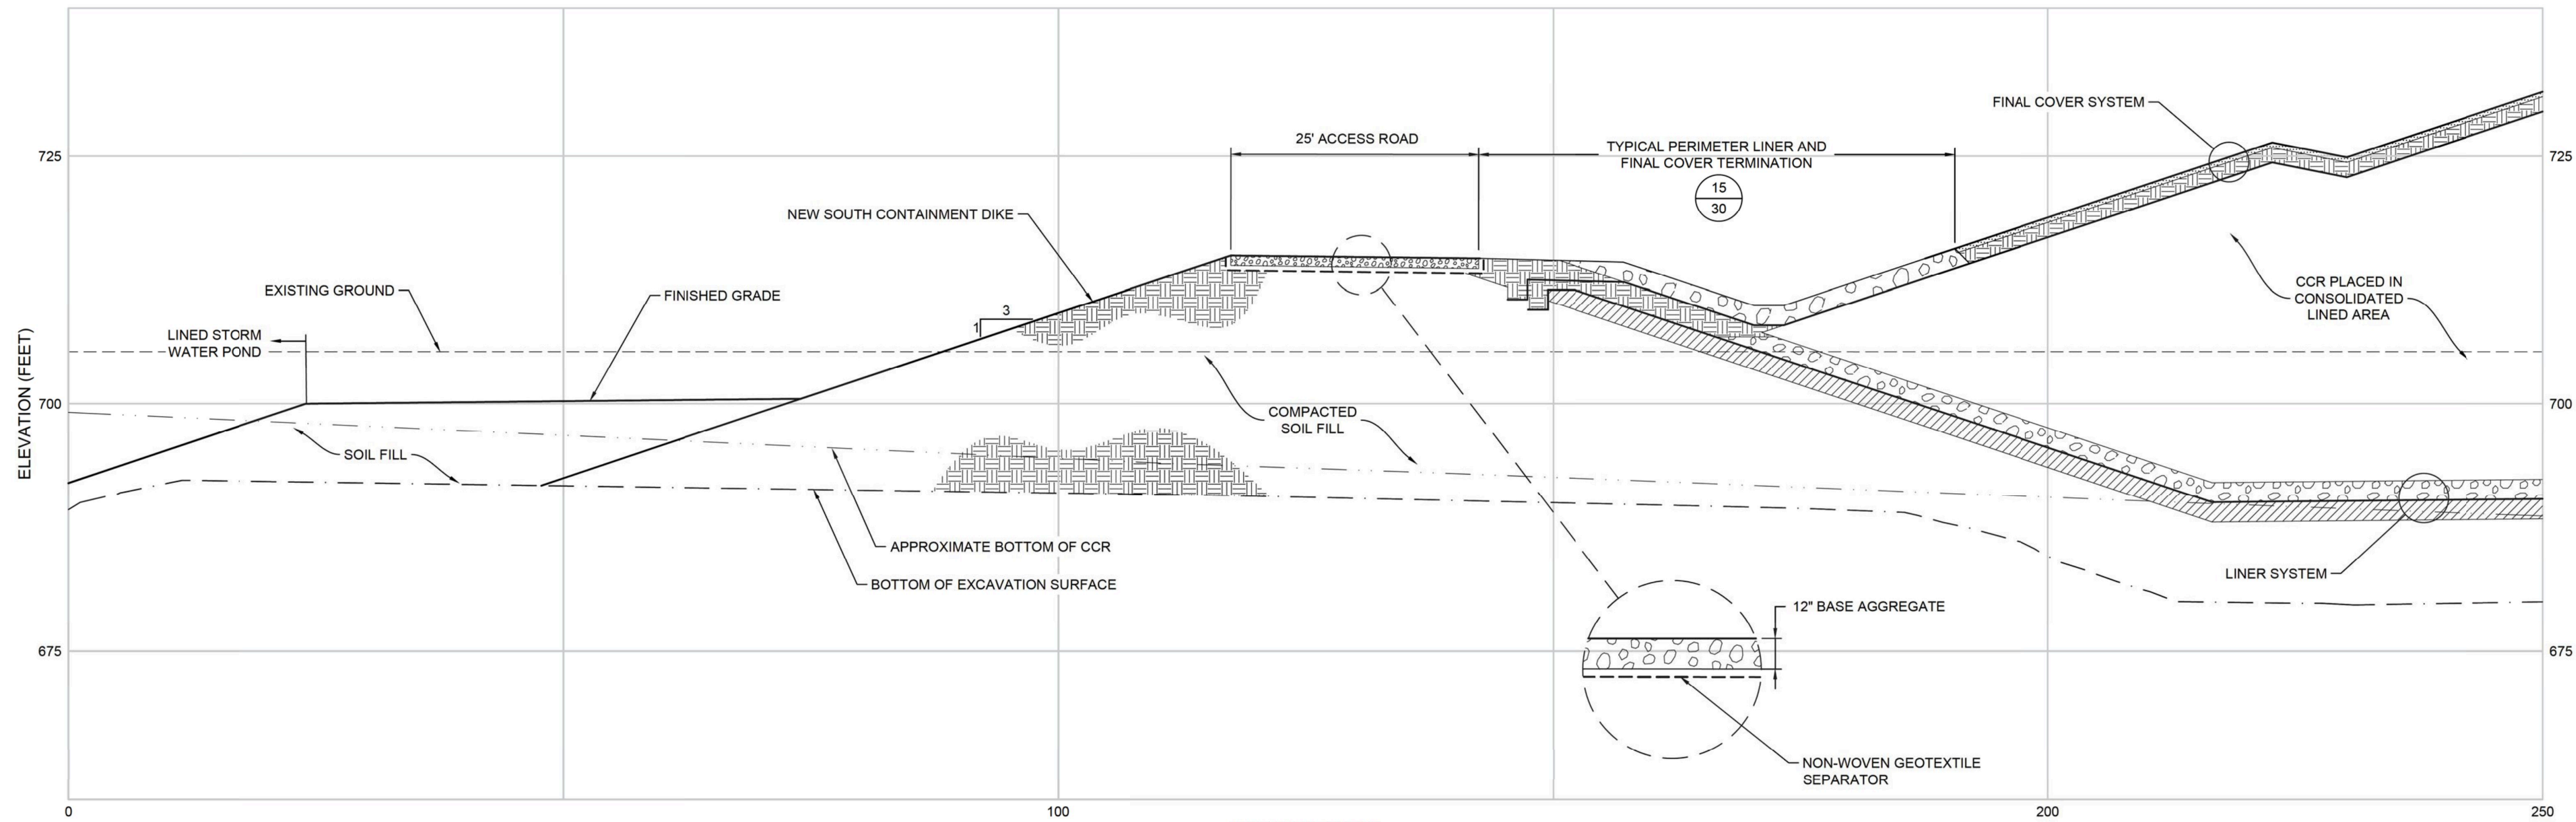

**F**  
32  
**SECTION**  
**SOUTH PERIMETER**  
SCALE: 1" = 10'

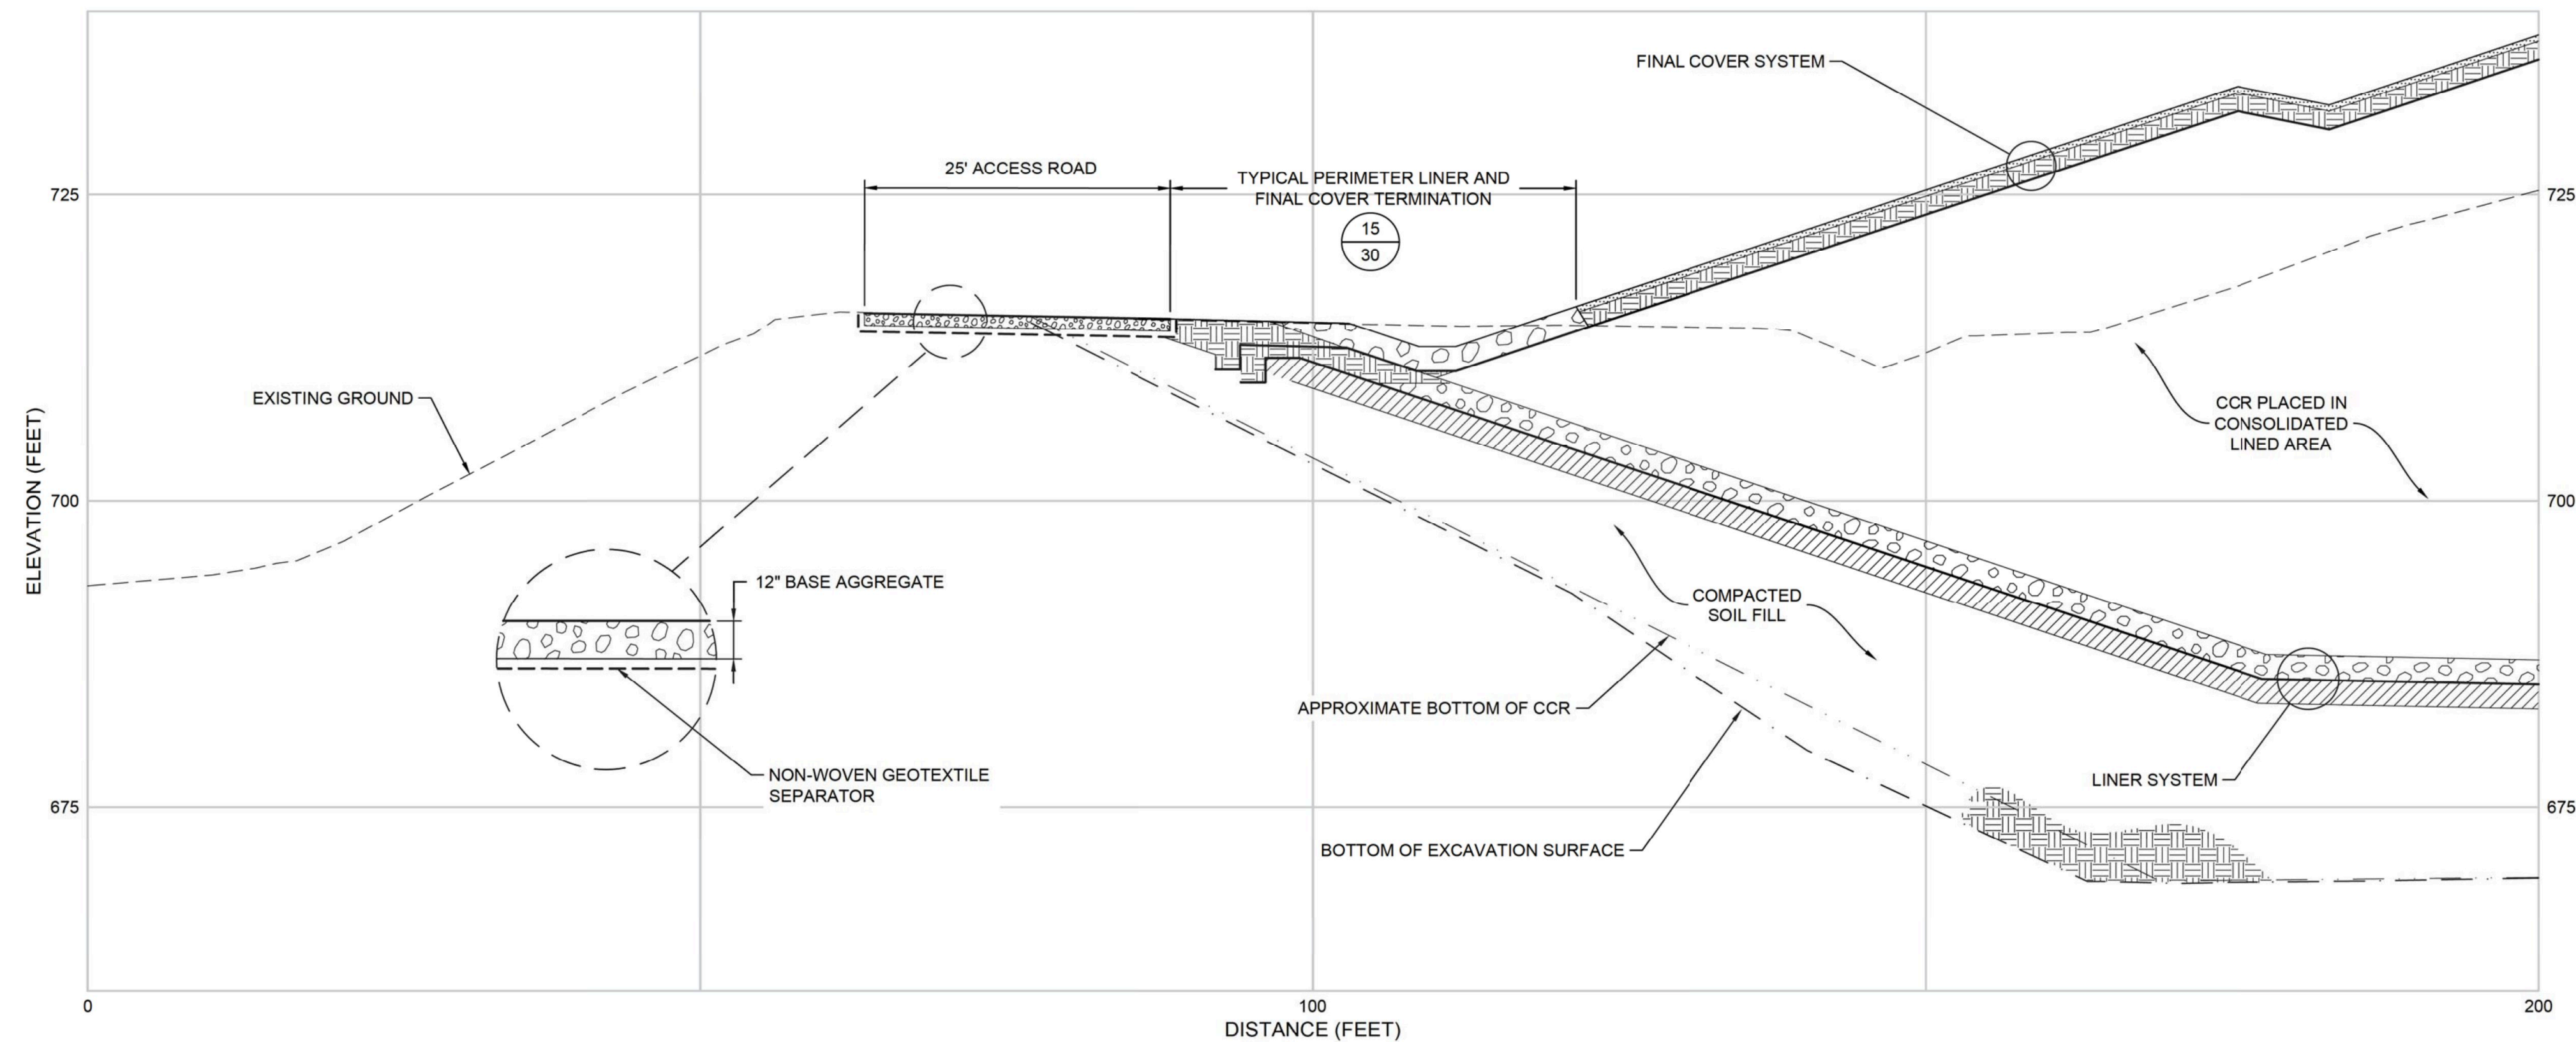

**G**  
32  
**SECTION**  
**WEST PERIMETER**  
SCALE: 1" = 10'

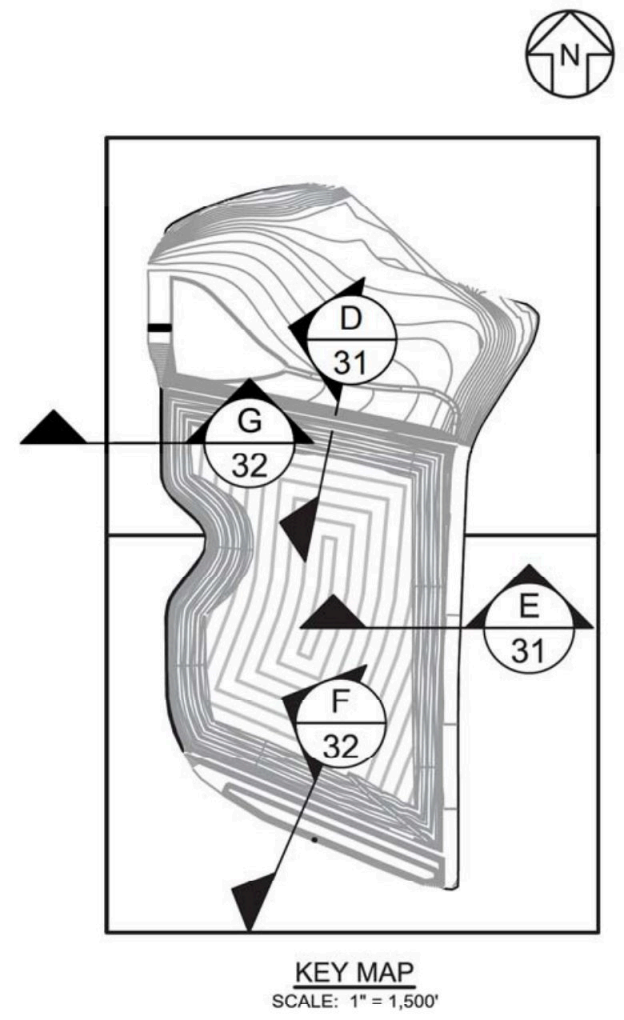

0	AUG. 2021	SUBMITTAL TO GA EPD	JJ/VKH	RB
REV	DATE	DESCRIPTION	DRN	APP
PERIMETER SECTIONS II				
PLANT BOWEN ASH POND 1 (AP-1) CLOSURE DRAWINGS BARTOW COUNTY, GEORGIA				
<b>Geosyntec</b> consultants <small>1255 ROBERTS BOULEVARD, NW, SUITE 200 KENNESAW, GEORGIA 30144 USA</small>				
PROJ. NO.	GR6601	DWG.	GR6601-033	EDIT 08.16.21
SCALE	AS SHOWN	DRAWING 32 OF 50		
DATE	AUGUST 2021			



PERMIT DRAWING  
NOT FOR CONSTRUCTION





LEGEND	
	EXCAVATION SURFACE ELEVATION (FEET)
	TOP OF LINER SYSTEM ELEVATION (FEET)
	EXISTING LIMIT OF AP-1
	LEACHATE COLLECTION CORRIDOR
	LEACHATE SUMP AND RISER PIPE
	LEACHATE FORCEMAIN
	PERMIT BOUNDARY
	LEACHATE FORCEMAIN AIR RELEASE MANHOLE
	LEACHATE FORCEMAIN CLEANOUT MANHOLE
	LEACHATE FORCEMAIN JUNCTION MANHOLE
	LEACHATE RISER PAD
	TEMPORARY WWTS PAD

- NOTES:
- SEE DRAWING 2 FOR LEGENDS, ABBREVIATIONS, AND GENERAL SITE NOTES.
  - TOP OF LINER GRADES SHOWN ON THIS DRAWING REPRESENT THE TOP OF THE GEOMEMBRANE COMPONENT OF THE LINER SYSTEM WITHIN THE CONSOLIDATED LINED FOOTPRINT AREA. WITHIN THE REMAINDER OF AP-1 OUTSIDE THE CONSOLIDATED LINED FOOTPRINT AREA, GRADES REPRESENT EXISTING EXTERIOR NORTH AND SOUTH CONTAINMENT DIKE SLOPES, WHICH TIE-IN TO THE ESTIMATED BOTTOM OF EXCAVATION GRADES. CONTOURS SHOWN ON THIS DRAWING BEYOND LIMITS OF AP-1 ARE EXISTING GROUND TOPOGRAPHY.
  - A TEMPORARY WWTS WILL BE ESTABLISHED AT THE APPROXIMATE LOCATION SHOWN FOR TREATMENT OF LEACHATE AND CONTACT WATER GENERATED DURING CLOSURE CONSTRUCTION. AT THE COMPLETION OF CLOSURE CONSTRUCTION, LEACHATE WILL BE ROUTED TO A PERMANENT ON-SITE WWTS LOCATED OUTSIDE THE AP-1 PERMIT BOUNDARY, ON THE PLANT BOWEN PROPERTY.




1	MAY 2024	UPDATE AND ADD GAS PIPELINES	JDV	RS
3	AUG. 2021	SUBMITTAL TO GA EPD	JAN/RH	RS
REV.	DATE	DESCRIPTION	DRN	APP
LEACHATE MANAGEMENT PLAN				
PLANT BOWEN ASH POND 1 (AP-1) CLOSURE DRAWINGS BARTOW COUNTY, GEORGIA				
<div>Geosyntec<sup>®</sup> consultants</div> <div>1305 ROBERTS BOULEVARD, SUITE 300 KENNESAW, GEORGIA 30144 USA PHONE: 478.302.9500 WWW.GEOSYNTEC.COM</div>				
PROJ. NO.	GR6601	DWG.	GR6601-034	EDIT 5/23/24
SCALE	1" = 300'	DRAWING 33 OF 50		
DATE	AUGUST 2021			




PERMIT DRAWING  
NOT FOR CONSTRUCTION



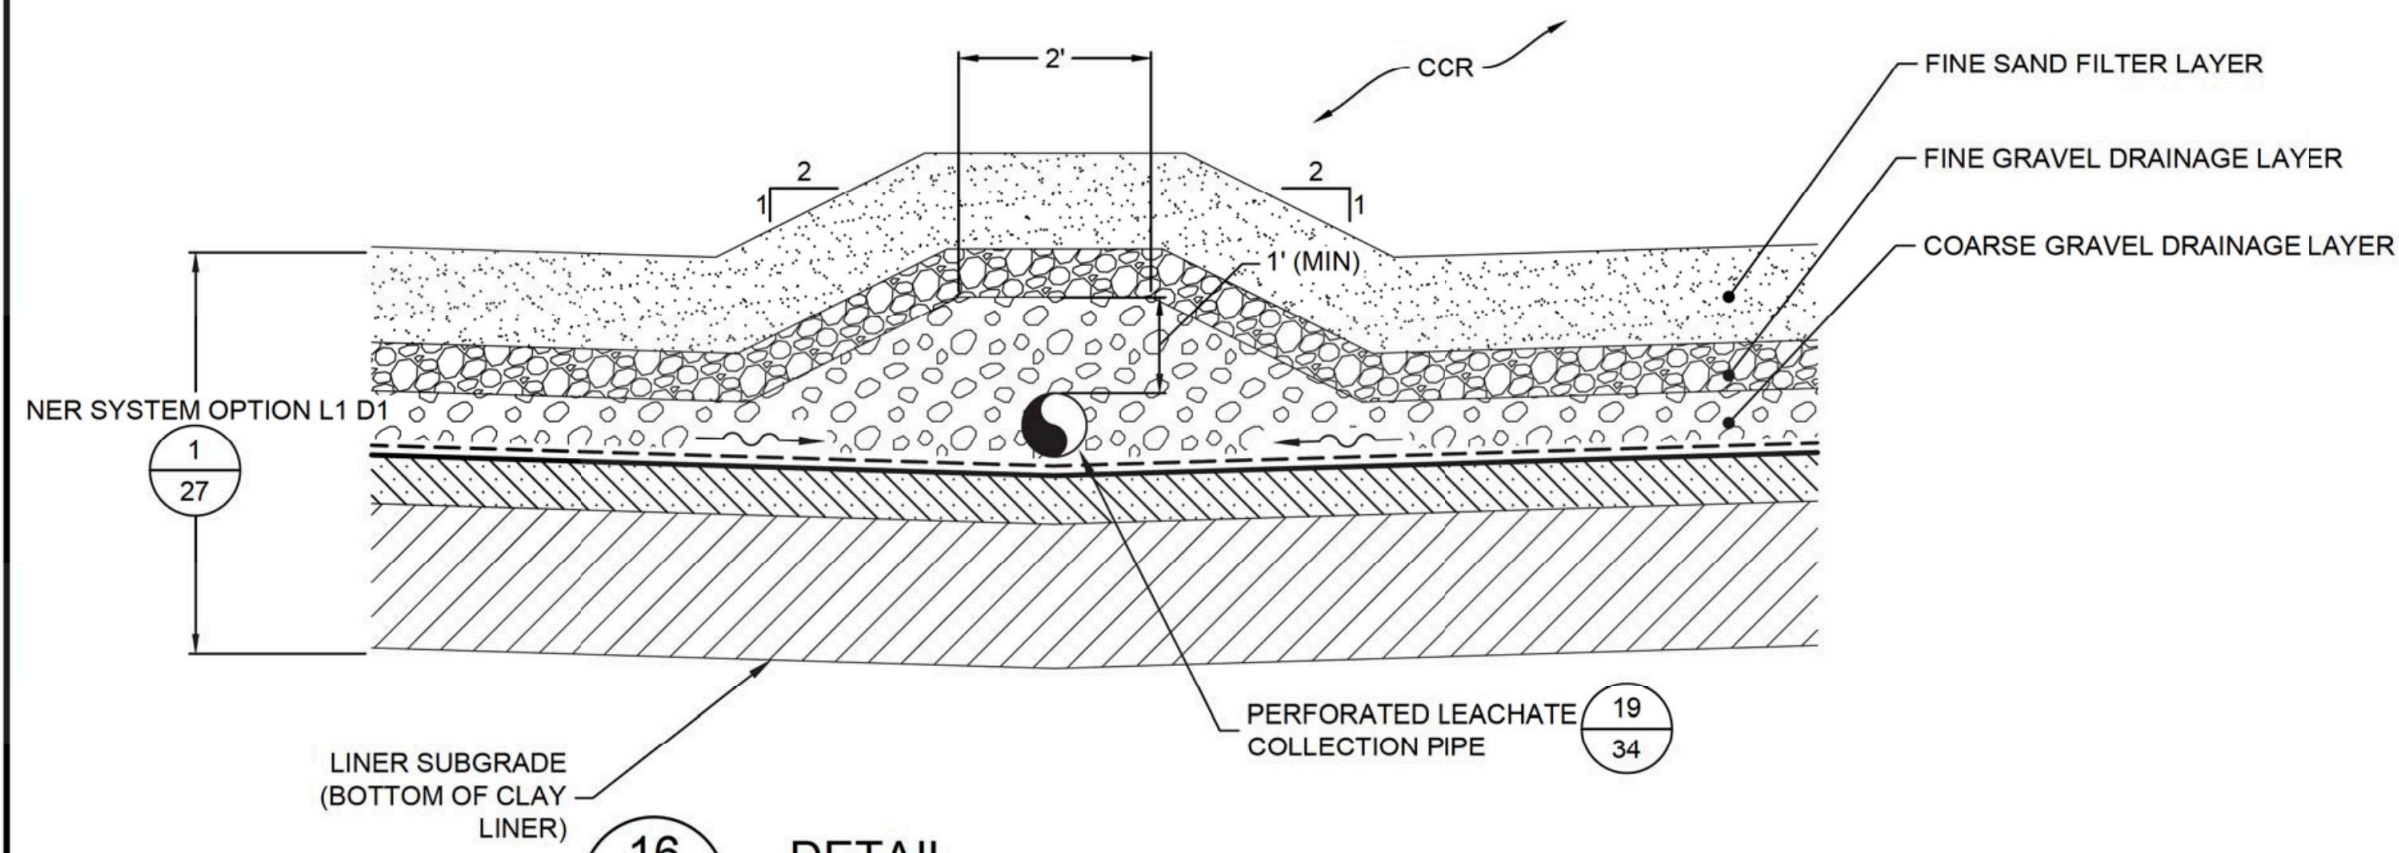


**16**  
**33** **DETAIL**  
**LEACHATE COLLECTION CORRIDOR**


0 2 4  
SCALE IN FEET

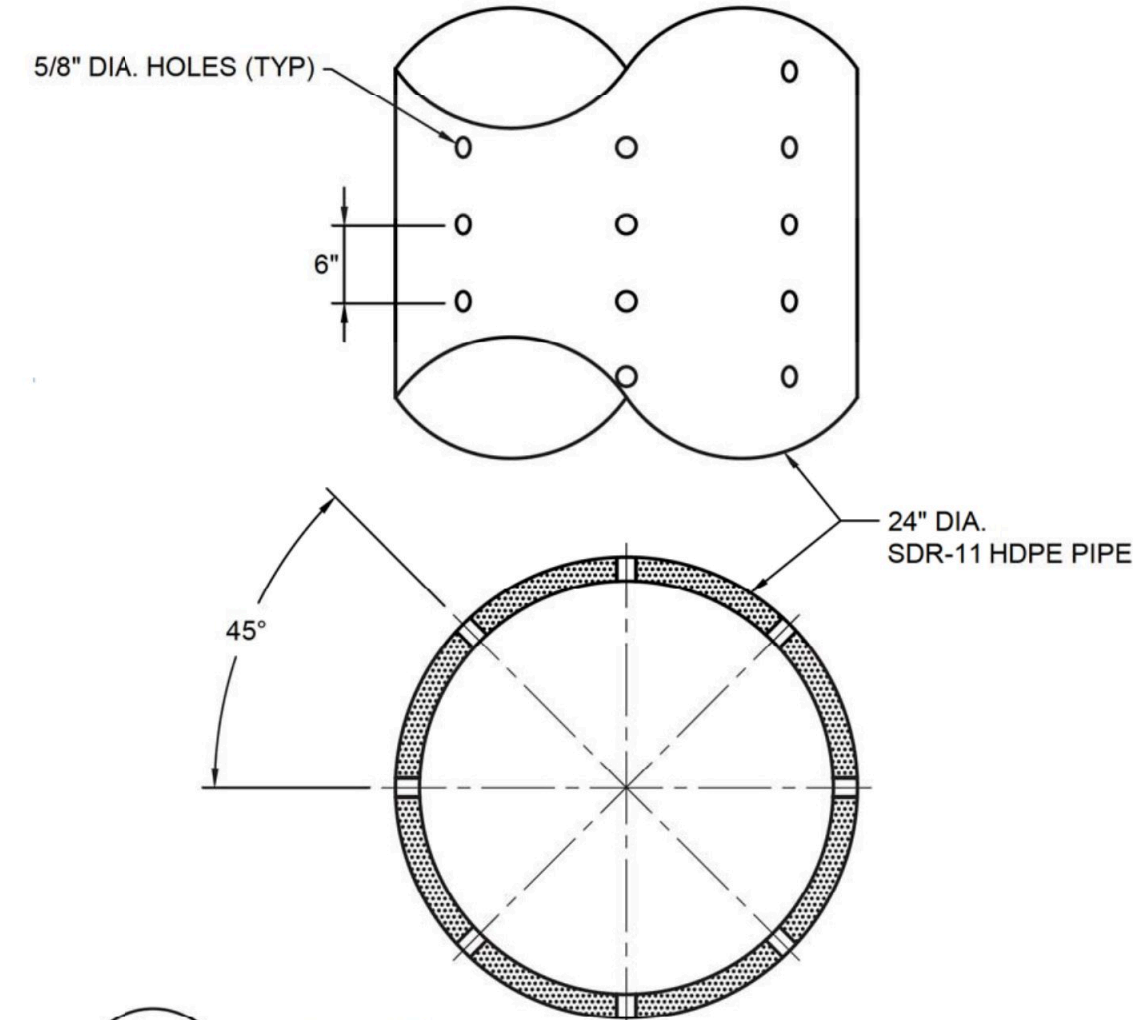


**17**  
**34** **DETAIL**  
**PERFORATED LEACHATE RISER PIPE**  
SCALE: NOT TO SCALE

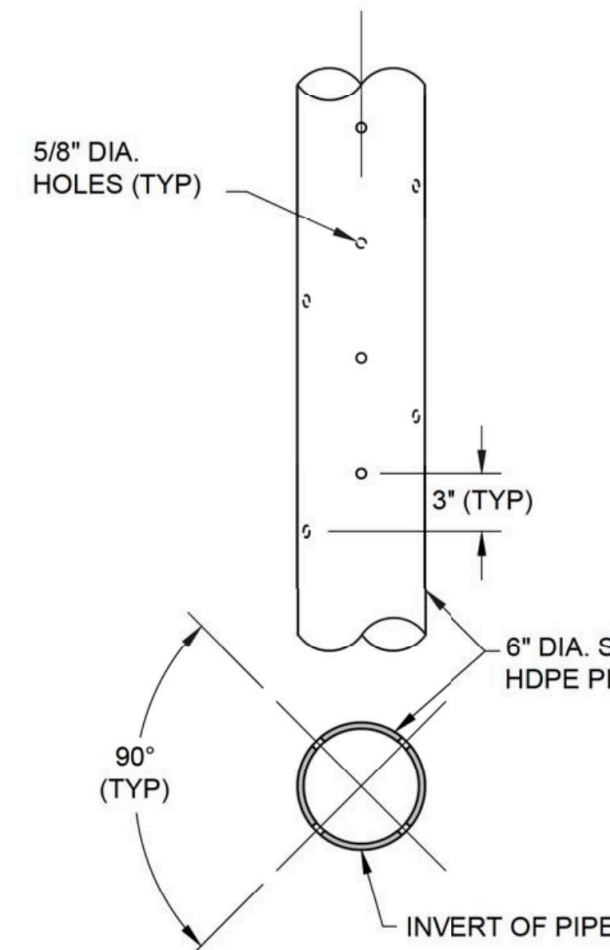

**19**  
**34** **DETAIL**  
**PERFORATED LEACHATE COLLECTION PIPE**  
SCALE: NOT TO SCALE

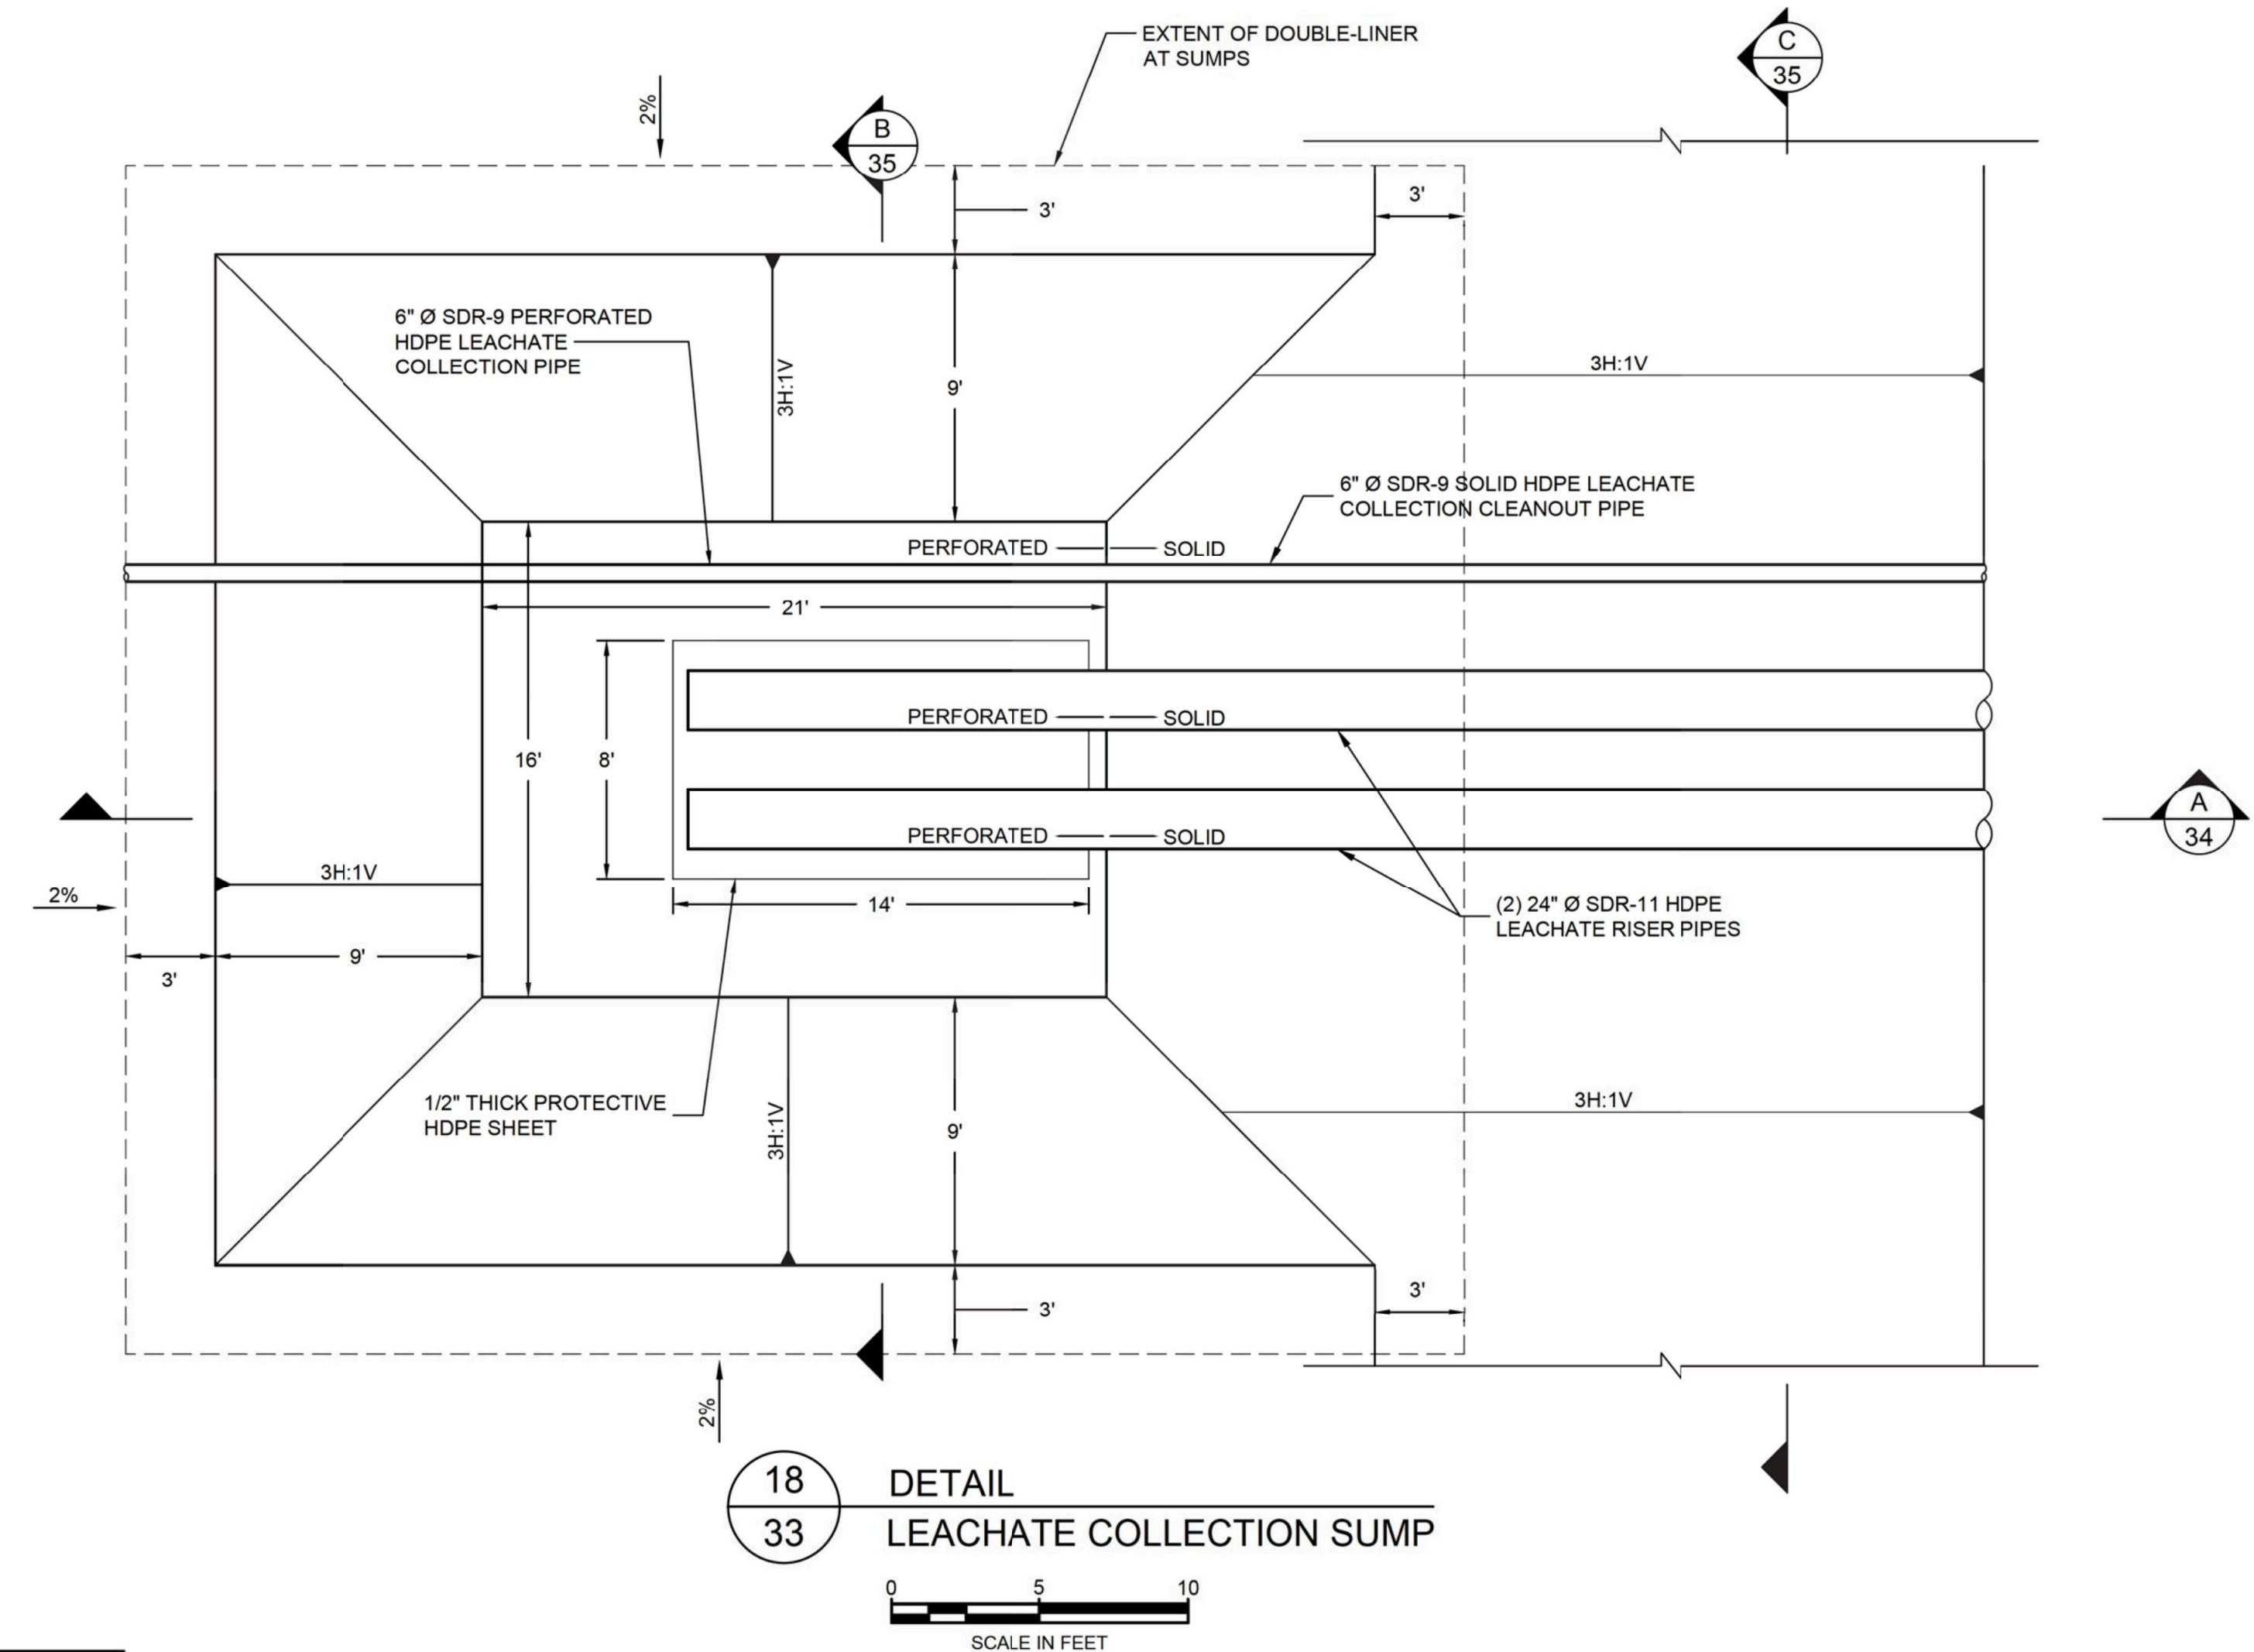

**18**  
**33** **DETAIL**  
**LEACHATE COLLECTION SUMP**  
0 5 10  
SCALE IN FEET

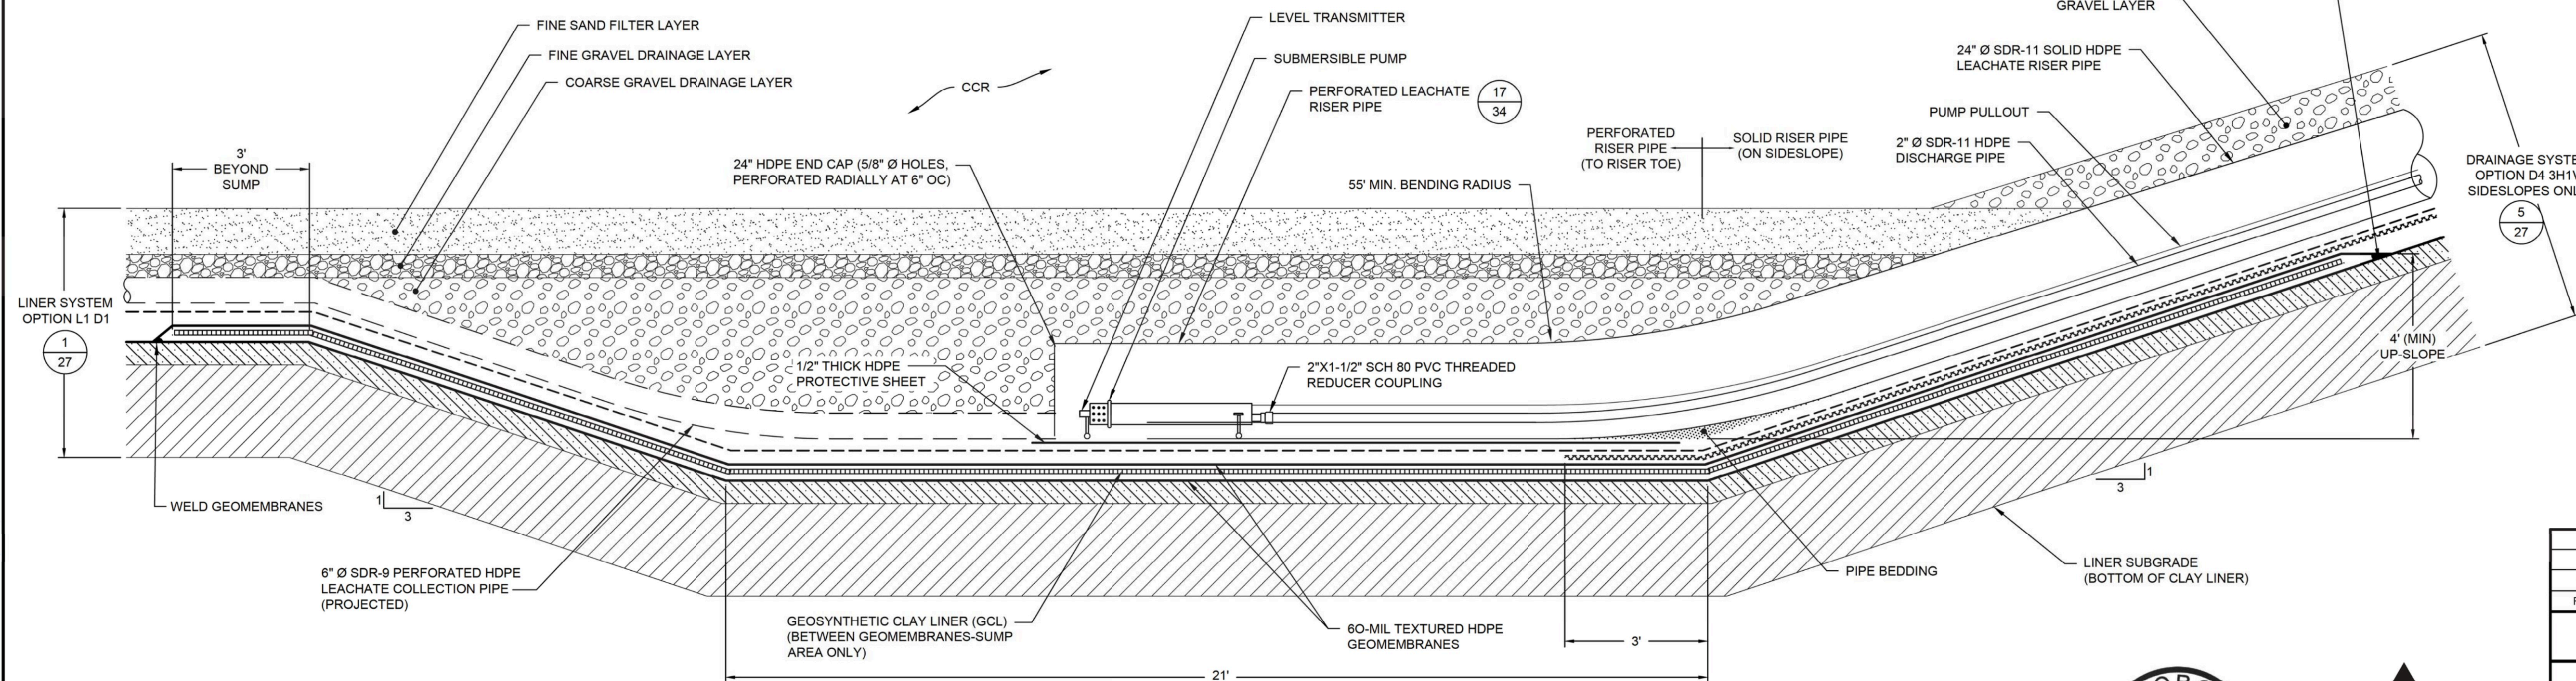

**A**  
**34** **SECTION**  
**LEACHATE COLLECTION RISER TOE**

0 2 4  
SCALE IN FEET



- NOTES:
1. GEOSYNTHETIC LAYER THICKNESSES EXAGGERATED FOR CLARITY.
  2. SUBGRADE PREPARATION IN AREAS WHERE GEOMEMBRANE LINER WILL BE INSTALLED WILL CONSIST OF MOISTURE CONDITIONING, COMPACTION, AND SMOOTH ROLLING AS NEEDED.
  3. TWO RISER PIPES ARE PROVIDED: A PRIMARY RISER AND A BACKUP/REDUNDANT RISER - EACH WITH A SUBMERSIBLE PUMP.
  4. GRADATION REQUIREMENTS AND OTHER MATERIAL PROPERTIES FOR SOIL LAYERS WILL BE PROVIDED IN TECHNICAL SPECIFICATIONS DEVELOPED FOR DETAILED DESIGN.
  5. DETAILS SHOWN ON THIS DRAWING REFLECT LINER SYSTEM OPTIONS AS INDICATED. IF OTHER LINER SYSTEM OPTIONS ARE USED, THE DESIGN APPROACH WILL REMAIN CONSISTENT WITH THIS DRAWING.





PERMIT DRAWING  
NOT FOR CONSTRUCTION

REV	DATE	DESCRIPTION	DRN	APP
0	AUG. 2021	SUBMITTAL TO GA EPD	JV/KH	RB
LEACHATE COLLECTION SYSTEM DETAILS I				
PLANT BOWEN ASH POND 1 (AP-1) CLOSURE DRAWINGS BARTOW COUNTY, GEORGIA				
<b>Geosyntec</b> consultants <small>1255 ROBERTS BOULEVARD, NW, SUITE 200 KENNESAW, GEORGIA 30144 USA PHONE: 678.202.9600 WWW.GEOSYNTEC.COM</small>				
PROJ. NO.	GR6601	DWG.	GR6601-036	EDIT 08.16.21
SCALE	AS SHOWN	DRAWING 34 OF 50		
DATE	AUGUST 2021			



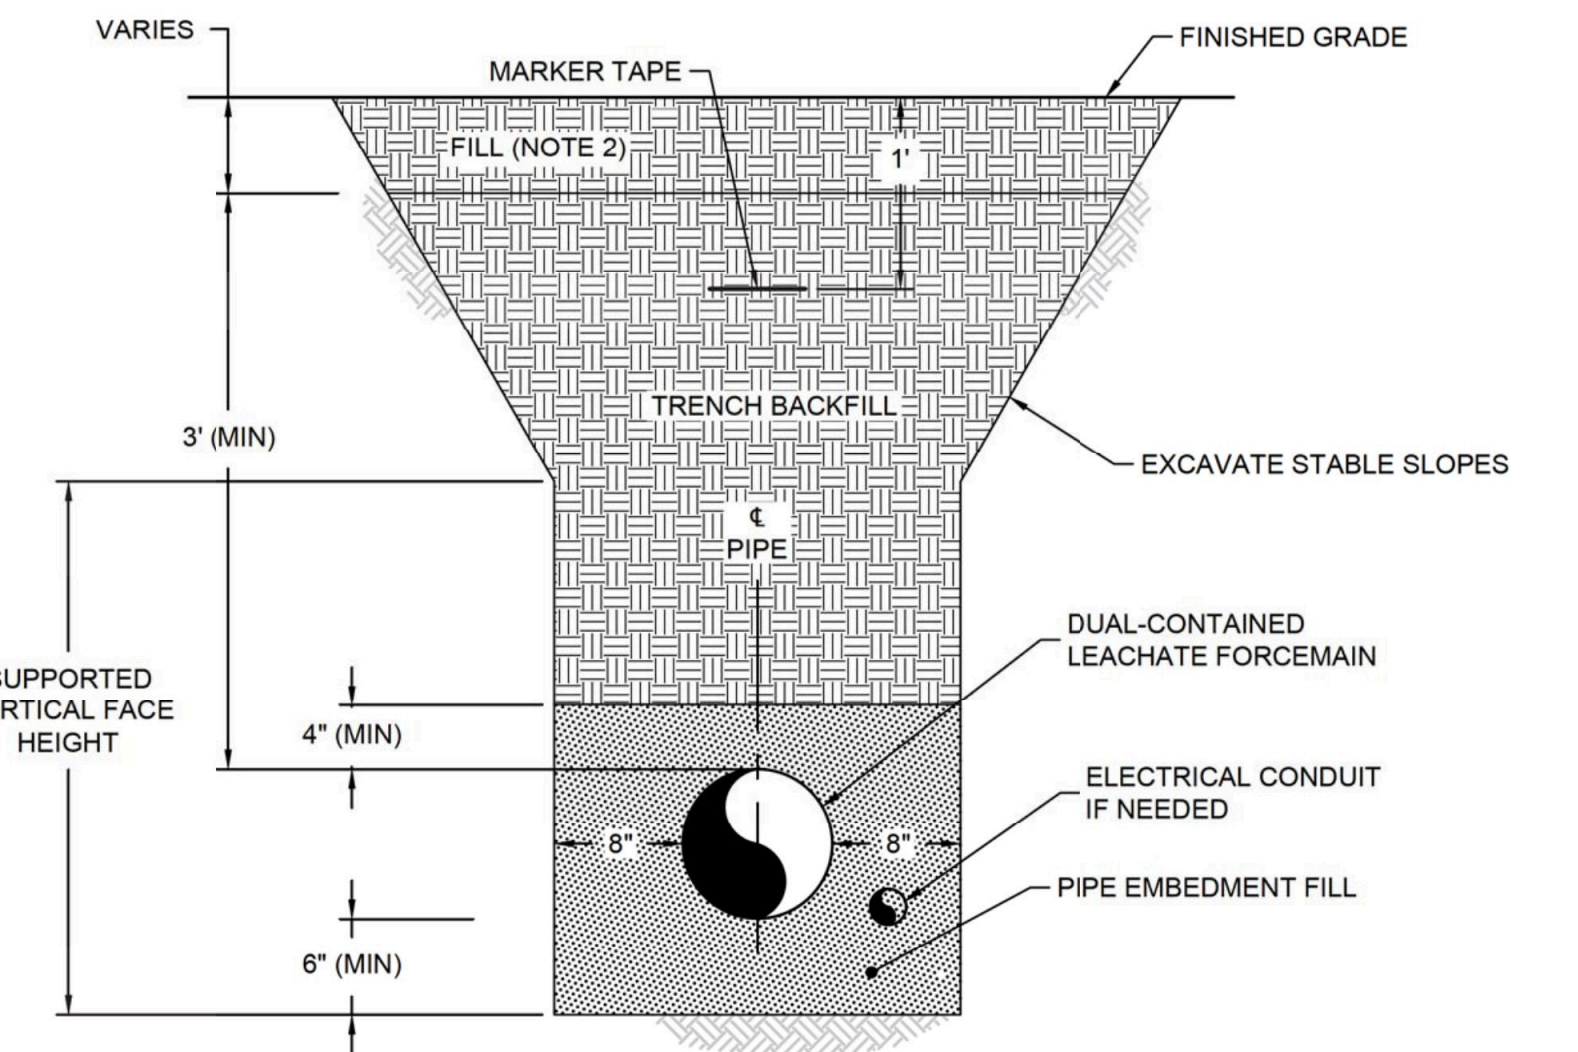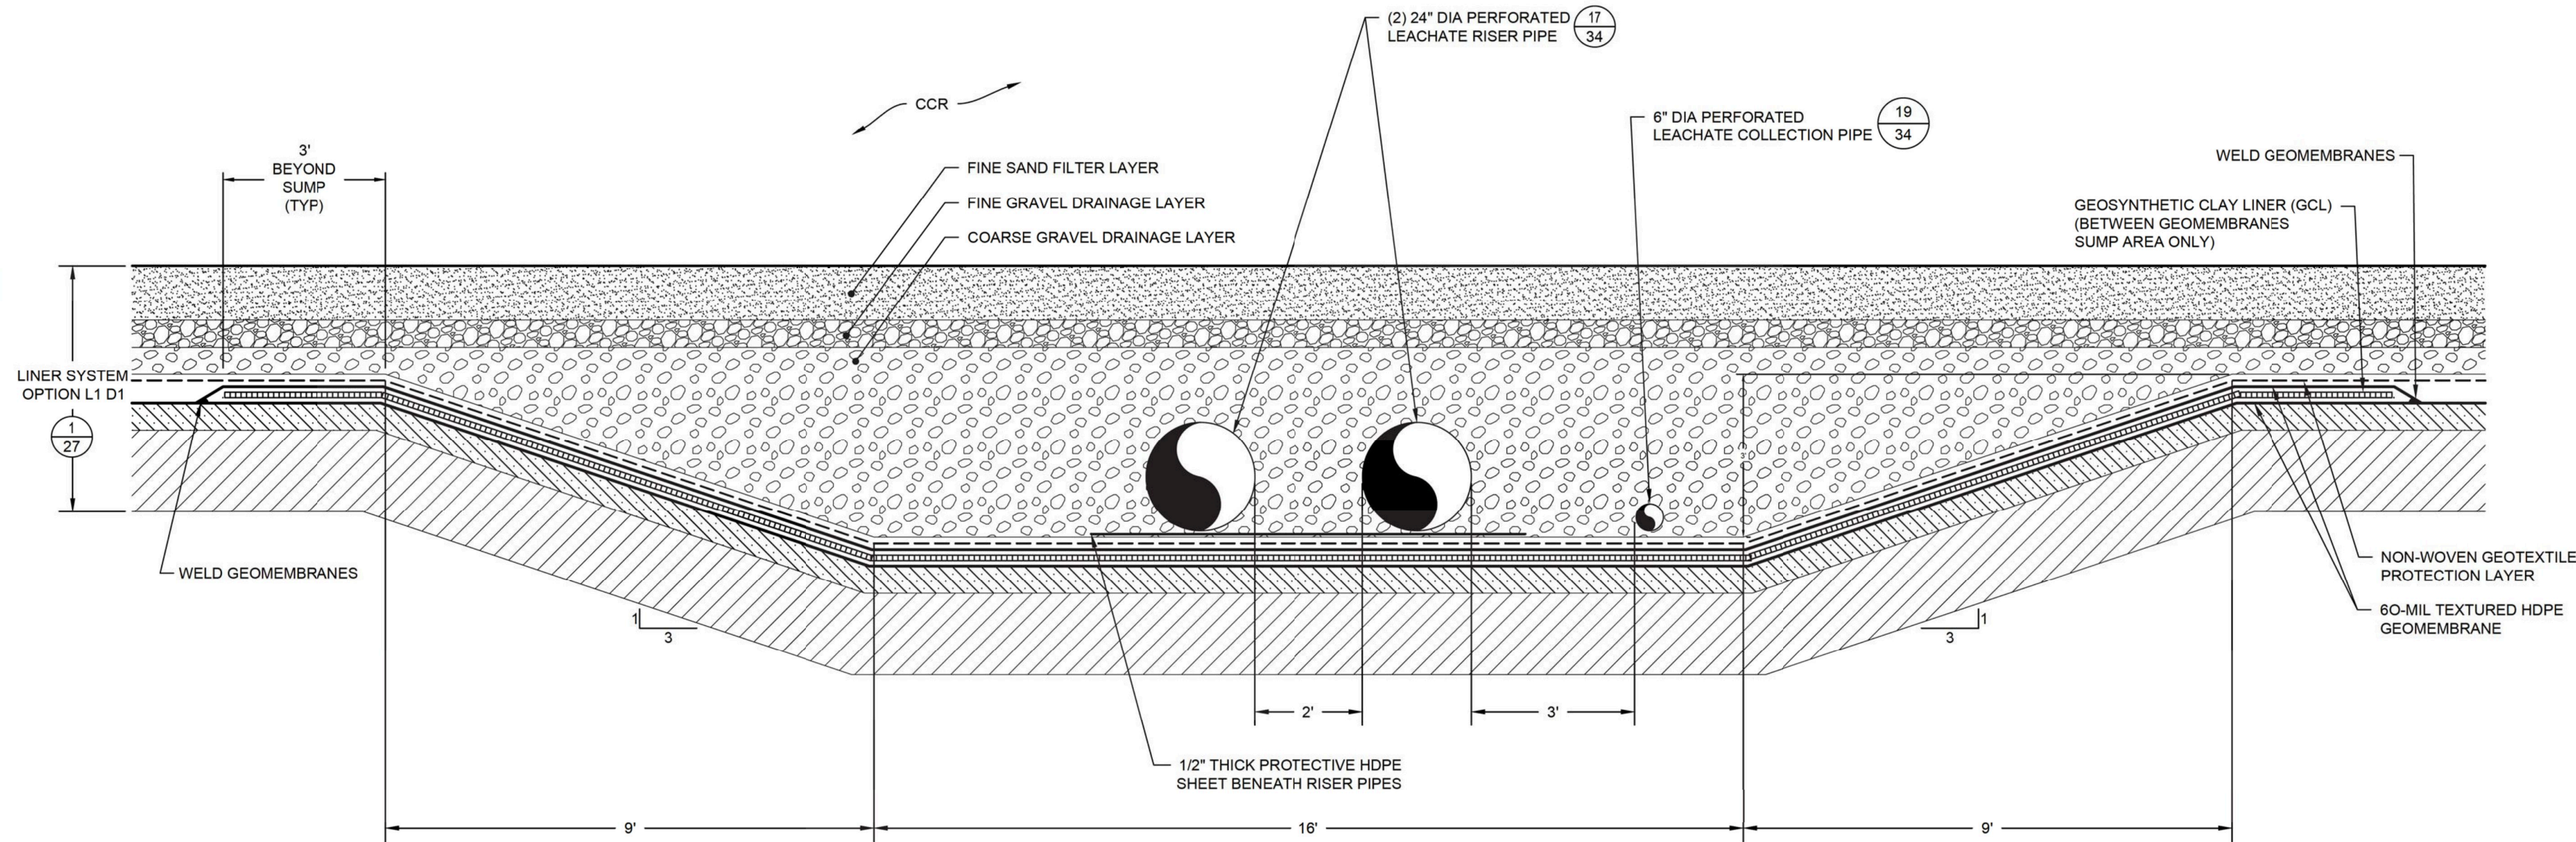

**B**  
**34** SECTION  
**LEACHATE COLLECTION SUMP**  
SCALE: 1"=2'

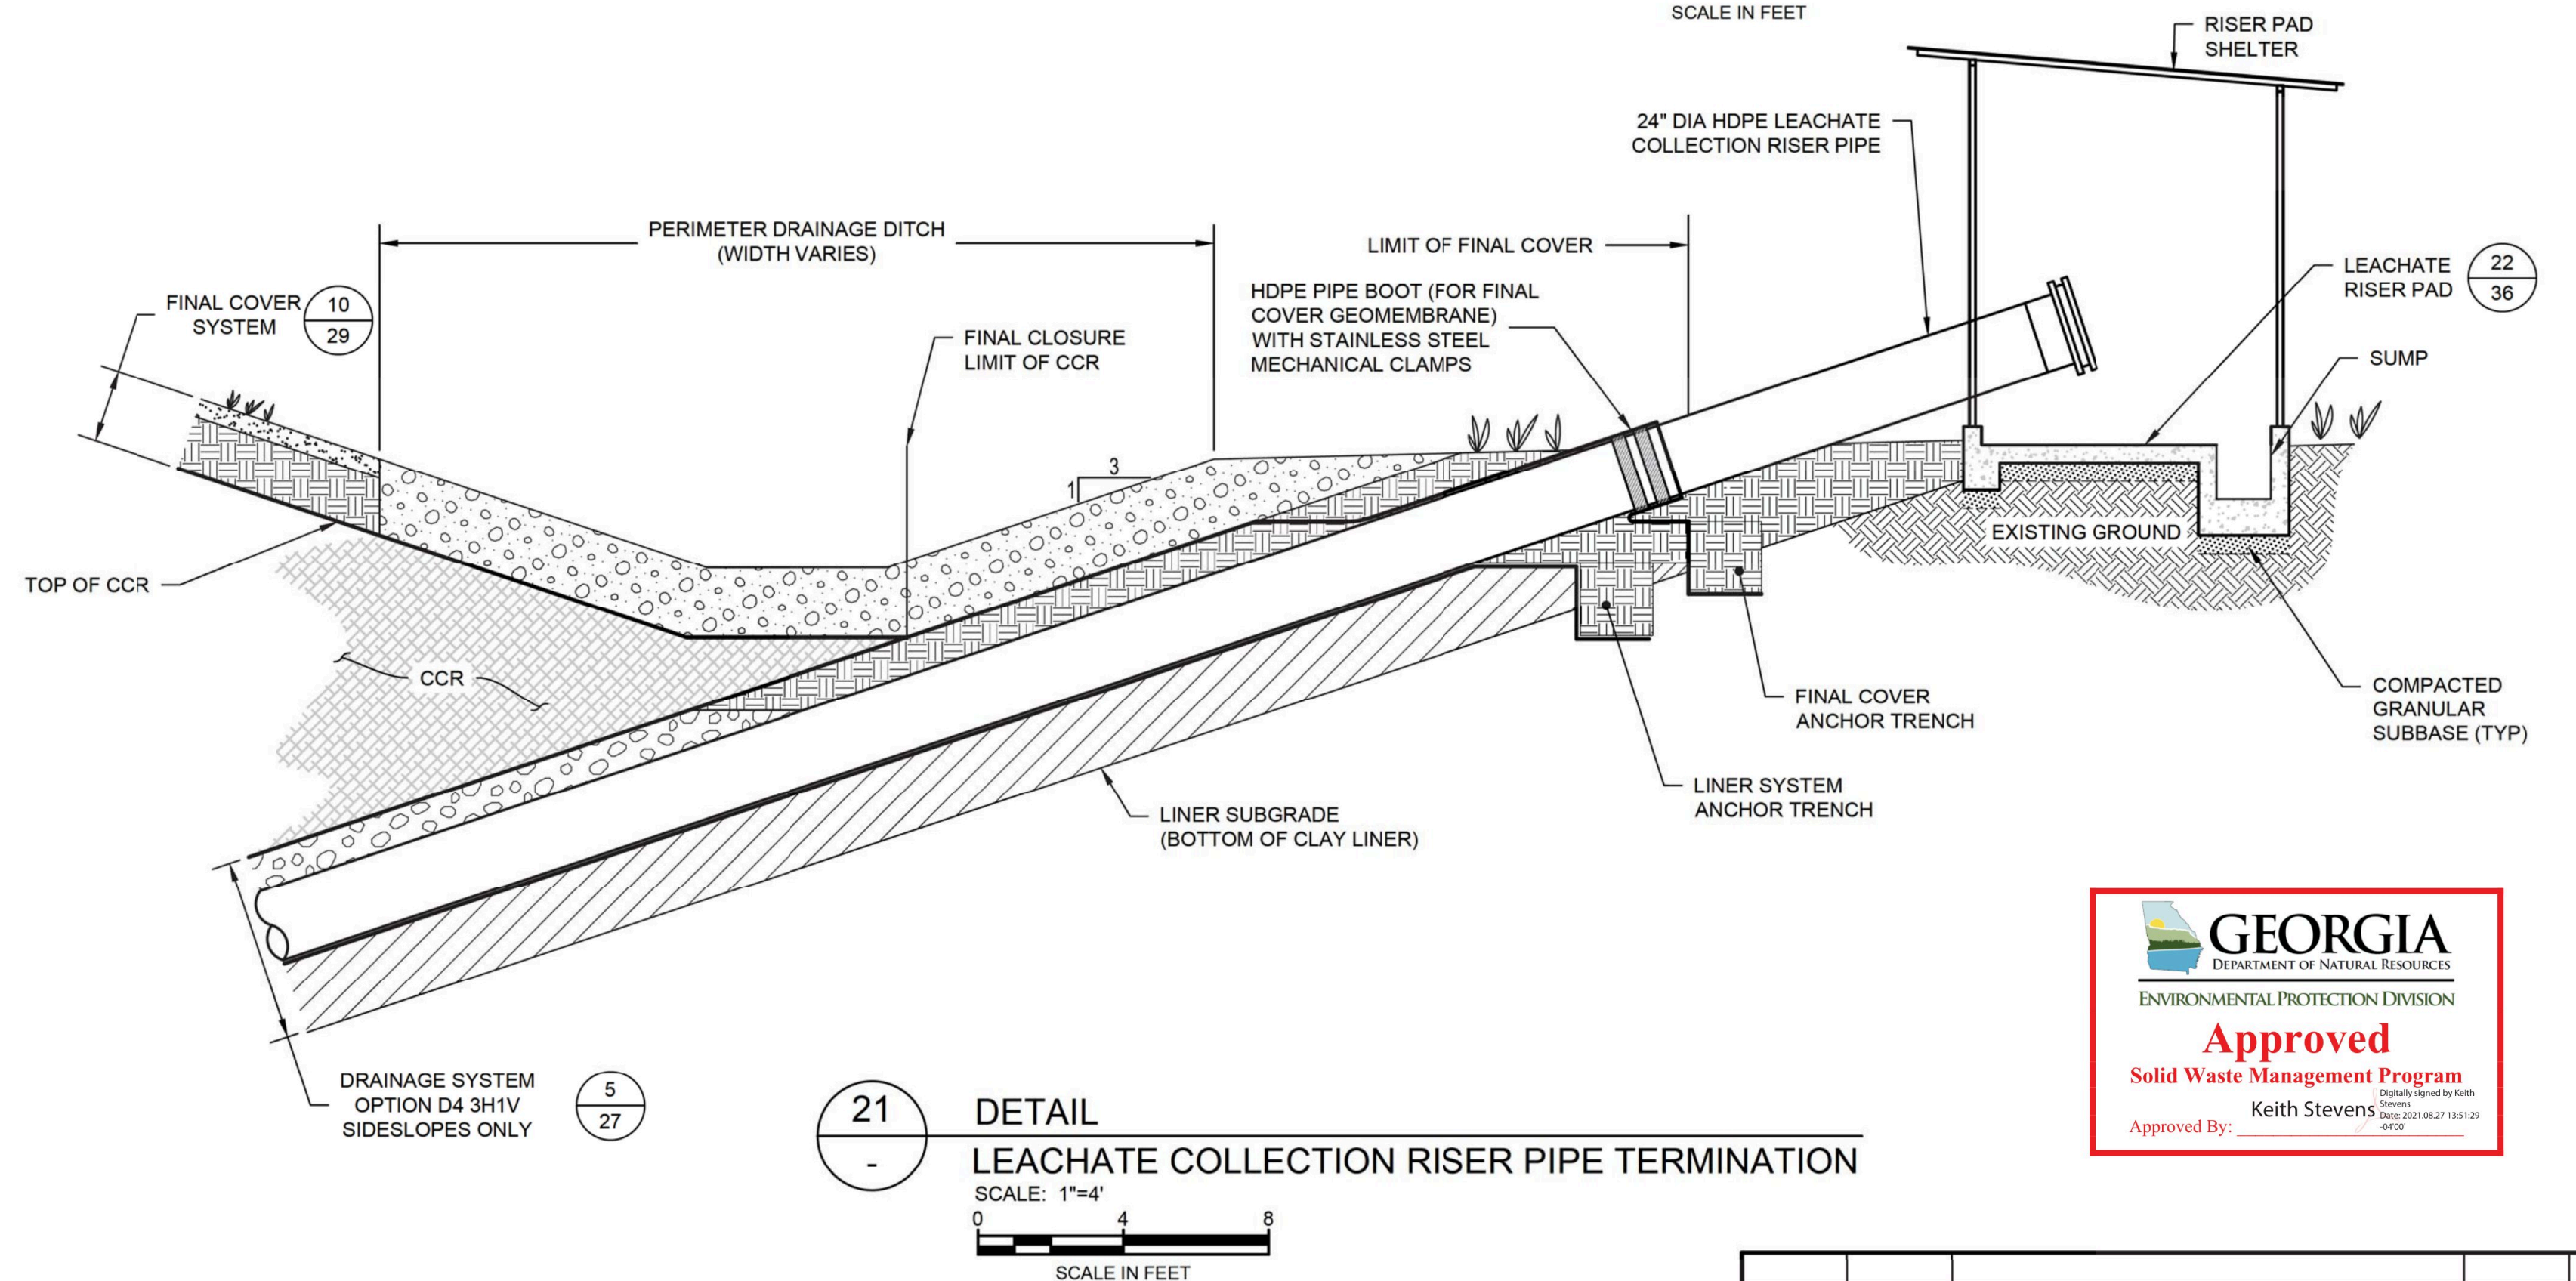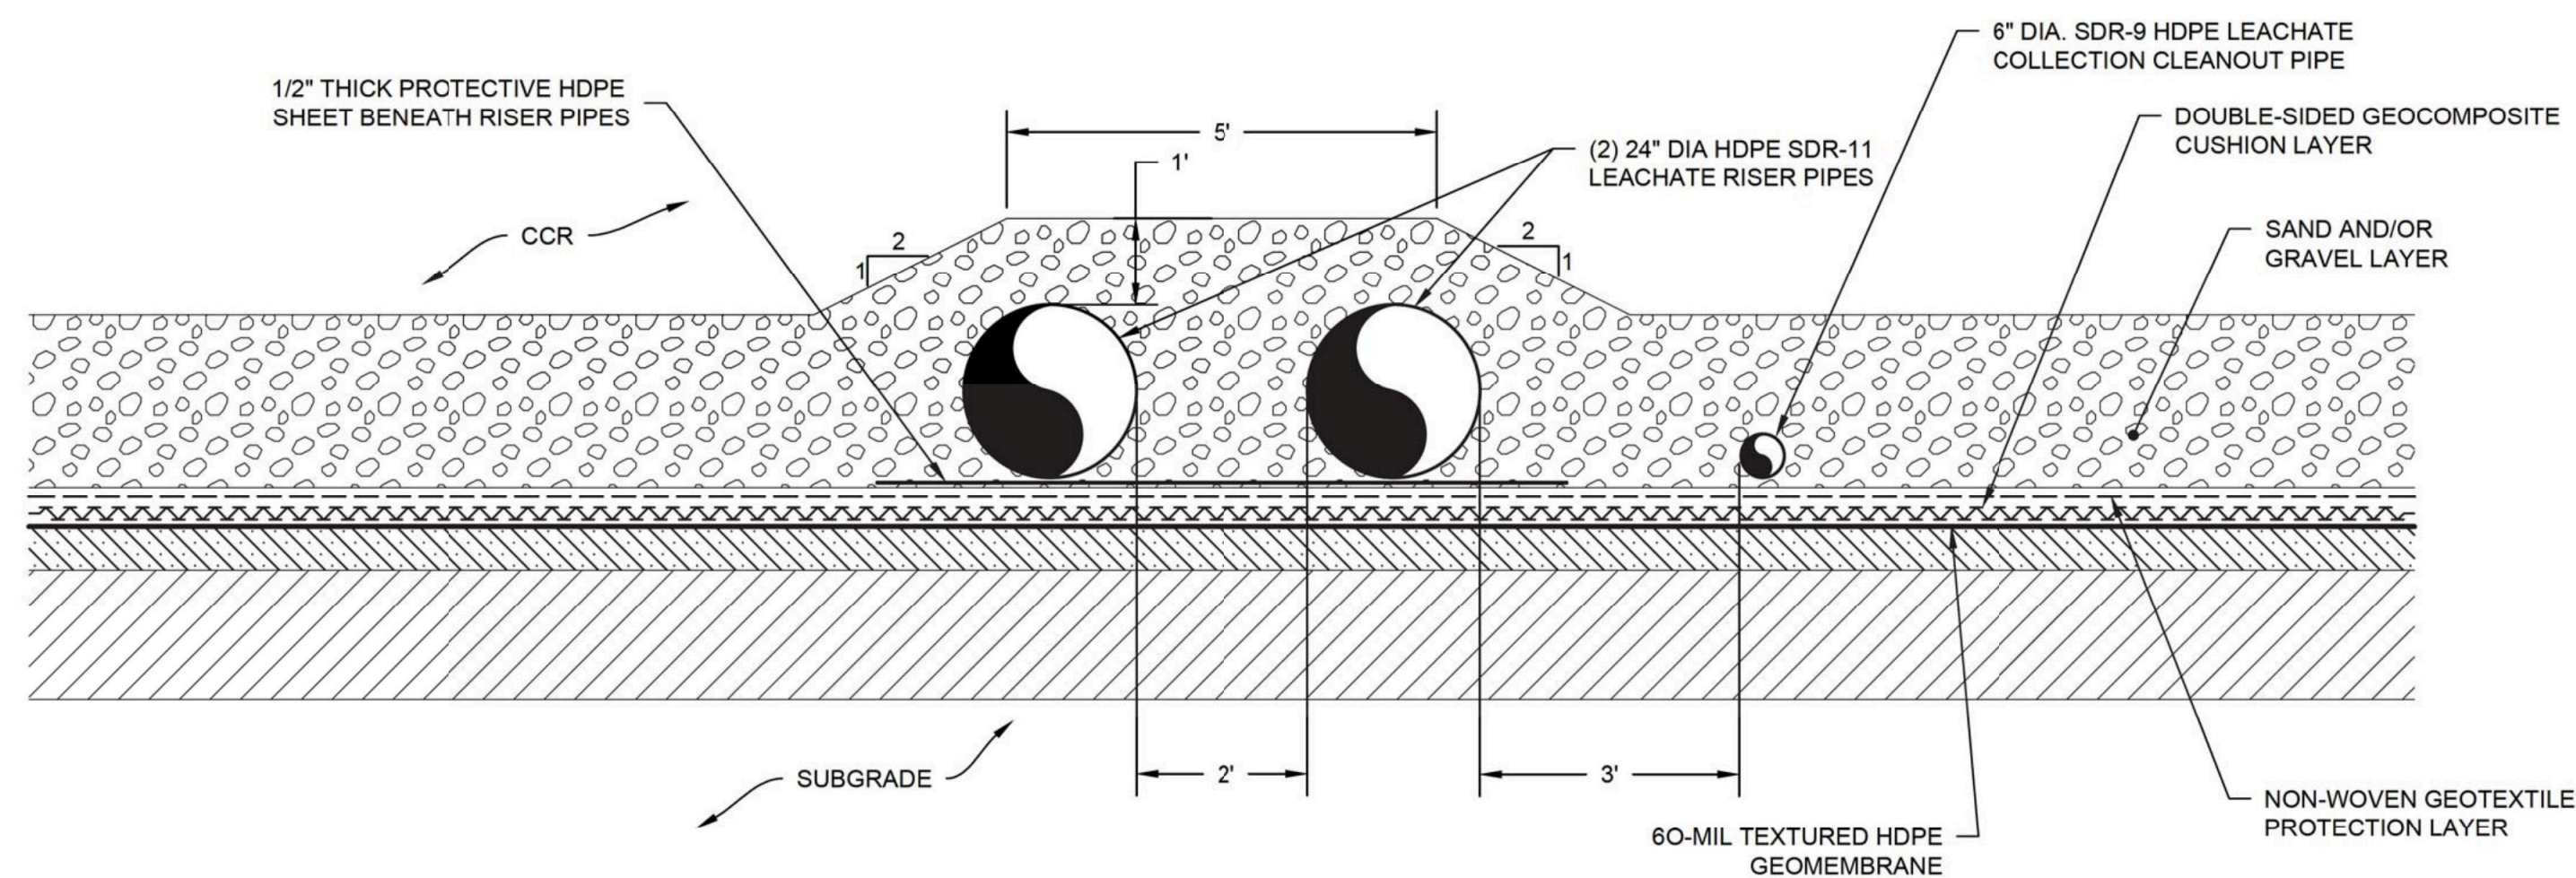

**C**  
**34** SECTION  
**SIDESLOPE LEACHATE RISER SYSTEM**  
SCALE: 1"=2'

NOTES:

- GEOSYNTHETIC LAYER THICKNESSES EXAGGERATED FOR CLARITY.
- GRADATION REQUIREMENTS AND OTHER MATERIAL PROPERTIES FOR SOIL LAYERS WILL BE PROVIDED IN TECHNICAL SPECIFICATIONS DEVELOPED FOR DETAILED DESIGN.
- DETAILS SHOWN ON THIS DRAWING REFLECT LINER SYSTEM OPTIONS AS INDICATED. IF ALTERNATIVE LINER SYSTEMS ARE USED, THE DESIGN APPROACH WILL REMAIN CONSISTENT WITH THIS DRAWING.




PERMIT DRAWING  
NOT FOR CONSTRUCTION




REV	DATE	DESCRIPTION	DRN	APP
0	AUG. 2021	SUBMITTAL TO GA EPD	JJ/VKH	RB
LEACHATE COLLECTION SYSTEM DETAILS II				
PLANT BOWEN ASH POND 1 (AP-1) CLOSURE DRAWINGS BARTOW COUNTY, GEORGIA				
<b>Geosyntec</b> consultants <small>1255 ROBERTS BOULEVARD, NW, SUITE 200 KENNESAW, GEORGIA 30144 USA</small> <small>PHONE: 678.202.9600 WWW.GEOSYNTEC.COM</small>				
PROJ. NO.	GR6601	DWG.	GR6601-037	EDIT
SCALE	AS SHOWN	DATE	AUGUST 2021	08.16.21
DRAWING				35 OF 50




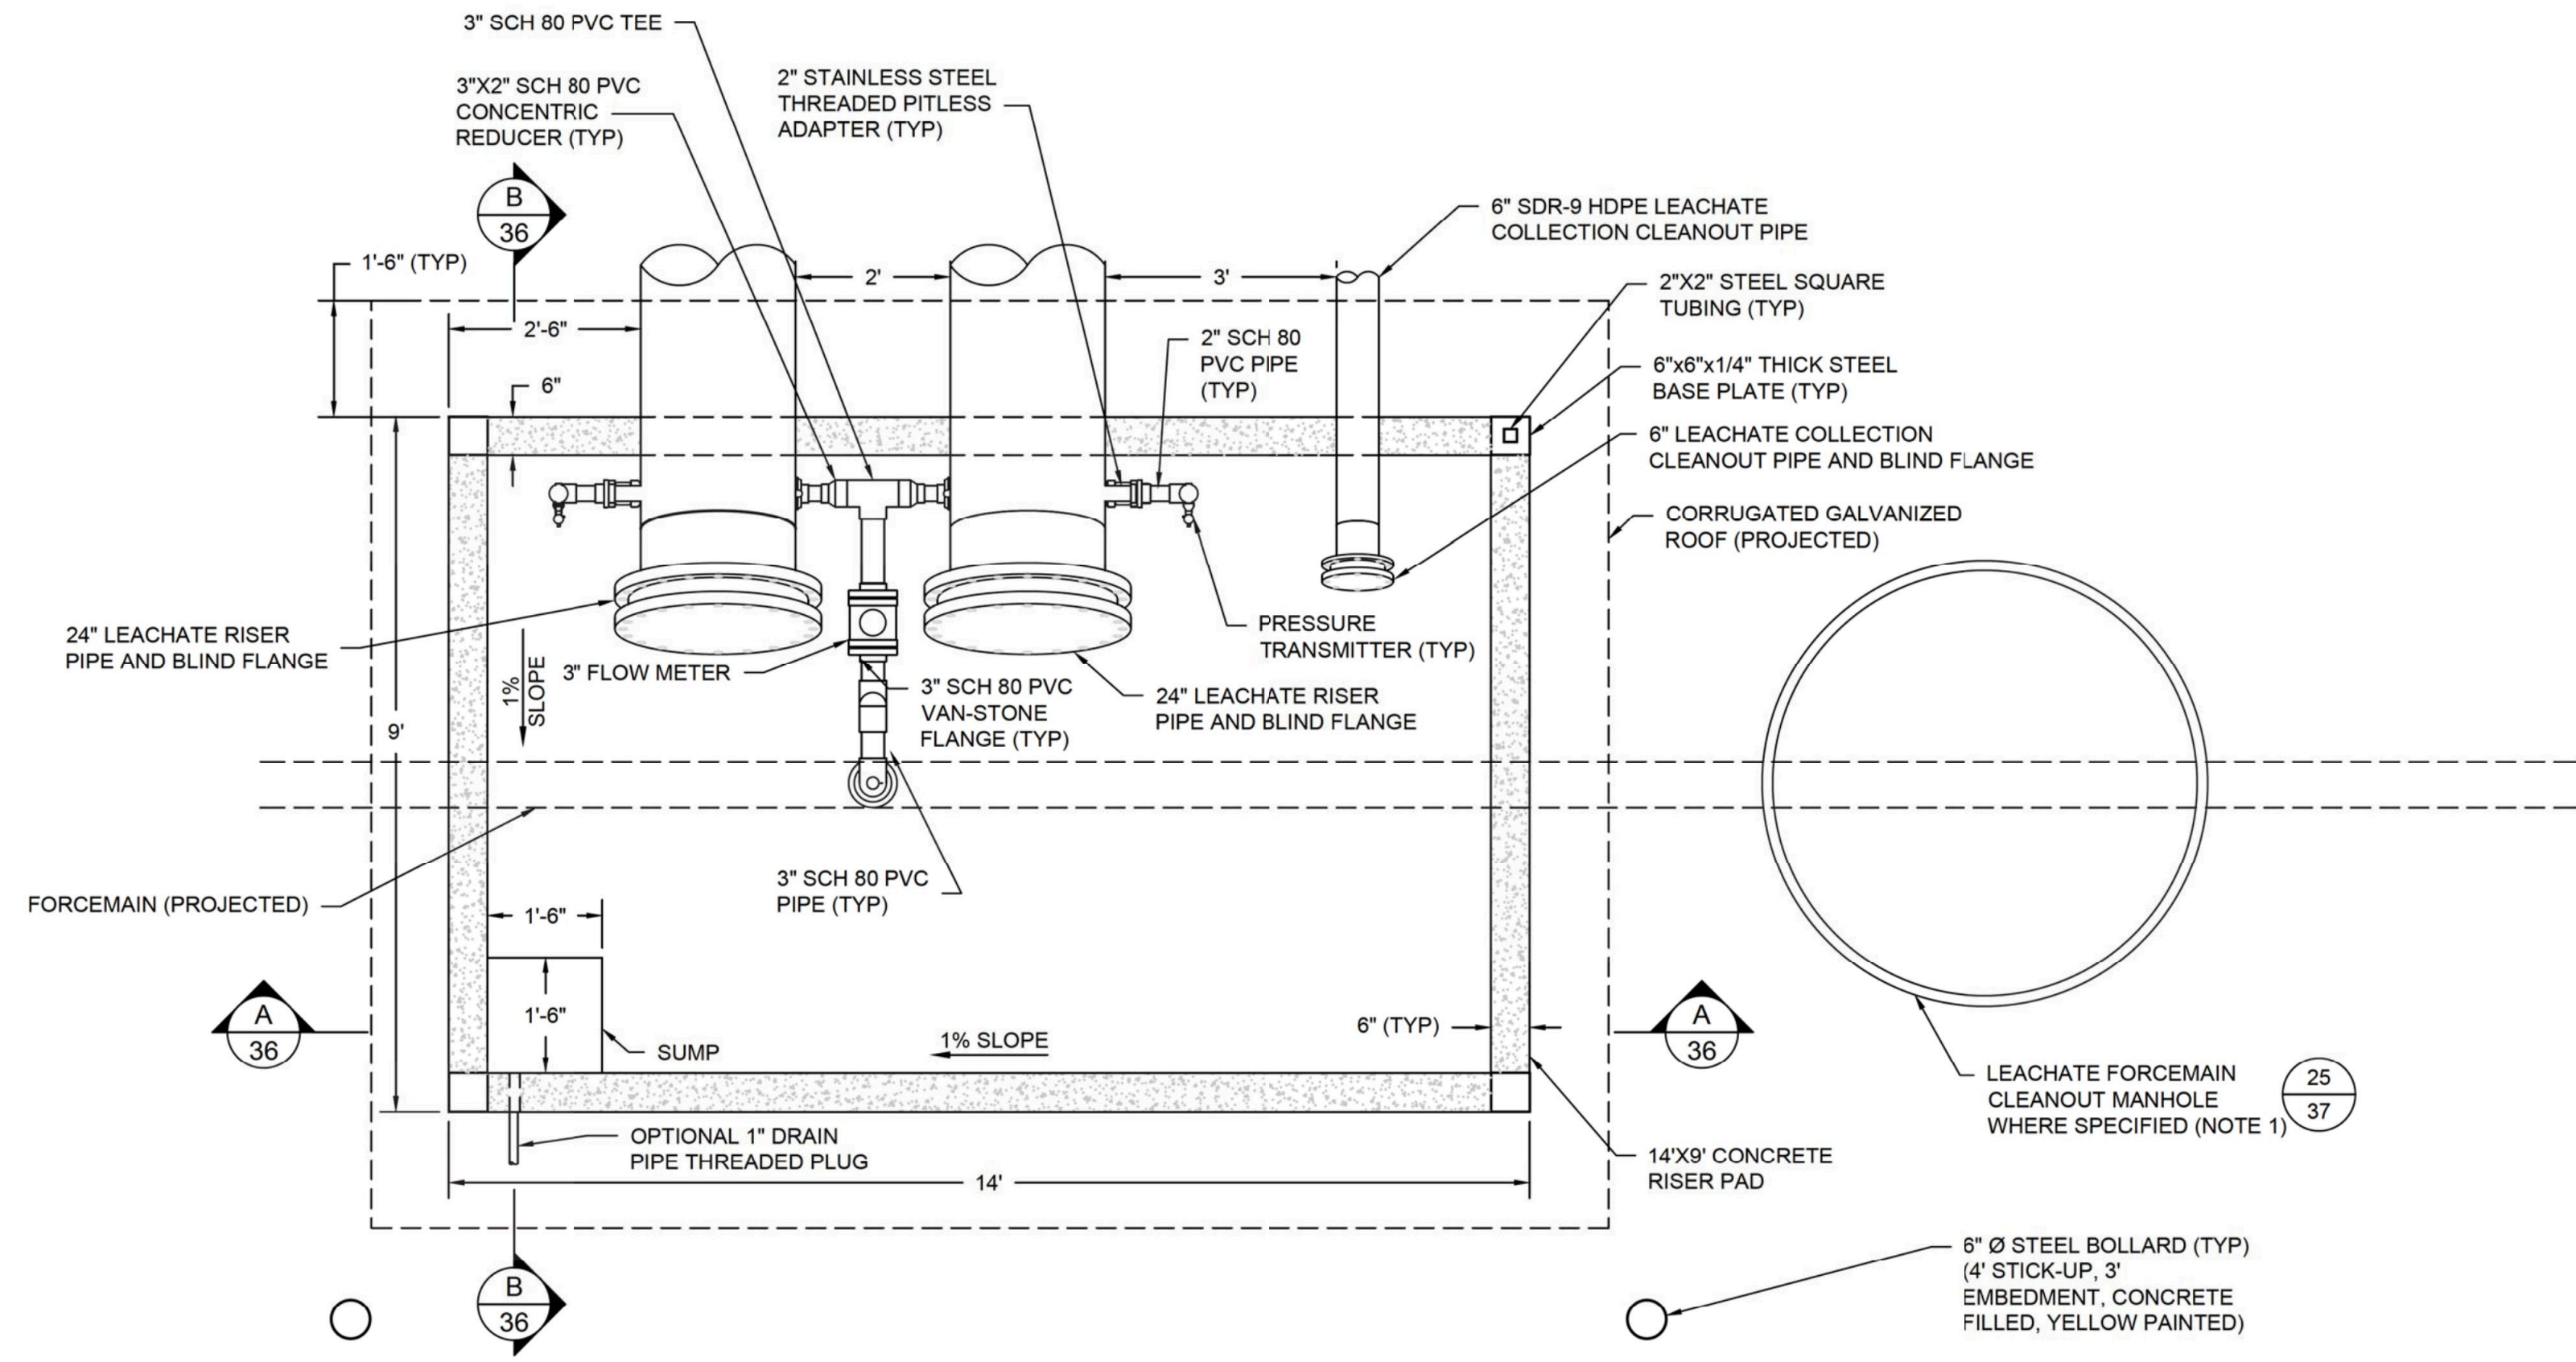

PLAN VIEW

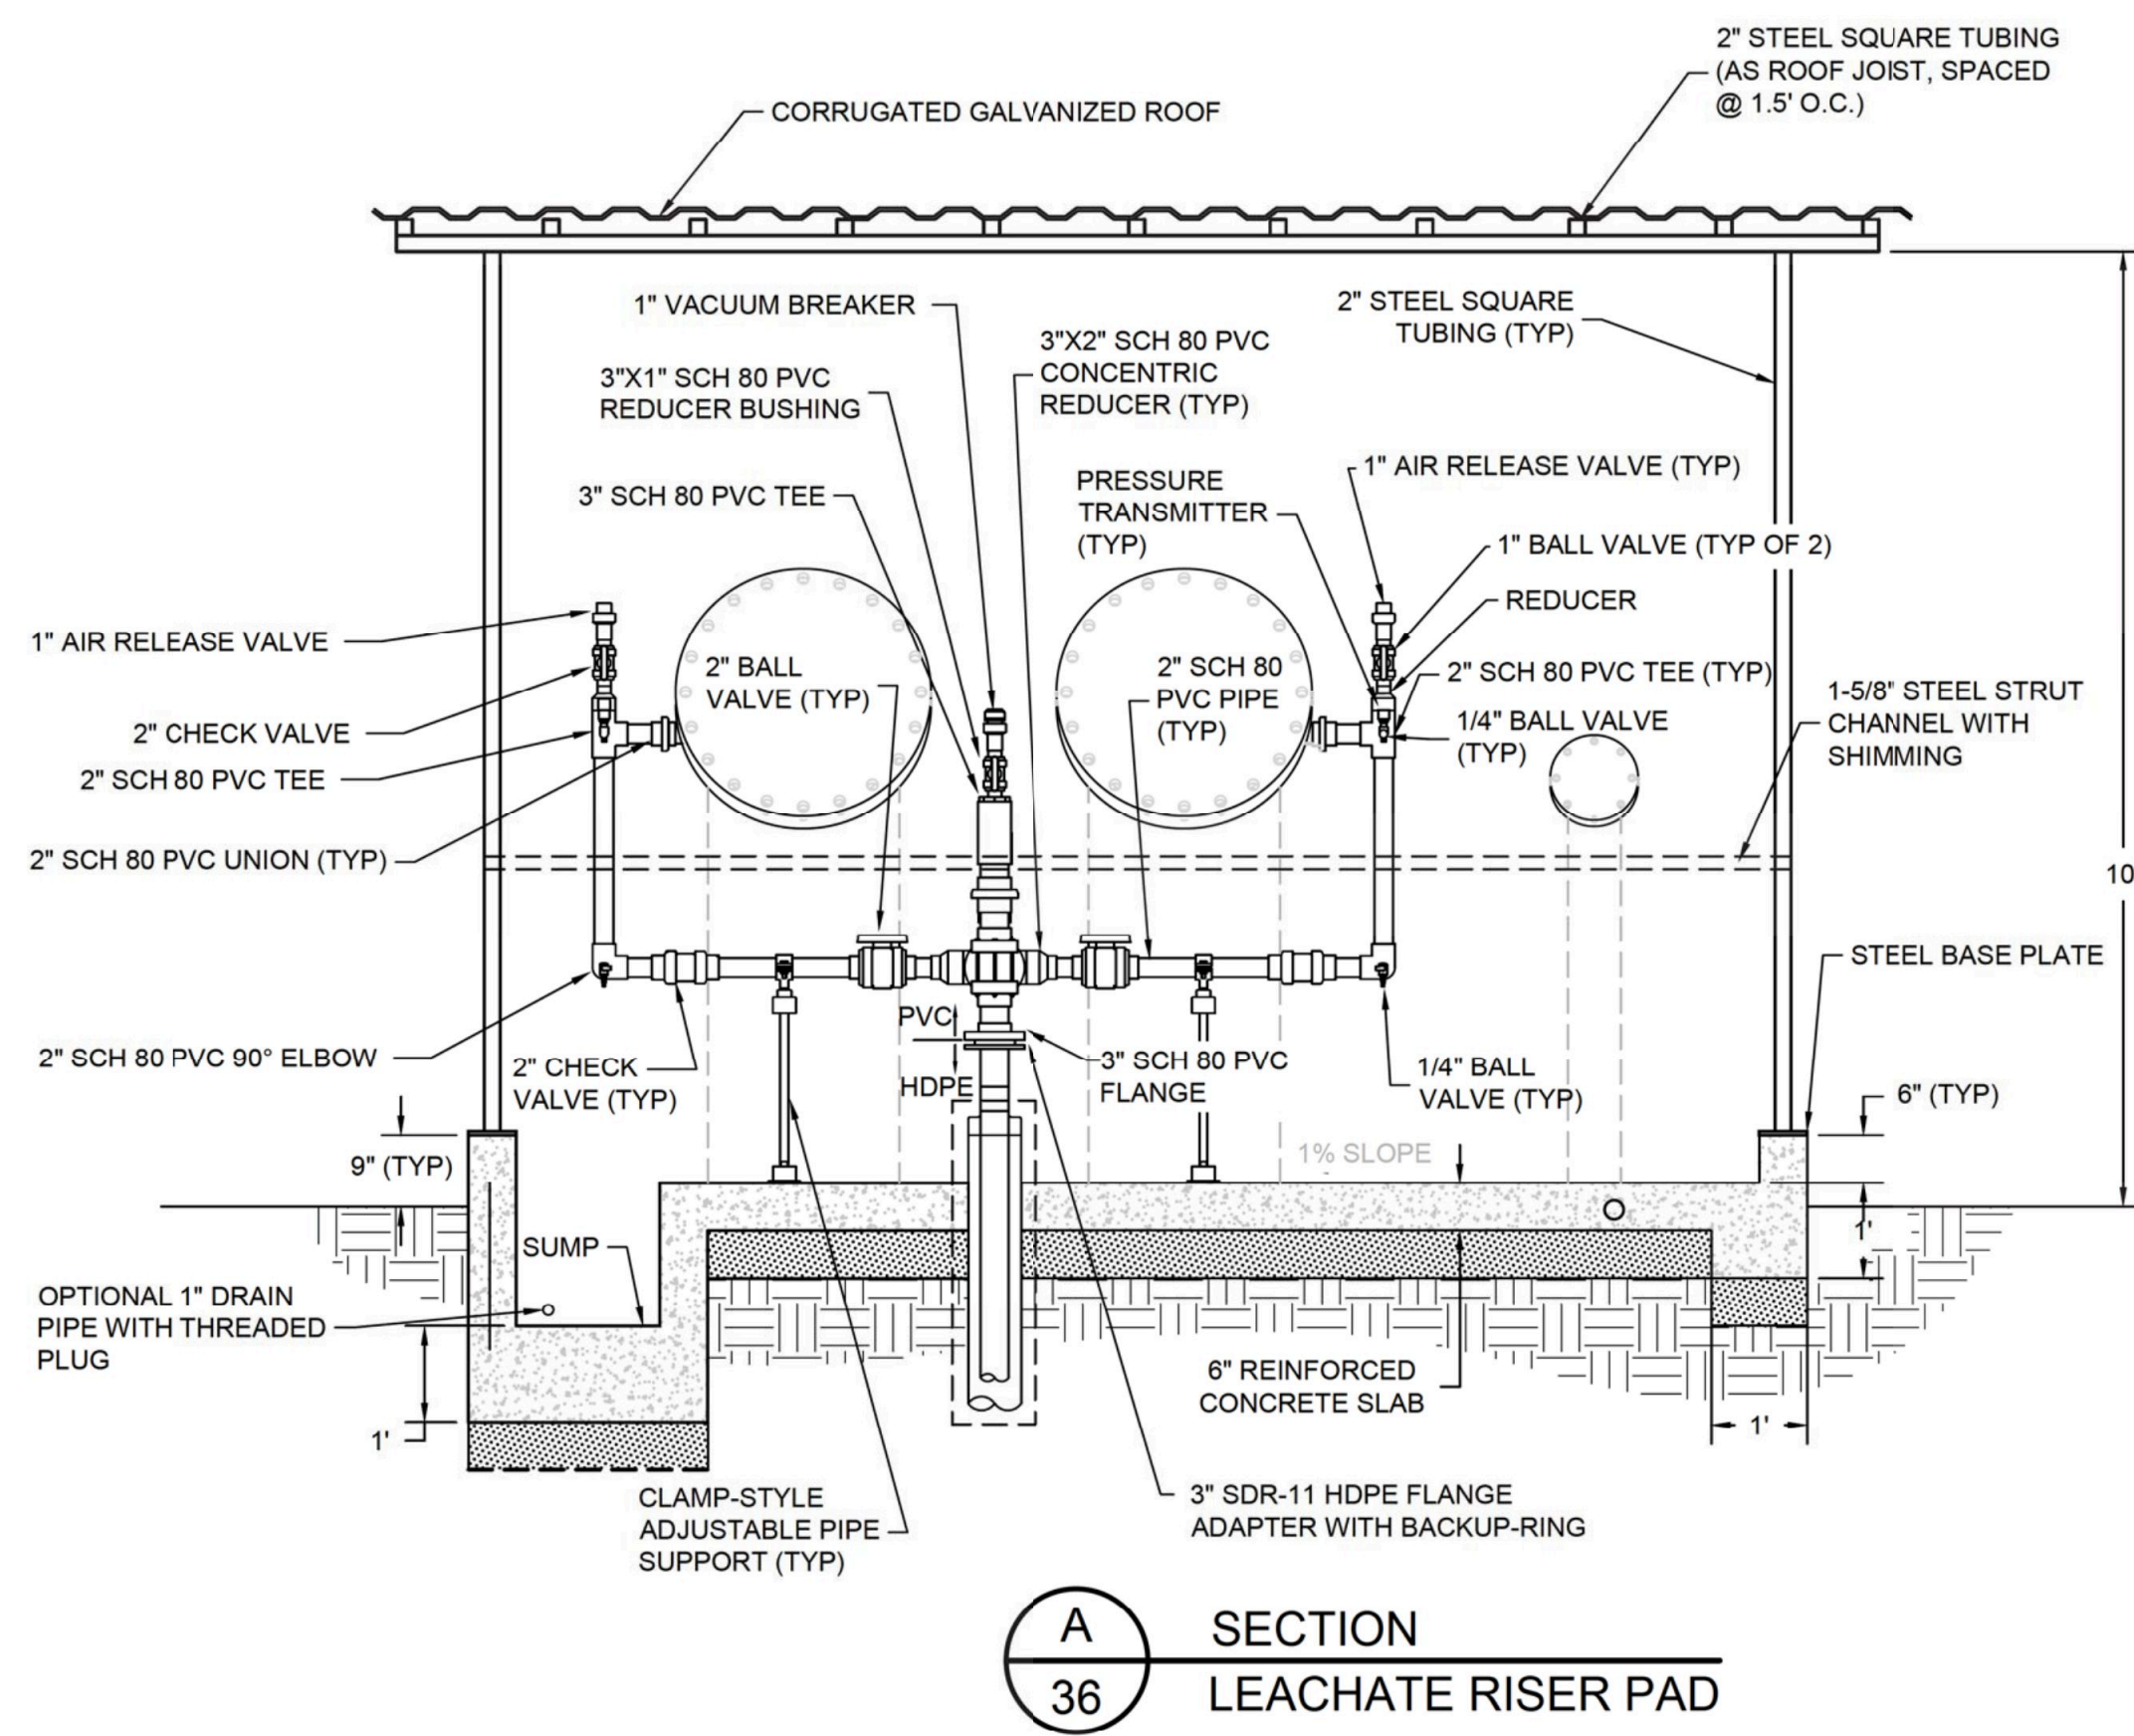

A  
36  
SECTION  
LEACHATE RISER PAD

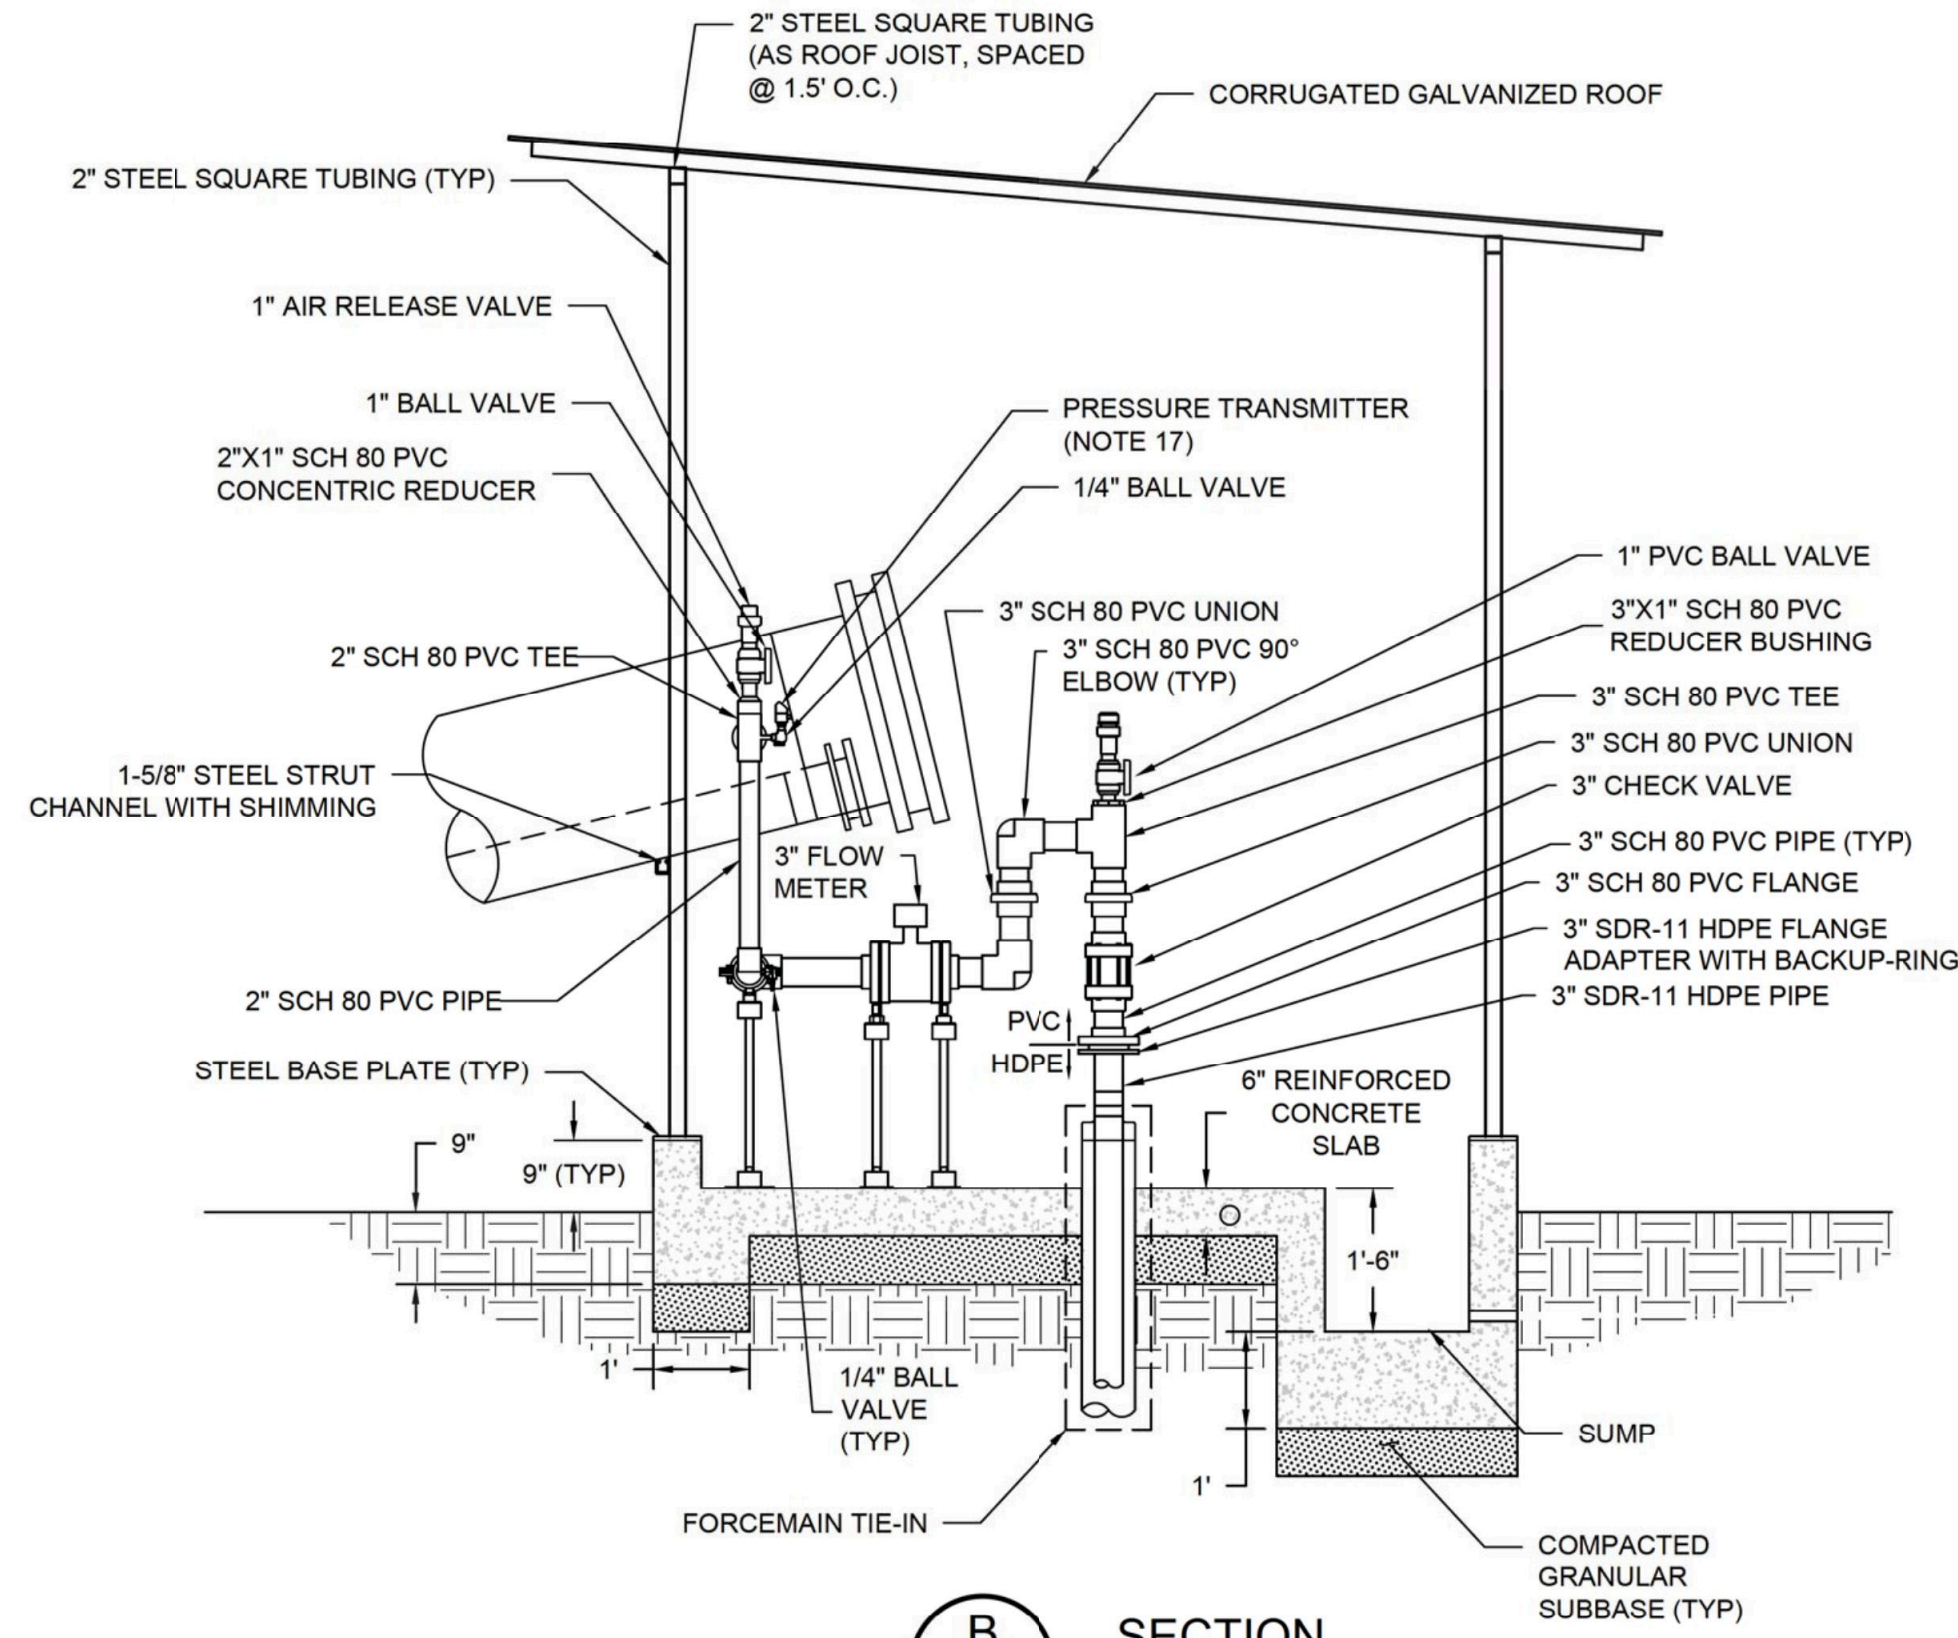

B  
36  
SECTION  
LEACHATE RISER PAD

- NOTE:
- CLEANOUT MANHOLES WILL BE USED AT RISER PAD AREA OF CELLS 1A,4A,4B, AND 7A. ADDITIONAL CLEANOUTS MAY BE ADDED AS NEEDED. CLEANOUT MANHOLES MAY BE INSTALLED WITHIN RISER PADS, OR NEXT TO RISER PADS AS SHOWN.
  - PIPING AND VALVES ARE CONCEPTUAL TO ILLUSTRATE INTENDED FUNCTIONALITY AND MAY BE REVISED DURING DETAILED DESIGN.

22  
33  
DETAIL  
LEACHATE RISER PAD  
SCALE: NOT TO SCALE




**Georgia Power**  
PERMIT DRAWING  
NOT FOR CONSTRUCTION


0	AUG. 2021	SUBMITTAL TO GA EPD		JJV/KH	RB
REV	DATE	DESCRIPTION		DRN	APP
LEACHATE COLLECTION SYSTEM DETAILS III					
PLANT BOWEN ASH POND 1 (AP-1) CLOSURE DRAWINGS BARTOW COUNTY, GEORGIA					
<div>Geosyntec consultants</div> <div>1255 ROBERTS BOULEVARD, NW, SUITE 200 KENNESAW, GEORGIA 30144 USA</div> <div>PHONE: 678.202.9500 WWW.GEOSYNTEC.COM</div>					
PROJ. NO.		GR6601		DWG.	GR6601-038
SCALE		AS SHOWN		EDIT	08.16.21
DATE		AUGUST 2021		DRAWING 36 OF 50	

P:\CAD\PROJECTS\GEORGIA POWER\BOWEN POWER PLANT\TIE-IN\ASH POND CLOSURE (GR6601)\DRAWINGS\GR6601-038




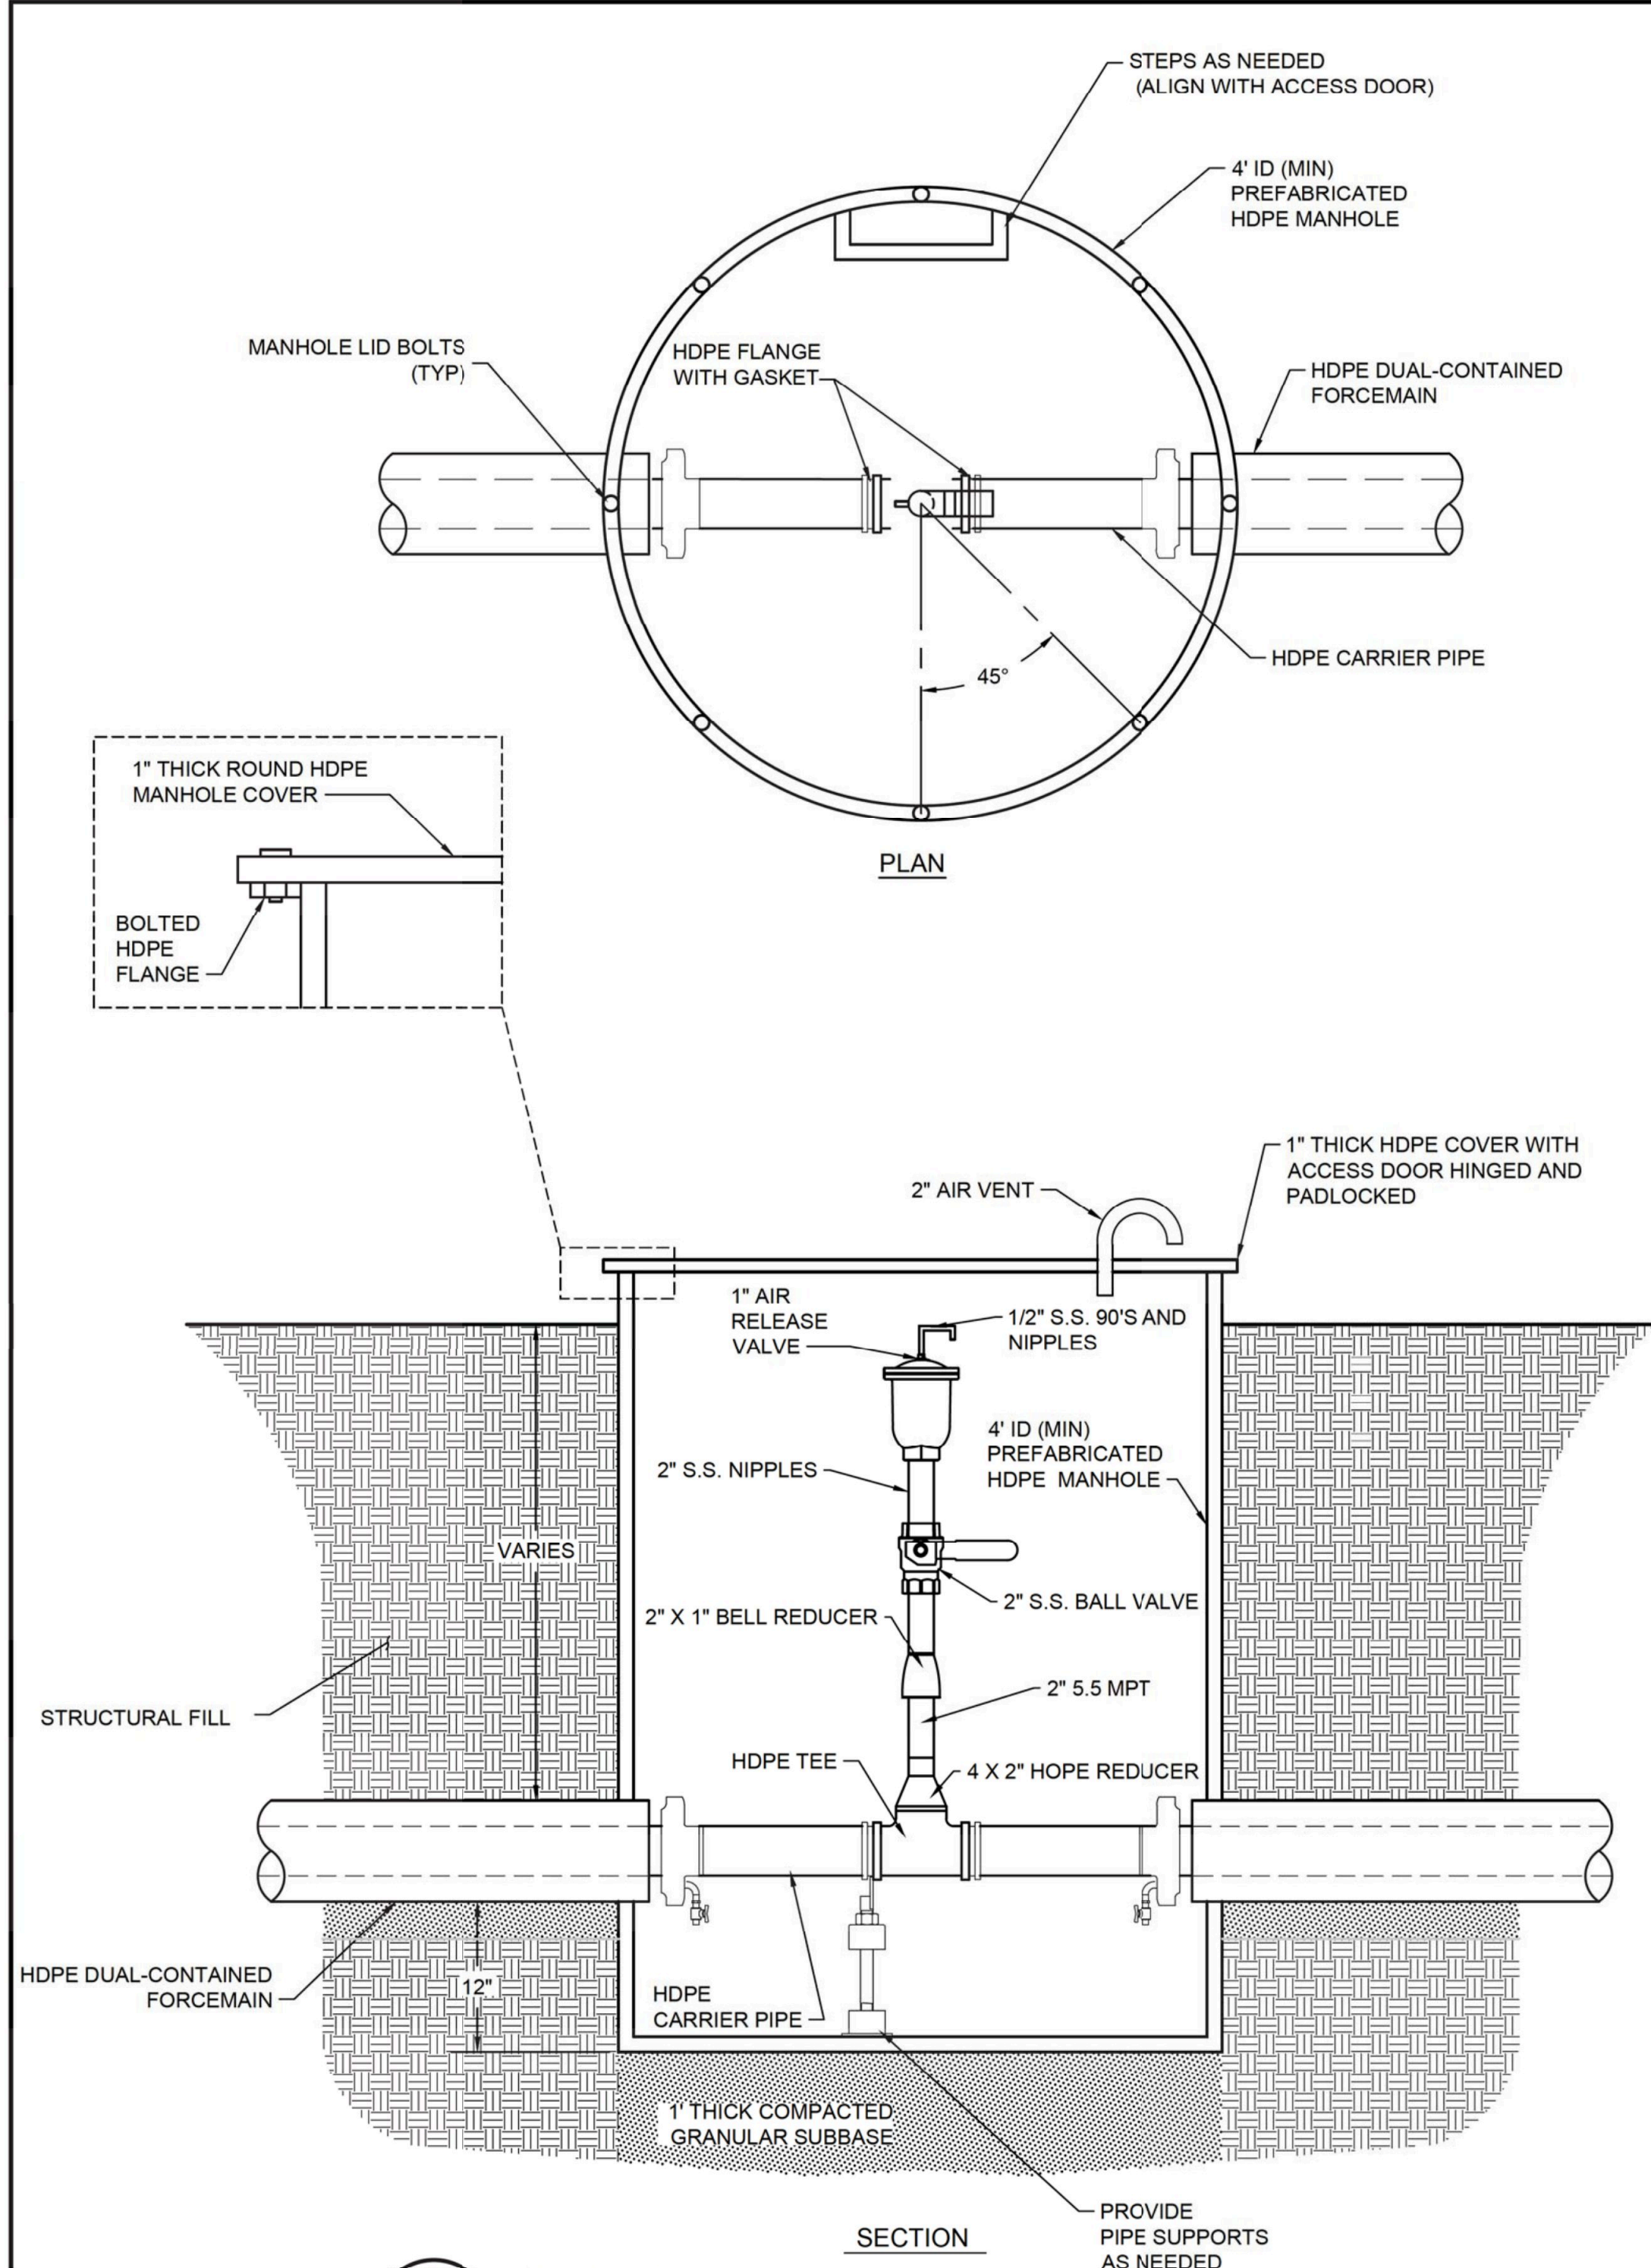

**23** **DETAIL**  
**33** **LEACHATE FORCEMAIN AIR RELEASE MANHOLE**  
SCALE: NTS

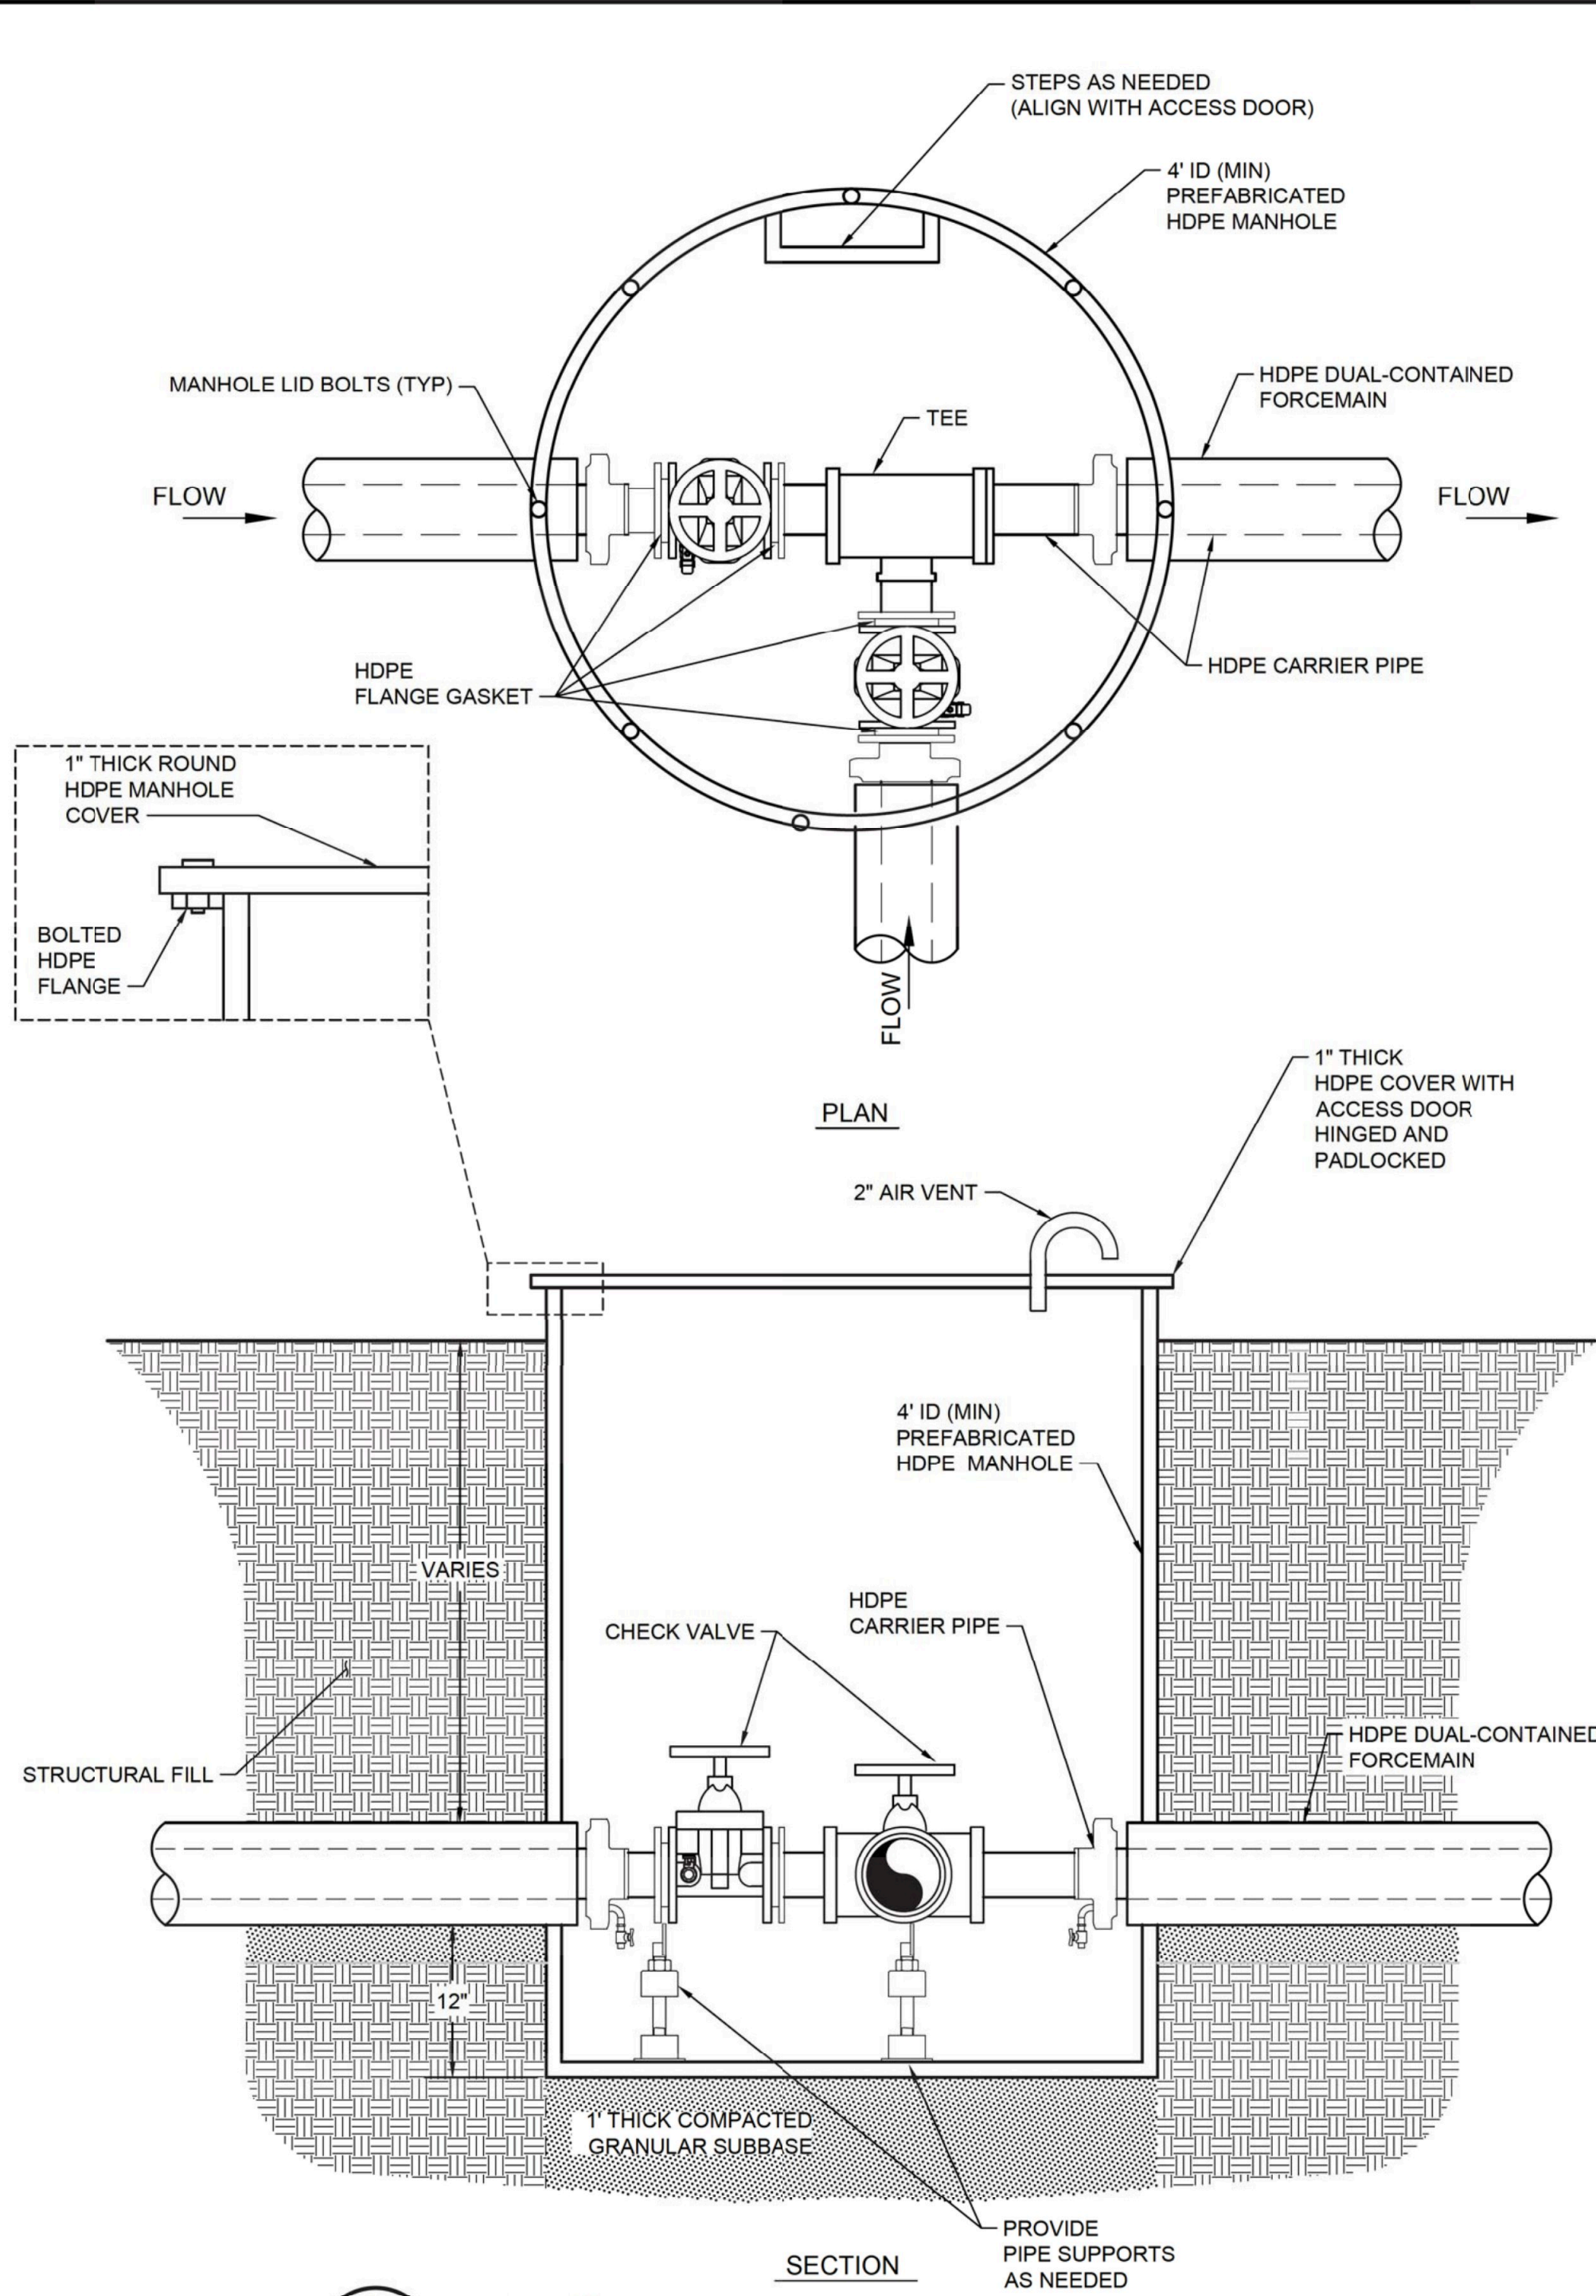


**24** **DETAIL**  
**33** **LEACHATE FORCEMAIN JUNCTION MANHOLE**  
SCALE: NTS

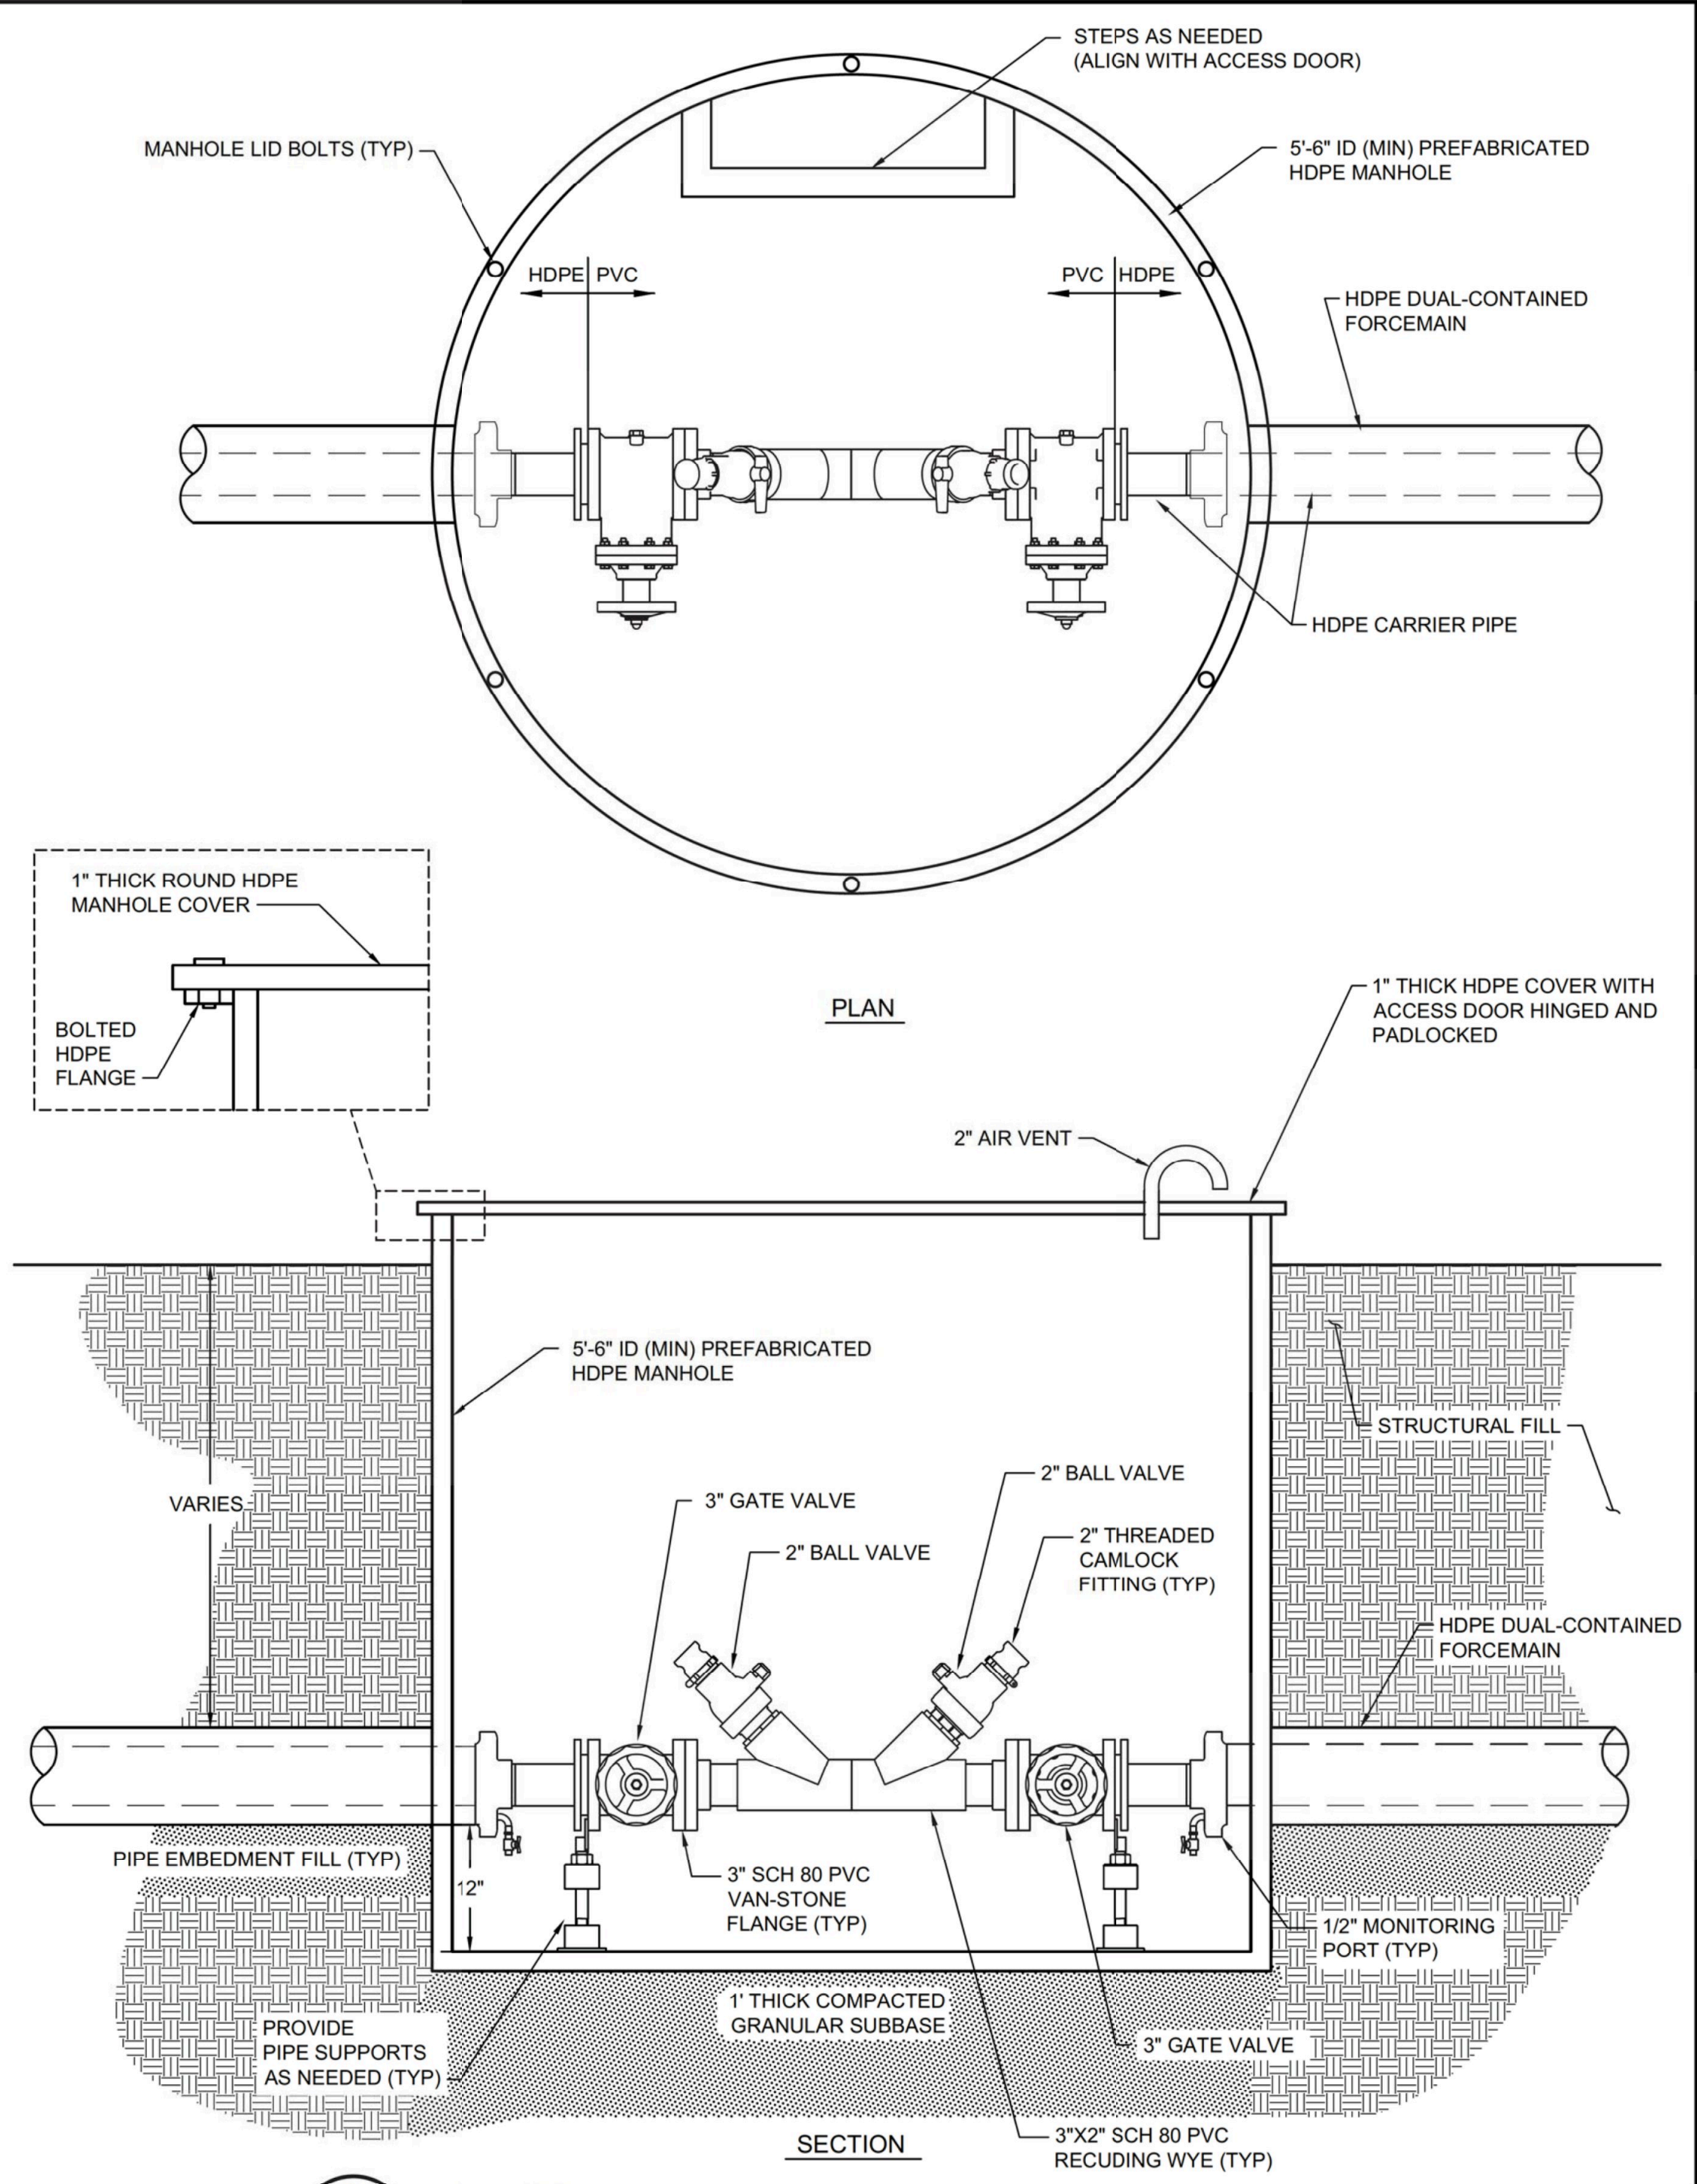

**25** **DETAIL**  
**36** **LEACHATE FORCEMAIN CLEANOUT MANHOLE**  
SCALE: NTS

NOTE:  
1. PIPING AND VALVES ARE CONCEPTUAL TO ILLUSTRATE INTENDED FUNCTIONALITY AND MAY BE REVISED DURING DETAILED DESIGN.

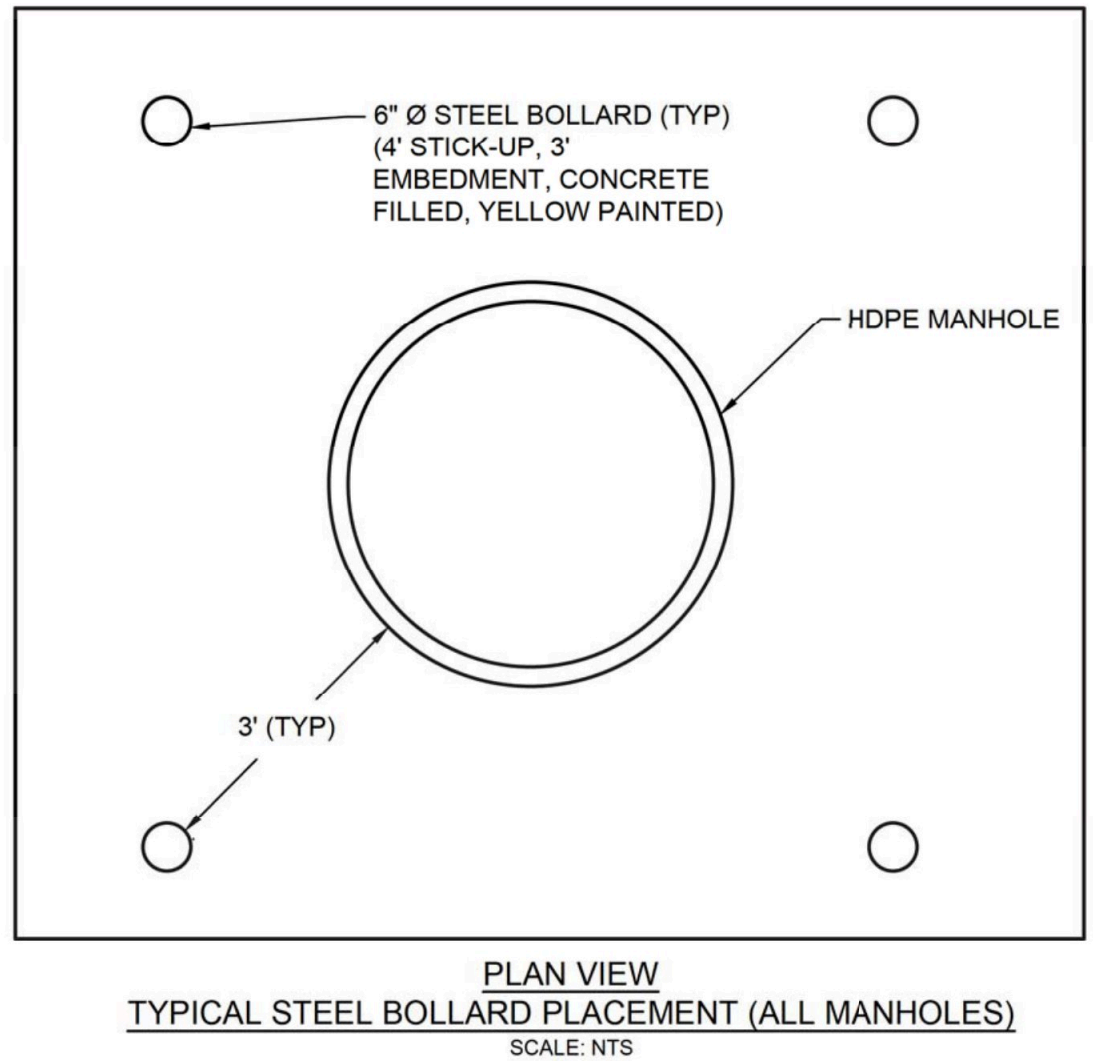


PERMIT DRAWING  
NOT FOR CONSTRUCTION

0	AUG. 2021	SUBMITTAL TO GA EPD	JJ/VKH	RB
REV	DATE	DESCRIPTION	DRN	APP
LEACHATE COLLECTION SYSTEM DETAILS IV				
PLANT BOWEN ASH POND 1 (AP-1) CLOSURE DRAWINGS BARTOW COUNTY, GEORGIA				
<b>Geosyntec</b> consultants <small>1255 ROBERTS BOULEVARD, NW, SUITE 200 KENNESAW, GEORGIA 30144 USA</small>				
PROJ. NO.	GR6601	DWG.	GR6601-039	EDIT 08.16.21
SCALE	AS SHOWN	DRAWING 37 OF 50		
DATE	AUGUST 2021			
		PHONE: 678.202.9600 WWW.GEOSYNTEC.COM		





LEGEND	
	FINISHED GROUND ELEVATION (FEET) (NOTE 1)
	FINAL COVER TOP DECK DIVERSION BERM
	FINAL COVER TOP DECK LET-DOWN CHANNEL
	FINAL COVER DOWNCHUTE CHANNEL
	FINAL COVER SIDESLOPE DRAINAGE BENCH
	STORMWATER CHANNEL
	LINED STORMWATER POND

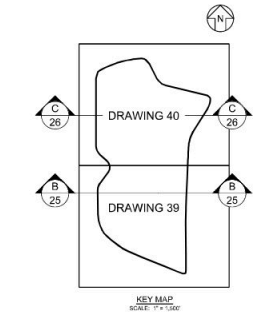

- NOTES
- SEE DRAWING 2 FOR LEGENDS, ABBREVIATIONS, AND GENERAL SITE NOTES.
  - FINAL CLOSURE GRADES SHOWN ON THIS DRAWING REPRESENT THE TOP OF THE FINAL COVER SYSTEM (SOIL-GEOSYNTHETIC COMPOSITE COVER) WITHIN THE FINAL COVER LIMITS. BEYOND THE FINAL COVER LIMITS, PROPOSED FINISHED GRADES ARE SHOWN, WHICH TIE-IN TO EXISTING GROUND TOPOGRAPHY AT THE LIMIT OF DISTURBANCE. SEE DRAWING 2, GENERAL SITE NOTE 15.
  - IN ADDITION TO PERMANENT STORMWATER PONDS SHOWN, TEMPORARY LINED STORMWATER PONDS WILL BE UTILIZED DURING CONSTRUCTION AS NEEDED.





PERMIT DRAWING  
NOT FOR CONSTRUCTION

1	MAY 2024	UPDATE AND ADD GAS PIPELINES	JZV	RSB
2	AUG 2021	SUBMITTAL TO GA EPD	JAN/18	RSB
REV	DATE	DESCRIPTION	DRN	APP
STORMWATER MANAGEMENT SYSTEM - OVERVIEW				
PLANT BOWEN ASH POND 1 (AP-1) CLOSURE DRAWINGS BARTOW COUNTY, GEORGIA				
<b>Geosyntec</b> consultants				
<small>1305 ROBERTS ROAD, SUITE 200, KENNESAW, GEORGIA 30144 USA</small>				
<small>PROJECT NO. GR6601</small>		<small>DWG. GR6601-040</small>		<small>EDIT 5/23/224</small>
<small>SCALE 1" = 300'</small>		<small>DATE AUGUST 2021</small>		
				<small>PHONE: 478.302.9500 WWW.GEOSYNTEC.COM</small>
		DRAWING 38 OF 50		



MATCHLINE SHEET 40

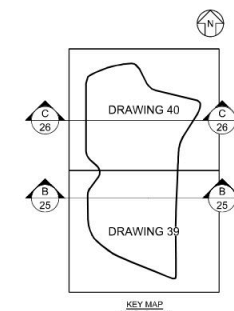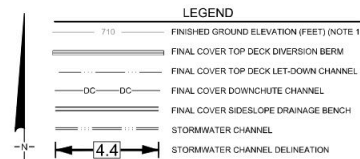

- NOTES:
- SEE DRAWING 2 FOR LEGENDS, ABBREVIATIONS, AND GENERAL SITE NOTES.
  - FINAL CLOSURE GRADES SHOWN ON THIS DRAWING REPRESENT THE TOP OF THE FINAL COVER SYSTEM (SOIL-GEO SYNTHETIC COMPOSITE COVERS WITHIN THE FINAL COVER LIMITS. BEYOND THE FINAL COVER LIMITS, PROPOSED FINISHED GRADES ARE SHOWN, WHICH TIE-IN TO EXISTING GROUND TOPOGRAPHY AT THE LIMIT OF DISTURBANCE. SEE DRAWING 2, GENERAL SITE NOTE 19.
  - IN ADDITION TO PERMANENT STORMWATER PONDS SHOWN, TEMPORARY LINED STORMWATER PONDS WILL BE UTILIZED DURING CONSTRUCTION AS NEEDED.






1	MAY 2024	UPDATE AND ADD GAS PIPELINES	JDV	RSB		
9	AUG 2021	SUBMITTAL TO GA EPD	JAN/H	RSB		
REV	DATE	DESCRIPTION	DRN	APP		
STORMWATER MANAGEMENT SYSTEM - SOUTH AP-1						
PLANT BOWEN ASH POND 1 (AP-1) CLOSURE DRAWINGS BARTOW COUNTY, GEORGIA						
<div>Geosyntec<sup>®</sup> consultants</div>						
1305 ROBERTS ROAD, SUITE 200 KENNESAW, GEORGIA 30144 USA			PHONE: 478.202.9500 www.geosyntec.com			
PROJ. NO.		GR6601	DWG.	GR6601-041	EDIT	5/23/24
SCALE		1" = 150'				
DATE		AUGUST 2021				
		DRAWING 39 OF 50				



**Georgia Power**  
PERMIT DRAWING  
NOT FOR CONSTRUCTION



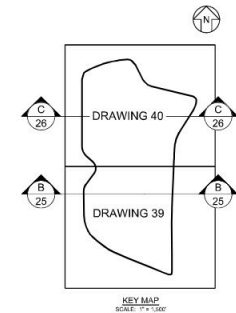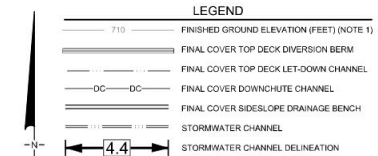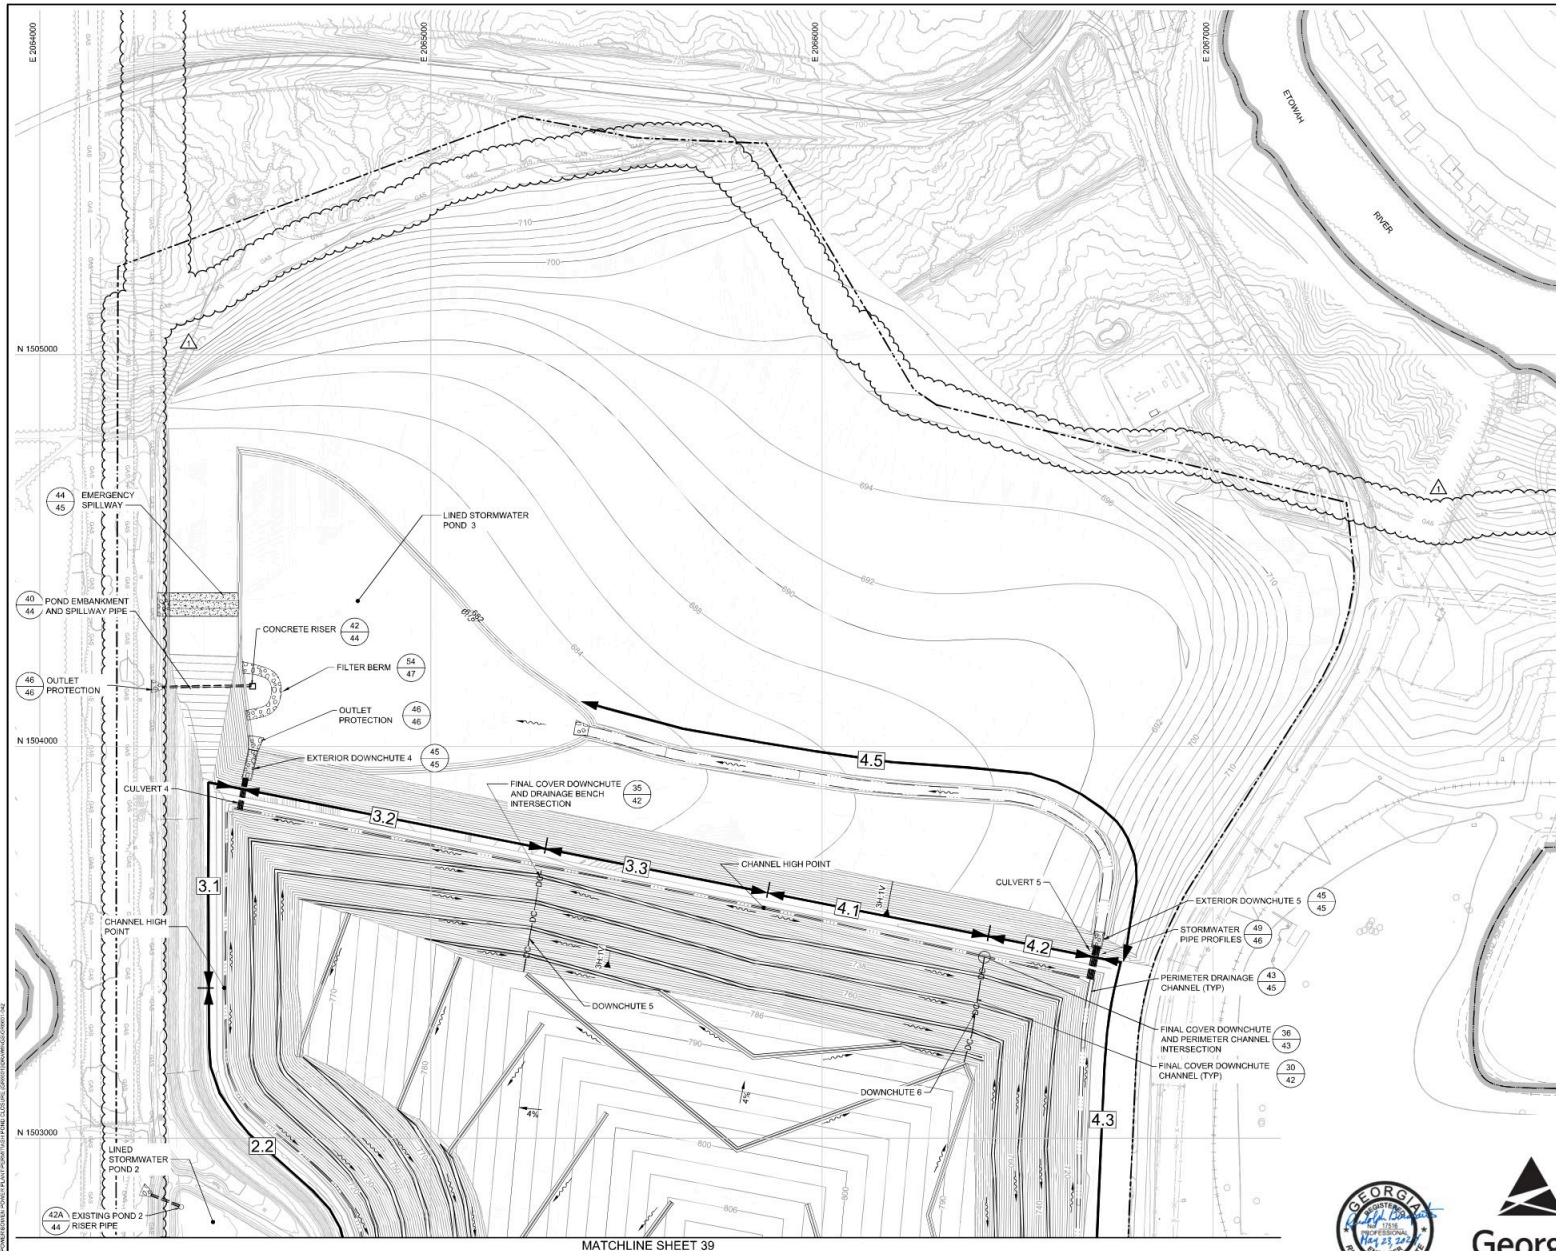


- NOTES:**
- SEE DRAWING 2 FOR LEGENDS, ABBREVIATIONS, AND GENERAL SITE NOTES.
  - FINAL CLOSURE GRADES SHOWN ON THIS DRAWING REPRESENT THE TOP OF THE FINAL COVER SYSTEM (SOIL-GEOSYNTHETIC COMPOSITE) COVERED WITHIN THE FINAL COVER LIMITS. BEYOND THE FINAL COVER LIMITS, PROPOSED FINISHED GRADES ARE SHOWN, WHICH TIE-IN TO EXISTING GROUND TOPOGRAPHY AT THE LIMIT OF DISTURBANCE. SEE DRAWING 2, GENERAL SITE NOTE 19.
  - IN ADDITION TO PERMANENT STORMWATER PONDS SHOWN, TEMPORARY LINED STORMWATER PONDS WILL BE UTILIZED DURING CONSTRUCTION AS NEEDED.



PERMIT DRAWING  
NOT FOR CONSTRUCTION


1	MAY 2024	UPDATE AND ADD GAS PIPELINES	JZV	RSB
2	AUG 2021	SUBMITTAL TO GA EPD	JAV/HH	RSB
REV	DATE	DESCRIPTION	DRN	APP
STORMWATER MANAGEMENT SYSTEM - NORTH AP-1				
PLANT BOWEN ASH POND 1 (AP-1) CLOSURE DRAWINGS BARTOW COUNTY, GEORGIA				
<b>Geosyntec</b> consultants				
<small>1305 ROBERTS ROAD, SUITE 200, KENNESAW, GEORGIA 30144 USA            PROJ. NO. GR6601 DWG. GR6601-042 EDIT 5/23/24            SCALE 1" = 150' DATE AUGUST 2021            PHONE: 478.202.9500            WWW.GEOSYNTEC.COM</small>				
DRAWING 40 OF 50				



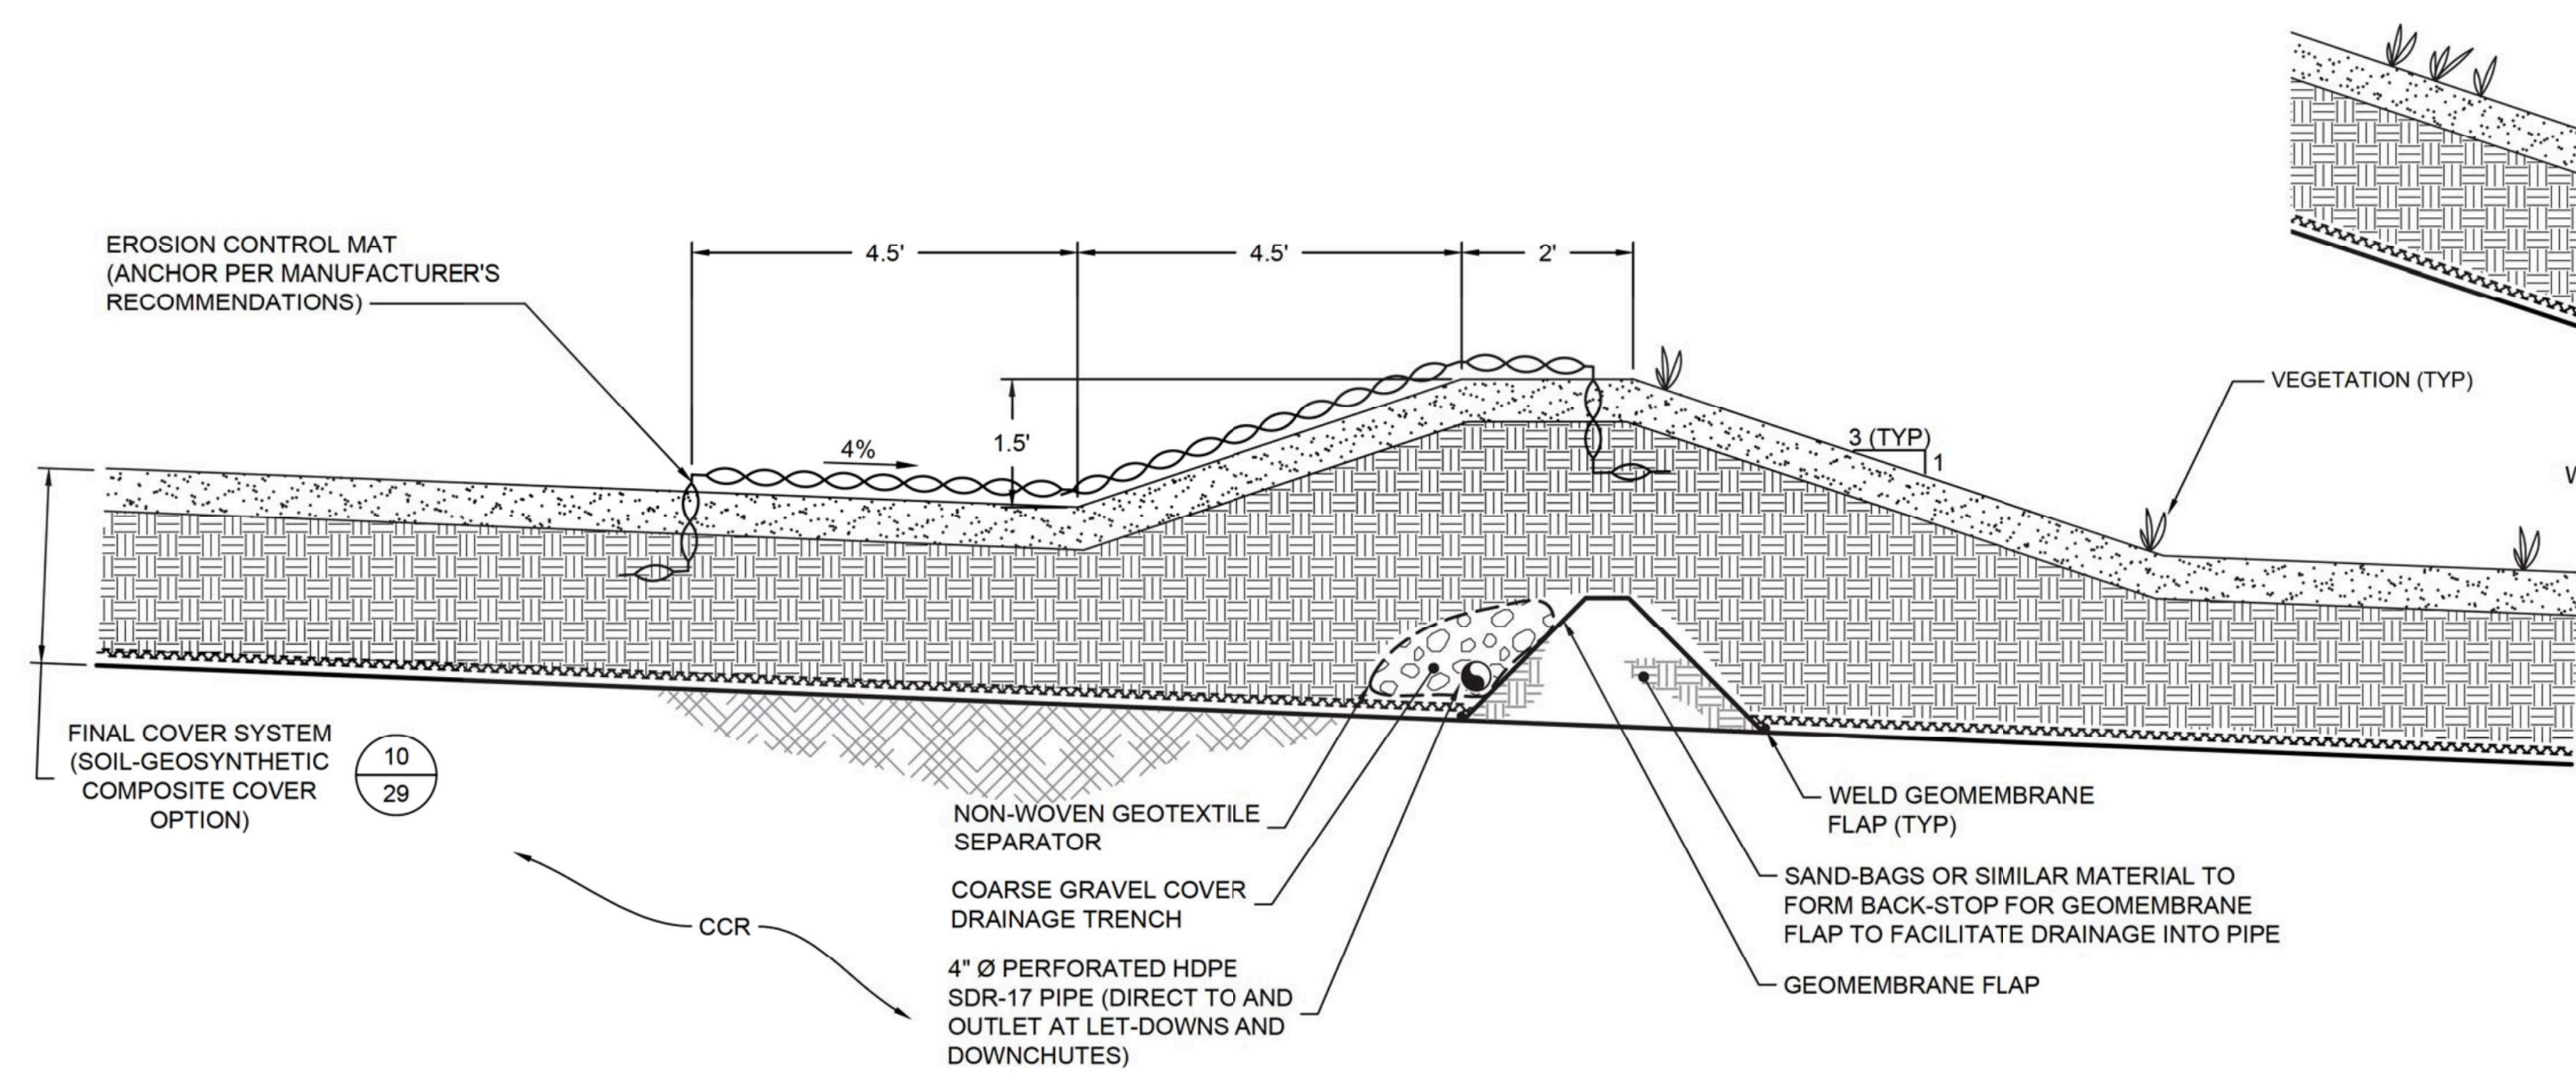


26  
38  
DETAIL  
FINAL COVER TOP DECK DIVERSION BERM

0 2 4  
SCALE IN FEET

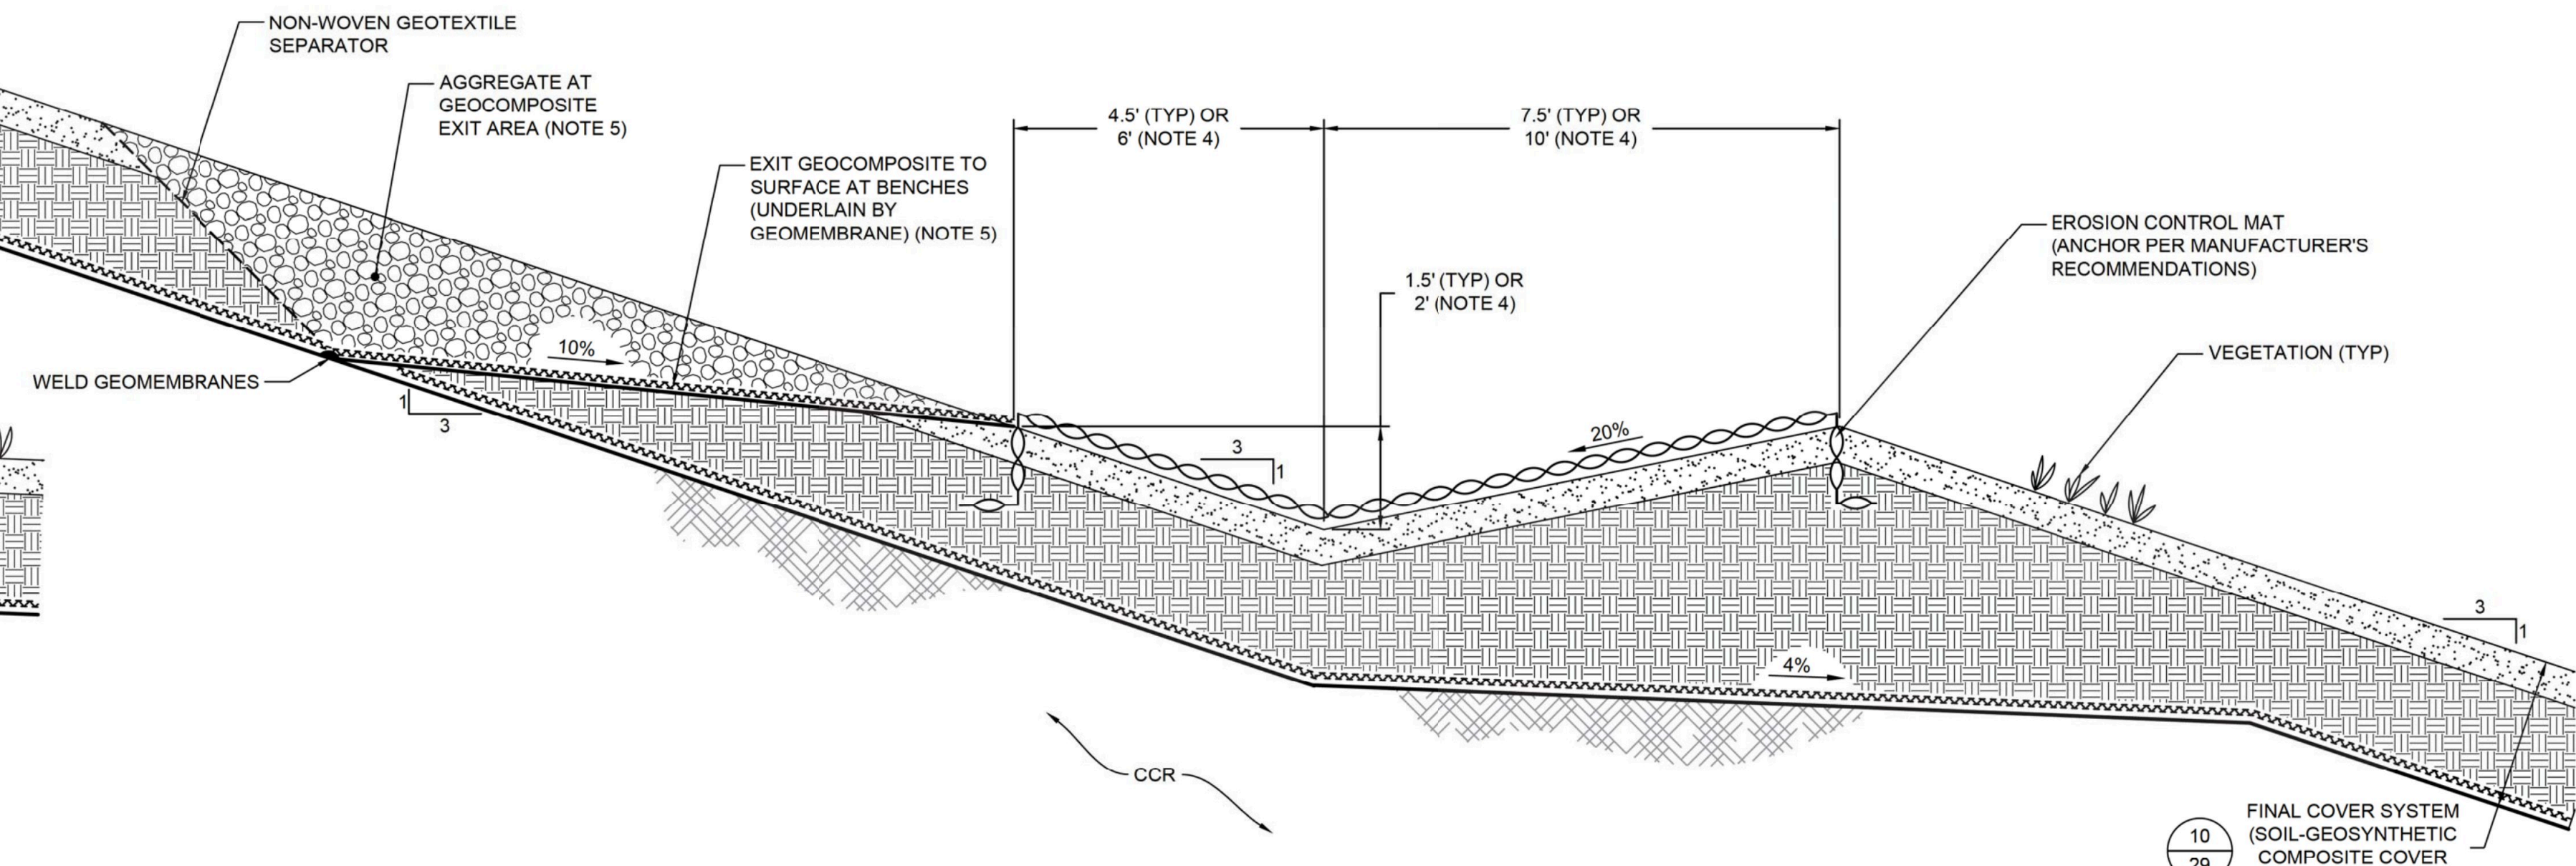


27  
38  
DETAIL  
FINAL COVER SIDESLOPE DRAINAGE BENCH

0 2 4  
SCALE IN FEET

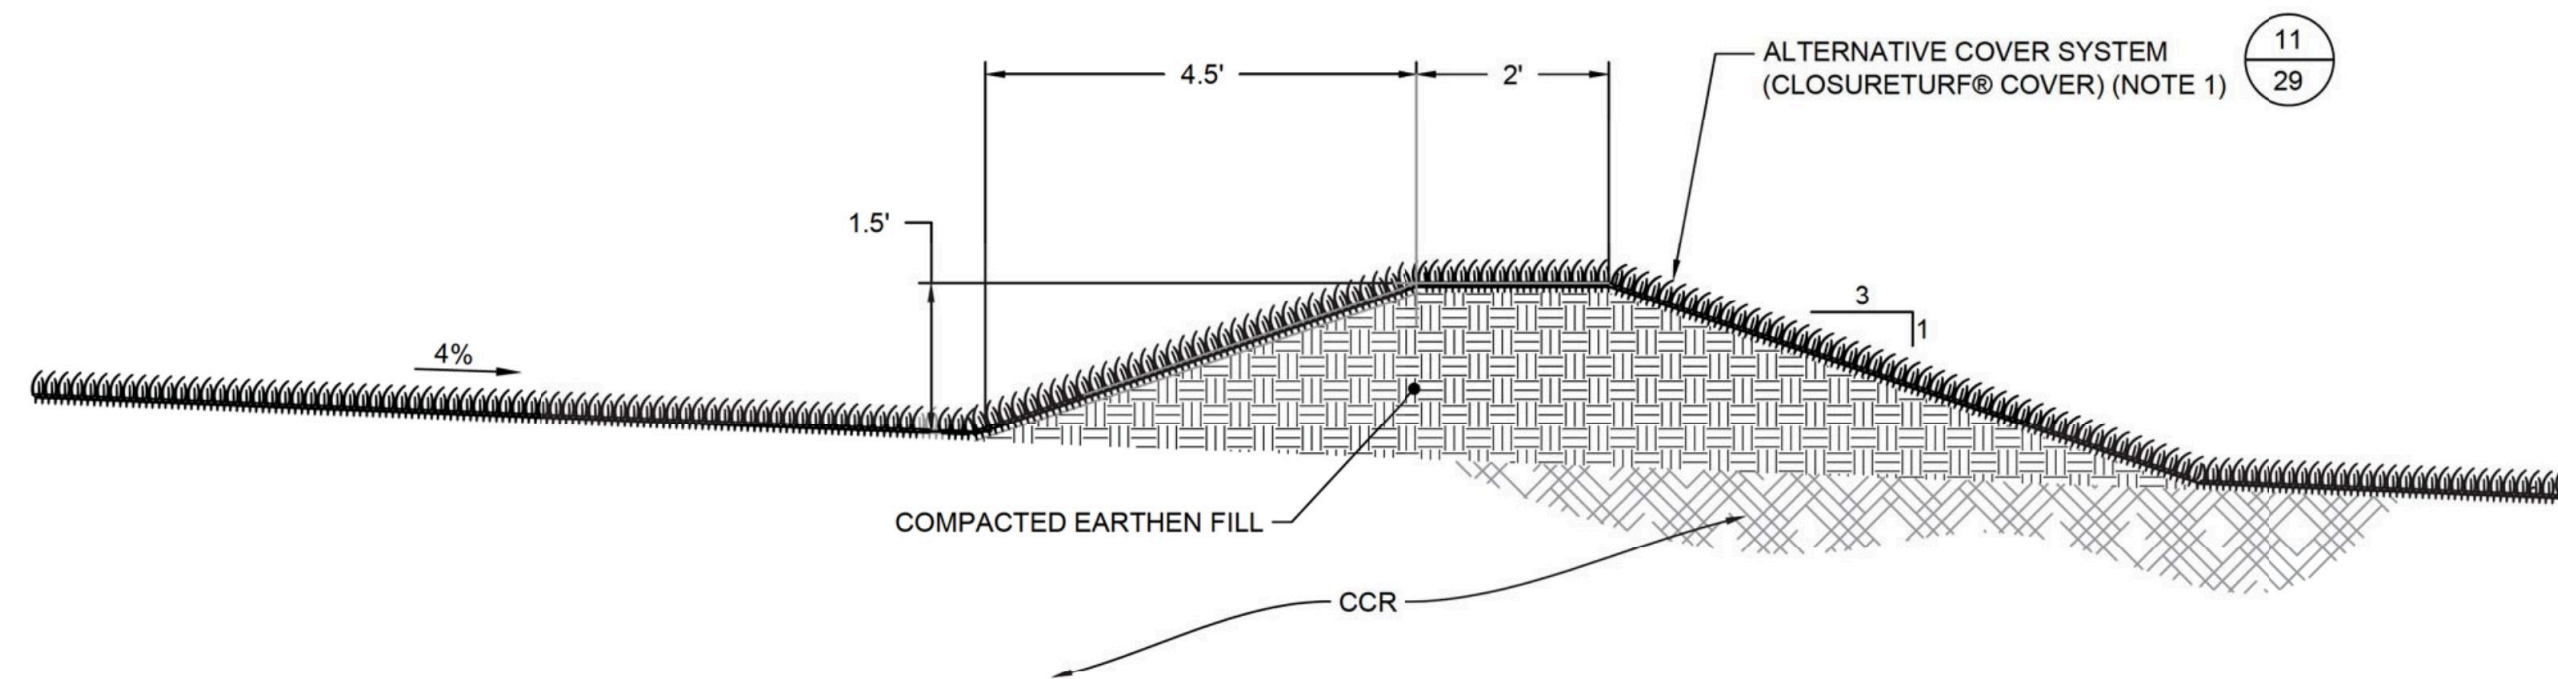

28  
-  
DETAIL  
FINAL COVER TOP DECK DIVERSION BERM  
(CLOSURETURF® OPTION)

0 2 4  
SCALE IN FEET

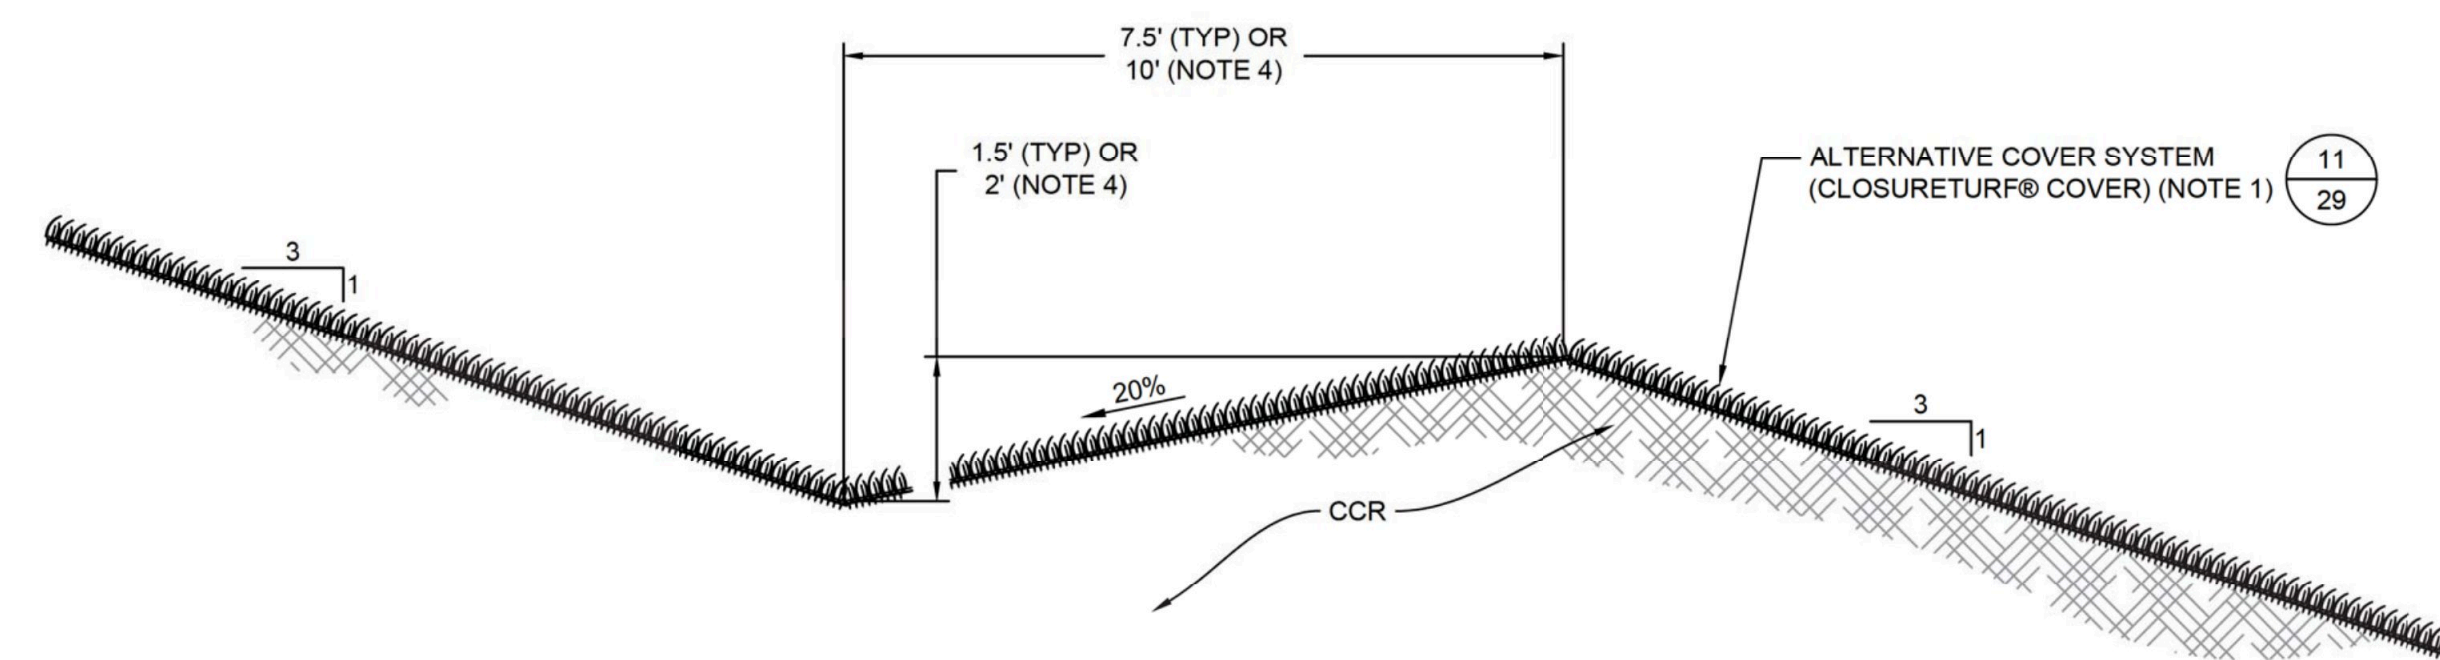

29  
-  
DETAIL  
FINAL COVER SIDESLOPE DRAINAGE BENCH (CLOSURETURF® OPTION)

0 2 4  
SCALE IN FEET

NOTES:


1. IF THE CLOSURETURF® FINAL COVER SYSTEM OPTION IS SELECTED, SAND INFILL IS TO BE USED WITH CLOSURETURF® ENGINEERED TURF IN ALL LOCATIONS. WITHIN THE FINAL COVER SIDESLOPE DRAINAGE BENCHES AND TOP DECK DIVERSION BERM, GRANULAR LINING MATERIALS THAT SUPPLEMENT THE SAND INFILL WILL BE EVALUATED DURING DETAILED DESIGN AND SPECIFIED AS APPROPRIATE.
2. GEOSYNTHETIC LAYER THICKNESSES EXAGGERATED FOR CLARITY.
3. GRADATION REQUIREMENTS AND OTHER MATERIAL PROPERTIES FOR SOIL LAYERS WILL BE PROVIDED IN TECHNICAL SPECIFICATIONS DEVELOPED FOR DETAILED DESIGN.
4. SIDESLOPE DRAINAGE BENCH DIMENSIONS ARE MINIMUM AND TYPICAL. SEE DRAWINGS 39 AND 40 FOR THE LOCATIONS OF THE LARGER SIDESLOPE DRAINAGE BENCHES.
5. IN LIEU OF GEOCOMPOSITE EXIT DESIGN AT SIDESLOPE BENCHES, AN ALTERNATIVE DRAINAGE LAYER EXIT SYSTEM USING PERIODICALLY-SPACED OUTLET PIPES WILL BE EVALUATED DURING DETAILED DESIGN AND MAY BE USED UPON APPROVAL BY THE DESIGN ENGINEER AND AUTHORIZATION BY GPC.
5. IN LIEU OF GEOCOMPOSITE EXIT DESIGN AT SIDESLOPE BENCHES, AN ALTERNATIVE DRAINAGE LAYER EXIT SYSTEM USING PERIODICALLY-SPACED OUTLET PIPES WILL BE EVALUATED DURING DETAILED DESIGN AND MAY BE USED UPON APPROVAL BY THE DESIGN ENGINEER AND AUTHORIZATION BY GPC.









PERMIT DRAWING  
NOT FOR CONSTRUCTION

0	AUG. 2021	SUBMITTAL TO GA EPD	JJ/VKH	RB
REV	DATE	DESCRIPTION	DRN	APP
STORMWATER MANAGEMENT SYSTEM DETAILS I				
PLANT BOWEN ASH POND 1 (AP-1) CLOSURE DRAWINGS BARTOW COUNTY, GEORGIA				
Geosyntec consultants				
1255 ROBERTS BOULEVARD, NW, SUITE 200 KENNESAW, GEORGIA 30144 USA PHONE: 678.202.9600 WWW.GEOSYNTEC.COM				
PROJ. NO.	GR6601	DWG.	GR6601-043	EDIT 08.16.21
SCALE	AS SHOWN	DRAWING 41 OF 50		
DATE	AUGUST 2021			



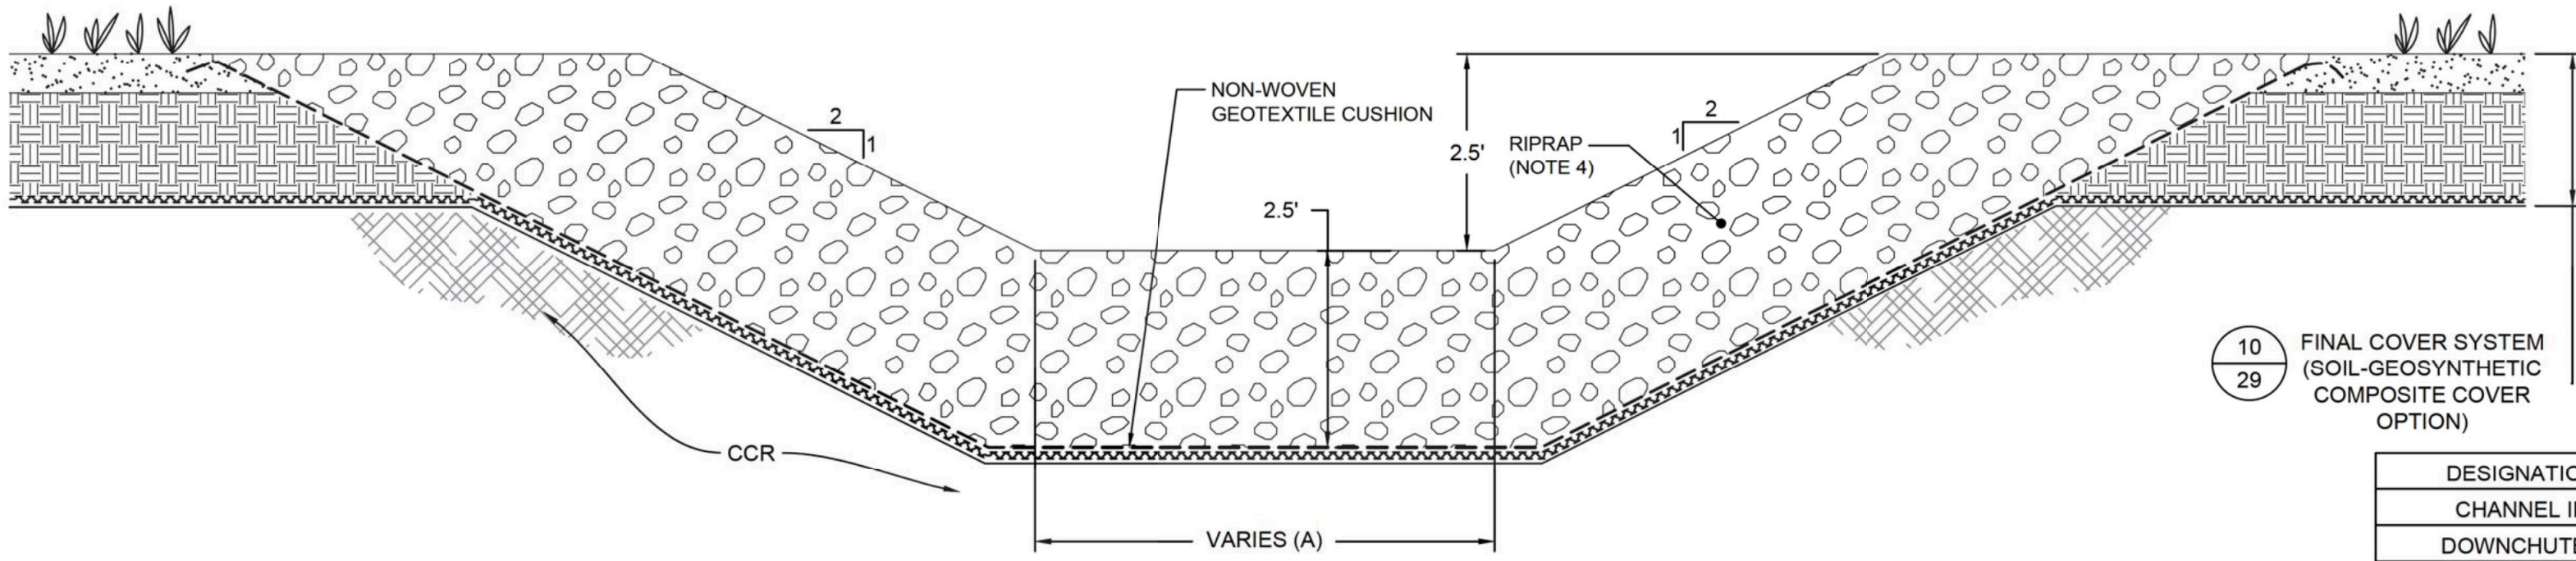

DESIGNATION	(A)
CHANNEL ID	BOTTOM WIDTH (FT)
DOWNCHUTE 1	20
DOWNCHUTE 2	15
DOWNCHUTE 3	5
DOWNCHUTE 4	30
DOWNCHUTE 5	10
DOWNCHUTE 6	5
DOWNCHUTE 7	15

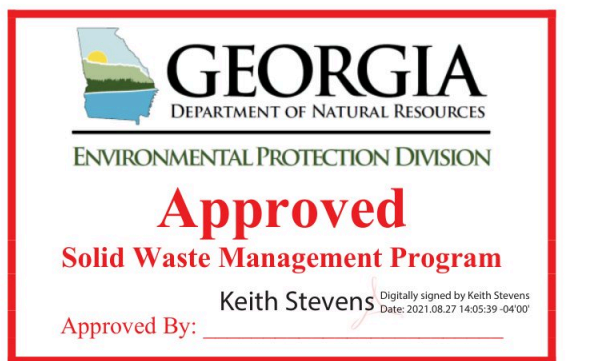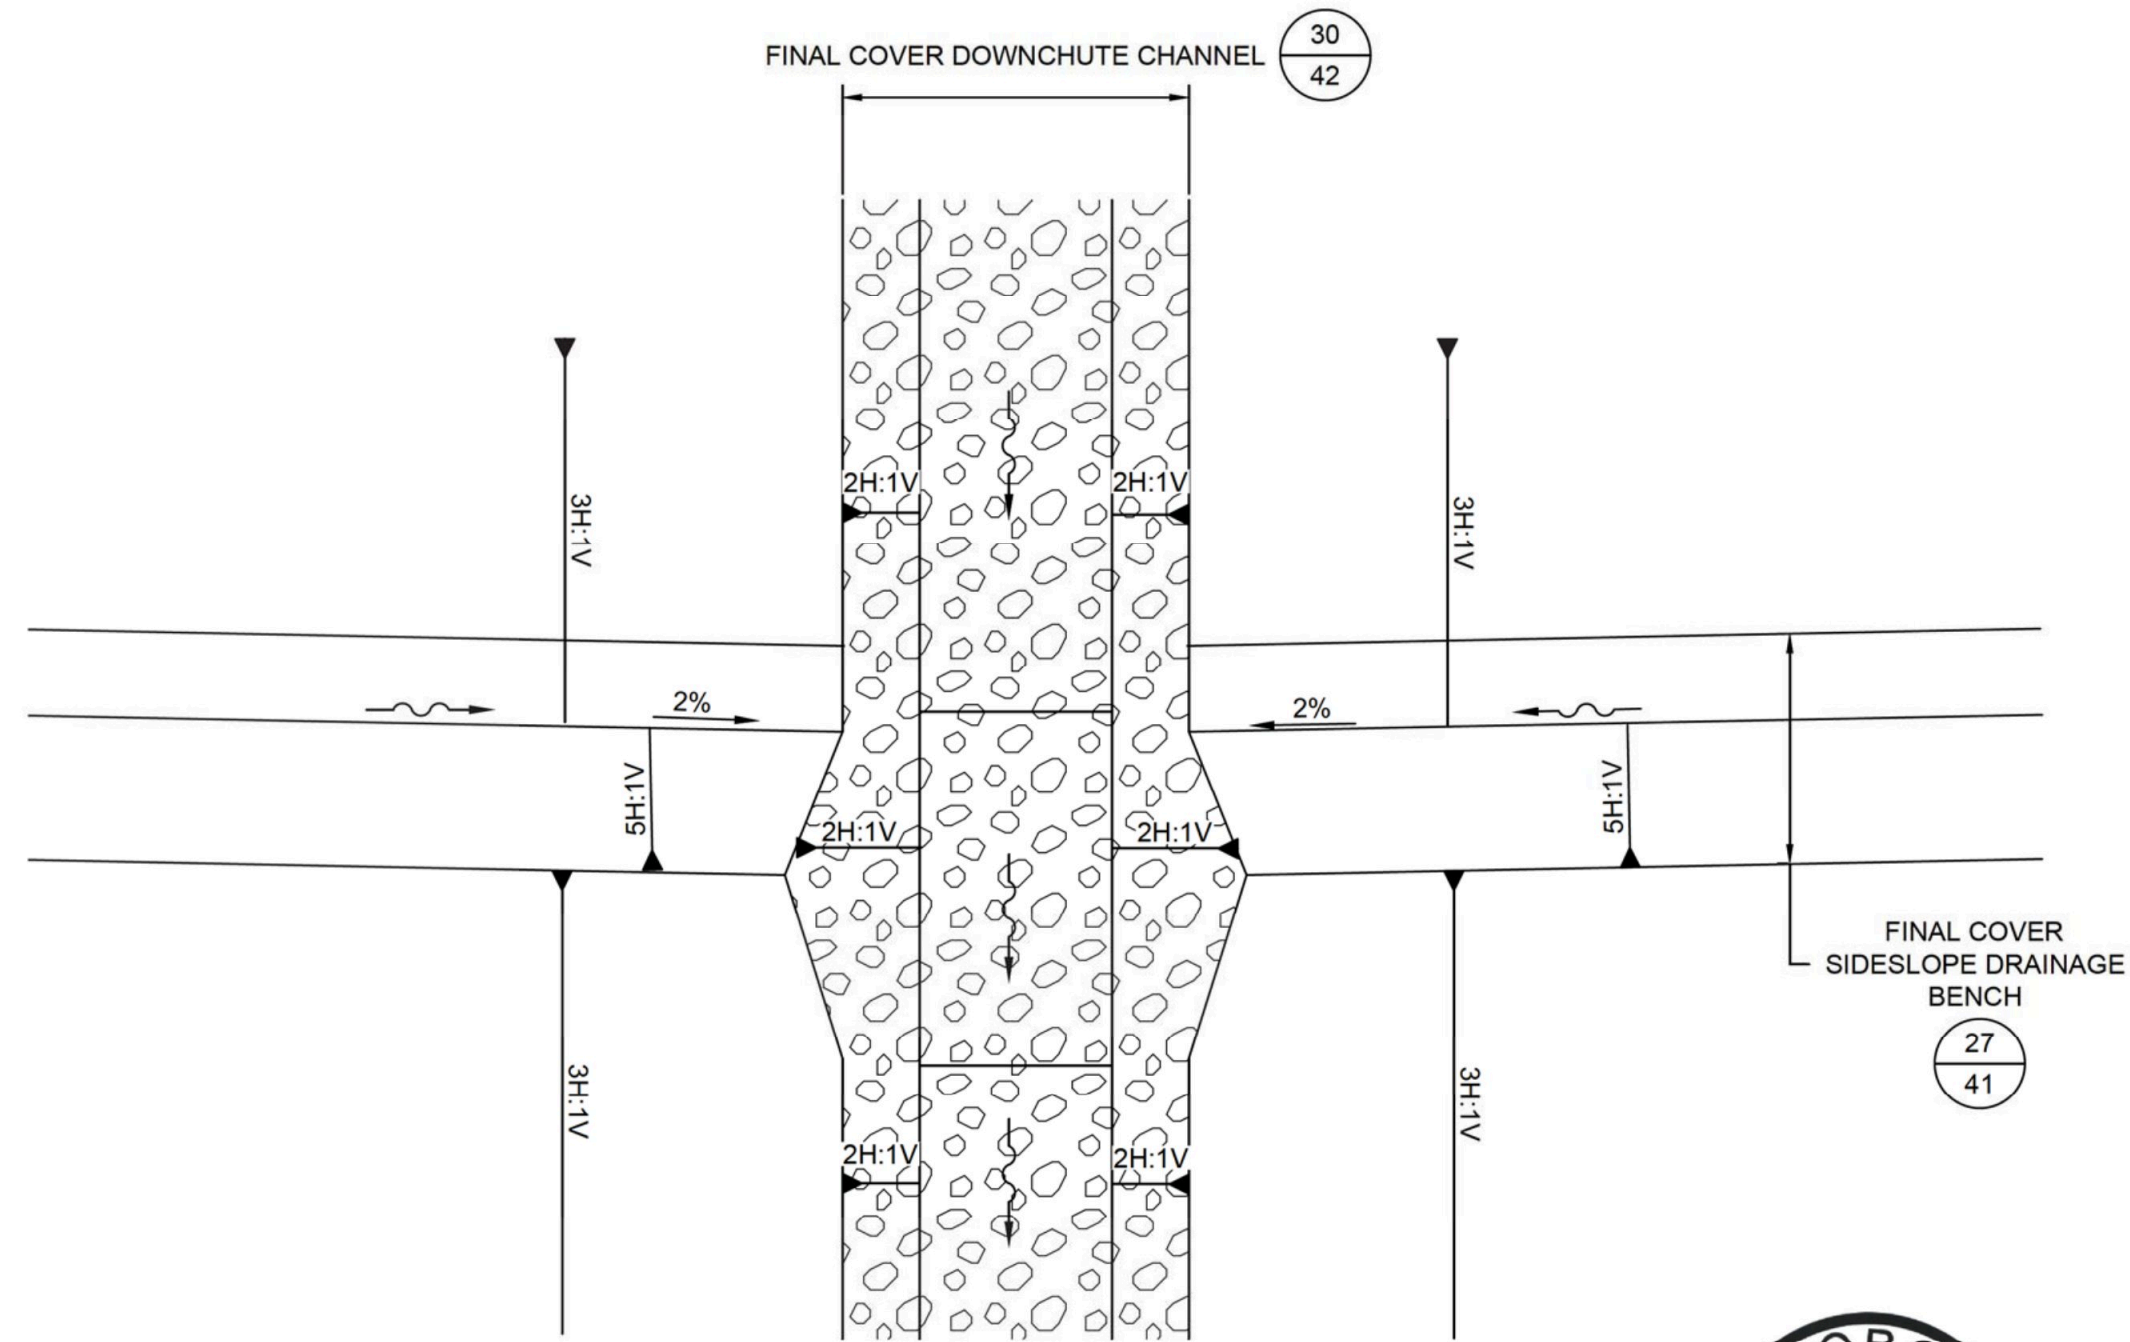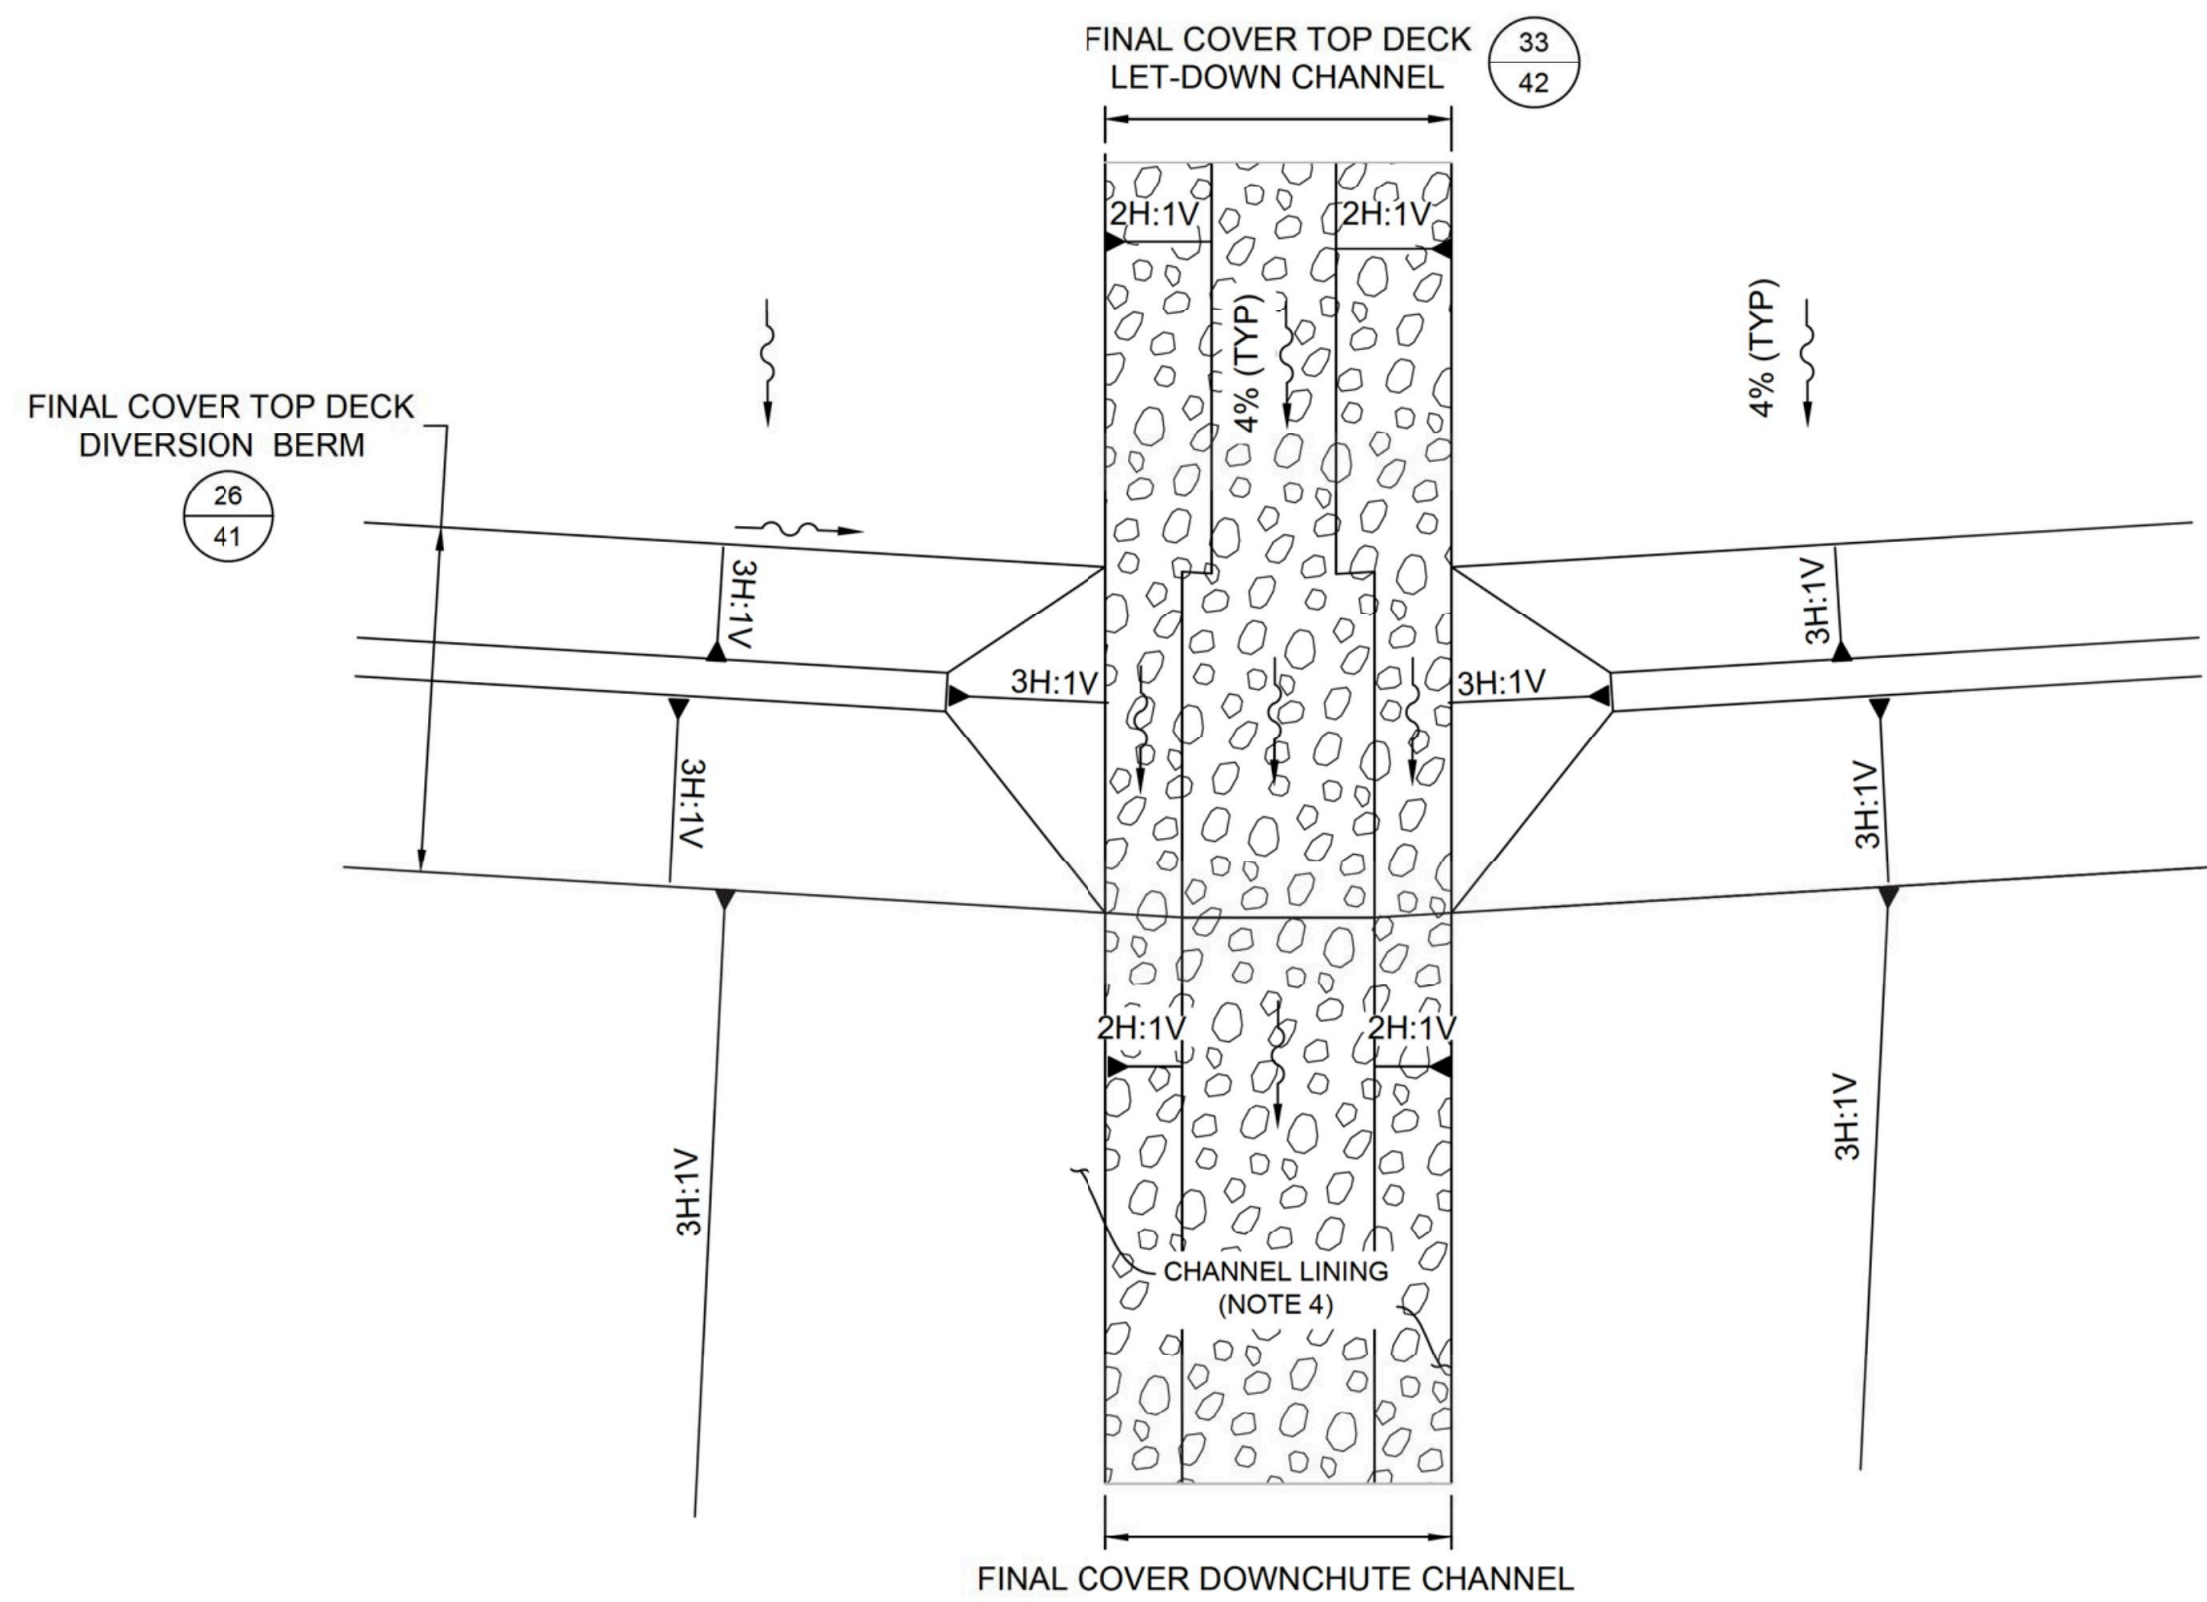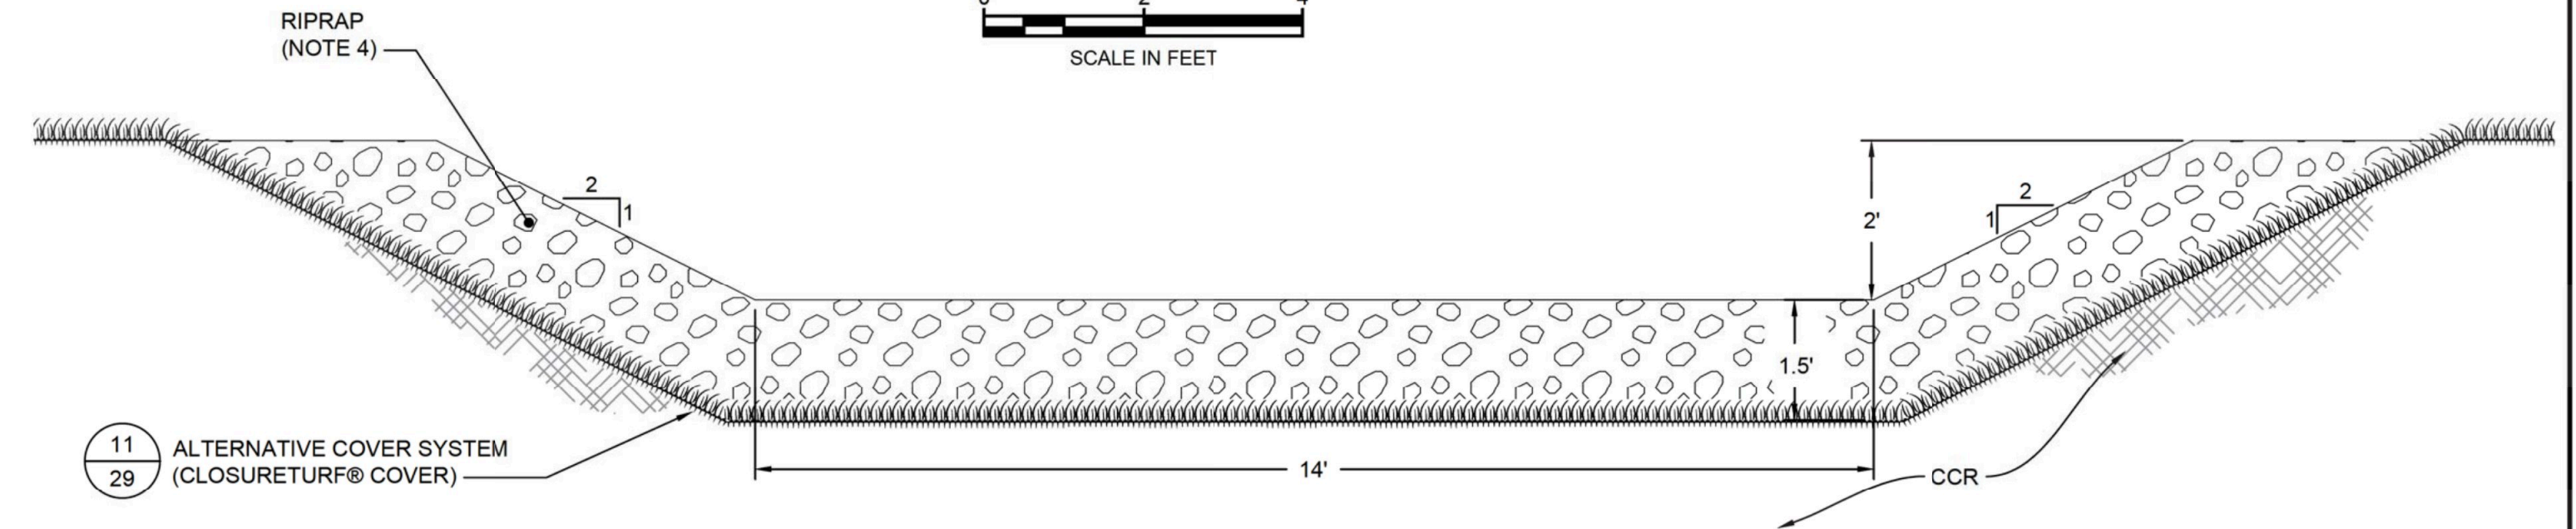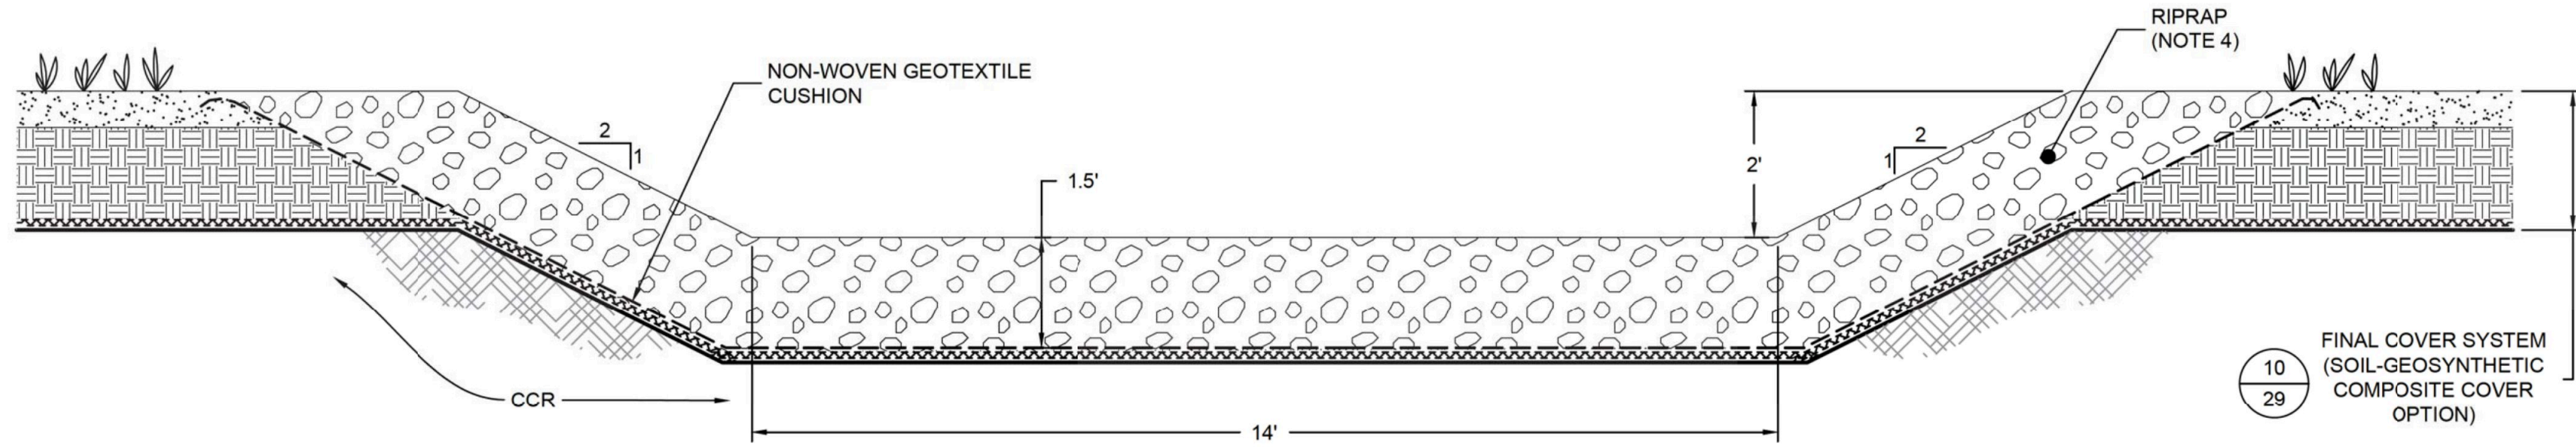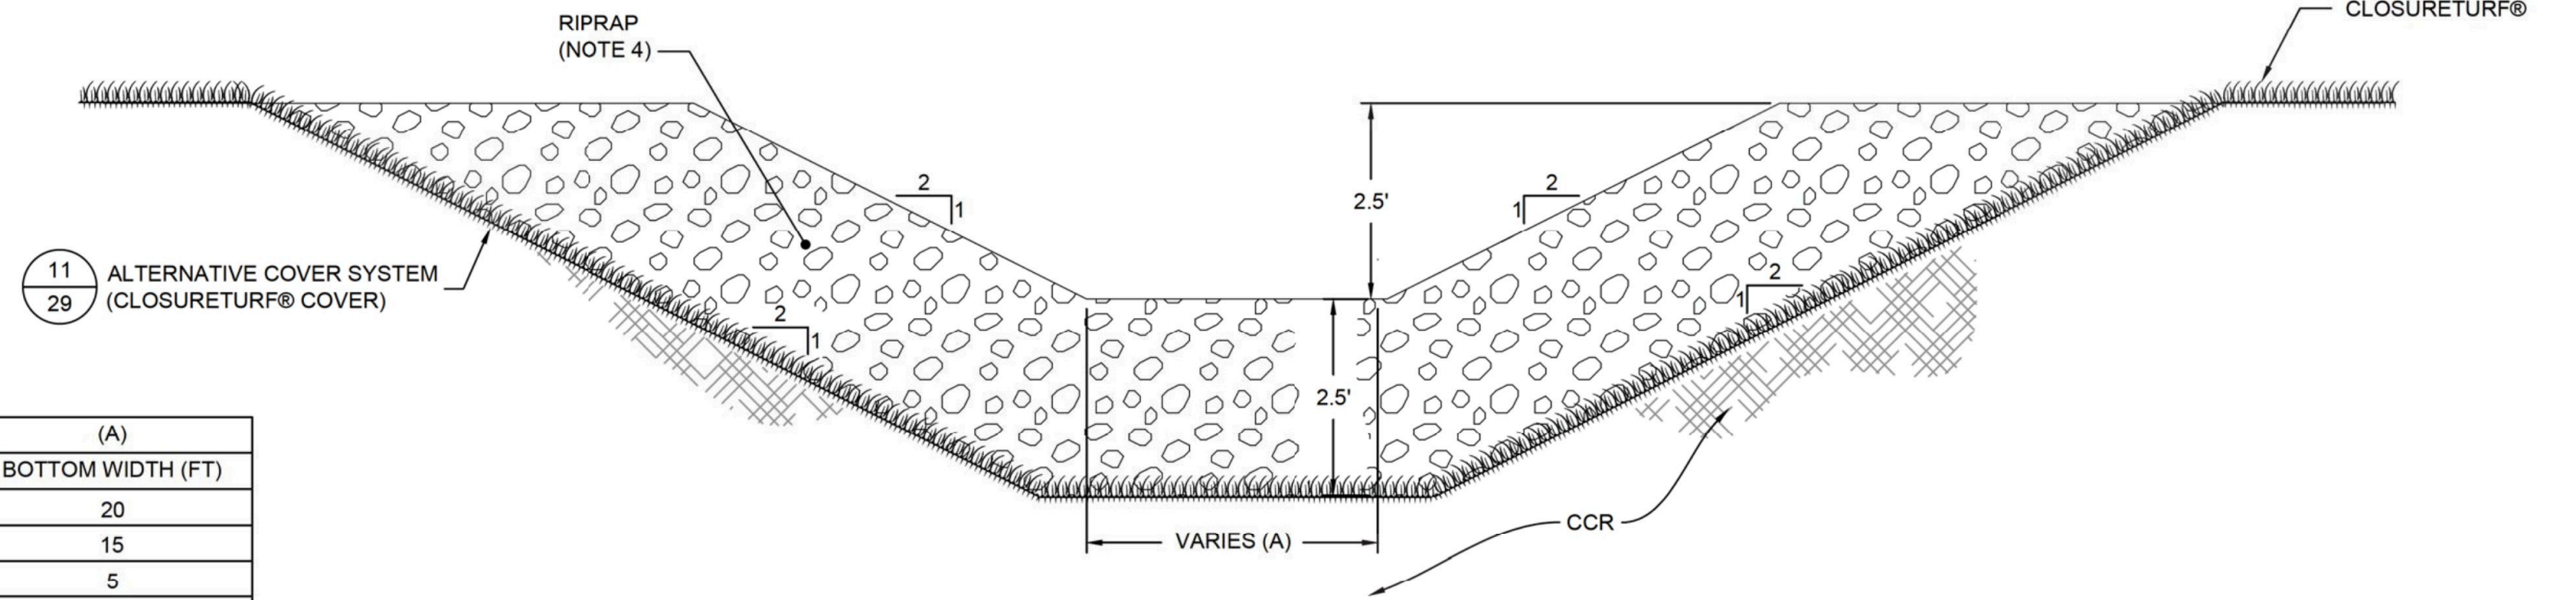

- NOTES:
- SAND INFILL IS TO BE USED WITH CLOSURETURF® ENGINEERED TURF IN ALL LOCATIONS.
  - GEOSYNTHETIC LAYER THICKNESSES EXAGGERATED FOR CLARITY.
  - OTHER CHANNEL DIMENSIONS AND LINING SYSTEMS WILL BE ASSESSED DURING THE DETAILED DESIGN BY FOLLOWING THE CHANNEL SIZING PROCEDURES IN THE "FINAL COVER STORMWATER MANAGEMENT SYSTEM DESIGN AND ANALYSIS" AND UTILIZING SUFFICIENT ENERGY DISSIPATION TECHNIQUES WITHIN FHWA CIRCULAR NUMBER 14 (HEC 14).
  - DOWNCHUTE CHANNELS WILL USE NATIONAL STONE ASSOCIATION (N.S.A) NO. R-5 GRADED RIPRAP WITH N.S.A. NO. FS-2 FILTER STONE AS PRESENTED IN TABLE C-1 OF THE "MANUAL FOR EROSION AND SEDIMENT CONTROL" (GREEN BOOK).
  - GRADATION REQUIREMENTS AND OTHER MATERIAL PROPERTIES FOR SOIL LAYERS WILL BE PROVIDED IN TECHNICAL SPECIFICATIONS DEVELOPED FOR DETAILED DESIGN.
  - IN LIEU OF RIPRAP LINING AT THE FINAL COVER DOWNCHUTES AND TOP DECK LET-DOWN CHANNELS, AN ALTERNATIVE LINING SYSTEM USING CLOSURETURF® WITH HYDROBINDER® WILL BE EVALUATED DURING DETAILED DESIGN AND SPECIFIED AS APPROPRIATE.


REV	DATE	DESCRIPTION	DRN	APP
0	AUG. 2021	SUBMITTAL TO GA EPD	JJ/VKH	RB
STORMWATER MANAGEMENT SYSTEM DETAILS II				
PLANT BOWEN ASH POND 1 (AP-1) CLOSURE DRAWINGS BARTOW COUNTY, GEORGIA				
Geosyntec consultants				
1255 ROBERTS BOULEVARD, NW, SUITE 200 KENNESAW, GEORGIA 30144 USA PHONE: 678.202.9600 WWW.GEOSYNTEC.COM				
PROJ. NO.	GR6601	DWG.	GR6601-044	EDIT 08.16.21
SCALE	AS SHOWN	DRAWING 42 OF 50		
DATE	AUGUST 2021			




PERMIT DRAWING  
NOT FOR CONSTRUCTION



P:\CADD\PROJECTS\GEORGIA POWER\BOWEN POND PLANT\TIE-IN\ASH POND CLOSURE (GR6601)\DRAWINGS\GR6601-044A

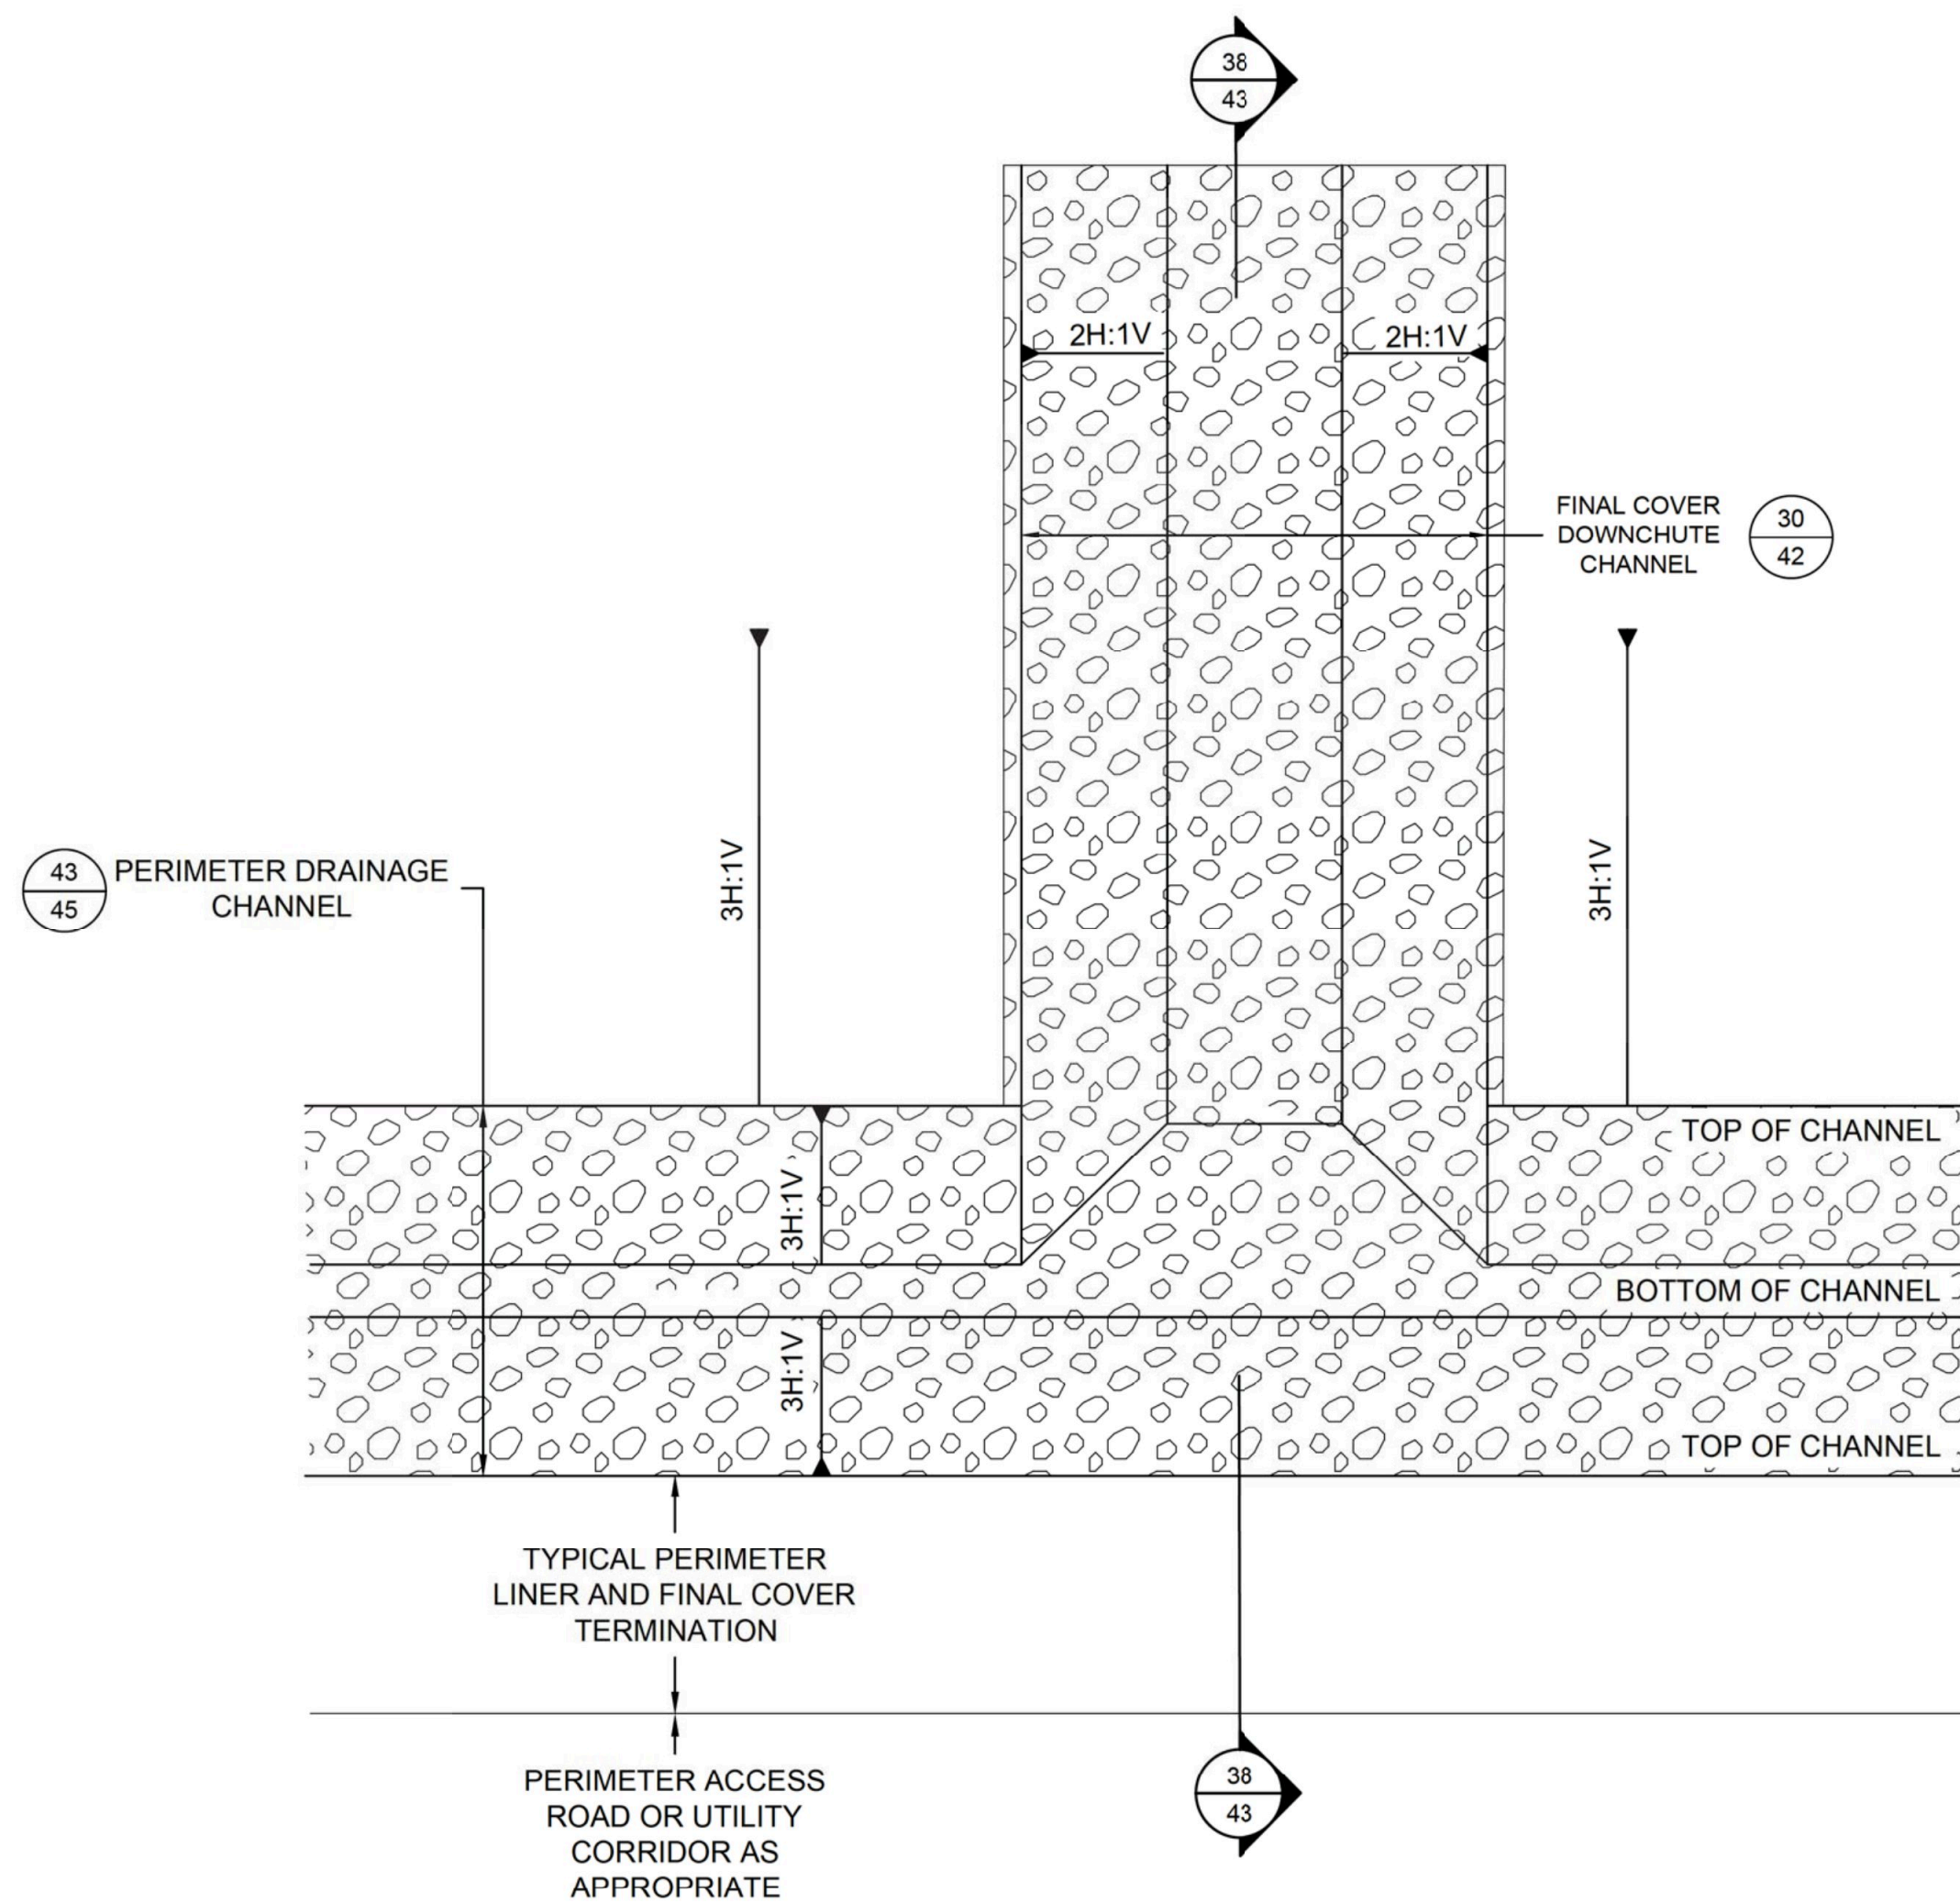


**36**  
**38** **DETAIL**  
**FINAL COVER DOWNCHUTE AND PERIMETER CHANNEL INTERSECTION**  
SCALE: NTS

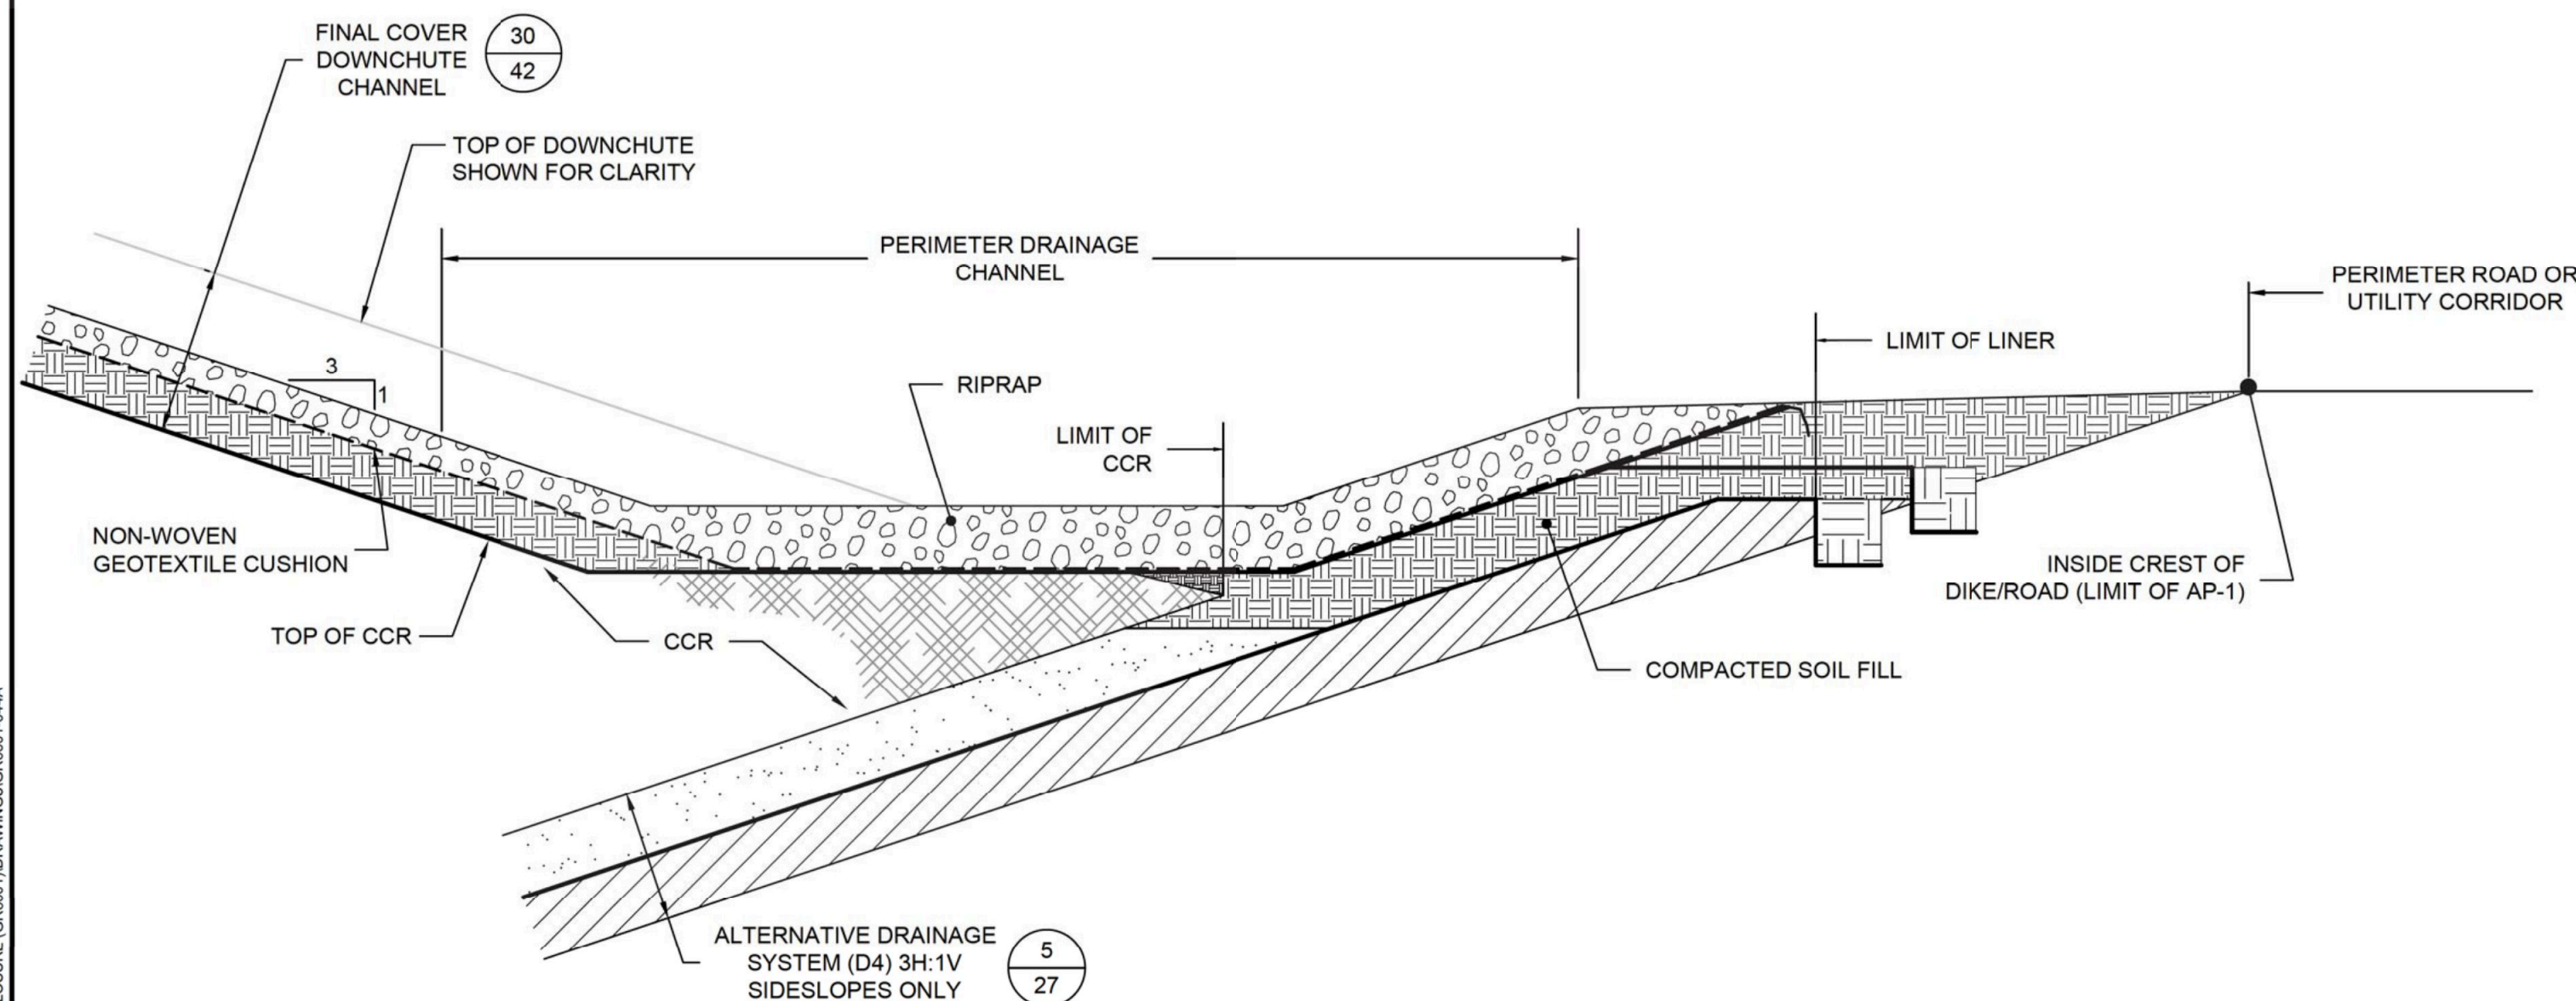


**38**  
**43** **SECTION**  
**FINAL COVER DOWNCHUTE AND PERIMETER CHANNEL SECTION**  
SCALE: NTS

NOTES:

1. SAND INFILL IS TO BE USED WITH CLOSURETURF® ENGINEERED TURF IN ALL LOCATIONS.
2. GEOSYNTHETIC LAYER THICKNESSES EXAGGERATED FOR CLARITY.
3. GRADATION REQUIREMENTS AND OTHER MATERIAL PROPERTIES FOR SOIL LAYERS WILL BE PROVIDED IN TECHNICAL SPECIFICATIONS DEVELOPED FOR DETAILED DESIGN.
4. IF THE CLOSURETURF® OPTION IS SELECTED, THE FINAL COVER DOWNCHUTE AND PERIMETER CHANNEL WILL BE INSTALLED TO MAINTAIN THE SAME LIMIT OF CCR MINIMUM CHANNEL DIMENSIONS, AND DEGREE OF SEPARATION BETWEEN THE RIPRAP LINING AND CCR.

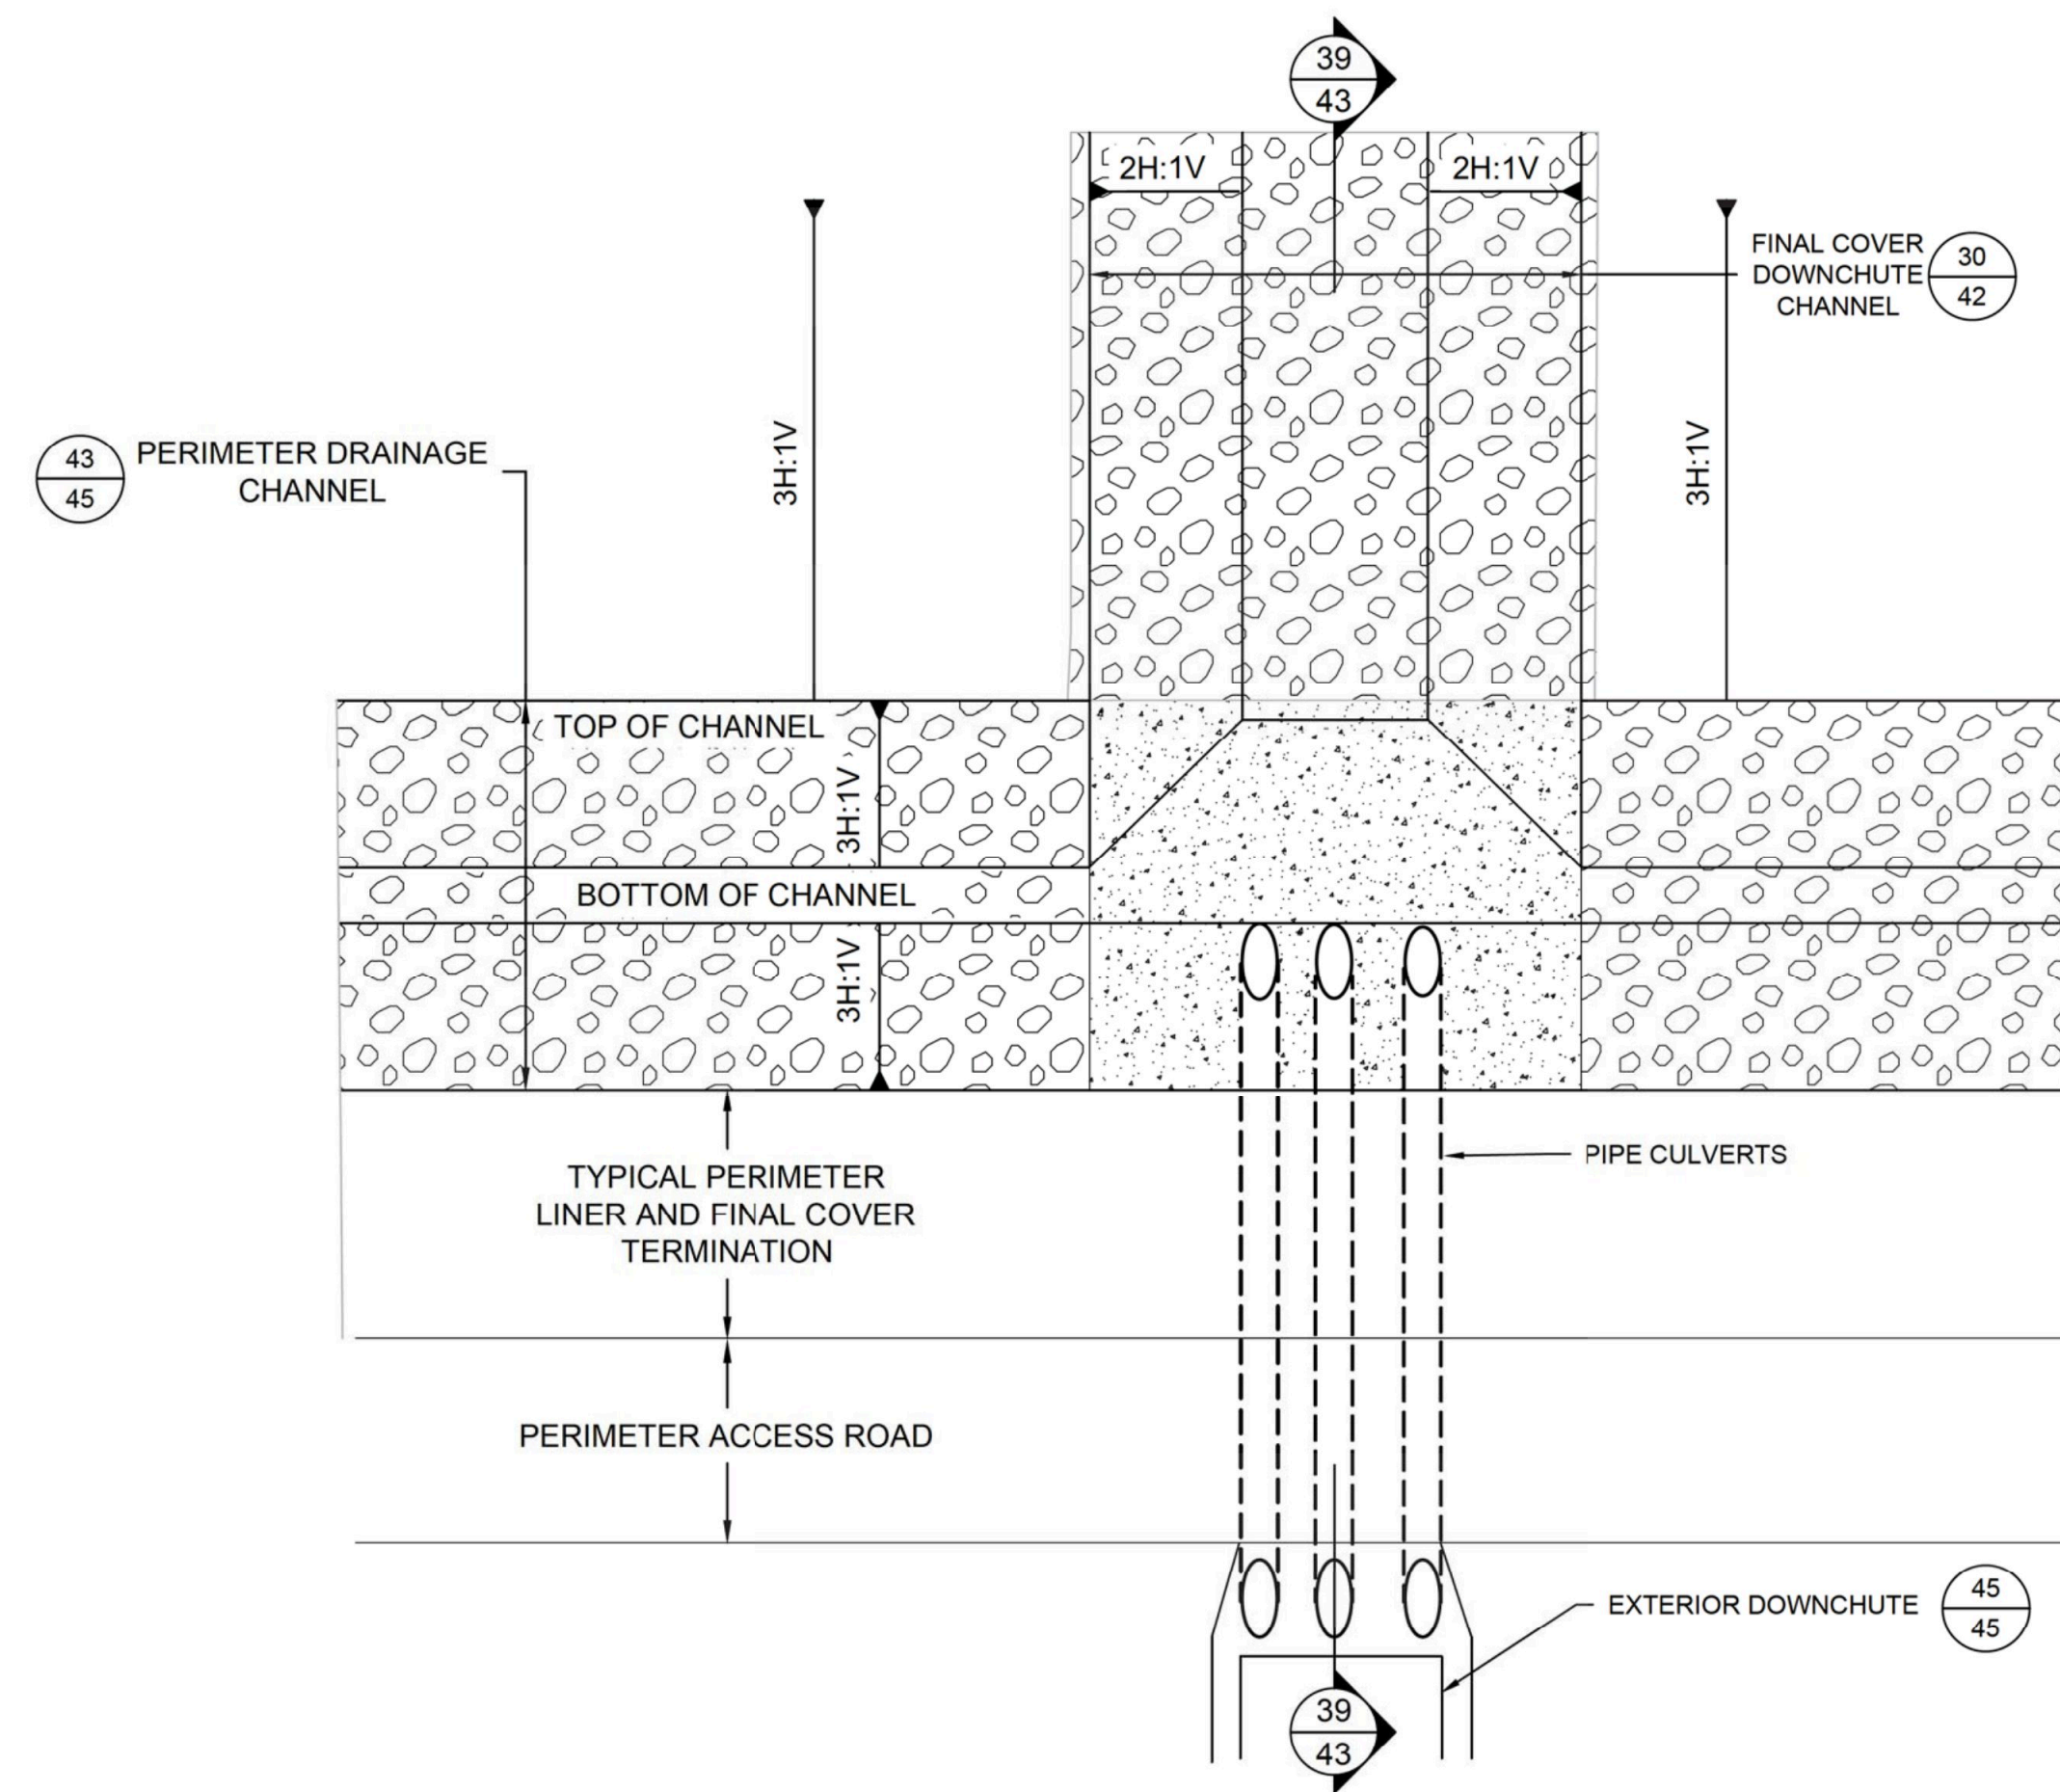

**37**  
**39** **DETAIL**  
**FINAL COVER DOWNCHUTE AND PERIMETER DRAINAGE CHANNEL OUTLET**  
SCALE: NTS

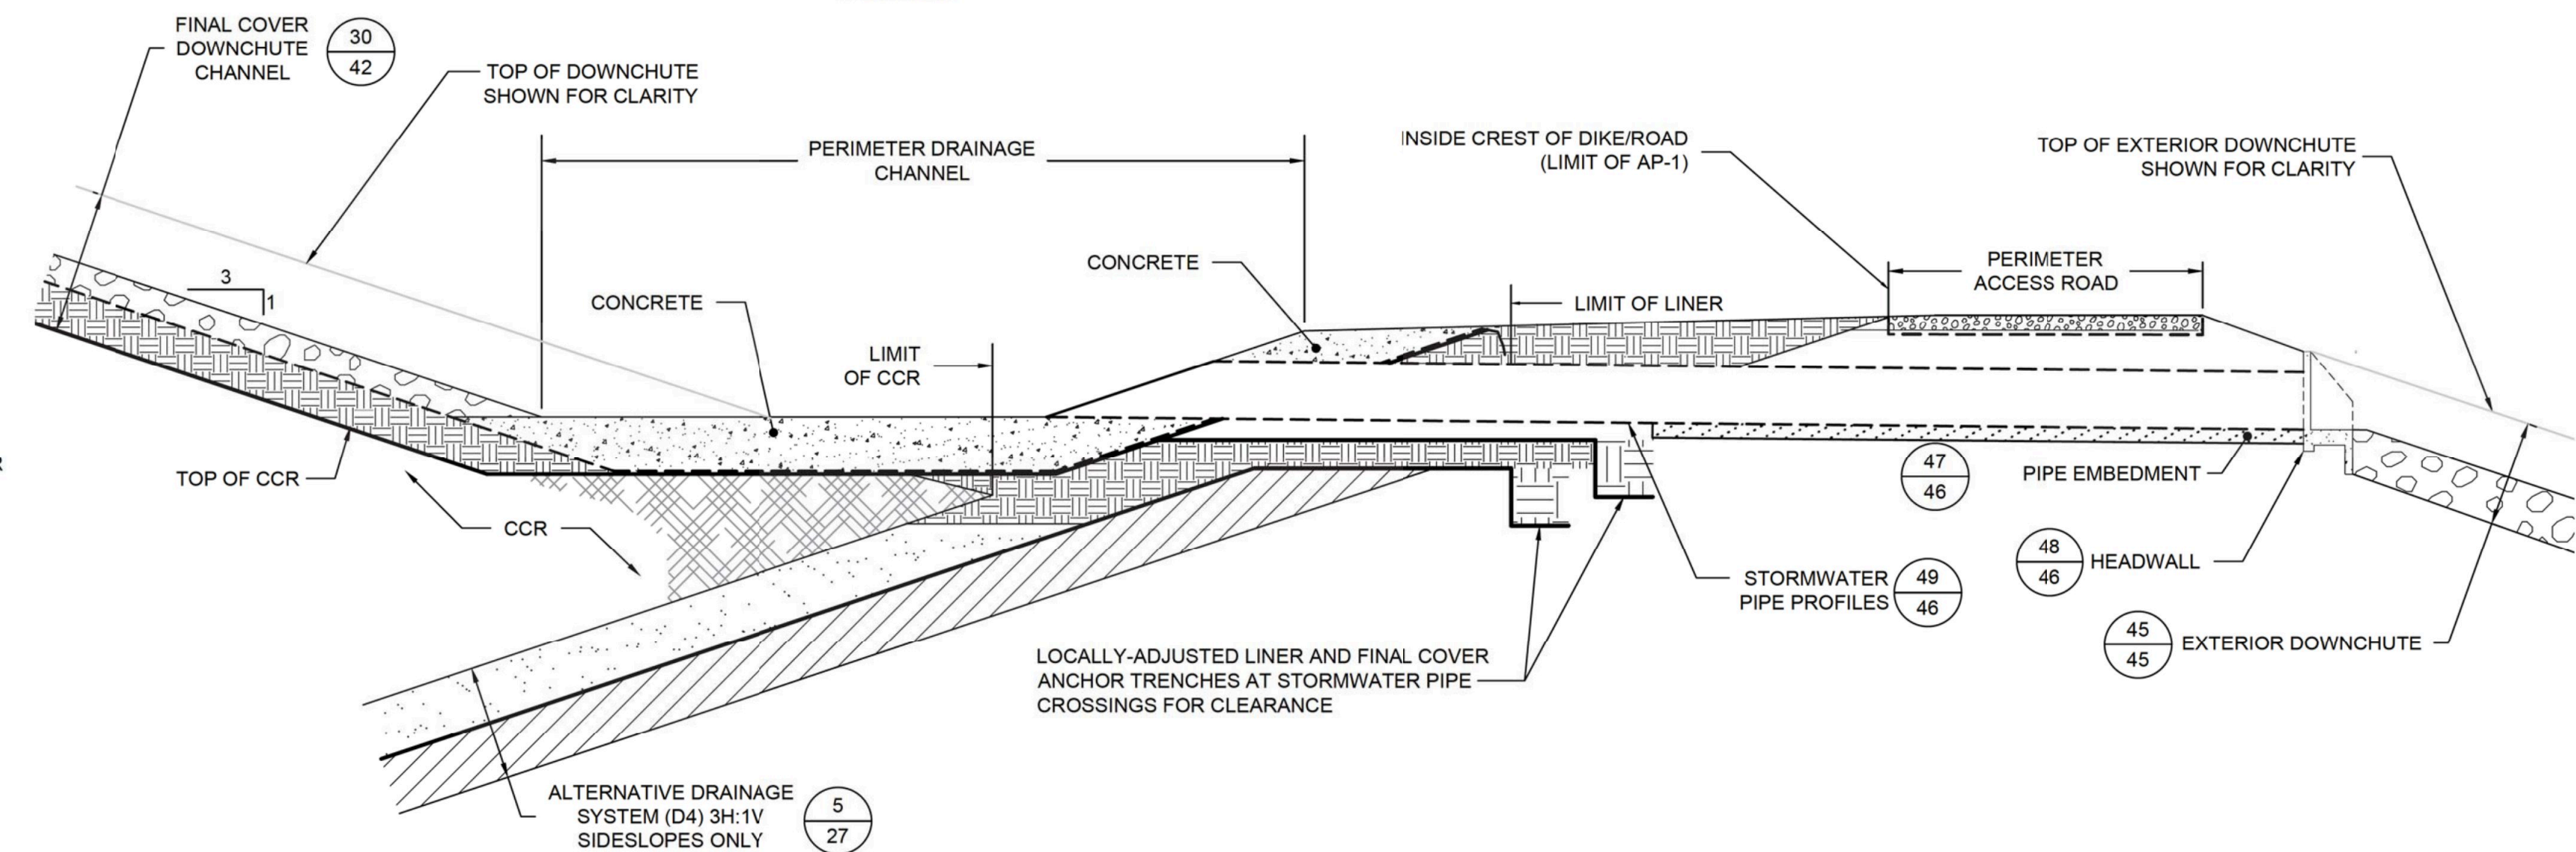


**39**  
**43** **SECTION**  
**DOWNCHUTE AND PERIMETER DRAINAGE CHANNEL OUTLET**  
SCALE: NTS




PERMIT DRAWING  
NOT FOR CONSTRUCTION

REV	DATE	DESCRIPTION	DRN	APP
0	AUG. 2021	SUBMITTAL TO GA EPD	JJ/VKH	RB
STORMWATER MANAGEMENT SYSTEM DETAILS III				
PLANT BOWEN ASH POND 1 (AP-1) CLOSURE DRAWINGS BARTOW COUNTY, GEORGIA				
Geosyntec consultants				
1255 ROBERTS BOULEVARD, NW, SUITE 200 KENNESAW, GEORGIA 30144 USA PHONE: 678.202.9600 WWW.GEOSYNTEC.COM				
PROJ. NO.	GR6601	DWG.	GR6601-044A	EDIT 08.16.21
SCALE	AS SHOWN	DRAWING 43 OF 50		
DATE	AUGUST 2021			




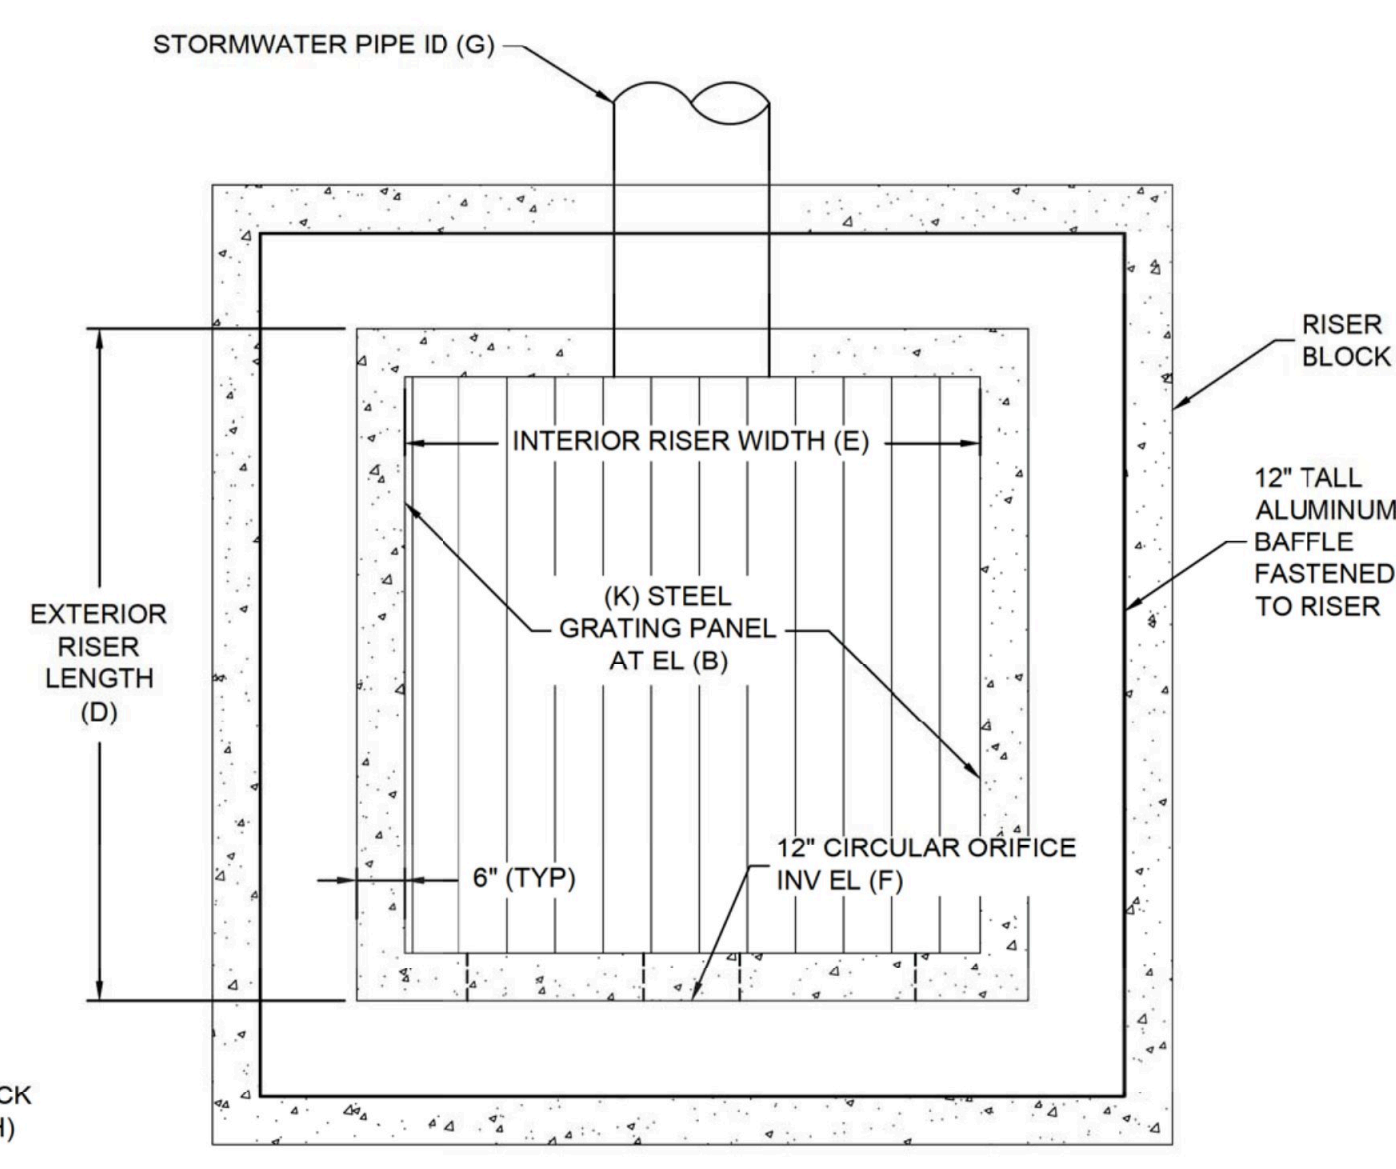

### PLAN VIEW

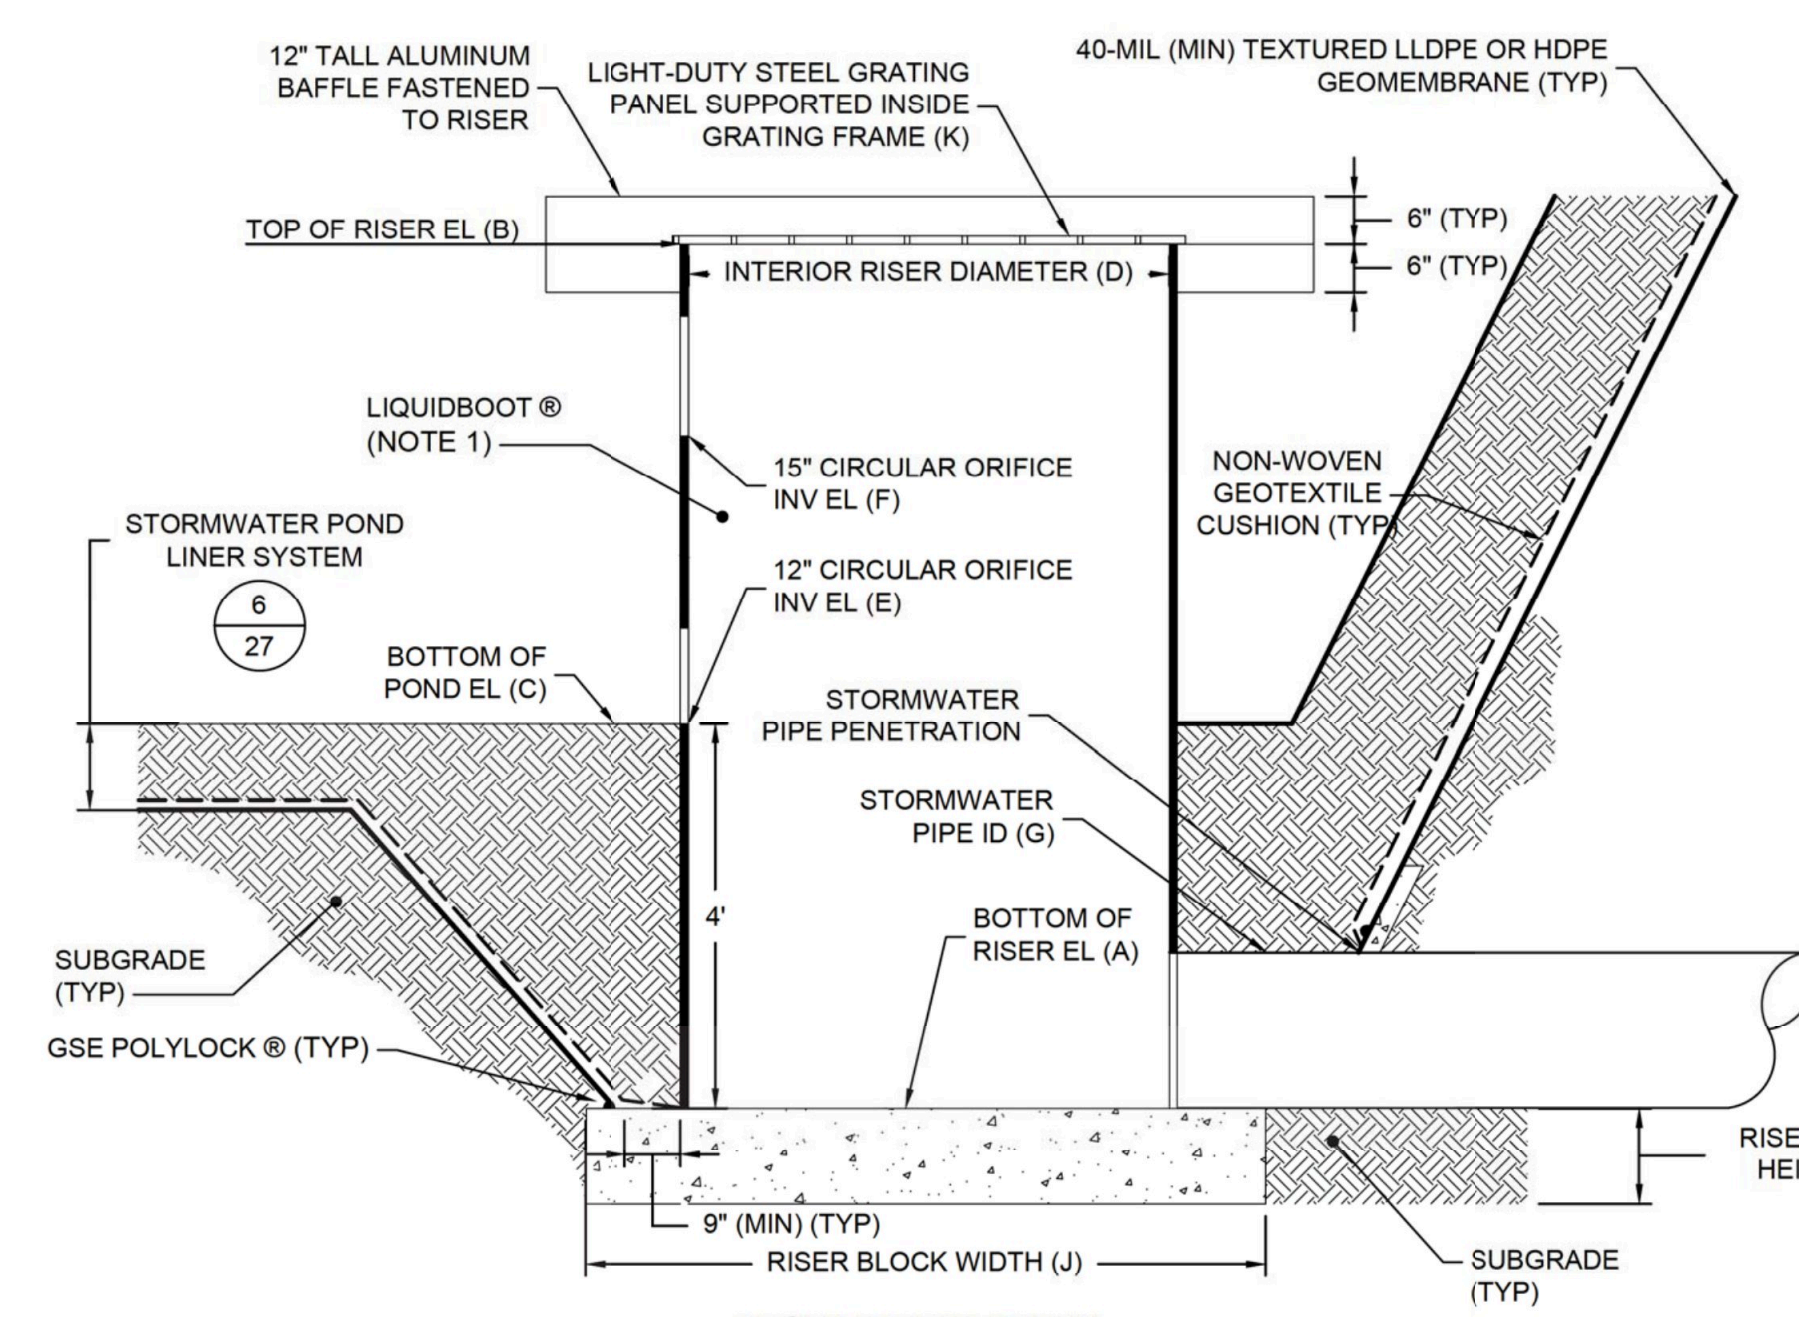

PROFILE VIEW: WIDTH

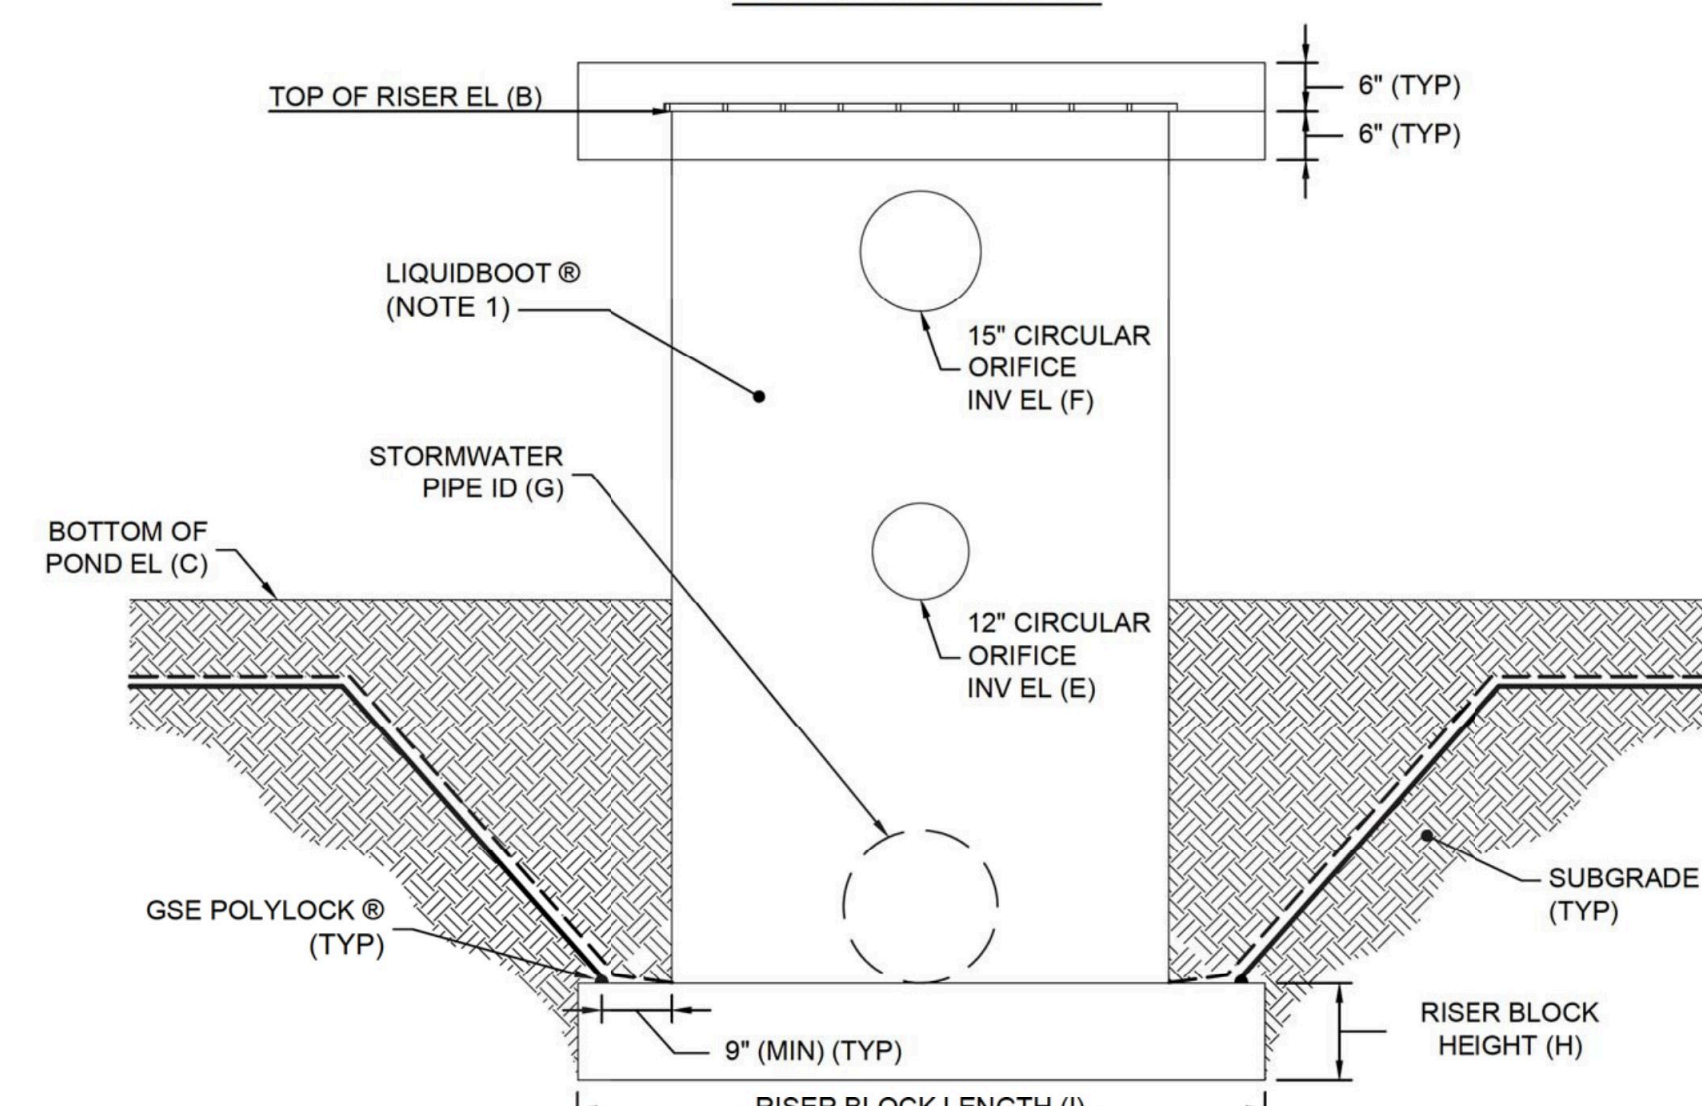


### PLAN VIEW

DESIGNATION	(A)	(B)	(C)	(D)	(E)	(F)	(G)	(H)	(I)	(J)	(K)
POND ID	BOTTOM OF RISER EL (FT)	TOP OF RISER EL (FT)	BOTTOM OF POND EL (FT)	INTERIOR RISER DIAMETER (FT)	12" CIRCULAR ORIFICE INV EL (FT)	15" CIRCULAR ORIFICE INV EL (FT)	STORMWATER PIPE ID	RISER BLOCK HEIGHT (FT)	RISER BLOCK LENGTH (FT)	RISER BLOCK WIDTH (FT)	PANEL DIAMETER (in)
POND 2	673.5	683.0	677.5	5	677.5	680.5	POND 2 PRINCIPAL SPILLWAY PIPE	2	7.2	7.2	60

42A  
39

DETAIL  
EXISTING POND 2 RISER PIPE

SCALE: NTS

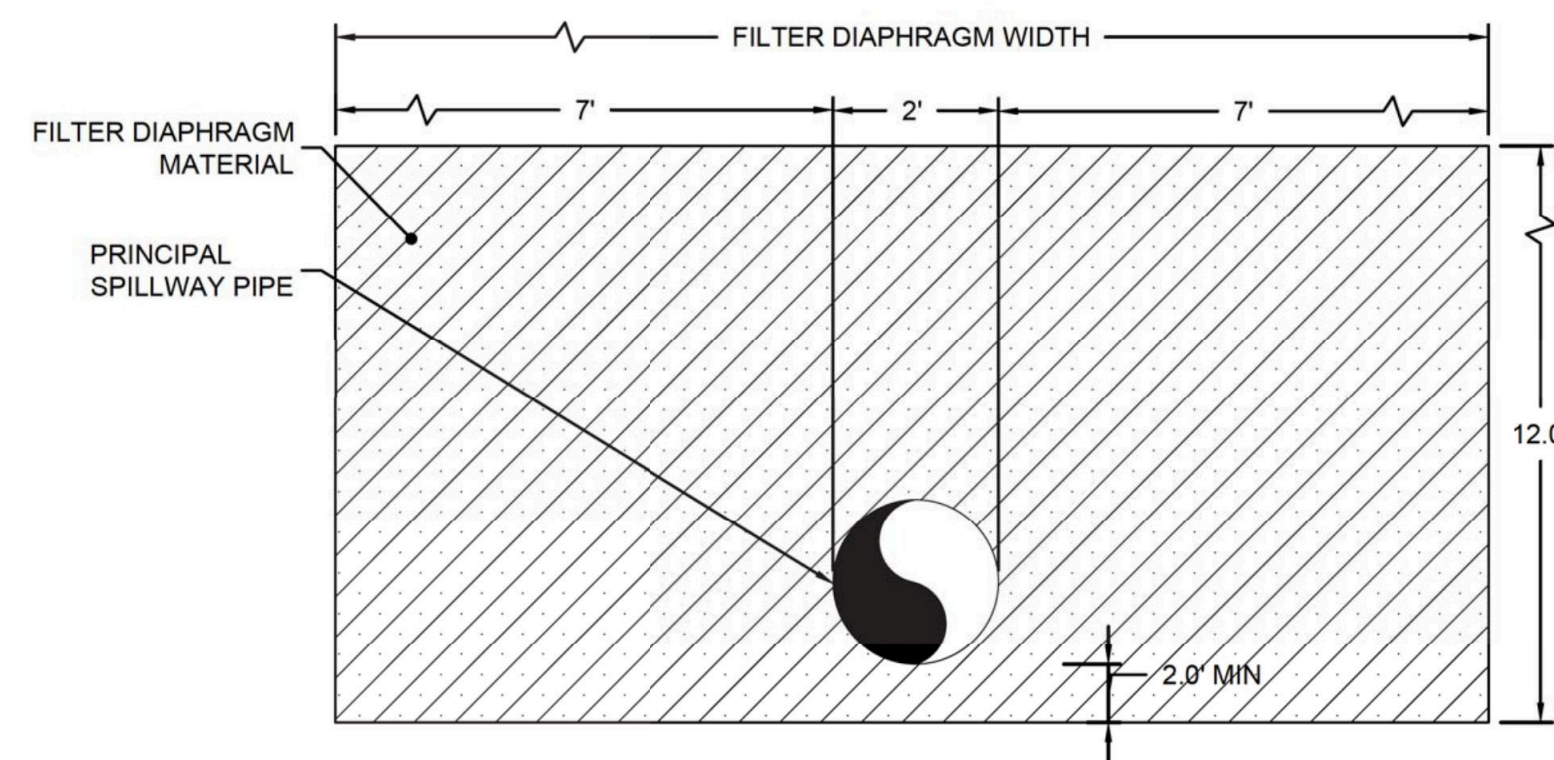

41	DETAIL
44	FILTER DIAPHRAGM (SAND CORE)

NOTES:

-  **GEORGIA**  
DEPARTMENT OF NATURAL RESOURCES
- 
- ENVIRONMENTAL PROTECTION DIVISION
- Approved**
- Solid Waste Management Program**
- Keith Stevens
- Approved By: \_\_\_\_\_
- Digitally signed by Keith Stevens  
Date: 2021.08.27 14:14:27 -04'




Georgia  
Power

PERMIT DRAWING  
NOT FOR CONSTRUCTION


0	AUG. 2021	SUBMITTAL TO GA EPD				JJV/KH	RB		
REV	DATE	DESCRIPTION				DRN	APP		
STORMWATER MANAGEMENT SYSTEM DETAILS IV									
PLANT BOWEN ASH POND 1 (AP-1) CLOSURE DRAWINGS BARTOW COUNTY, GEORGIA									
<div><div><div>Geosyntec</div><div>consultants</div></div><div><div>1255 ROBERTS BOULEVARD, NW, SUITE 200 KENNESAW, GEORGIA 30144 USA</div><div>PHONE: 678.202.9500 WWW.GEOSYNTEC.COM</div></div></div>									
PROJ. NO.		GR6601		DWG.		GR6601-045		EDIT 08.16.21	
SCALE		AS SHOWN		DRAWING 44 OF 50					
DATE		AUGUST 2021							



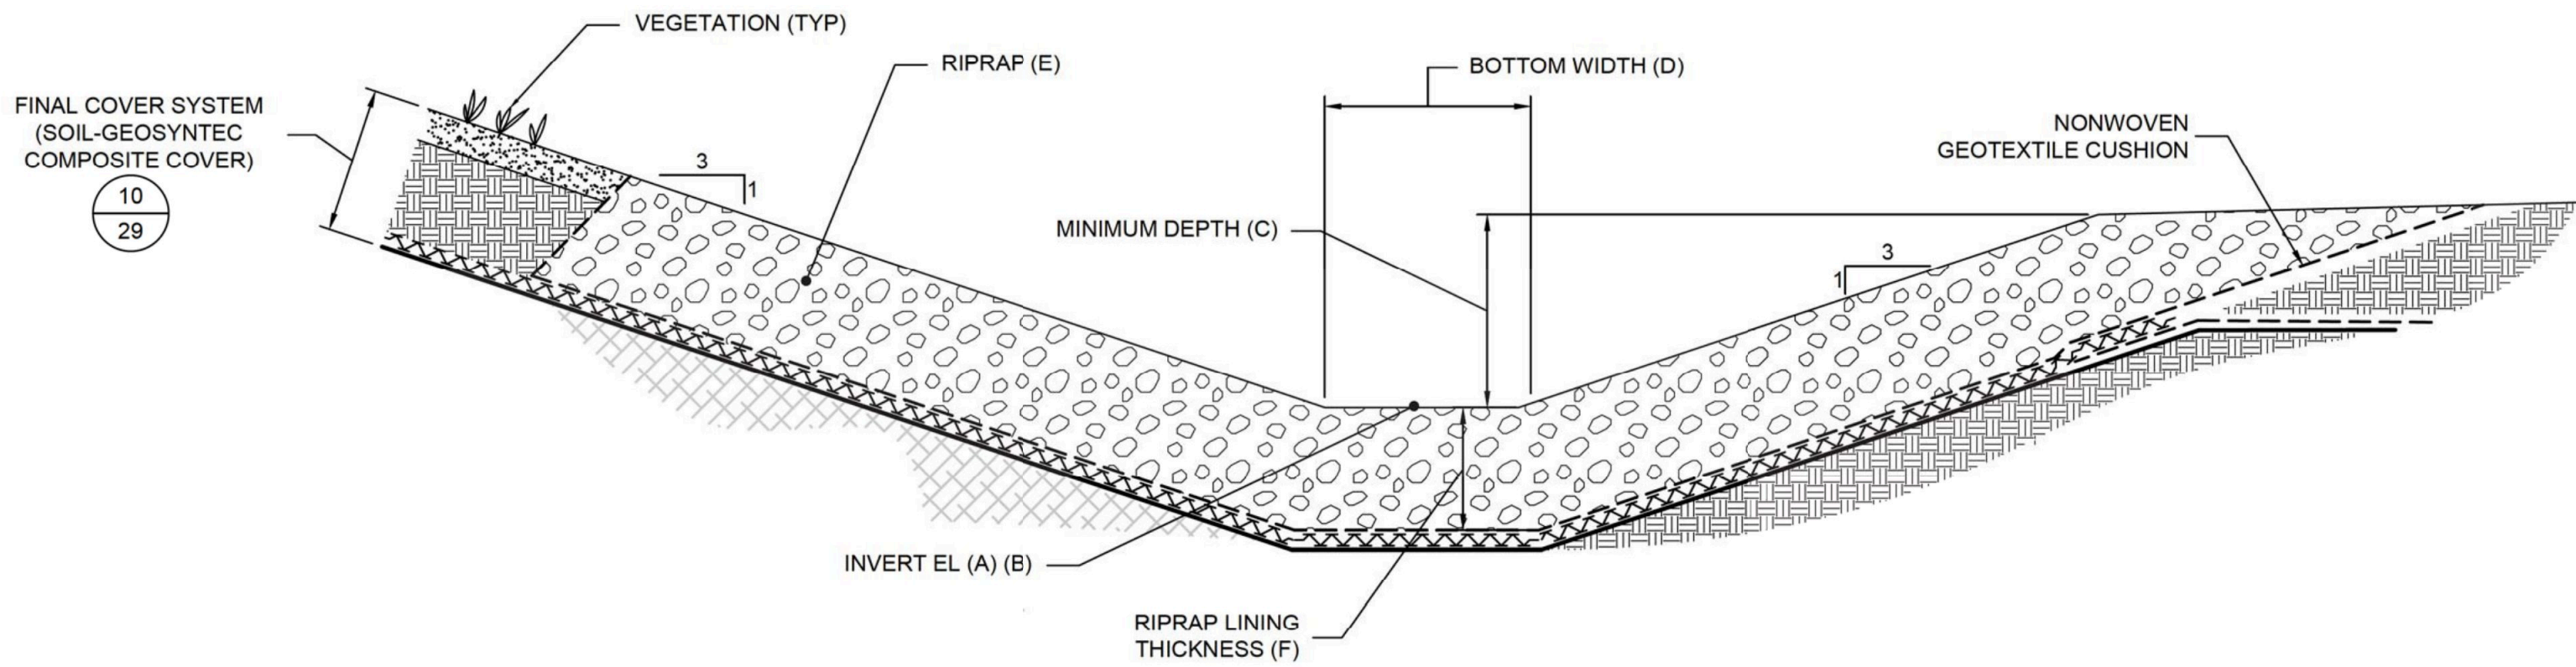


DESIGNATION			(A)	(B)	(C)	(D)	(E)	(F)
PERIMETER CHANNEL ID	LENGTH (FT)	SLOPE (FT/FT)	UPSTREAM INVERT EL (FT)	DOWNSTREAM INVERT EL (FT)	MIN DEPTH (FT)	BOTTOM WIDTH (FT)	RIPRAP STONE GRADE (FILTER STONE GRADE) (NOTE 2)	RIPRAP LINING THICKNESS
1.1	934	0.005	716.86	712.19	2.5	3	N.S.A. No. R-4 (FS-2)	1.5
1.2	675	0.005	712.19	708.81	4	3	N.S.A. No. R-4 (FS-2)	1.5
1.3	674	0.005	713.00	709.62	2	3	N.S.A. No. R-4 (FS-2)	1.5
1.4	927	0.006	713.00	707.17	2.5	3	N.S.A. No. R-4 (FS-2)	1.5
1.5	1226	0.005	713.30	707.17	2.5	3	N.S.A. No. R-4 (FS-2)	1.5
2.1	1031	0.005	713.30	708.14	3	3	N.S.A. No. R-4 (FS-2)	1.5
2.2	872	0.005	712.92	708.14	2	3	N.S.A. No. R-4 (FS-2)	1.5
3.1	490	0.005	712.92	710.47	2	3	N.S.A. No. R-4 (FS-2)	1.5
3.2	807	0.005	710.97	706.93	3	3	N.S.A. No. R-4 (FS-2)	1.5
3.3	580	0.005	713.70	710.97	2	3	N.S.A. No. R-4 (FS-2)	1.5
4.1	575	0.005	713.70	710.60	2	3	N.S.A. No. R-4 (FS-2)	1.5
4.2	315	0.005	710.60	708.91	3	3	N.S.A. No. R-4 (FS-2)	1.5
4.3	1110	0.005	714.46	708.91	3	9	N.S.A. No. R-4 (FS-2)	1.5
4.4	480	0.005	716.86	714.46	2.5	3	N.S.A. No. R-4 (FS-2)	1.5
4.5	1815	0.010	695.49	676.83	3	20	N.S.A. No. R-5 (FS-2)	2.5

43  
30  
DETAIL  
PERIMETER DRAINAGE CHANNEL  
SCALE: NTS

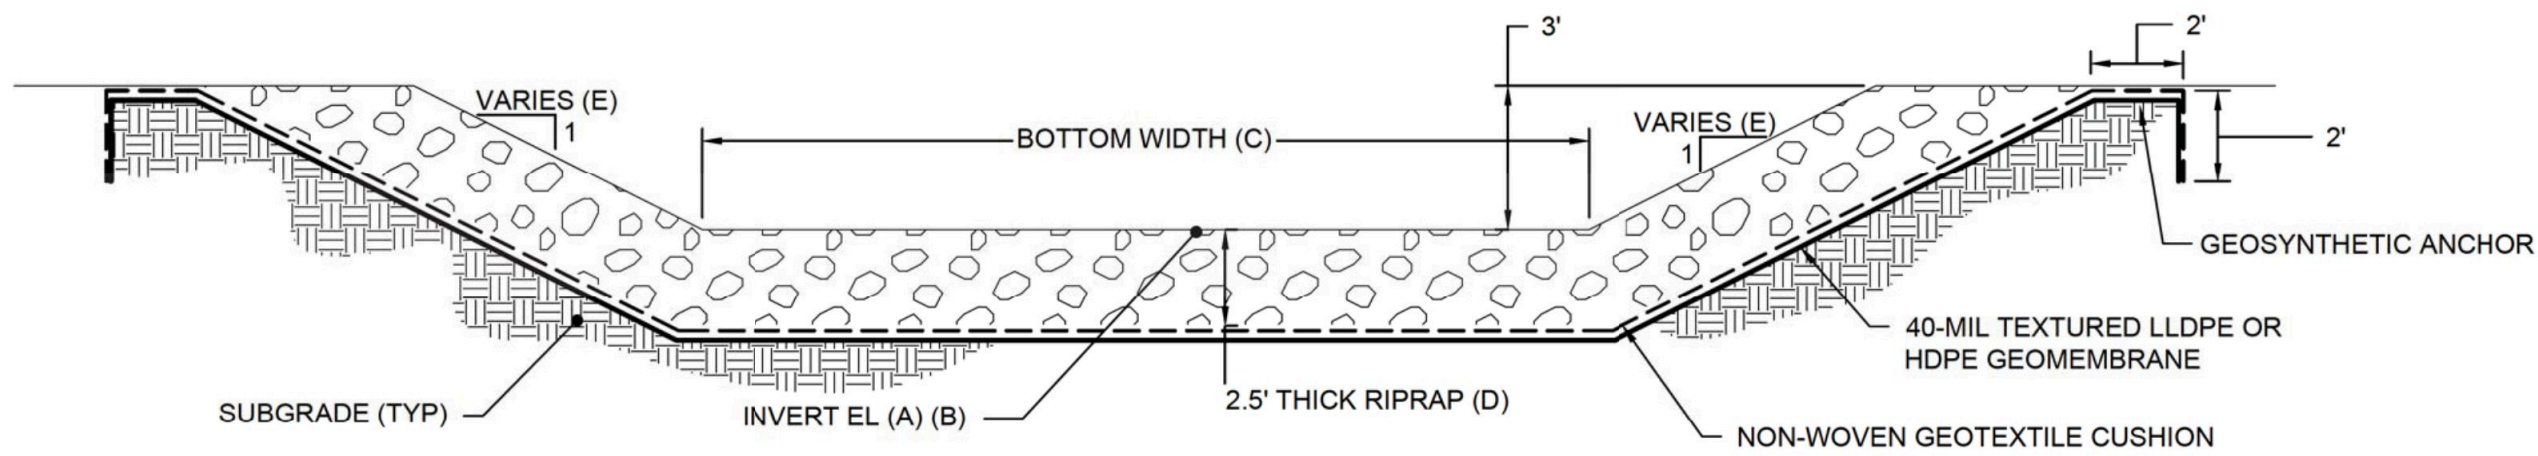

DESIGNATION			(A)	(B)	(C)	(D)	(E)
EXTERIOR DOWNCHUTE ID	LENGTH (FT)	SLOPE (FT/FT)	UPSTREAM INVERT EL (FT)	DOWNSTREAM INVERT EL (FT)	BOTTOM WIDTH (FT)	RIPRAP STONE GRADE (FILTER STONE GRADE) (NOTE 2)	SIDE SLOPE (H:V)
ED-1	110	0.33 (NOTE 7)	709.0	790.0	15	N.S.A. No. R-5 (FS-2)	2:1
ED-2	110	0.33 (NOTE 7)	706.8	790.0	10	N.S.A. No. R-5 (FS-2)	2:1
ED-4	100	0.33	706.6	682.0	5	N.S.A. No. R-5 (FS-2)	2:1
ED-5	100	0.33	708.7	699.9	10	N.S.A. No. R-5 (FS-2)	3:1

45  
38  
DETAIL  
EXTERIOR DOWNCHUTE  
SCALE: NTS

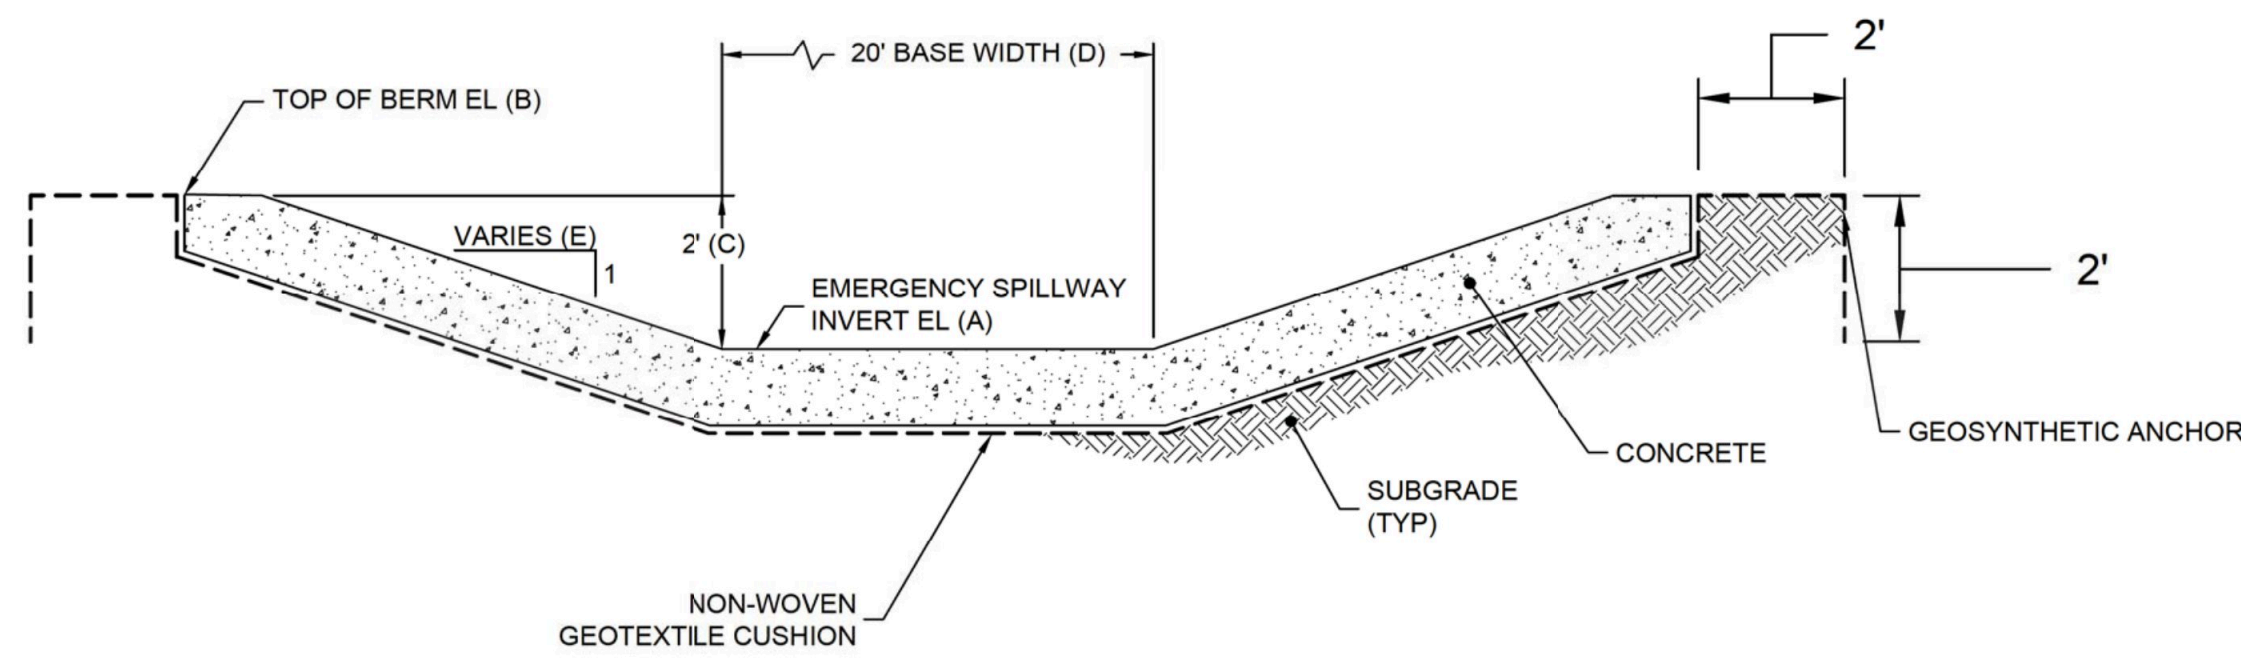

DESIGNATION	(A)	(B)	(C)	(D)	(E)
POND ID	SPILLWAY INV EL (FT)	TOP OF BERM EL (FT)	DEPTH (FT)	BASE WIDTH (FT)	SIDE SLOPE (H:V)
POND 1 EMERGENCY SPILLWAY	698	700	2	20	3:1
POND 2 EMERGENCY SPILLWAY (EXISTING)	685	687	2	20	10:1
POND 3 EMERGENCY SPILLWAY	680	682	2	20	10:1

44  
39  
DETAIL  
EMERGENCY SPILLWAY  
SCALE: NTS


- NOTES:
- GEOSYNTHETIC LAYER THICKNESSES EXAGGERATED FOR CLARITY.
  - N.S.A No. REFERS TO NATIONAL STONE ASSOCIATION RIPRAP AND FILTER STONE GRADATIONS AS PRESENTED IN TABLE C-1 OF THE "MANUAL FOR EROSION AND SEDIMENT CONTROL" (GREEN BOOK).
  - OTHER CHANNEL DIMENSIONS AND LINING SYSTEMS WILL BE ASSESSED DURING THE DETAILED DESIGN BY FOLLOWING THE CHANNEL SIZING PROCEDURES IN THE "FINAL COVER STORMWATER MANAGEMENT SYSTEM DESIGN AND ANALYSIS" AND UTILIZING SUFFICIENT ENERGY DISSIPATION TECHNIQUES WITHIN FHWA CIRCULAR NUMBER 14 (HEC 14).
  - GRADATION REQUIREMENTS AND OTHER MATERIAL PROPERTIES FOR SOIL LAYERS WILL BE PROVIDED IN TECHNICAL SPECIFICATIONS DEVELOPED FOR DETAILED DESIGN.
  - SUBGRADE PREPARATION IN AREAS WHERE GEOMEMBRANE LINER WILL BE INSTALLED WILL CONSIST OF MOISTURE CONDITIONING, COMPACTION, AND SMOOTH ROLLING AS NEEDED.
  - PERIMETER DRAINAGE CHANNEL 4.5 IS CONSTRUCTED OUTSIDE OF THE NEW EARTHEN CONTAINMENT DIKE, AS SHOWN ON DWG 40, AND WILL BE CONSTRUCTED FOLLOWING THE EXTERIOR DOWNCHUTE DETAIL.
  - EXTERIOR DOWNCHUTE 1 AND EXTERIOR DOWNCHUTE 2 WILL BE CONSTRUCTED AT A MINIMUM SLOPE OF 1 PERCENT ALONG THE CORRIDOR BETWEEN THE NEW EARTHEN CONTAINMENT DIKE AND POND 1.



PERMIT DRAWING  
NOT FOR CONSTRUCTION

0	AUG. 2021	SUBMITTAL TO GA EPD	JJ/VKH	RB
REV	DATE	DESCRIPTION	DRN	APP
STORMWATER MANAGEMENT SYSTEM DETAILS V				
PLANT BOWEN ASH POND 1 (AP-1) CLOSURE DRAWINGS BARTOW COUNTY, GEORGIA				
Geosyntec consultants				
1255 ROBERTS BOULEVARD, NW, SUITE 200 KENNESAW, GEORGIA 30144 USA PHONE: 678.202.9600 WWW.GEOSYNTEC.COM				
PROJ. NO.	GR6601	DWG.	GR6601-046	EDIT 08.16.21
SCALE	AS SHOWN	DRAWING 45 OF 50		
DATE	AUGUST 2021			



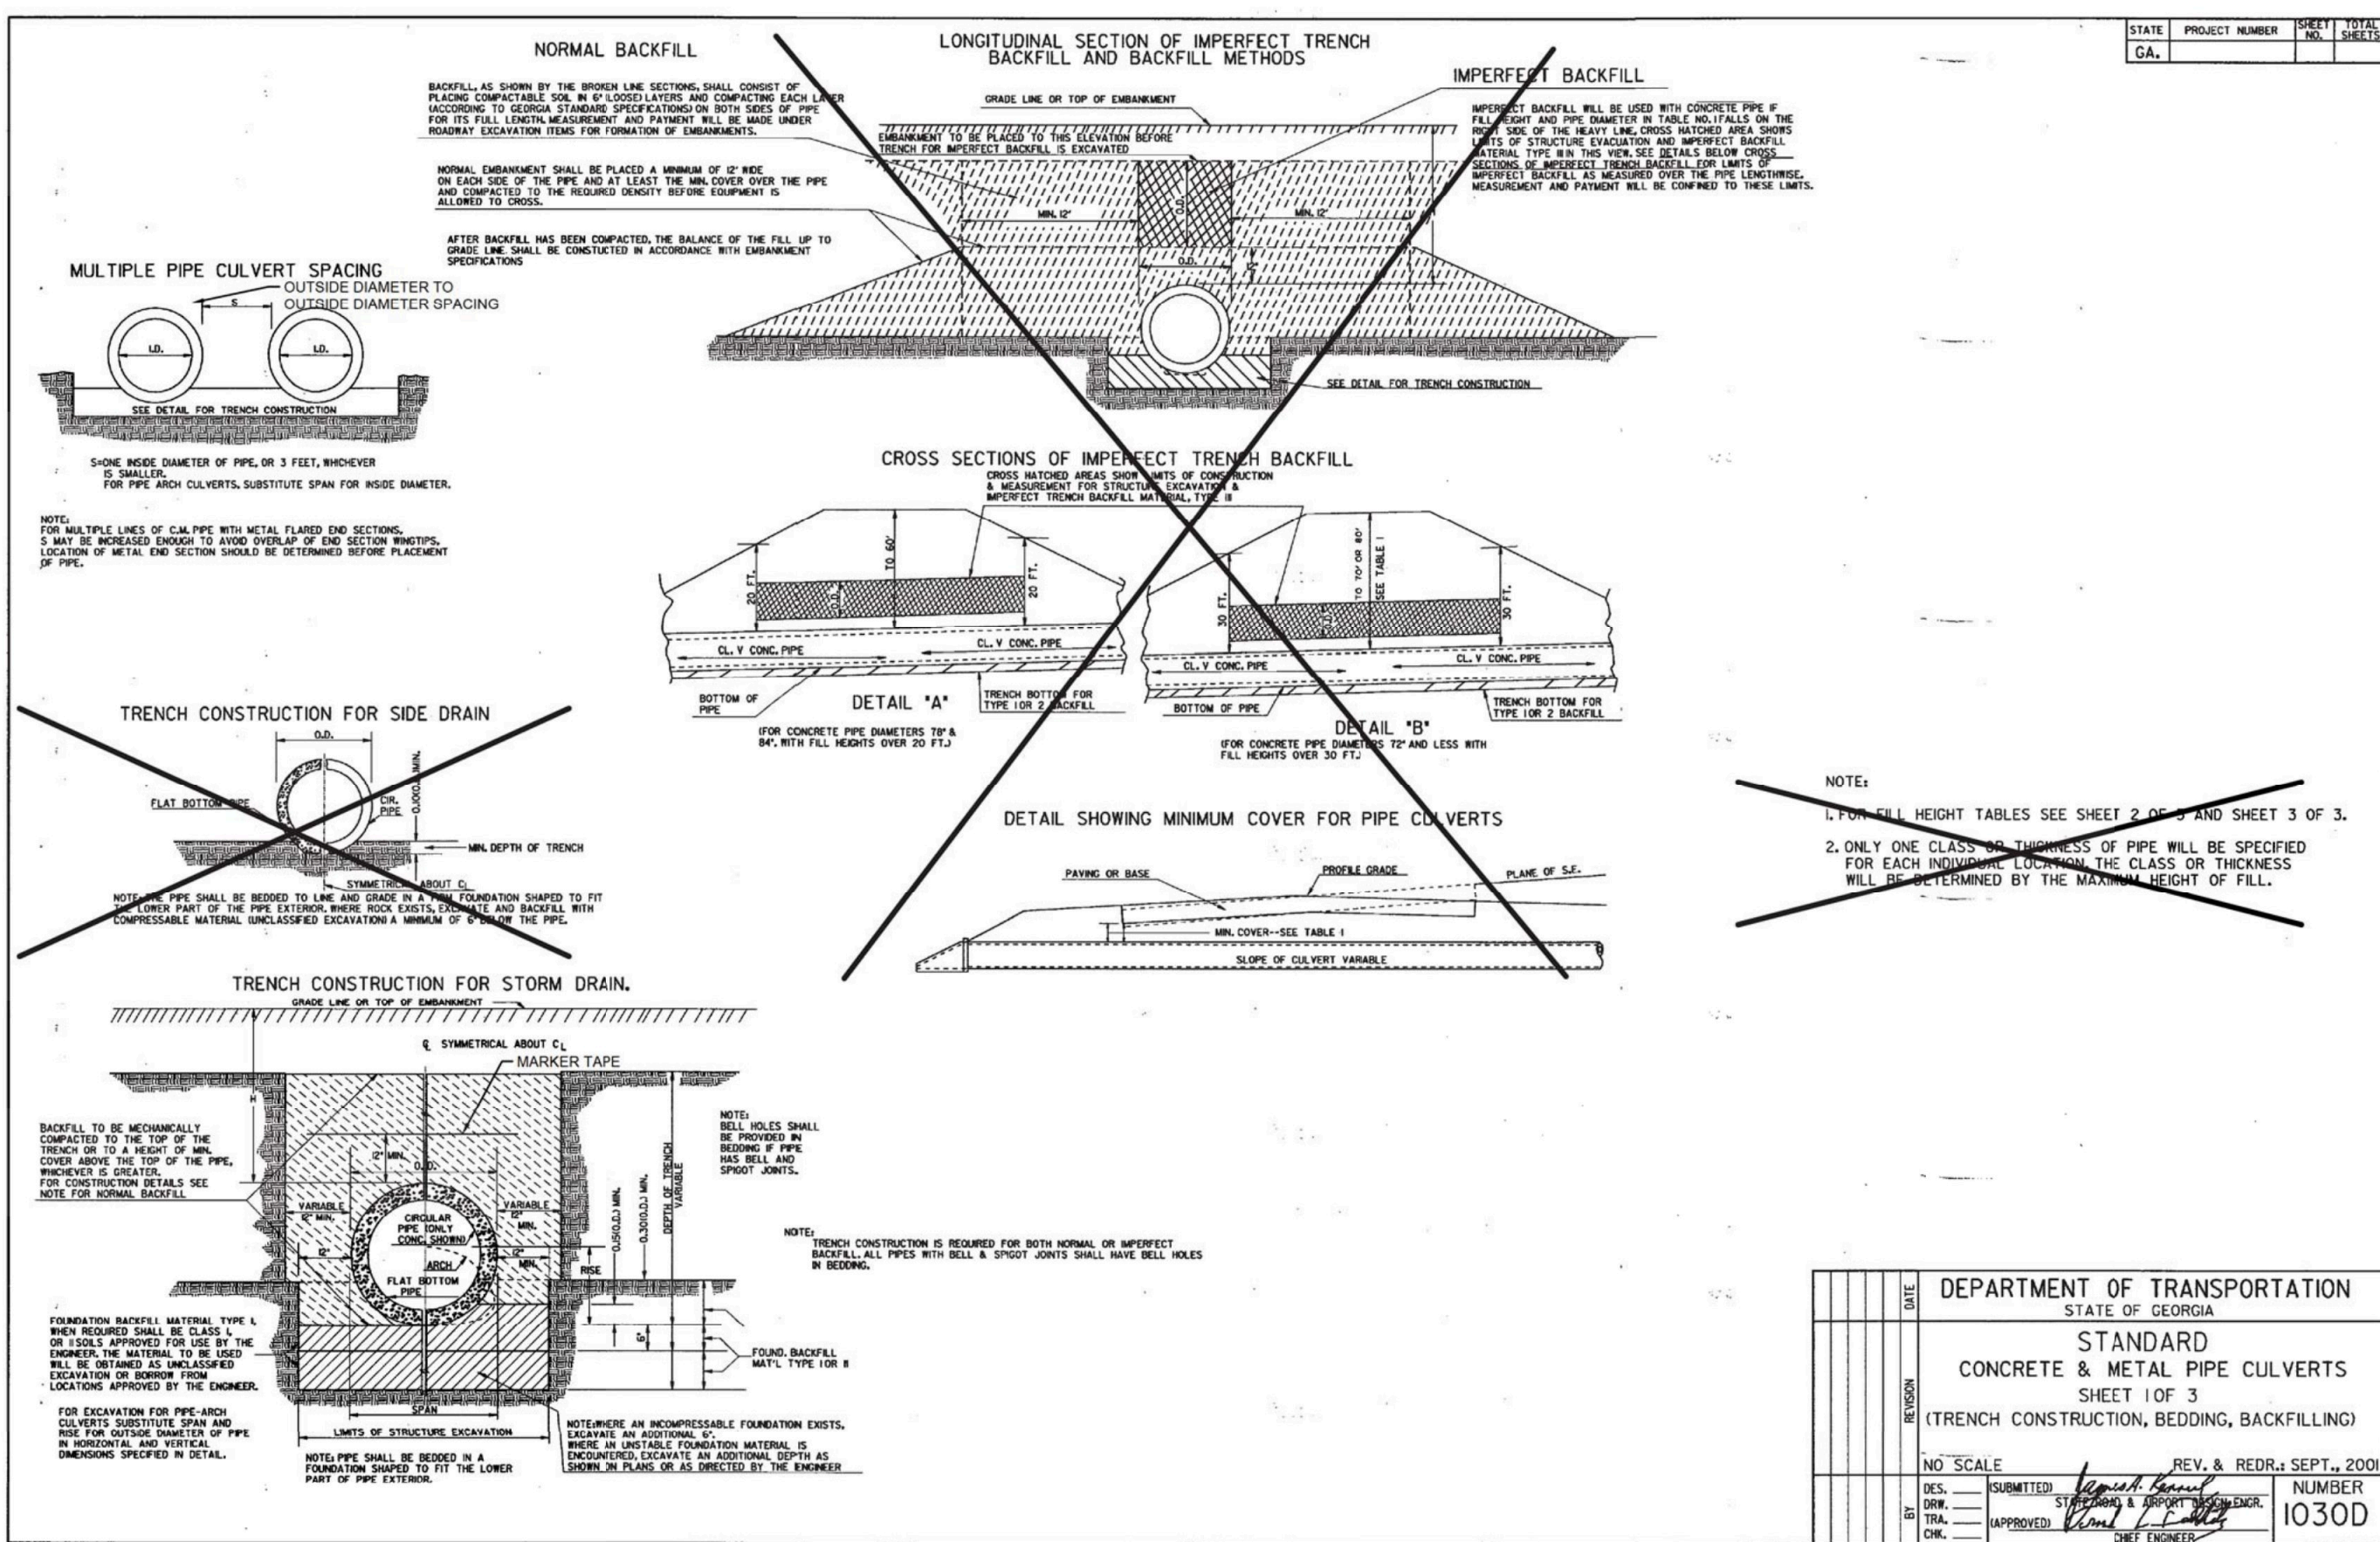

DESIGNATION	(A)	(B)	(C)	(D)	(E)	(F)	(G)	(H)	(I)
OUTLET ID	OUTLET TYPE	UPSTREAM APRON WIDTH (FT)	DOWNSTREAM APRON WIDTH (FT)	LENGTH OF APRON (FT)	PIPE DIAMETER OR TOP-OF-CHANNEL WIDTH x DEPTH (FT)	d50 (in.)	dmax (in.)	DEPTH OF APRON (FT)	RIPRAP STONE GRADE (FILTER STONE GRADE) (NOTE 3)
POND 1 PRINCIPAL SPILLWAY PIPE	RCP	6	20	15	2.0	6	12	1.5	N.S.A. No. R-4 (FS-2)
POND 3 PRINCIPAL SPILLWAY PIPE	RCP	7.5	20	20	2.5	6	12	1.5	N.S.A. No. R-4 (FS-2)
POND 1 EMERGENCY SPILLWAY	CONCRETE TRAPEZOIDAL CHANNEL	32	32	25	(32 x 2)	9	18	2.5	N.S.A. No. R-5 (FS-2)
POND 3 EMERGENCY SPILLWAY	CONCRETE TRAPEZOIDAL CHANNEL	60	60	25	(60 x 2)	9	18	2.5	N.S.A. No. R-5 (FS-2)
PERIMETER CHANNEL 4.5	RIPRAP-LINED TRAPEZOIDAL CHANNEL	40	45	35	(38 x 3)	9	18	2.5	N.S.A. No. R-5 (FS-2)
EXTERIOR DOWNCHUTE 1	RIPRAP-LINED TRAPEZOIDAL CHANNEL	30	40	35	(27 x 3)	9	18	2.5	N.S.A. No. R-5 (FS-2)
EXTERIOR DOWNCHUTE 2	RIPRAP-LINED TRAPEZOIDAL CHANNEL	25	40	35	(22 x 3)	9	10	2.5	N.S.A. No. R-5 (FS-2)
EXTERIOR DOWNCHUTE 4	RIPRAP-LINED TRAPEZOIDAL CHANNEL	20	40	35	(17 x 3)	9	18	2.5	N.S.A. No. R-5 (FS-2)
EXTERIOR DOWNCHUTE 6	RIPRAP-LINED TRAPEZOIDAL CHANNEL	25	40	35	(22 x 3)	9	18	2.5	N.S.A. No. R-5 (FS-2)

SECTION 47  
PIPE EMBEDMENT

SCALE: NTS  
SOURCE: GDOT

PERIMETER DRAINAGE CHANNEL  
RIPRAP LINING

UPSTREAM STORMWATER PIPE  
PENETRATION (G)

INLET INV EL (D)

PERIMETER DRAINAGE  
CHANNEL

NON-WOVEN GEOTEXTILE  
CUSHION AND 40-MIL TEXTURED  
LLDPE OR HDPE GEOMEMBRANE  
(TYP)

FINISHED GRADE

STORMWATER PIPE (A) (B) (C)

1.5' (MIN)

PERIMETER ROAD

SLOPE (F)

DOWNSTREAM STORMWATER PIPE  
PENETRATION (H)

OUTLET INV EL (E)

TOP OF EXTERIOR DOWNCHUTE  
SHOWN FOR CLARITY

PIPE EMBEDMENT

HEADWALL

EXTERIOR DOWNCHUTE

TYPICAL PERIMETER LINER AND FINAL  
COVER TERMINATION

43  
45

47  
46

48  
46

15  
30


45  
45

NOTES:

1. RIPRAP OUTLET PROTECTION WILL BE LINED WITH A 40-MIL (MIN) TEXTURED LLDPE OR HDPE GEOMEMBRANE OVERLAIN WITH A GEOTEXTILE CUSHION.
2. SUBGRADE PREPARATION IN AREAS WHERE GEOMEMBRANE LINER WILL BE INSTALLED WILL CONSIST OF MOISTURE CONDITIONING, COMPACTION, AND SMOOTH ROLLING AS NEEDED.
3. N.S.A No. REFERS TO NATIONAL STONE ASSOCIATION RIPRAP AND FILTER STONE GRADATIONS AS PRESENTED IN TABLE C-1 OF THE "MANUAL FOR EROSION AND SEDIMENT CONTROL" (GREEN BOOK).


1255 ROBERTS BOULEVARD, NW, SUITE 200 KENNESAW, GEORGIA 30144 USA		PHONE: 678.202.9500 WWW.GEOSYNTEC.COM	
PROJ. NO.	GR6601	DWG.	GR6601-048
SCALE	AS SHOWN	EDIT	08.16.21
DATE	AUGUST 2021	DRAWING 46 OF 50	



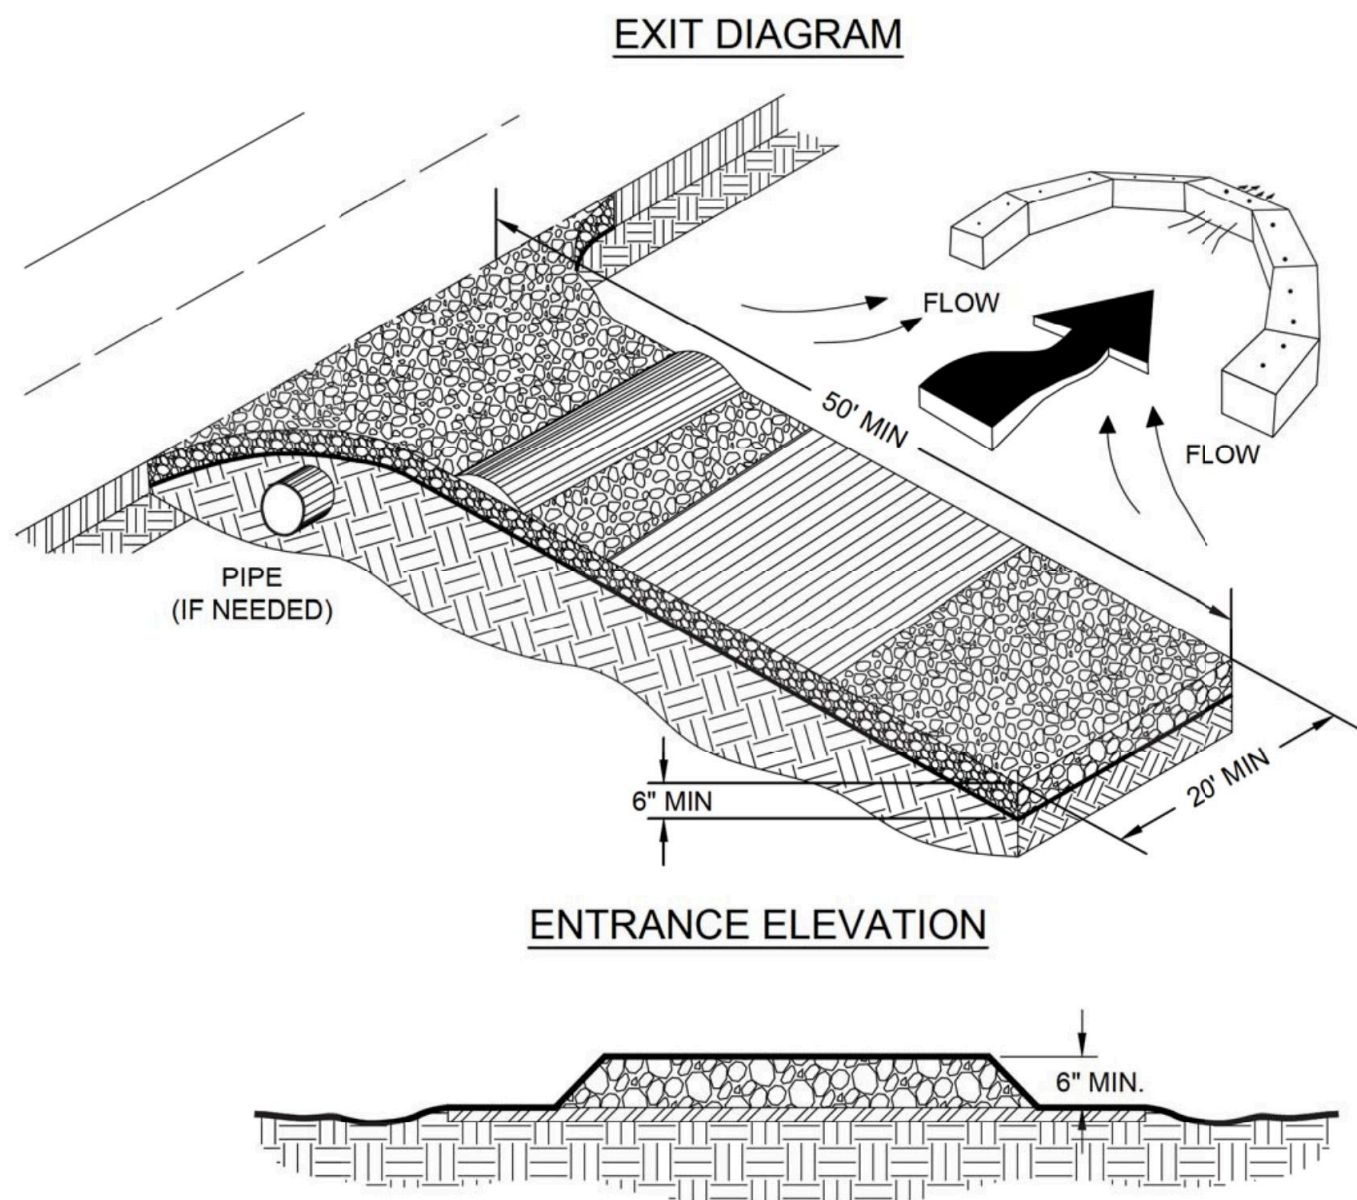

- NOTES:**
1. AVOID LOCATING ON STEEP SLOPES OR AT CURVES ON PUBLIC ROADS.
  2. REMOVE ALL VEGETATION AND OTHER UNSUITABLE MATERIAL FROM THE FOUNDATION AREA, GRADE, AND CROWN FOR POSITIVE DRAINAGE.
  3. AGGREGATE SIZE SHALL BE IN ACCORDANCE WITH NATIONAL STONE ASSOCIATION R-2 (1.5"-3.5" STONE).
  4. GRAVEL PAD SHALL HAVE A MINIMUM THICKNESS OF 6".
  5. PAD WIDTH SHALL EQUAL FULL WIDTH AT ALL POINTS OF VEHICULAR EGRESS, BUT NO LESS THAN 20'.
  6. A DIVERSION RIDGE SHOULD BE CONSTRUCTED WHEN GRADE TOWARD PAVED AREA IS GREATER THAN 2%.
  7. INSTALL PIPE UNDER THE ENTRANCE IF NEEDED TO MAINTAIN DRAINAGE DITCHES.
  8. WHEN WASHING IS REQUIRED, IT SHOULD BE DONE ON AN AREA STABILIZED WITH CRUSHED STONE THAT DRAINS INTO AN APPROVED SEDIMENT TRAP OR SEDIMENT BASIN (DIVERT ALL SURFACE RUNOFF AND DRAINAGE FROM THE ENTRANCE TO A SEDIMENT CONTROL DEVICE).
  9. WASHRACKS AND/OR TIRE WASHERS MAY BE REQUIRED DEPENDING ON SCALE AND CIRCUMSTANCE. IF NECESSARY, WASHRACK DESIGN MAY CONSIST OF ANY MATERIAL SUITABLE FOR TRUCK TRAFFIC THAT REMOVES MUD AND DIRT.
  10. MAINTAIN AREA IN A WAY THAT PREVENTS TRACKING AND/OR FLOW OF MUD ONTO PUBLIC RIGHTS-OF-WAYS. THIS MAY REQUIRE TOP DRESSING, REPAIR AND/OR CLEANOUT OF ANY MEASURES USED TO TRAP SEDIMENT.

**Co** **50** **DETAIL**  
**CONSTRUCTION EXIT**  
SCALE: NTS  
SOURCE: GSWCC

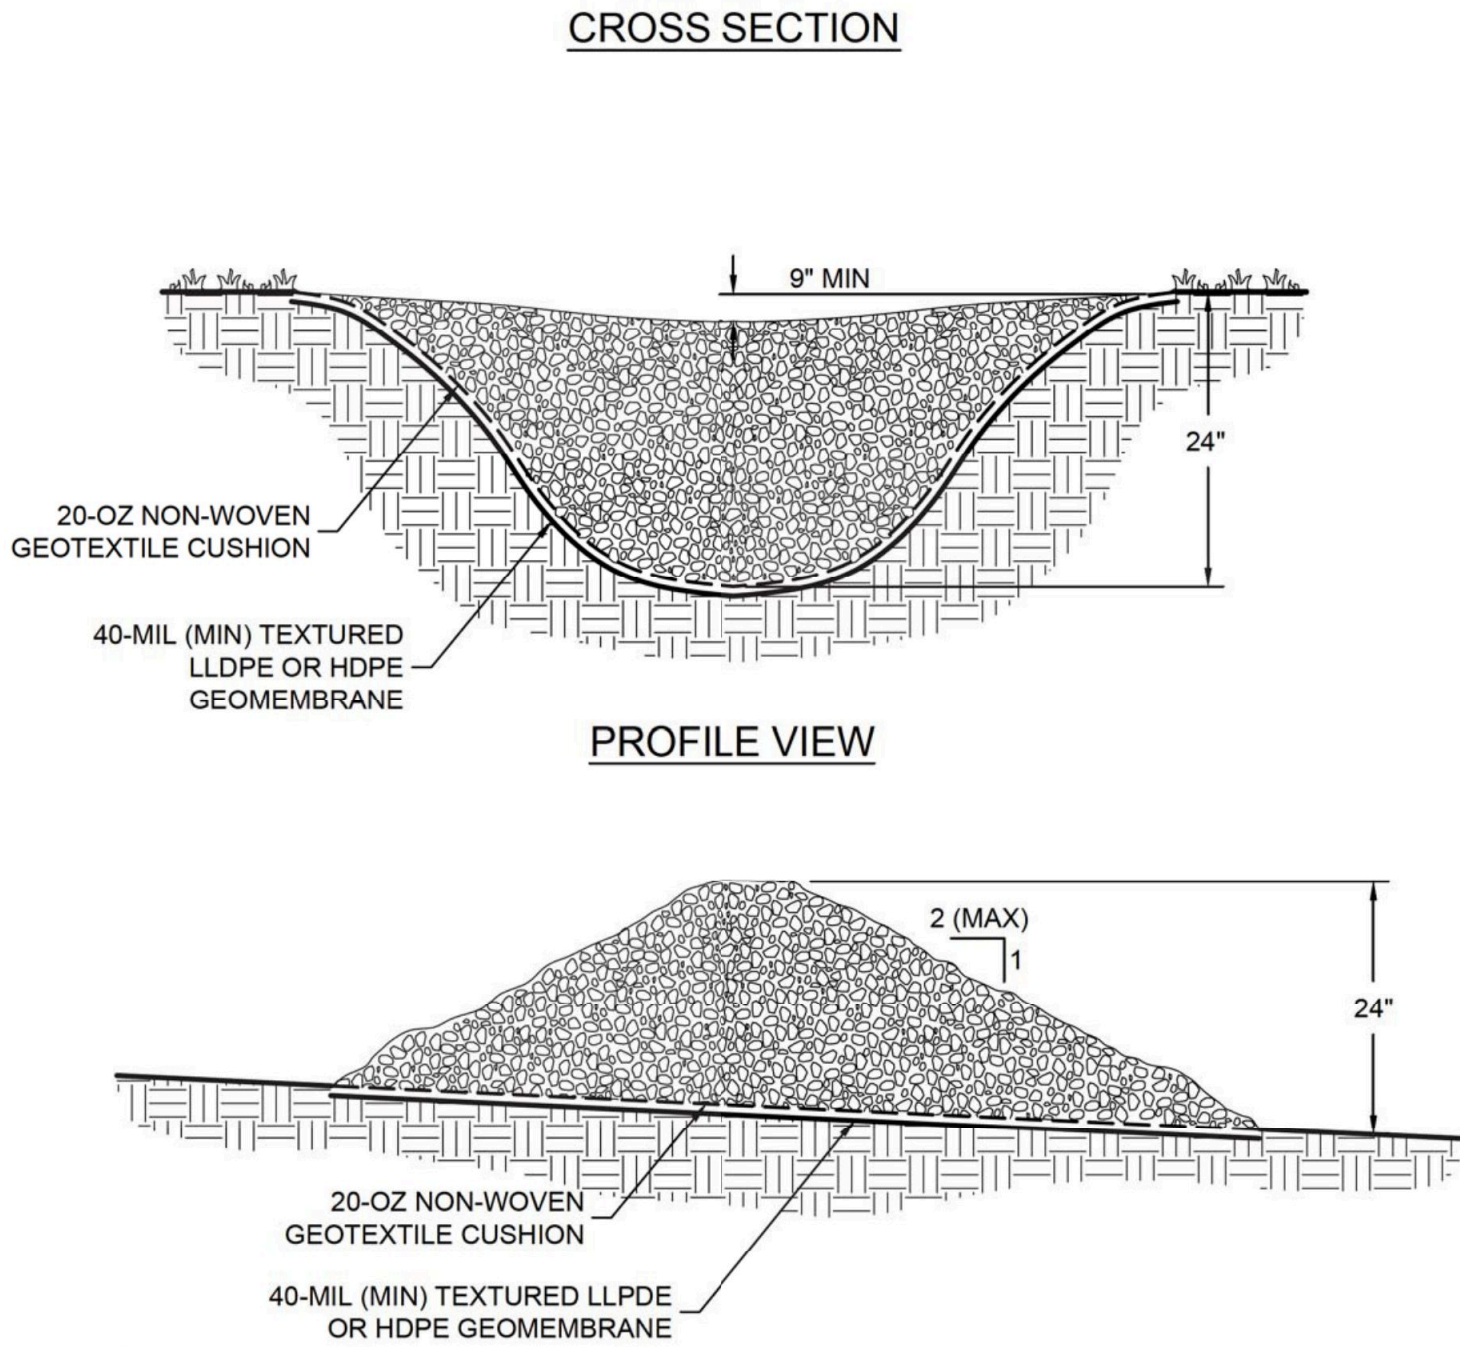

- NOTES:**
1. CHECK DAMS ARE TO BE USED ONLY IN SMALL OPEN CHANNELS (THEY ARE NOT TO BE USED IN LIVE STREAMS).
  2. THE DRAINAGE AREA FOR STONE CHECK DAMS SHALL NOT EXCEED TWO ACRES.
  3. THE CENTER OF THE CHECK DAM MUST BE AT LEAST 9 INCHES LOWER THAN THE OUTER EDGES.
  4. THE DAM HEIGHT SHOULD BE A MAXIMUM OF 2 FEET FROM CENTER TO RIM EDGE.
  5. THE SIDE SLOPES OF THE CHECK DAM SHALL NOT EXCEED A 2:1 SLOPE.
  6. GEOTEXTILE SHALL BE USED TO PREVENT THE MITIGATION OF SUBGRADE SOIL PARTICLES INTO THE STONES (REFER TO AASHTO M288-96, SECTION 7.3, TABLE 3).
  7. CHECK DAMS SHALL BE SPACED 250 FT APART.

**Cd** **53** **DETAIL**  
**STONE CHECK DAM**  
SCALE: NTS  
SOURCE: GSWCC

**CONDITIONS**  
THIS PRACTICE IS APPLICABLE TO AREAS SUBJECT TO SURFACE AND AIR MOVEMENT OF DUST WHERE ON AND OFF-SITE DAMAGE MAY OCCUR WITHOUT TREATMENT.

**METHODS AND MATERIALS**  
A. TEMPORARY METHODS

MULCHES. SEE SPECIFICATION Ds1 - DISTURBED AREA STABILIZATION (WITH MULCHING ONLY).


VEGETATIVE COVER. SEE SPECIFICATION Ds2 - DISTURBED AREA STABILIZATION (WITH TEMPORARY SEEDING).

B. PERMANENT METHODS

PERMANENT VEGETATION. SEE SPECIFICATION Ds3 - DISTURBED AREA STABILIZATION (WITH PERMANENT VEGETATION). EXISTING TREES AND LARGE SHRUBS MAY AFFORD VALUABLE PROTECTION IF LEFT IN PLACE.

TOPSOILING. SEE SPECIFICATION Tp - TOPSOILING.




**Du** **51** **DETAIL**  
**DUST CONTROL ON DISTURBED AREAS**  
SCALE: NTS  
SOURCE: GSWCC

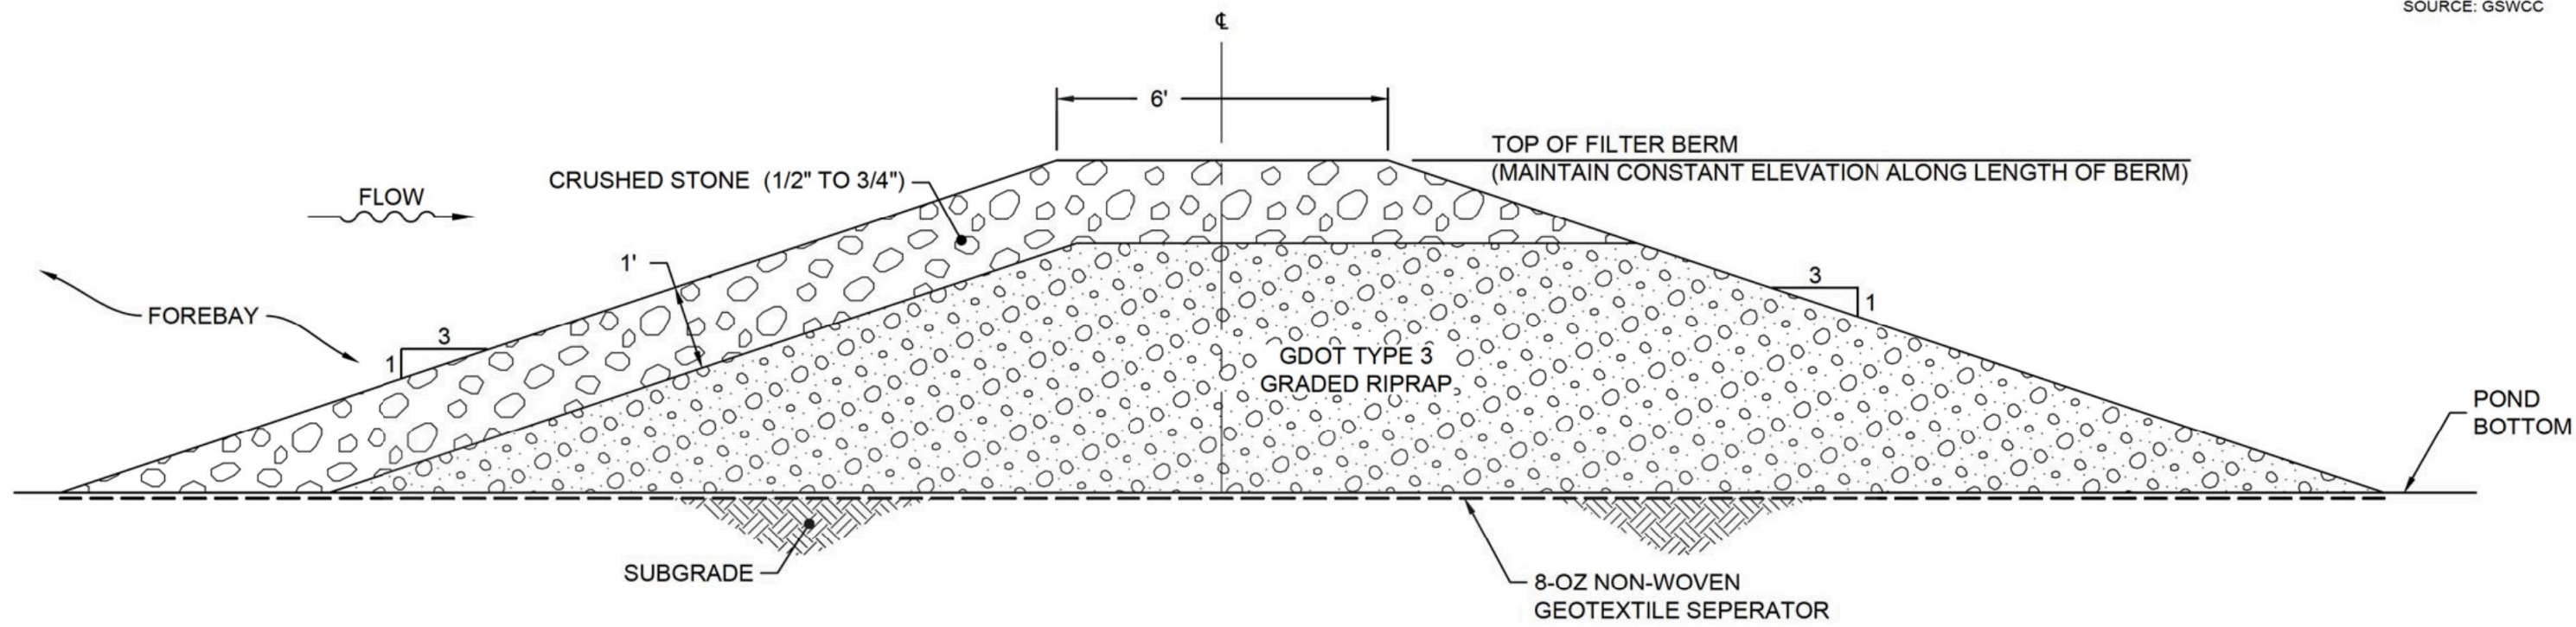

**54** **DETAIL**  
**39** **FILTER BERM**  
SCALE: NTS



- GENERAL EROSION AND SEDIMENT CONTROL NOTES**
1. ALL EROSION CONTROL MEASURES SHALL BE IN CONFORMANCE WITH THE CURRENT EDITION OF THE "MANUAL FOR EROSION AND SEDIMENT CONTROL IN GEORGIA." STORMWATER CONTROLS AND BEST MANAGEMENT PRACTICES SHALL BE DESIGNED, INSTALLED AND MAINTAINED IN ACCORDANCE WITH THE APPLICABLE NPDES CONSTRUCTION STORMWATER DISCHARGE GENERAL PERMIT, NPDES INDUSTRIAL STORMWATER DISCHARGE GENERAL PERMIT AND/OR THE FACILITY'S NPDES INDUSTRIAL WASTEWATER DISCHARGE INDIVIDUAL PERMIT.
  2. STORM WATER DISCHARGES ASSOCIATED WITH ASH POND CLOSURE ACTIVITIES WILL BE COVERED UNDER THE APPLICABLE NPDES CONSTRUCTION STORMWATER DISCHARGE GENERAL PERMIT, NPDES INDUSTRIAL STORMWATER DISCHARGE GENERAL PERMIT AND/OR THE FACILITY'S NPDES INDUSTRIAL WASTEWATER DISCHARGE INDIVIDUAL PERMIT.
  3. STATE WATERS BUFFERS SHALL REMAIN UNDISTURBED, EXCEPT WHERE ENCROACHMENT IS REQUIRED TO FACILITATE ASH POND CLOSURE ACTIVITIES. UNLESS OTHERWISE EXEMPTED BY THE APPROPRIATE NPDES CONSTRUCTION STORMWATER DISCHARGE GENERAL PERMIT, A STATE WATERS BUFFER VARIANCE SHALL BE OBTAINED FROM GEORGIA EPD'S WATERSHED PROTECTION BRANCH PRIOR TO BUFFER ENCROACHMENT. GEORGIA EPD'S SOLID WASTE MANAGEMENT BRANCH SHALL BE NOTIFIED WHEN GPC ENVIRONMENTAL AFFAIRS APPLIES FOR A STATE WATERS BUFFER VARIANCE. CONTACT GPC ENVIRONMENTAL AFFAIRS FOR ASSISTANCE.
  4. PRIOR TO COMMENCING CONSTRUCTION ACTIVITIES FOR THIS PROJECT, THE PERMITTED BOUNDARY, THE LIMITS OF DISTURBANCE AND ALL WETLANDS AND STATE WATERS BUFFERS WITHIN 200 FEET OF THE LIMITS OF DISTURBANCE OR WITHIN THE PROPERTY BOUNDARY (WHICHEVER IS CLOSER) SHALL BE CLEARLY FLAGGED AND STAKED. THESE MARKINGS SHALL BE MAINTAINED UNTIL COMPLETION OF CONSTRUCTION / CLOSURE ACTIVITIES. SHOULD ANY OF THE MARKINGS BE DISTURBED, THE CONTRACTOR SHALL NOTIFY GEORGIA POWER COMPANY IMMEDIATELY. ALL CONSTRUCTION PERSONNEL SHALL BE SHOWN THE LOCATION OF THE LIMITS OF DISTURBANCE, STATE WATER BUFFERS, STATE WATERS AND WETLANDS OUTSIDE THE LIMITS OF DISTURBANCE TO PREVENT HEAVY EQUIPMENT ENCROACHMENT INTO THESE AREAS.

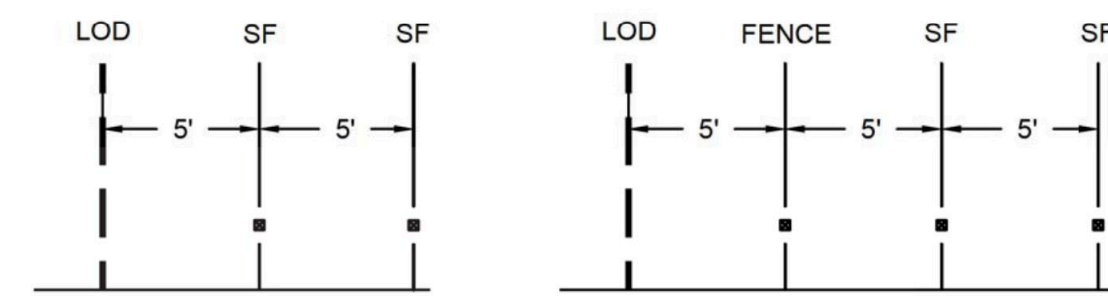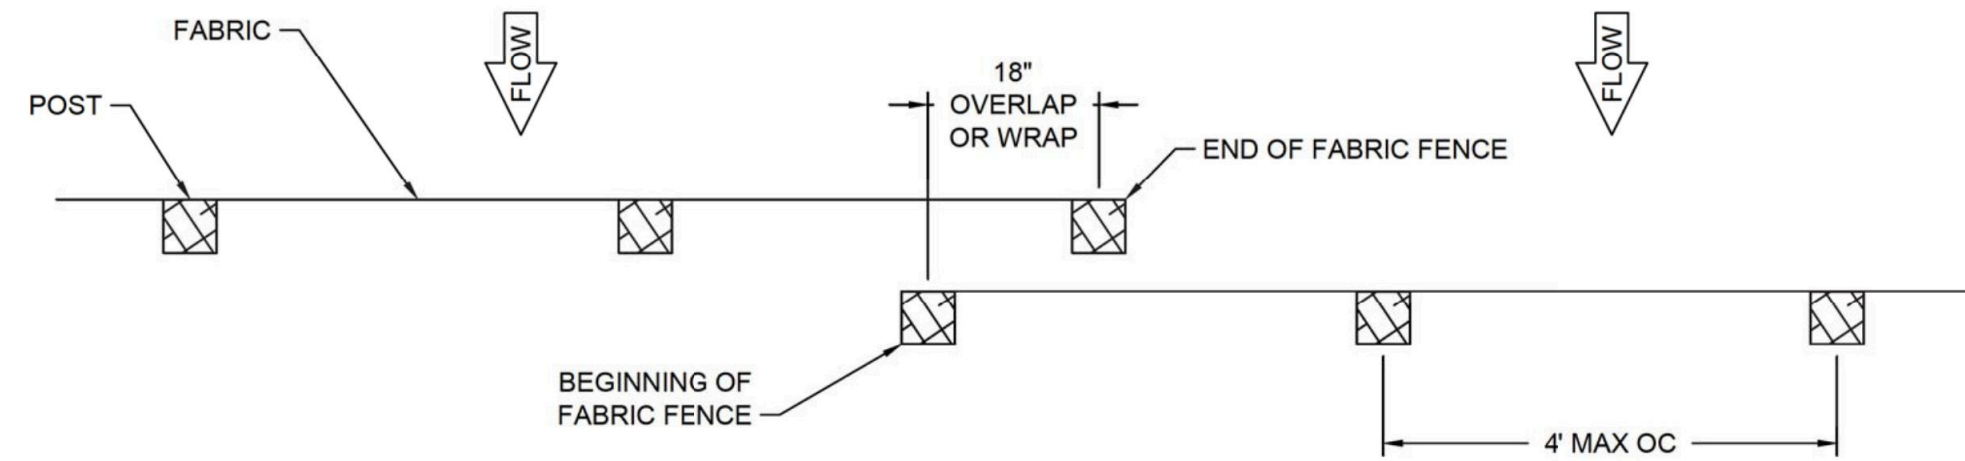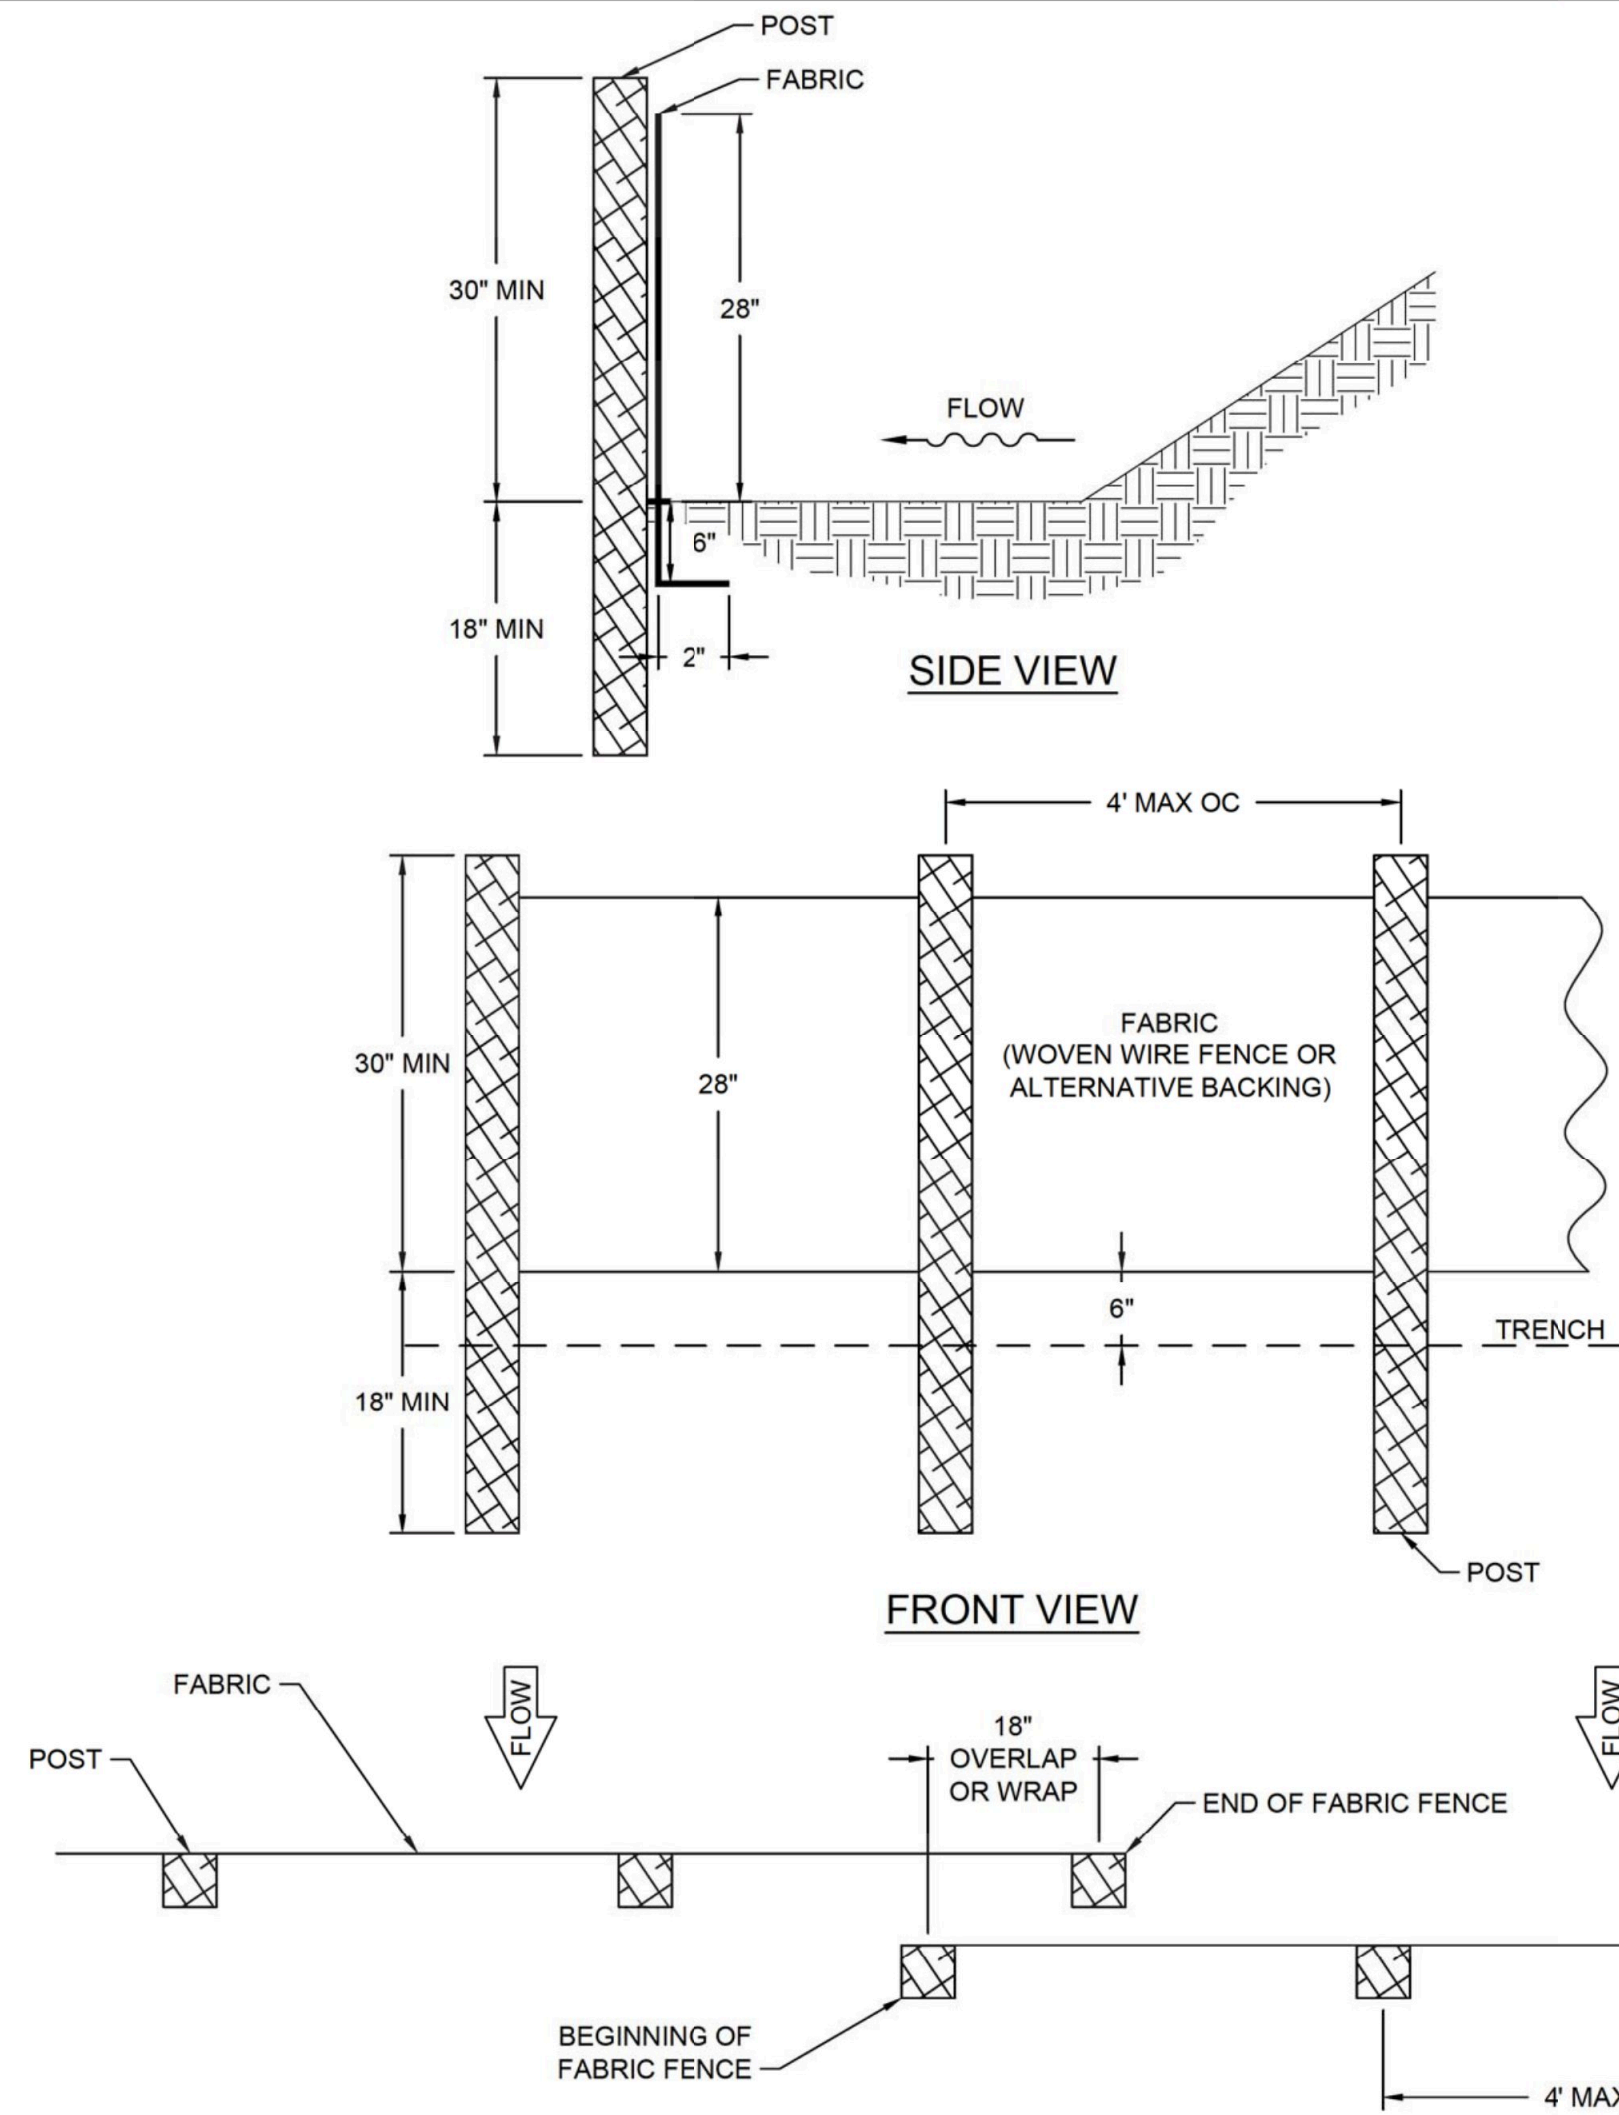

CRITERIA FOR SILT FENCE PLACEMENT	
LAND SLOPE (PERCENT)	MAXIMUM LENGTH OF SLOPE ABOVE FENCE (FEET)
<2	100
2 TO 5	75
5 TO 10	50
10 TO 20	25
>20	15

**SILT FENCE SPACING**

- SILT FENCE NOTES:**
1. ALL SILT FENCE SHOWN ON THE PLANS IS TO BE DOUBLE ROW TYPE "C" BARRIER. CONTRACTOR SHALL MAINTAIN FENCE AT THESE LOCATIONS DURING CONSTRUCTION UNTIL FINAL SURFACE TREATMENTS HAVE BEEN APPLIED AND A SUFFICIENT STAND OF GRASS HAS BEEN ESTABLISHED AS DETERMINED BY THE SITE ENGINEER.
  2. ADDITIONAL SILT FENCE SHALL BE REQUIRED IN AREAS WHICH ARE CLEARED OR GRADED AND DO NOT HAVE STORMWATER RUNOFF DIVERTED TO SEDIMENT BASINS MEETING THE CRITERIA LISTED IN THE TABLES. THE DRAINAGE AREA SHALL NOT EXCEED 1/4 ACRE FOR EVERY 100 FEET OF SILT FENCE.

- INSTALLATION:**
1. WHERE NO SEDIMENT TRAP/STORMWATER DISPOSAL SYSTEM IS PRESENT, MAXIMUM SLOPE LENGTH SHALL NOT EXCEED THAT IN THE TABLE. ALSO, THE DRAINAGE AREA IS NOT TO EXCEED 1/4 ACRE PER 100 FEET OF SILT FENCE.
  2. INSTALL ALONG CONTOURS WITH ENDS POINTING UPHILL.
  3. DO NOT PLACE IN WATERWAYS OR AREAS OF CONCENTRATED FLOW.
  4. PROVIDE A RIPRAP SPLASH PAD OR OTHER OUTLET PROTECTION DEVICE FOR ANY POINT WHERE FLOW MAY TOP THE SEDIMENT FENCE. ENSURE THAT THE MAXIMUM HEIGHT OF THE FENCE AT A PROTECTED, REINFORCED OUTLET DOES NOT EXCEED 1 FT AND THAT SUPPORT POST SPACING DOES NOT EXCEED 4 FT FOR TYPE C.
  5. SAFETY CAPS ARE REQUIRED FOR ALL STEEL POSTS.
  6. POSTS SHALL BE STEEL AND HAVE A MINIMUM LENGTH OF 4 FEET. POSTS SHALL BE "U", "T", OR "C" SHAPED AND HAVE A MINIMUM WEIGHT OF 1.3 POUNDS PER FOOT. THE POSTS SHALL HAVE PROJECTIONS FOR FASTENING THE WOVEN WIRE AND FILTER FABRIC. MAXIMUM POSTS SPACING SHALL BE 4 FEET FOR TYPE C.
  7. A WOVEN WIRE SUPPORT FENCE SHALL BE USED WITH TYPE "C" FENCE. THE WIRE FENCE FABRIC SHALL BE AT LEAST 36 INCHES HIGH AND SHALL HAVE AT LEAST 6 HORIZONTAL WIRES. VERTICAL WIRES SHALL HAVE A MAXIMUM SPACING OF 12 INCHES. THE TOP AND BOTTOM WIRES SHALL BE AT LEAST 10 GAUGE AND ALL OTHER WIRES SHALL BE AT LEAST 12 1/2 GAUGE.
  8. APPROVED SILT FENCE FABRICS ARE LISTED IN THE GEORGIA DEPARTMENT OF TRANSPORTATION QUALIFIED PRODUCTS LIST #36 (QPL-36).

**Sd1-S** **52** **DETAIL**  
**SILT FENCE - TYPE C**  
SCALE: NTS  
SOURCE: GSWCC




**PERMIT DRAWING**  
**NOT FOR CONSTRUCTION**

0	AUG. 2021	SUBMITTAL TO GA EPD	JJ/VKH	RB
REV	DATE	DESCRIPTION	DRN	APP
EROSION AND SEDIMENT CONTROL DETAILS I				
PLANT BOWEN ASH POND 1 (AP-1) CLOSURE DRAWINGS BARTOW COUNTY, GEORGIA				
<b>Geosyntec</b> consultants				
1255 ROBERTS BOULEVARD, NW, SUITE 200 KENNESAW, GEORGIA 30144 USA				
PHONE: 678.202.9600 WWW.GEOSYNTEC.COM				
PROJ. NO.	GR6601	DWG.	GR6601-049	EDIT 08.16.21
SCALE	AS SHOWN	DRAWING 47 OF 50		
DATE	AUGUST 2021			




TYPICAL INSTALLATION GUIDELINES FOR  
ROLLED EROSION CONTROL PRODUCTS  
(RECP)

BLANKET AND MATTING CROSS-SECTIONS

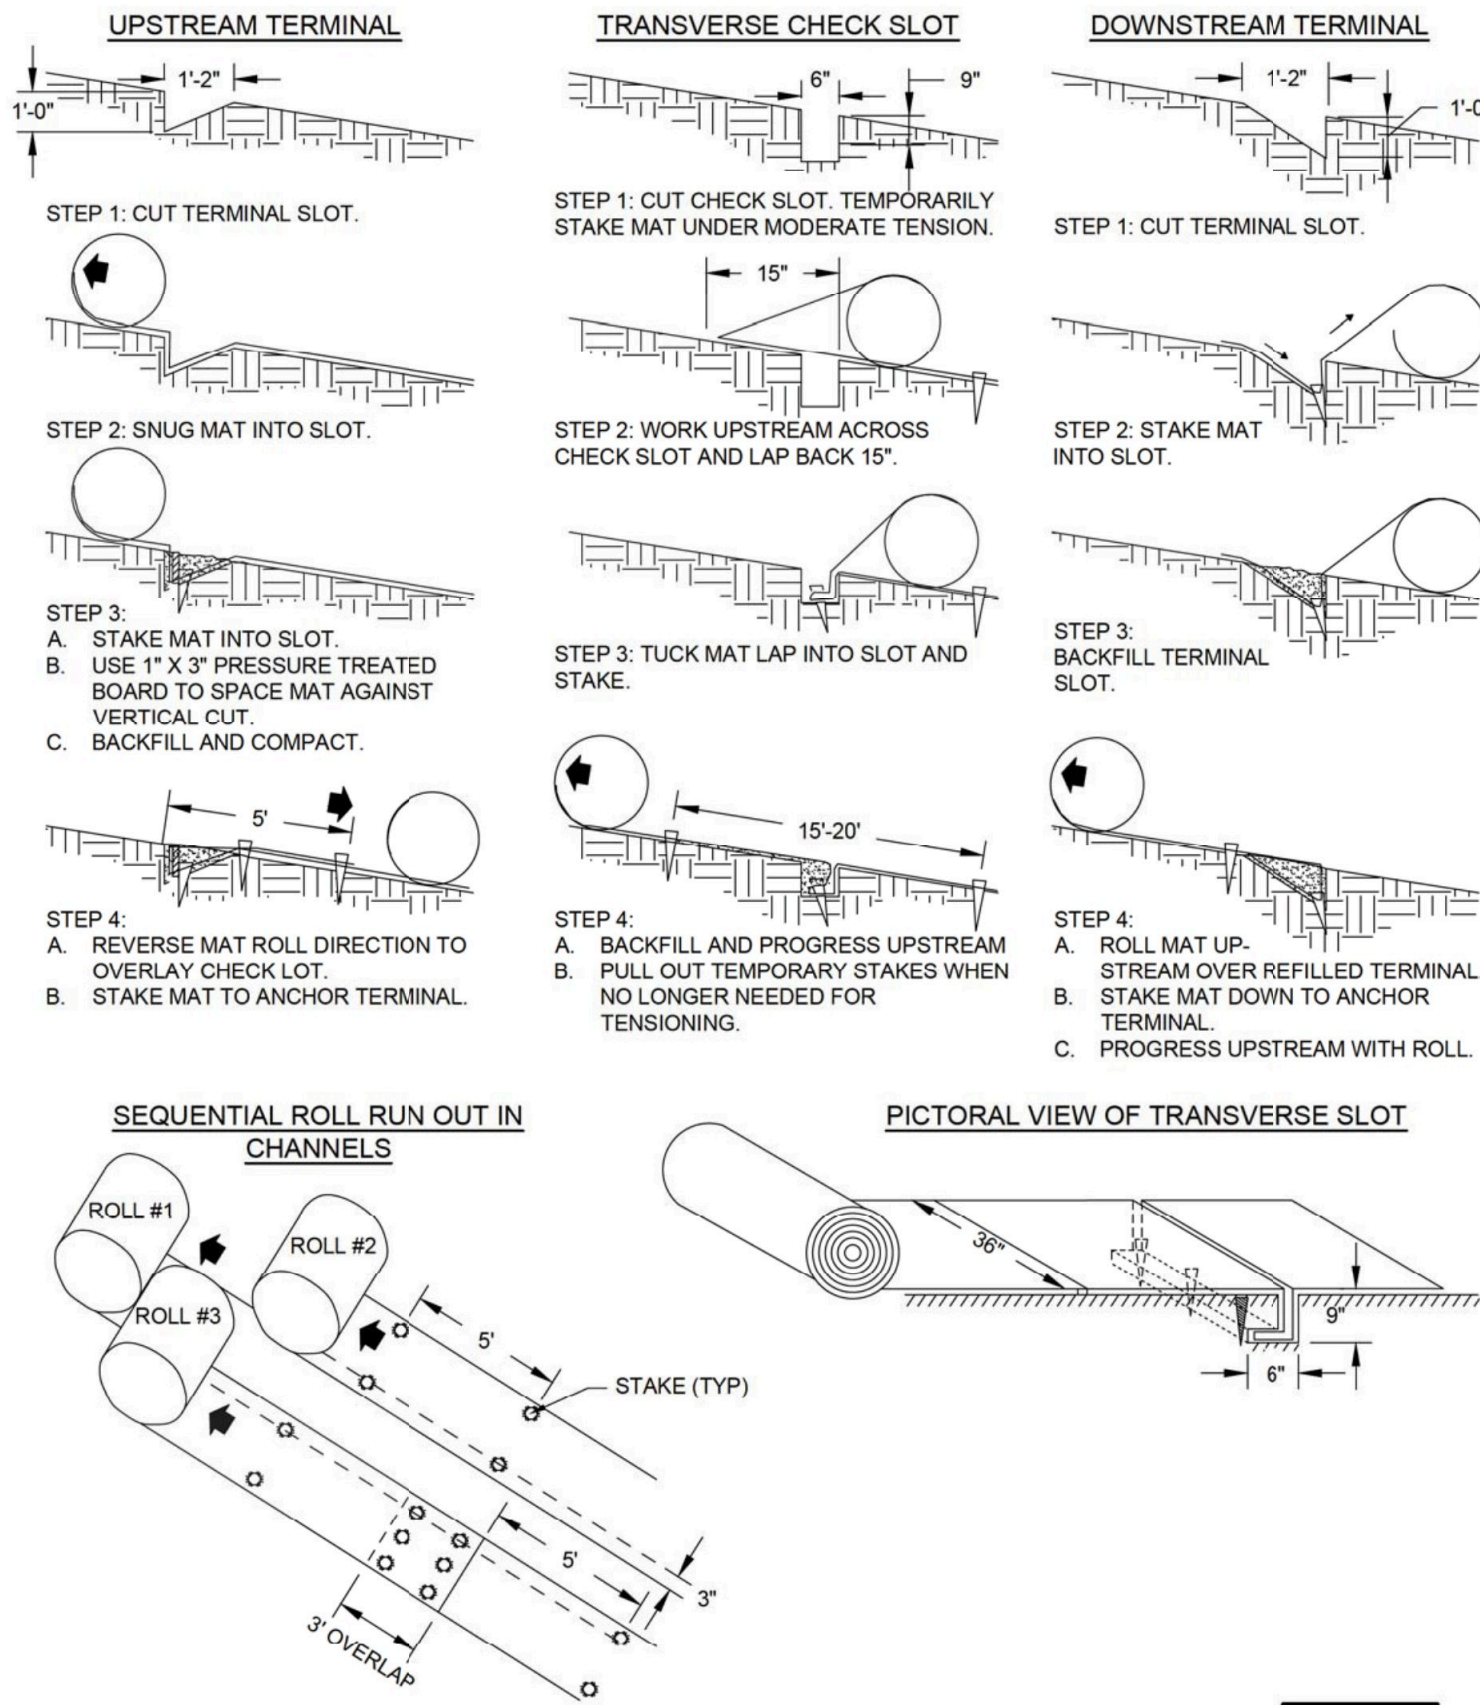

55 - DETAIL  
SLOPE STABILIZATION  
SCALE: NTS  
SOURCE: GWSCC

Channel Installation Detail

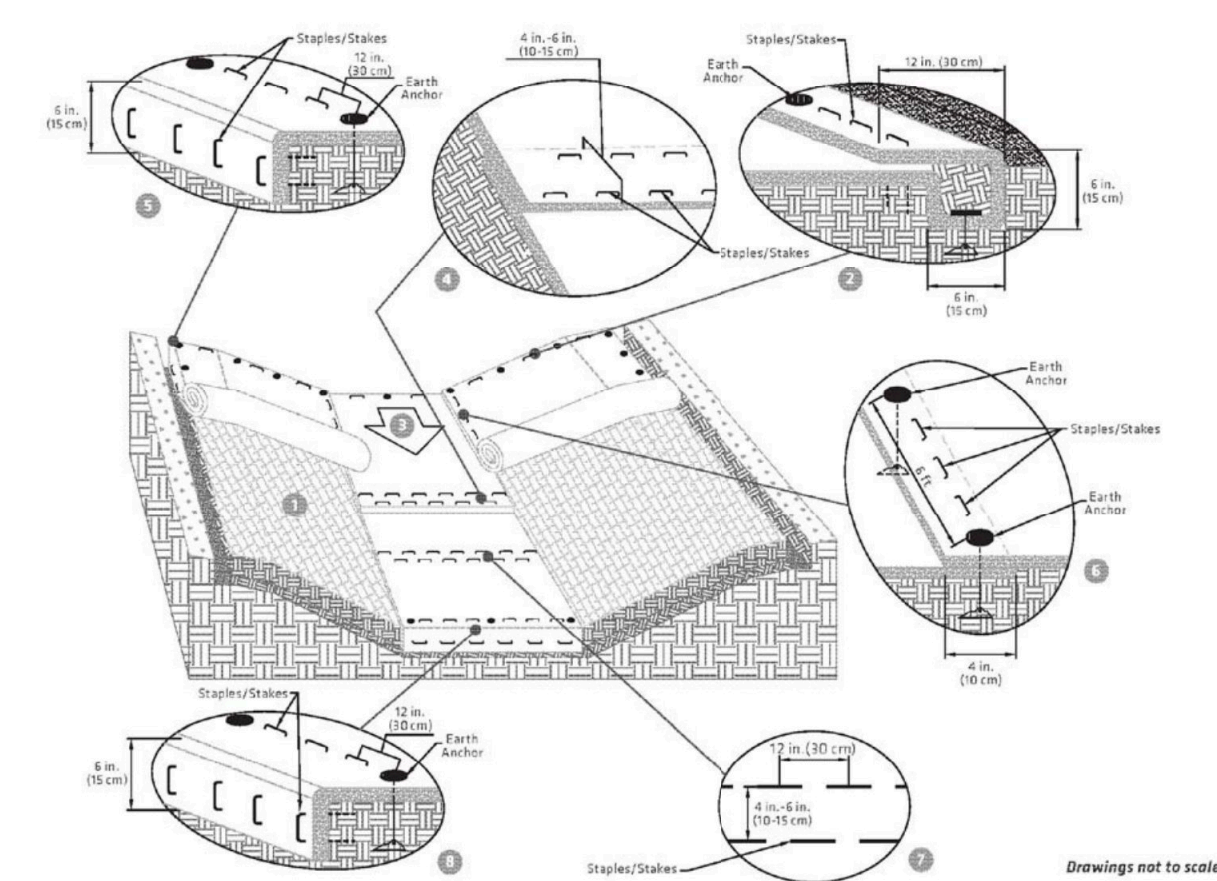

GENERAL INSTALLATION

- Prepare soil before installing the HPTM, including any necessary application of soil amendments such as lime or fertilizer. See seeding and vegetating section for details regarding pre-seeding, overseeding or use with sod.
- Begin at the top of the channel by anchoring the HPTM in a 6 in. (15 cm) deep x 6 in. (15 cm) wide trench with approximately 12 in. (30 cm) of HPTM extended beyond the upslope portion of the trench. Anchor the HPTM with a row of anchors/staples/stakes spaced approximately 12 in. (30 cm) apart in a 6 in. (15 cm) deep x 6 in. (15 cm) wide trench. Backfill and compact the trench after stapling.
- Roll center HPTM in direction of water flow in bottom of channel. HPTMs will unroll with appropriate side against the soil surface. All HPTMs must be securely fastened to soil surface by placing anchors/staples/stakes in appropriate locations as shown in the anchoring detail.
- Place consecutive HPTMs and over end (single style) with a 4 in. x 6 in. (10 cm x 15 cm) overlap. Use a double row of staples/stakes staggered 12 in. (30 cm) apart and 12 in. (30 cm) on center to secure HPTMs.
- Full length edge of HPTMs at top of side slopes must be anchored with a row of staples/stakes approximately 12 in. (30 cm) apart in a 6 in. (15 cm) deep x 6 in. (15 cm) wide trench. Backfill and compact the trench after stapling.
- In high flow channel applications, a staple/stake check slot is recommended at 30 ft to 40 ft (9 m-12 m) intervals. Use a double row of staples/stakes staggered 4 in. (10 cm) apart and 12 in. (30 cm) on center over entire width of the channel.
- The terminal end of the HPTMs must be anchored with a row of staples/stakes approximately 12 in. (30 cm) apart in a 6 in. (15 cm) deep x 6 in. (15 cm) wide trench. Backfill and compact the trench after stapling.

57 - DETAIL  
TURF REINFORCEMENT MATTING  
SCALE: NTS  
SOURCE: NORTH AMERICAN GREEN

NOTES

**CONDITIONS**  
SLOPE STABILIZATION CAN BE APPLIED TO FLAT AREAS OR SLOPES WHERE THE EROSION HAZARD IS HIGH AND SLOPE PROTECTION IS NEEDED DURING THE ESTABLISHMENT OF VEGETATION.

**PLANNING CONSIDERATIONS**  
CARE MUST BE TAKEN TO CHOOSE THE TYPE OF SLOPE STABILIZATION PRODUCT WHICH IS MOST APPROPRIATE FOR THE SPECIFIC NEEDS OF A PROJECT. TWO GENERAL TYPES OF SLOPE STABILIZATION PRODUCTS ARE DISCUSSED WITHIN THIS SPECIFICATION.

**ROLLED EROSION CONTROL PRODUCTS (RECP)**  
A NATURAL FIBER BLANKET WITH SINGLE OR DOUBLE PHOTODEGRADABLE OR BIODEGRADABLE NETS.

**HYDRAULIC EROSION CONTROL PRODUCTS (HECP)**  
HECP SHALL UTILIZE STRAW, COTTON, WOOD OR OTHER NATURAL BASED FIBERS HELD TOGETHER BY A SOIL BINDING AGENT WHICH WORKS TO STABILIZE SOIL PARTICLES. PAPER MULCH SHOULD NOT BE USED FOR EROSION CONTROL.


- CRITERIA**  
ROLLED EROSION CONTROL PRODUCTS (RECPS) AND HYDRAULIC EROSION CONTROL PRODUCTS (HECPS):
- INSTALLATION AND STAPLING OF RECPS AND APPLICATION RATES FOR THE HECPS SHALL CONFORM TO MANUFACTURER'S GUIDELINES FOR APPLICATION
  - PRODUCTS SHALL HAVE A MAXIMUM C-FACTOR (ASTM D6459) FOR THE FOLLOWING GRADE:  
SLOPE (H:V) C-FACTOR (MAX)  
3:1 OR GREATER 0.080

**PERFORMANCE EVALUATION**  
FOR A PRODUCT OR PRACTICE TO BE APPROVED AS SLOPE STABILIZATION, THAT PRODUCT OR PRACTICE MUST HAVE A DOCUMENTED C-FACTOR OF 0.080, AS SPECIFIED BY GSWCC. FOR COMPLETE TEST PROCEDURES AND APPROVED PRODUCTS LIST PLEASE VISIT [WWW.GASWCC.GEORGIA.GOV](http://WWW.GASWCC.GEORGIA.GOV).

**SITE PREPARATION**  
AFTER THE SITE HAS BEEN SHAPED AND GRADED TO THE APPROVED DESIGN, PREPARE A FRIABLE SEEDBED RELATIVELY FREE FROM CLOUDS AND ROCKS MORE THAN ONE INCH IN DIAMETER, AND ANY FOREIGN MATERIAL THAT WILL PREVENT CONTACT OF THE SOIL STABILIZATION MAT WITH THE SOIL SURFACE. SURFACE MUST BE SMOOTH TO ENSURE PROPER CONTACT OF BLANKETS OR MATTING TO THE SOIL SURFACE. IF NECESSARY, REDIRECT ANY RUNOFF FROM THE DITCH OR SLOPE DURING INSTALLATION.

- START AT DOWNSTREAM TERMINAL AND PROGRESS UPSTREAM.
- FIRST ROLL IS CENTERED LONGITUDINALLY IN MID-CHANNEL AND PINNED WITH TEMPORARY STAKES TO MAINTAIN ALIGNMENT.
- SUBSEQUENT ROLLS FOLLOW IN STAGGERED SEQUENCE BEHIND THE FIRST ROLL. USE THE CENTER ROLL FOR ALIGNMENT TO THE CHANNEL CENTER.
- WORK OUTWARDS FROM THE CHANNEL CENTER TO THE EDGE.
- USE 3" OVERLAPS AND STAKE AT 5' INTERVALS ALONG THE SEAMS.
- USE 3" OVERLAPS AND SHINGLE DOWNSTREAM TO CONNECT THE LINING AT THE ROLL ENDS.
- IT IS THE INTENTION OF THIS SECTION TO ALLOW INTERCHANGEABLE USE OF RECPS AND HECPS FOR EROSION PROTECTION ON SLOPES. THE PROJECT ENGINEER SHOULD SELECT THE TYPE OF EROSION CONTROL PRODUCT THAT BEST FITS THE NEED OF THE PARTICULAR SITE.

Anchoring Detail

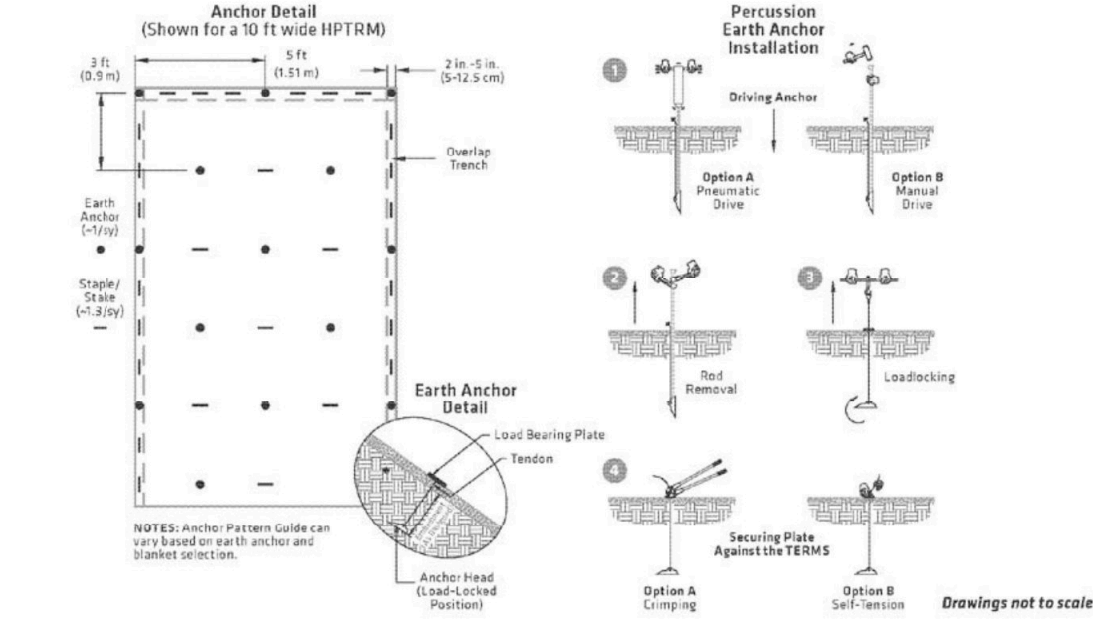

ANCHORING DETAIL

The performance of ground anchoring devices is highly dependent on numerous site/project specific variables. It is the sole responsibility of the project engineer and/or contractor to select the appropriate anchor type and weight. Anchoring shall be selected to hold the mat in intimate contact with the soil subgrade and resist pullout in accordance with the project's design intent.

- Staples and/or stakes should be at least 6 in. (15 cm) in length and with sufficient ground penetration to resist pullout. Longer staples and/or stakes may be needed in looser soils.
- The percussion earth anchor assembly consists of an anchor head, a tendon, a faceplate, and an end piece device. See North American Green Earth Anchor specification for detailed information on assembly components and associated pull-out strength.

PERCUSSION EARTH ANCHOR INSTALLATION

- Insert the drive rod into the assembly's anchor head then use either a sledge hammer or vibratory hammer to drive the anchor to their desired depth.
- After the desired anchor depth is achieved, retract the drive rod.
- Lock the anchor assembly by swiftly pulling the cable upwards until the anchor head rotates as signaled by sudden resistance to pulling. A hooked setting tool may be used to aid in this step.
- Secure the faceplate to the high-performance Turf Reinforcement Mat (HPTM) surface by locking the end-piece. If using a copper or aluminum stop, crimp the ferrule to

**NOTE:** Larger anchors may require more force to set the anchor. This can be achieved through using simple mechanical equipment for greater leverage, such as a jacking, manual or hydraulic jack, winch, or post puller.



secure. If using a self-tensioning end-piece (rip or wedge grip) set by simply tightening the end-piece against the faceplate. If desired, cut the remaining cable assembly, above end-piece, to desired length.

**SEEDING AND VEGETATING**  
When using a Composite Turf Reinforcement Mat (CTRM) with fiber components:

- Pre-seed prepared soils prior to the installation of the CTRM. Install matting as directed. CTRM does not require soil infill or a top dressing of seed. Overseeding may be done as a secondary form of seeding.
- Sod may be installed in place of seeding on top of the CTRM. Additional staking of sod is recommended in high-flow conditions. Sodded areas should be irrigated until rooting through the mat and into subgrade occurs.

When using a woven HPTM:

- Install the HPTM as directed prior to seed and soil filling.
- Place seed into the installed HPTM. After seeding, spread a layer of fine soil into the mat. Using the flat side of a rake, broom or other tool, completely fill the voids. Smooth soil-fill in order to just expose the top of the HPTM matrix. Do not place excessive soil above the mat.
- Additional seed, hydraulic mulching or the use of a temporary Erosion Control Blanket (ECB) can be applied over the soil-filled mat for increased protection.
- Sod may be installed in place of seeding. Install HPTM, and soil-fill as outlined above. Place sod directly onto the soil-filled HPTM. Additional staking of sod is recommended in high-flow conditions. Sodded areas should be irrigated until rooting through the mat and into subgrade occurs.
- Consult with a manufacturer's technical representative for installation assistance if unique conditions apply.

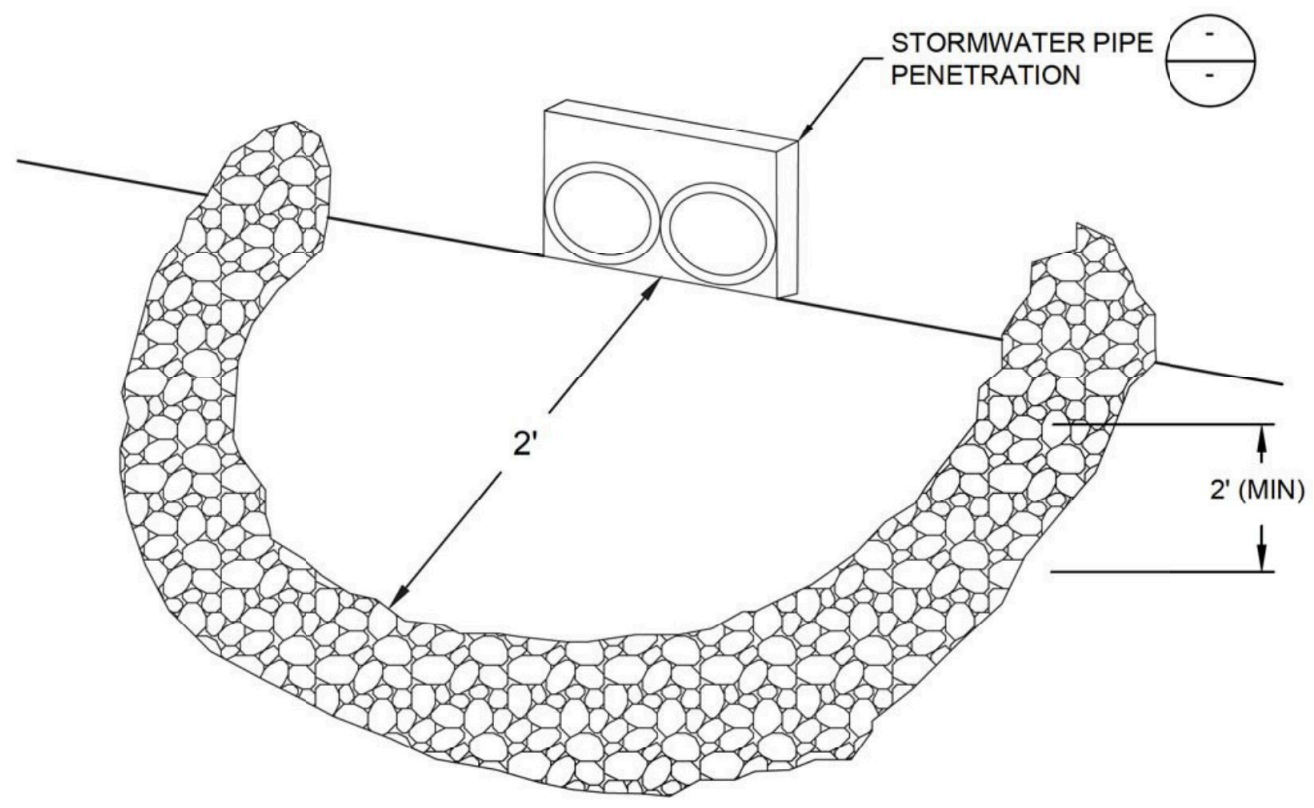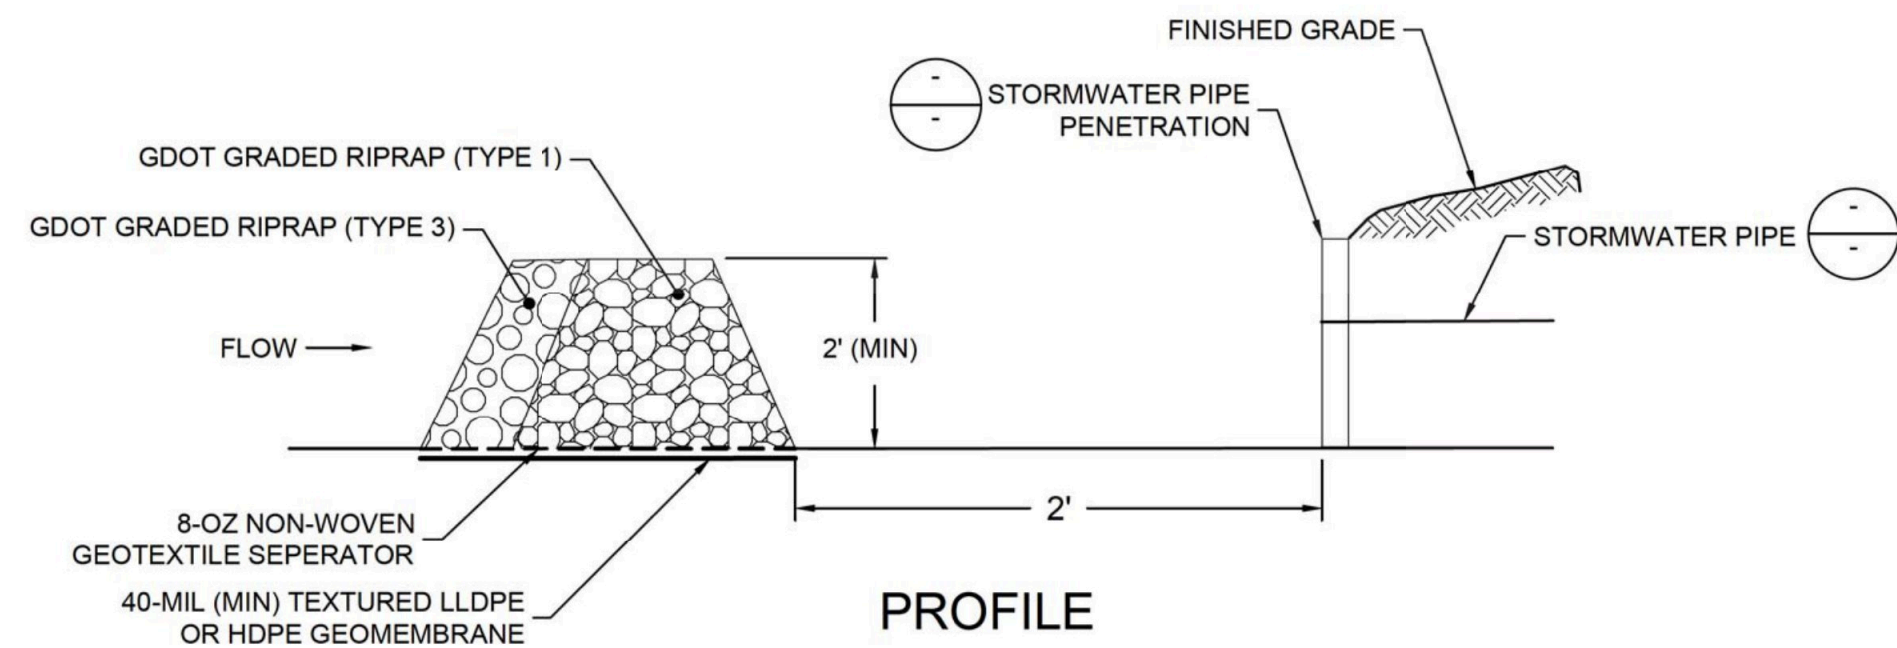

PERSPECTIVE



56 - DETAIL  
FILTER RING  
SCALE: NTS

**DEFINITION**  
TACKIFIERS ARE USED AS A TIE-DOWN FOR SOIL, COMPOST, SEED, STRAW, HAY OR MULCH. TACKIFIERS HYDRATE IN WATER AND READILY BLEND WITH OTHER SLURRY MATERIALS TO FORM A HOMOGENOUS SLURRY.

**PURPOSE**  
TO REDUCE SOIL EROSION FROM WIND AND WATER ON CONSTRUCTION SITES. OTHER BENEFITS INCLUDE SOIL INFILTRATION, SOIL FERTILITY, ENHANCED SEED GERMINATION, INCREASED SOIL COHESION, ENHANCED SOIL STABILIZATION, REDUCED STORMWATER RUNOFF TURBIDITY AND REDUCTION IN LESS OF TOPSOIL.

**CONDITIONS**  
THIS PRACTICE IS INTENDED FOR DIRECT SOIL SURFACE APPLICATION TO SITES WHERE THE TIMELY ESTABLISHMENT OF VEGETATION MAY NOT BE FEASIBLE OR WHERE VEGETATION COVER IS ABSENT OR INADEQUATE. SUCH AREAS INCLUDE CONSTRUCTION AREAS, WHERE PLANT RESIDUES ARE INADEQUATE TO PROTECT THE SOIL SURFACE AND WHERE LAND DISTURBING ACTIVITIES PREVENT THE ESTABLISHMENT OR MAINTENANCE OF A VEGETATIVE COVER.

58 - DETAIL  
TACKIFIER  
SOURCE: GWSCC

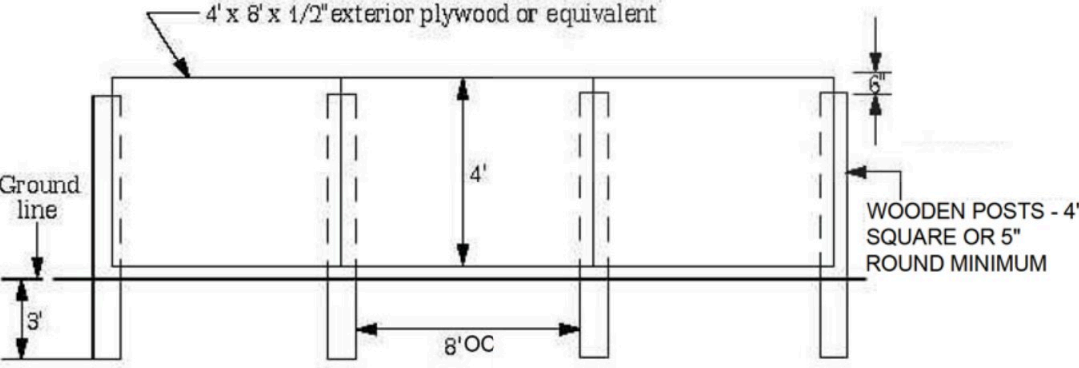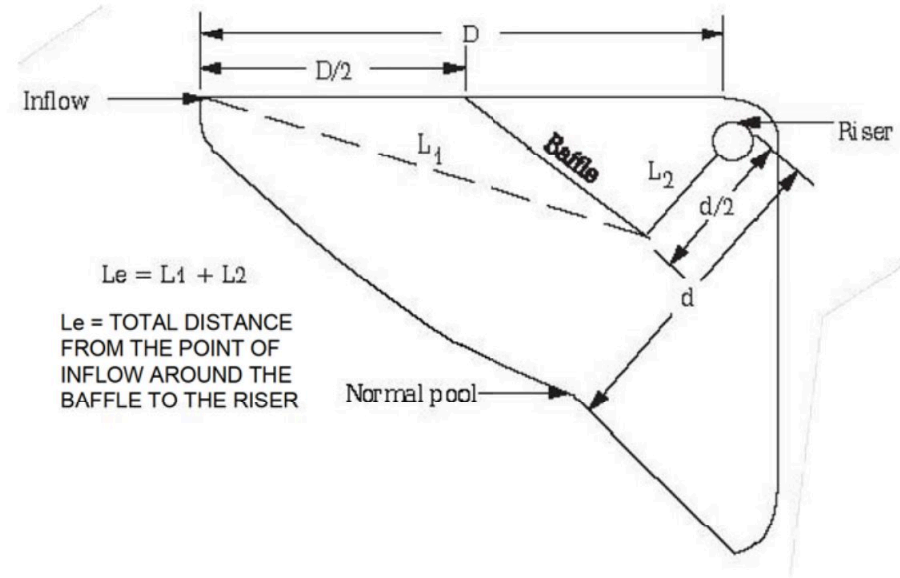

59 - DETAIL  
STORMWATER BAFFLE  
SCALE: NTS  
SOURCE: GWSCC

0	AUG. 2021	SUBMITTAL TO GA EPD	JV/KH	RB
REV	DATE	DESCRIPTION	DRN	APP
EROSION AND SEDIMENT CONTROL DETAILS II				
PLANT BOWEN ASH POND 1 (AP-1) CLOSURE DRAWINGS BARTOW COUNTY, GEORGIA				
<b>Geosyntec</b> consultants				
1255 ROBERTS BOULEVARD, NW, SUITE 200 KENNESAW, GEORGIA 30144 USA			PHONE: 678.202.8600 WWW.GEOSYNTEC.COM	
PROJ. NO.	GR6601	DWG.	GR6601-050	EDIT 08.16.21
SCALE	AS SHOWN	DRAWING 48 OF 50		
DATE	AUGUST 2021			



Georgia  
Power  
PERMIT DRAWING  
NOT FOR CONSTRUCTION



**DEFINITION**  
APPLYING PLANT RESIDUES OR OTHER SUITABLE MATERIALS, PRODUCED ON THE SITE IF POSSIBLE, TO THE SOIL SURFACE.

**REQUIREMENT FOR REGULATORY COMPLIANCE**  
MULCH OR TEMPORARY GRASSING SHALL BE APPLIED TO ALL EXPOSED AREAS WITHIN 14 DAYS OF DISTURBANCE. MULCH CAN BE USED AS A SINGULAR EROSION CONTROL DEVICE FOR UP TO SIX MONTHS, BUT IT SHALL BE APPLIED AT THE APPROPRIATE DEPTH (DEPENDING ON THE MATERIAL USED), ANCHORED, AND HAVE A CONTINUOUS 90% COVER OR GREATER OF THE SOIL SURFACE.

MAINTENANCE SHALL BE REQUIRED TO MAINTAIN APPROPRIATE DEPTH AND 90% COVER. TEMPORARY VEGETATION MAY BE EMPLOYED INSTEAD OF MULCH IF THE AREA WILL REMAIN UNDISTURBED FOR LESS THAN SIX MONTHS.

IF ANY AREA WILL REMAIN UNDISTURBED FOR GREATER THAN SIX MONTHS, PERMANENT VEGETATIVE TECHNIQUES SHALL BE EMPLOYED. REFER TO Ds2-DISTURBED AREA STABILIZATION (WITH TEMPORARY SEEDING), AND Ds3 - DISTURBED AREA STABILIZATION (WITH PERMANENT VEGETATION).

**SPECIFICATIONS**  
MULCHING WITHOUT SEEDING:  
THIS STANDARD APPLIES TO GRADED OR CLEARED AREAS WHERE SEEDINGS MAY NOT HAVE A SUITABLE GROWING SEASON TO PRODUCE AN EROSION RETARDANT COVER, BUT CAN BE STABILIZED WITH A MULCH COVER.

**SITE PREPARATION**  
1. GRADE TO PERMIT THE USE OF EQUIPMENT FOR APPLYING AND ANCHORING MULCH.  
2. INSTALL NEEDED EROSION CONTROL MEASURES AS REQUIRED SUCH AS DIKES, DIVERSIONS, BERMS, TERRACES AND SEDIMENT BARRIERS.  
3. LOOSEN COMPACTED SOIL TO A MINIMUM DEPTH OF 3 INCHES.

**MULCHING MATERIALS**  
SELECT ONE OF THE FOLLOWING MATERIALS AND APPLY AT THE DEPTH INDICATED:  
1. DRY STRAW OR HAY SHALL BE APPLIED AT A DEPTH OF 2 TO 4 INCHES PROVIDING COMPLETE SOIL COVERAGE. ONE ADVANTAGE OF THIS MATERIAL IS EASY APPLICATION.

Ds1

60

-

DETAIL

DISTURBED AREA STABILIZATION (WITH MULCHING ONLY)

SOURCE: GSWCC

2. WOOD WASTE (CHIPS, SAWDUST OR BARK) SHALL BE APPLIED AT A DEPTH OF 2 TO 3 INCHES. ORGANIC MATERIAL FROM THE CLEARING STAGE OF DEVELOPMENT REMAINING ON SITE CAN BE CHIPPED AND APPLIED AS MULCH. THIS METHOD OF MULCHING CAN GREATLY REDUCE EROSION CONTROL COSTS.
3. POLYETHYLENE FILM SHALL BE SECURED OVER BANKS OR STOCKPILED SOIL MATERIAL FOR TEMPORARY PROTECTION. THIS MATERIAL CAN BE SALVAGED AND RE-USED.

**APPLYING MULCH**  
WHEN MULCH IS USED WITHOUT SEEDING, MULCH SHALL BE APPLIED TO PROVIDE FULL COVERAGE OF THE EXPOSED AREA.

1. DRY STRAW OR HAY MULCH AND WOOD CHIPS SHALL BE APPLIED UNIFORMLY BY HAND OR BY MECHANICAL EQUIPMENT.

2. IF THE AREA WILL EVENTUALLY BE COVERED WITH PERENNIAL VEGETATION, 20-30 POUNDS OF NITROGEN PER ACRE, IN ADDITION TO THE NORMAL AMOUNT, SHALL BE APPLIED TO OFFSET THE UPTAKE OF NITROGEN CAUSED BY THE DECOMPOSITION OF THE ORGANIC MULCHS.

**ANCHORING MULCH**  
1. STRAW OR HAY MULCH CAN BE PRESSED INTO THE SOIL WITH A DISK HARROW WITH THE DISK SET STRAIGHT OR WITH A SPECIAL "PACKER DISK." DISKS MAY BE SMOOTH OR SERRATED AND SHOULD BE 20 INCHES OR MORE IN DIAMETER AND 8 TO 12 INCHES APART. THE EDGES OF THE DISK SHOULD BE DULL ENOUGH NOT TO CUT THE MULCH BUT TO PRESS IT INTO THE SOIL LEAVING MUCH OF IT IN AN ERECT POSITION. STRAW OR HAY MULCH SHALL BE ANCHORED IMMEDIATELY AFTER APPLICATION. STRAW OR HAY MULCH SPREAD WITH SPECIAL BLOWER-TYPE EQUIPMENT MAY BE ANCHORED. TACKIFIERS, BINDERS AND HYDRAULIC MULCH WITH TACKIFIER SPECIFICALLY DESIGNED FOR TACKING STRAW CAN BE SUBSTITUTED FOR EMULSIFIED ASPHALT. REFER TO Tack-TACKIFIERS. PLASTIC MESH OR NETTING WITH MESH NO LARGER THAN ONE INCH BY ONE INCH SHALL BE INSTALLED ACCORDING TO MANUFACTURER'S SPECIFICATIONS.

2. NETTING OF THE APPROPRIATE SIZE SHALL BE USED TO ANCHOR WOOD WASTE. OPENINGS OF THE NETTING SHALL NOT BE LARGER THAN THE AVERAGE SIZE OF THE WOOD WASTE CHIPS.

CUBIC YARDS OF TOPSOIL REQUIRED FOR APPLICATION TO VARIOUS DEPTHS

DEPTH (IN.)	PER 1,000 SQUARE FEET	PER ACRE
1	3.1	134
2	6.2	268
3	9.3	402
4	12.4	537
5	15.5	672
6	18.6	806

**CONDITIONS**  
THIS PRACTICE IS RECOMMENDED FOR SITES OF 2H:1V OR FLATTER SLOPES WHERE:

1. THE TEXTURE OF THE EXPOSED SUBSOIL OR PARENT MATERIAL IS NOT SUITABLE TO PRODUCE ADEQUATE VEGETATIVE GROWTH.

2. THE SOIL MATERIAL IS SO SHALLOW THAT THE ROOTING ZONE IS NOT DEEP ENOUGH TO SUPPORT PLANTS WITH CONTINUING SUPPLIES OF MOISTURE AND FOOD.

3. THE SOIL TO BE VEGETATED CONTAINS MATERIAL TOXIC TO PLANT GROWTH.

**CONSTRUCTION SPECIFICATIONS**  
**MATERIALS**  
TOPSOIL SHOULD BE FRIABLE AND LOAMY, FREE OF DEBRIS, OBJECTIONABLE WEEDS AND STONES, AND CONTAIN NO TOXIC SUBSTANCE THAT MAY BE HARMFUL TO PLANT GROWTH. A pH RANGE OF 5.0-7.5 IS ACCEPTABLE. SOLUBLE SALTS SHOULD NOT EXCEED 500 PPM.

**TESTING**  
FIELD EXPLORATION SHOULD BE MADE TO DETERMINE WHETHER THE QUANTITY AND QUALITY OF SURFACE SOIL JUSTIFIES STRIPPING.

**STRIPPING**  
STRIPPING SHOULD BE CONFINED TO THE IMMEDIATE CONSTRUCTION AREA. A 4 TO 6 INCH STRIPPING DEPTH IS COMMON, BUT MAY VARY DEPENDING ON THE PARTICULAR SOIL.

**TOPSOIL pH**  
IF pH VALUE IS LESS THAN 6.0, LIME SHALL BE APPLIED AND INCORPORATED WITH THE TOPSOIL TO ADJUST THE pH TO 6.5 OR HIGHER. TOPSOILS CONTAINING SOLUBLE SALTS GREATER THAN 500 PARTS PER MILLION SHALL NOT BE USED.

**SITE PREPARATION (WHERE TOPSOIL IS TO BE ADDED)**  
TOPSOILING - WHEN TOPSOILING, MAINTAIN NEEDED EROSION CONTROL PRACTICES SUCH AS DIVERSIONS, GRADE STABILIZATION STRUCTURES, BERMS, DIKES, LEVEL SPREADERS, WATERWAYS, SEDIMENT BASINS, ETC.

**GRADING - GRADES ON THE AREAS TO BE TOPSOILED WHICH HAVE BEEN PREVIOUSLY ESTABLISHED SHALL BE MAINTAINED.**

**LIMING - SOIL TESTS SHOULD BE USED TO DETERMINE THE pH OF THE SOIL. WHERE THE pH OF THE SUBSOIL IS 5.0 OR LESS OR COMPOSED OF HEAVY CLAYS, AGRICULTURAL LIMESTONE SHALL BE SPREAD AT THE RATE OF 100 POUNDS PER 1,000 SQUARE FEET. LIME SHALL BE DISTRIBUTED UNIFORMLY OVER DESIGNATED AREAS AND WORKED INTO THE SOIL IN CONJUNCTION WITH TILLAGE OPERATIONS AS DESCRIBED IN THE FOLLOWING PROCEDURE.**

**BONDING - USE ONE OF THE FOLLOWING METHODS TO INSURE BONDING OF TOPSOIL AND SUBSOIL:**  
1. TILLING AFTER THE AREAS TO BE TOPSOILED HAVE BEEN BROUGHT TO GRADE, AND IMMEDIATELY PRIOR TO DUMPING AND SPREADING THE TOPSOIL, THE SUBGRADE SHALL BE LOOSENED BY DISCING OR SCARIFYING TO A DEPTH OF AT LEAST 3 INCHES TO PERMIT BONDING OF THE TOPSOIL TO THE SUBSOIL.

2. TRACKING. PASSING A BULLDOZER OVER THE ENTIRE SURFACE AREA OF THE SLOPE TO LEAVE HORIZONTAL DEPRESSIONS.

**APPLYING TOPSOIL**  
1. TOPSOIL SHOULD BE HANDLED ONLY WHEN IT IS DRY ENOUGH TO WORK WITHOUT DAMAGING THE SOIL STRUCTURE.

2. A UNIFORM APPLICATION OF 6 INCHES (UNSETTLED) IS RECOMMENDED, BUT MAY BE ADJUSTED AT THE DISCRETION OF THE ENGINEER OR LANDSCAPE ARCHITECT.



Tp

61

-

DETAIL

DISTURBED AREA STABILIZATION (WITH MULCHING ONLY)

SOURCE: GSWCC

SEEDING RATES FOR TEMPORARY SEEDING

BROADCAST		PLANTING DATES												COMMENTS
SPECIES	RATES	J	F	M	A	M	J	J	A	S	O	N	D	
BARLEY ALONE	144 LBS./AC									.....			.....	WINTER HARDY, USE ON PRODUCTIVE SOILS
BARLEY IN MIXTURE	24 LBS./AC									.....			.....	
LESPEDEZA, ANNUAL ALONE	40 LBS./AC			....	.....									MAY VOLUNTEER FOR SEVERAL YEARS. USE INOCULANT TYPE EL.
LESPEDEZA, ANNUAL IN MIXTURE	10 LBS./AC			....	.....									
LOVEGRASS, WEEPING ALONE LOVEGRASS, WEEPING IN MIXTURE	4 LBS./AC 2 LBS./AC				.....	.....								MAY LAST FOR SEVERAL YEARS. MIX WITH SERICEA LESPEDEZA.
MILLET, BROWNTOP ALONE	40 LBS./AC					.....	.....							QUICK DENSE COVER. WILL PROVIDE TOO MUCH COMPETITION IN MIXTURES IF SEEDED AT HIGH RATES.
MILLET, BROWNTOP IN MIXTURE	10 LBS./AC					.....	.....							
MILLET, PEARL ALONE	50 LBS./AC					....	.....							QUICK DENSE COVER. MAY REACH 5 FEET IN HEIGHT. NOT RECOMMENDED FOR MIXTURES.
OATS ALONE	128 LBS./AC										.....			USE ON PRODUCTIVE SOILS. NOT AS WINTER HARDY AS RYE OR BARLEY.
OATS IN MIXTURE	32 LBS./AC										.....			
RYE ALONE	168 LBS./AC											.....		QUICK COVER. DROUGHT TOLERANT AND WINTER HARDY.
RYE IN MIXTURE	28 LBS./AC											.....		
RYEGRASS, ANNUAL ALONE	40 LBS./AC	.....	.....	.....	.....									DENSE COVER. VERY COMPETITIVE AND NOT TO BE USED IN MIXTURES. GOOD ON DROUGHTY SITES. NOT RECOMMENDED FOR MIXTURES.
SUDANGRASS ALONE	60 LBS./AC				.....	.....								USE ON LOWER PART OF SOUTHERN COASTAL PLAIN AND IN ATLANTIC COASTAL FLATWOODS ONLY.
TRITICALE ALONE	144 LBS./AC	.....										.....		
TRITICALE IN MIXTURE	24 LBS./AC	.....										.....		
WHEAT ALONE	180 LBS./AC											.....		WINTER HARDY.
WHEAT WITH OTHER PERENNIALS	30 LBS./AC											.....		

SOLID LINES INDICATE OPTIMUM DATES, DOTTED LINES INDICATE PERMISSIBLE BUT MARGINAL DATES.

**DEFINITION**  
THE ESTABLISHMENT OF TEMPORARY VEGETATION COVER WITH FAST GROWING SEEDINGS FOR SEASONAL PROTECTION ON DISTURBED OR DENUEDED AREAS.

**CONDITIONS**  
TEMPORARY VEGETATIVE MEASURES SHOULD BE COORDINATED WITH PERMANENT MEASURES TO ASSURE ECONOMICAL AND EFFECTIVE STABILIZATION. MOST TYPES OF TEMPORARY VEGETATION ARE IDEAL TO USE AS COMPANION CROPS UNTIL THE PERMANENT VEGETATION IS ESTABLISHED. NOTE: SOME SPECIES OF TEMPORARY VEGETATION ARE NOT APPROPRIATE FOR COMPANION CROP PLANTINGS BECAUSE OF THEIR POTENTIAL TO OUT-COMPETE THE DESIRED SPECIES (E.G. ANNUAL RYEGRASS). CONTACT NATURAL RESOURCE CONSERVATION SERVICE OR THE LOCAL SOIL WATER CONSERVATION DISTRICT FOR MORE INFORMATION.

**SPECIFICATIONS**  
GRADING AND SHAPING  
EXCESSIVE WATER RUNOFF SHALL BE REDUCED BY PROPERLY DESIGNED AND INSTALLED EROSION CONTROL PRACTICES SUCH AS CLOSED DRAINS, DITCHES, DIKES, DIVERSIONS, SEDIMENT BARRIERS AND OTHERS. NO SHAPING OR GRADING IS REQUIRED IF SLOPES CAN BE STABILIZED BY HAND-SEEDED VEGETATION OR IF HYDRAULIC SEEDING EQUIPMENT IS TO BE USED.

**SEEDBED PREPARATION**  
WHEN A HYDRAULIC SEEDER IS USED, SEEDBED PREPARATION IS NOT REQUIRED. WHEN USING CONVENTIONAL OR HAND-SEEDED, SEEDBED PREPARATION IS NOT REQUIRED IF THE SOIL MATERIAL IS LOOSE AND NOT SEALED BY RAINFALL. WHEN SOIL HAS BEEN SEALED BY RAINFALL OR CONSISTS OF SMOOTH CUT SLOPES, THE SOIL SHALL BE PITTED, TRENCHED, OR OTHERWISE SCARIFIED TO PROVIDE A PLACE FOR SEED TO LEDGE AND GERMINATE.

**LIME AND FERTILIZER**  
AGRICULTURAL LIME IS REQUIRED UNLESS SOIL TESTS INDICATE OTHERWISE. APPLY AGRICULTURAL LIME AT A RATE DETERMINED BY SOIL TEST FOR pH.

Ds2

62

-

DETAIL

DISTURBED AREA STABILIZATION (WITH TEMPORARY SEEDING)

SOURCE: GSWCC

QUICK ACTING LIME SHOULD BE INCORPORATED TO MODIFY pH DURING THE GERMINATION PERIOD. BIO STIMULANTS SHOULD ALSO BE CONSIDERED WHEN THERE IS LESS THAN 3% ORGANIC MATTER IN THE SOIL. GRADED AREAS REQUIRE LIME APPLICATION. SOILS MUST BE TESTED TO DETERMINE REQUIRED AMOUNTS OF FERTILIZER AND AMENDMENTS. FERTILIZER SHOULD BE APPLIED BEFORE LAND PREPARATION AND INCORPORATED WITH A DISK, RIPPER, OR CHISEL. ON SLOPES TOO STEEP FOR OR INACCESSIBLE TO EQUIPMENT, FERTILIZER SHALL BE HYDRAULICALLY APPLIED, PREFERABLY IN THE FIRST PASS WITH SEED AND SOME HYDRAULIC MULCH, THEN TOPPED WITH THE REMAINING REQUIRED APPLICATION RATE.

**SEEDING**  
SELECT A GRASS OR GRASS-LEGUME MIXTURE SUITABLE TO THE AREA AND SEASON OF THE YEAR. SEED SHALL BE APPLIED UNIFORMLY BY HAND, CYCLOONE SEEDER, DRILL, CULTIPACKER-SEEDER, OR HYDRAULIC SEEDER (GURRY INCLUDING SEED AND FERTILIZER). DRILL OR CULTIPACKER SEEDERS SHOULD NORMALLY PLACE SEED ONE-QUARTER TO ONE-HALF INCH DEEP. APPROPRIATE DEPTH OF PLANTING IS TEN TIMES THE SEED DIAMETER. SOIL SHOULD BE "RAKED" LIGHTLY TO COVER SEED WITH SOIL IF SEED BY HAND. SEE THE MANUAL FOR EROSION AND SEDIMENT CONTROL IN GEORGIA, LATEST EDITION, FOR MORE INFORMATION.

**MULCHING**  
TEMPORARY VEGETATION CAN, IN MOST CASES, BE ESTABLISHED WITHOUT THE USE OF MULCH, PROVIDED THERE IS LITTLE TO NO EROSION POTENTIAL. HOWEVER, THE USE OF MULCH CAN OFTEN ACCELERATE AND ENHANCE GERMINATION AND VEGETATION ESTABLISHMENT. MULCH WITHOUT SEEDING SHOULD BE CONSIDERED FOR SHORT TERM PROTECTION. REFER TO Ds1-DISTURBED AREA STABILIZATION (WITH MULCHING ONLY).

**IRRIGATION**  
DURING TIMES OF DROUGHT, WATER SHALL BE APPLIED AT A RATE NOT CAUSING RUNOFF AND EROSION. THE SOIL SHALL BE THOROUGHLY WETTED TO A DEPTH THAT WILL INSURE GERMINATION OF THE SEED. SUBSEQUENT APPLICATIONS SHOULD BE MADE WHEN NEEDED.

FERTILIZER REQUIREMENTS

WARM SEASON GRASSES			
YEAR	EQUIVALENT N-P-K	ANALYSIS OR RATE	N TOP DRESSING
FIRST	6-12-12	1500 LBS./AC.	50-100 LBS./AC. 2/6/
SECOND	6-12-12	800 LBS./AC.	50-100 LBS./AC. 2/
MAINTENANCE	10-10-10	400 LBS./AC.	30 LBS./AC.
COOL SEASON GRASSES			
YEAR	EQUIVALENT N-P-K	ANALYSIS OR RATE	N TOP DRESSING
FIRST	6-12-12	1500 LBS./AC.	50 LBS./AC./6/
SECOND	6-12-12	1000 LBS./AC.	----
MAINTENANCE	6-10-10	400 LBS./AC.	----

PLANT, PLANTING RATE & PLANTING DATE FOR PERMANENT COVER

SPECIES	BROADCAST RATES	PLANTING DATES												PLANTING DATE REMARKS
		J	F	M	A	M	J	J	A	S	O	N	D	
LESPEDEZA SERICEA SCARIFIED	60 LBS./AC				.....			....						WIDELY ADAPTED. LOW MAINTENANCE. MIX WITH COMMON BERMUDA OR TALL FESCUE. INOCULATE SEED WITH EL INOCULANT.
LESPEDEZA SERICEA UNSCARIFIED	75 LBS./AC													MIX WITH TALL FESCUE.
PENSACOLA BAHIA ALONE OR WITH TEMPORARY COVER	60 LBS./AC	.....												LOW GROWING. SOD FORMING. SLOW TO ESTABLISH. PLANT WITH A COMPANION CROP. WILL SPREAD INTO BERMUDA PASTURES AND LAWNS. MIX WITH SERICEA LESPEDEZA.
WILMINGTON BAHIA WITH OTHER PERENNIALS	30 LBS./AC	.....												
TALL FESCUE ALONE	50 LBS./AC									....	.....			USE ALONE ONLY ON BETTER SITES. MIX WITH PERENNIAL LESPEDEZA OR CROWNVEATCH. APPLY TOP DRESSING IN SPRING FOLLOWING FALL PLANTINGS. NOT FOR HEAVY USE AREAS OR ATHLETIC FIELDS.
TALL FESCUE WITH OTHER PERENNIALS	30 LBS./AC													
REED CANARY GRASS ALONE	50 LBS./AC									....	.....			
REED CANARY GRASS WITH OTHER PERENNIALS	30 LBS./AC									....	.....			GROWS SIMILAR TO TALL FESCUE.
COMMON BERMUDA UNHULLED SEED WITH TEMPORARY COVER	10 LBS./AC													PLANT WITH WINTER ANNUALS.
COMMON BERMUDA UNHULLED SEED WITH OTHER PERENNIALS	6 LBS./AC													PLANT WITH TALL FESCUE.

SOLID LINES INDICATE OPTIMUM DATES, DOTTED LINES INDICATE PERMISSIBLE BUT MARGINAL DATES.

**DEFINITION**  
THE PLANTING OF PERENNIAL VEGETATION SUCH AS TREES, SHRUBS, VINES, GRASSES, OR LEGUMES ON EXPOSED AREAS FOR FINAL PERMANENT STABILIZATION. PERMANENT PERENNIAL VEGETATION SHALL BE USED TO ACHIEVE FINAL STABILIZATION.

**CONDITIONS**  
PERMANENT PERENNIAL VEGETATION IS USED TO PROVIDE A PROTECTIVE COVER FOR EXPOSED AREAS INCLUDING CUTS, FILLS, DAMS, AND OTHER DENUEDED AREAS.

**SPECIFICATIONS**  
GRADING AND SHAPING  
GRADING AND SHAPING MAY NOT BE REQUIRED WHERE HYDRAULIC SEEDING AND FERTILIZING EQUIPMENT IS TO BE USED. VERTICAL BANKS SHALL BE SLOPED TO ENABLE PLANT ESTABLISHMENT. WHEN CONVENTIONAL SEEDING AND FERTILIZING ARE TO BE DONE, GRADE AND SHAPE WHERE FEASIBLE AND PRACTICAL, SO THAT EQUIPMENT CAN BE USED SAFELY AND EFFICIENTLY DURING SEEDBED PREPARATION, SEEDING, MULCHING AND MAINTENANCE OF THE VEGETATION. CONCENTRATIONS OF WATER THAT WILL CAUSE EXCESSIVE SOIL EROSION SHALL BE DIVERTED TO A SAFE OUTLET. DIVERSIONS AND OTHER TREATMENT PRACTICES SHALL CONFORM WITH THE APPROPRIATE STANDARDS AND SPECIFICATIONS.

**SEEDBED PREPARATION**  
SEEDBED PREPARATION MAY NOT BE REQUIRED WHERE HYDRAULIC SEEDING AND FERTILIZING EQUIPMENT IS TO BE USED (BUT IS STRONGLY RECOMMENDED FOR ANY SEEDING PROCESS, WHEN POSSIBLE). WHEN CONVENTIONAL SEEDING IS TO BE USED, SEEDBED PREPARATION WILL BE DONE AS FOLLOWS:

- BROADCAST PLANTINGS**
1. TILLAGE, AT A MINIMUM, SHALL ADEQUATELY LOOSEN THE SOIL TO A DEPTH OF 4 TO 6 INCHES; ALLEVIATE COMPACTION; INCORPORATE LIME AND FERTILIZER; SMOOTH AND FIRM THE SOIL; ALLOW FOR THE PROPER PLACEMENT OF SEED, SPRIGS, OR PLANTS; AND ALLOW FOR THE ANCHORING OF STRAW OR HAY MULCH IF A DISK IS TO BE USED.
2. TILLAGE MAY BE DONE WITH ANY SUITABLE EQUIPMENT.
3. TILLAGE SHOULD BE DONE ON THE CONTOUR WHERE FEASIBLE.
4. ON SLOPES TOO STEEP FOR THE SAFE OPERATION OF TILLAGE EQUIPMENT, THE SOIL SURFACE SHALL BE PITTED OR TRENCHED ACROSS THE SLOPE WITH APPROPRIATE HAND TOOLS TO PROVIDE TWO PLACES 6 TO 8 INCHES APART IN WHICH SEED MAY LODGE AND GERMINATE. HYDRAULIC SEEDING MAY ALSO BE USED.

1. APPLY IN SPRING FOLLOWING SEEDING.
2. APPLY IN SPLIT APPLICATIONS WHEN HIGH RATES ARE USED.
3. APPLY IN 3 SPLIT APPLICATIONS.
4. APPLY WHEN PLANTS ARE PRUNED.
5. APPLY GRASS SPECIES ONLY.
6. APPLY WHEN PLANTS GROW TO A HEIGHT OF 2 TO 4 INCHES.

**MULCHING**  
MULCH IS REQUIRED FOR ALL PERMANENT VEGETATION APPLICATIONS. MULCH APPLIED TO SEEDED AREAS SHALL RECEIVE 75% TO 100% SOIL COVER. WHEN SELECTING A MULCH, DESIGN PROFESSIONALS SHOULD CONSIDER THE MULCH'S FUNCTIONAL LONGEVITY, VEGETATION ESTABLISHMENT ENHANCEMENT, AND EROSION CONTROL EFFECTIVENESS. SELECT THE MULCHING MATERIAL FROM THE FOLLOWING AND APPLY AS INDICATED:

1. DRY STRAW OR DRY HAY OF GOOD QUALITY AND FREE OF WEED SEEDS CAN BE USED. DRY STRAW SHALL BE APPLIED AT THE RATE OF 2 TONS PER ACRE. DRY HAY SHALL BE APPLIED AT A RATE OF 2 1/2 TONS PER ACRE.
2. WOOD CELLULOSE MULCH OR WOOD PULP FIBER SHALL BE USED WITH HYDRAULIC SEEDING. IT SHALL BE APPLIED AT THE RATE OF 500 POUNDS PER ACRE. DRY STRAW OR DRY HAY SHALL BE APPLIED (AT THE RATE INDICATED ABOVE) AFTER HYDRAULIC SEEDING.
3. ONE THOUSAND POUNDS OF WOOD CELLULOSE OR WOOD PULP FIBER, WHICH INCLUDES A TACKIFIER, SHALL BE USED WITH HYDRAULIC SEEDING ON SLOPES 1/4:1 OR STEEPER.
4. SERICEA LESPEDEZA HAY CONTAINING MATURE SEED SHALL BE APPLIED AT A RATE OF THREE TONS PER ACRE.
5. PINE STRAW OR PINE BARK SHALL BE APPLIED AT A THICKNESS OF 3 INCHES FOR BEDDING PURPOSES. OTHER SUITABLE MATERIALS IN SUFFICIENT QUANTITY MAY BE USED WHERE ORNAMENTALS OR OTHER GROUND COVERS ARE PLANTED. THIS IS NOT APPROPRIATE FOR SEEDED AREAS.
6. WHEN USING TEMPORARY EROSION CONTROL BLANKETS OR BLOCK SOD, MULCH IS NOT REQUIRED.
7. BITUMINOUS TREATED ROVING MAY BE APPLIED ON PLANTED AREAS, SLOPES, IN DITCHES, OR DRY WATERWAYS TO PREVENT EROSION. BITUMINOUS TREATED ROVING SHALL BE APPLIED WITHIN 24 HOURS AFTER AN AREA HAS BEEN PLANTED. APPLICATION RATES AND MATERIALS MUST MEET GEORGIA DEPARTMENT OF TRANSPORTATION SPECIFICATIONS. WOOD CELLULOSE AND WOOD PULP FIBERS SHALL NOT CONTAIN GERMINATION OR GROWTH INHIBITING FACTORS. THEY SHALL BE EVENLY DISPERSED WHEN AGITATED IN WATER. THE FIBERS SHALL CONTAIN A DYE TO ALLOW VISUAL METERING AND AID IN UNIFORM APPLICATION DURING SEEDING.

**APPLYING MULCH**  
STRAW OR HAY MULCH WILL BE SPREAD UNIFORMLY WITHIN 24 HOURS AFTER SEEDING AND/OR PLANTING. THE MULCH MAY BE SPREAD BY BLOWER-TYPE SPREADING EQUIPMENT, OTHER SPREADING EQUIPMENT OR BY HAND. MULCH SHALL BE APPLIED TO COVER 75% OF THE SOIL SURFACE. WOOD CELLULOSE OR WOOD FIBER MULCH SHALL BE APPLIED UNIFORMLY WITH HYDRAULIC SEEDING EQUIPMENT.

**ANCHORING MULCH**  
ANCHOR STRAW OR HAY MULCH IMMEDIATELY AFTER APPLICATION BY ONE OF THE FOLLOWING METHODS:

1. HAY AND STRAW MULCH SHALL BE PRESSED INTO THE SOIL IMMEDIATELY AFTER THE MULCH IS SPREAD. A SPECIAL "PACKER DISK" OR DISK HARROW WITH THE DISKS SET STRAIGHT MAY BE USED. THE DISKS MAY BE SMOOTH OR SERRATED AND SHOULD BE 2 INCHES OR MORE IN DIAMETER AND 8 TO 12 INCHES APART. THE EDGES OF THE DISKS SHALL BE DULL ENOUGH TO PRESS THE MULCH INTO THE GROUND WITHOUT CUTTING IT, LEAVING MUCH OF IT IN AN ERECT POSITION. MULCH SHALL NOT BE PLOWED INTO THE SOIL.

2. SYNTHETIC TACKIFIERS, FINDERS OR HYDRAULIC MULCH SPECIFICALLY DESIGNED TO TACK STRAW, SHALL BE APPLIED IN CONJUNCTION WITH OR IMMEDIATELY AFTER THE MULCH IS SPREAD. SYNTHETIC TACKIFIERS SHALL BE MIXED AND APPLIED ACCORDING TO MANUFACTURER'S SPECIFICATIONS. ALL TACKIFIERS, FINDERS OR HYDRAULIC MULCH SPECIFICALLY DESIGNED TO TACK STRAW SHOULD

- BE VERIFIED NONTXIC THROUGH EPA 2021.0 TESTING. REFER TO TACKIFIERS-TACK IN THE MANUAL FOR EROSION AND SEDIMENT CONTROL IN GEORGIA, LATEST EDITION.
3. RYE OR WHEAT CAN BE INCLUDED WITH FALL AND WINTER PLANTINGS TO STABILIZE THE MULCH. THEY SHALL BE APPLIED AT A RATE OF ONE-QUARTER TO ONE-HALF BUSHED PER ACRE.
4. PLASTIC MESH OR NETTING WITH MESH NO LARGER THAN ONE INCH BY ONE INCH MAY BE NEEDED TO ANCHOR STRAW OR HAY MULCH ON UNSTABLE SOILS AND CONCENTRATED FLOW AREAS. THESE MATERIALS SHALL BE INSTALLED AND ANCHORED ACCORDING TO MANUFACTURER'S SPECIFICATIONS.

**LIME AND FERTILIZER APPLICATION**  
WHEN HYDRAULIC SEEDING EQUIPMENT IS USED, THE INITIAL FERTILIZER SHALL BE MIXED WITH SEED, INNOCULANT (IF NEEDED), AND WOOD CELLULOSE OR WOOD PULP FIBER MULCH AND APPLIED IN A SLURRY. THE INNOCULANT, IF NEEDED, SHALL BE MIXED WITH THE SEED PRIOR TO BEING PLACED INTO THE HYDRAULIC SEEDER. THE SLURRY MIXTURE WILL BE AGITATED DURING APPLICATION TO KEEP THE INGREDIENTS THOROUGHLY MIXED. THE MIXTURE WILL BE SPREAD UNIFORMLY OVER THE AREA WITHIN ONE HOUR AFTER BEING PLACED IN THE HYDROSEEDER. FINELY GROUND LIMESTONE CAN BE APPLIED IN THE MULCH SLURRY OR IN COMBINATION WITH THE TOP DRESSING. WHEN CONVENTIONAL PLANTING IS TO BE DONE, LIME AND FERTILIZER SHALL BE APPLIED UNIFORMLY IN ONE OF THE FOLLOWING WAYS:

1. APPLY BEFORE LAND PREPARATION SO THAT IT WILL BE MIXED WITH THE SOIL DURING SEEDBED REPARATION.
2. MIX WITH THE SOIL USED TO FILL THE HOLES, DISTRIBUTE IN FURROWS.
3. BROADCAST AFTER STEEP SURFACES ARE SCARIFIED, PITTED OR TRENCHED.
4. A FERTILIZER PELLET SHALL BE PLACED AT ROOT DEPTH IN THE CLOSING HOLE BESIDE EACH PINE TREE SEEDLING.

**PLANT SELECTION**  
REFER TO THE MANUAL FOR EROSION AND SEDIMENT CONTROL IN GEORGIA, LATEST EDITION, FOR APPROVED SPECIES. SPECIES NOT LISTED SHALL BE APPROVED BY THE STATE RESOURCE CONSERVATIONIST OF THE NATURAL RESOURCES CONSERVATION SERVICE BEFORE THEY ARE USED. PLANTS SHALL BE SELECTED ON THE BASIS OF SPECIES CHARACTERISTICS, SITE AND SOIL CONDITIONS, PLANNED USE AND MAINTENANCE OF THE AREA, TIME OF YEAR OF PLANTING, METHOD OF PLANTING, AND THE NEEDS AND DESIRES OF THE LAND USER. SOME PERENNIAL SPECIES ARE EASILY ESTABLISHED AND CAN BE PLANTED ALONE. EXAMPLES OF THESE ARE COMMON BERMUDA, TALL FESCUE, AND WEEPING LOVEGRASS. OTHER PERENNIALS, SUCH AS BAHIA GRASS AND SERICEA LESPEDEZA, ARE SLOW TO BECOME ESTABLISHED AND SHOULD BE PLANTED WITH ANOTHER PERENNIAL SPECIES. THE ADDITIONAL SPECIES WILL PROVIDE QUICK COVER AND AMPLE SOIL PROTECTION UNTIL THE TARGET PERENNIAL SPECIES BECOME ESTABLISHED. FOR EXAMPLE, COMMON SEEDING COMBINATIONS ARE 1) WEEPING LOVEGRASS WITH SERICEA LESPEDEZA (SCARIFIED) AND 2) TALL FESCUE WITH SERICEA LESPEDEZA (UNSPECIFIED). PLANT SELECTION MAY ALSO INCLUDE ANNUAL COMPANION CROPS. ANNUAL COMPANION CROPS SHOULD BE USED ONLY WHEN THE PERENNIAL SPECIES ARE NOT PLANTED DURING THEIR OPTIMUM PLANTING PERIOD. A COMMON MIXTURE IS BROWN TOP MILLET WITH COMMON BERMUDA IN MID SUMMER. CARE SHOULD BE TAKEN IN SELECTING COMPANION CROP SPECIES AND SEEDING RATES BECAUSE ANNUAL CROPS WILL COMPETE WITH PERENNIAL SPECIES FOR WATER, NUTRIENTS, AND GROWING SPACE. A HIGH SEEDING RATE OF THE COMPANION CROP MAY PREVENT THE ESTABLISHMENT OF PERENNIAL SPECIES. RYEGRASS SHALL NOT BE USED IN ANY SEEDING MIXTURES CONTAINING PERENNIAL SPECIES DUE TO ITS ABILITY TO OUT-COMPETE DESIRED SPECIES CHOSEN FOR PERMANENT PERENNIAL COVER.

Ds3

63

-

DETAIL

DISTURBED AREA STABILIZATION (WITH PERMANENT VEGETATION)


SOURCE: GSWCC



Georgia  
Power

PERMIT DRAWING  
NOT FOR CONSTRUCTION




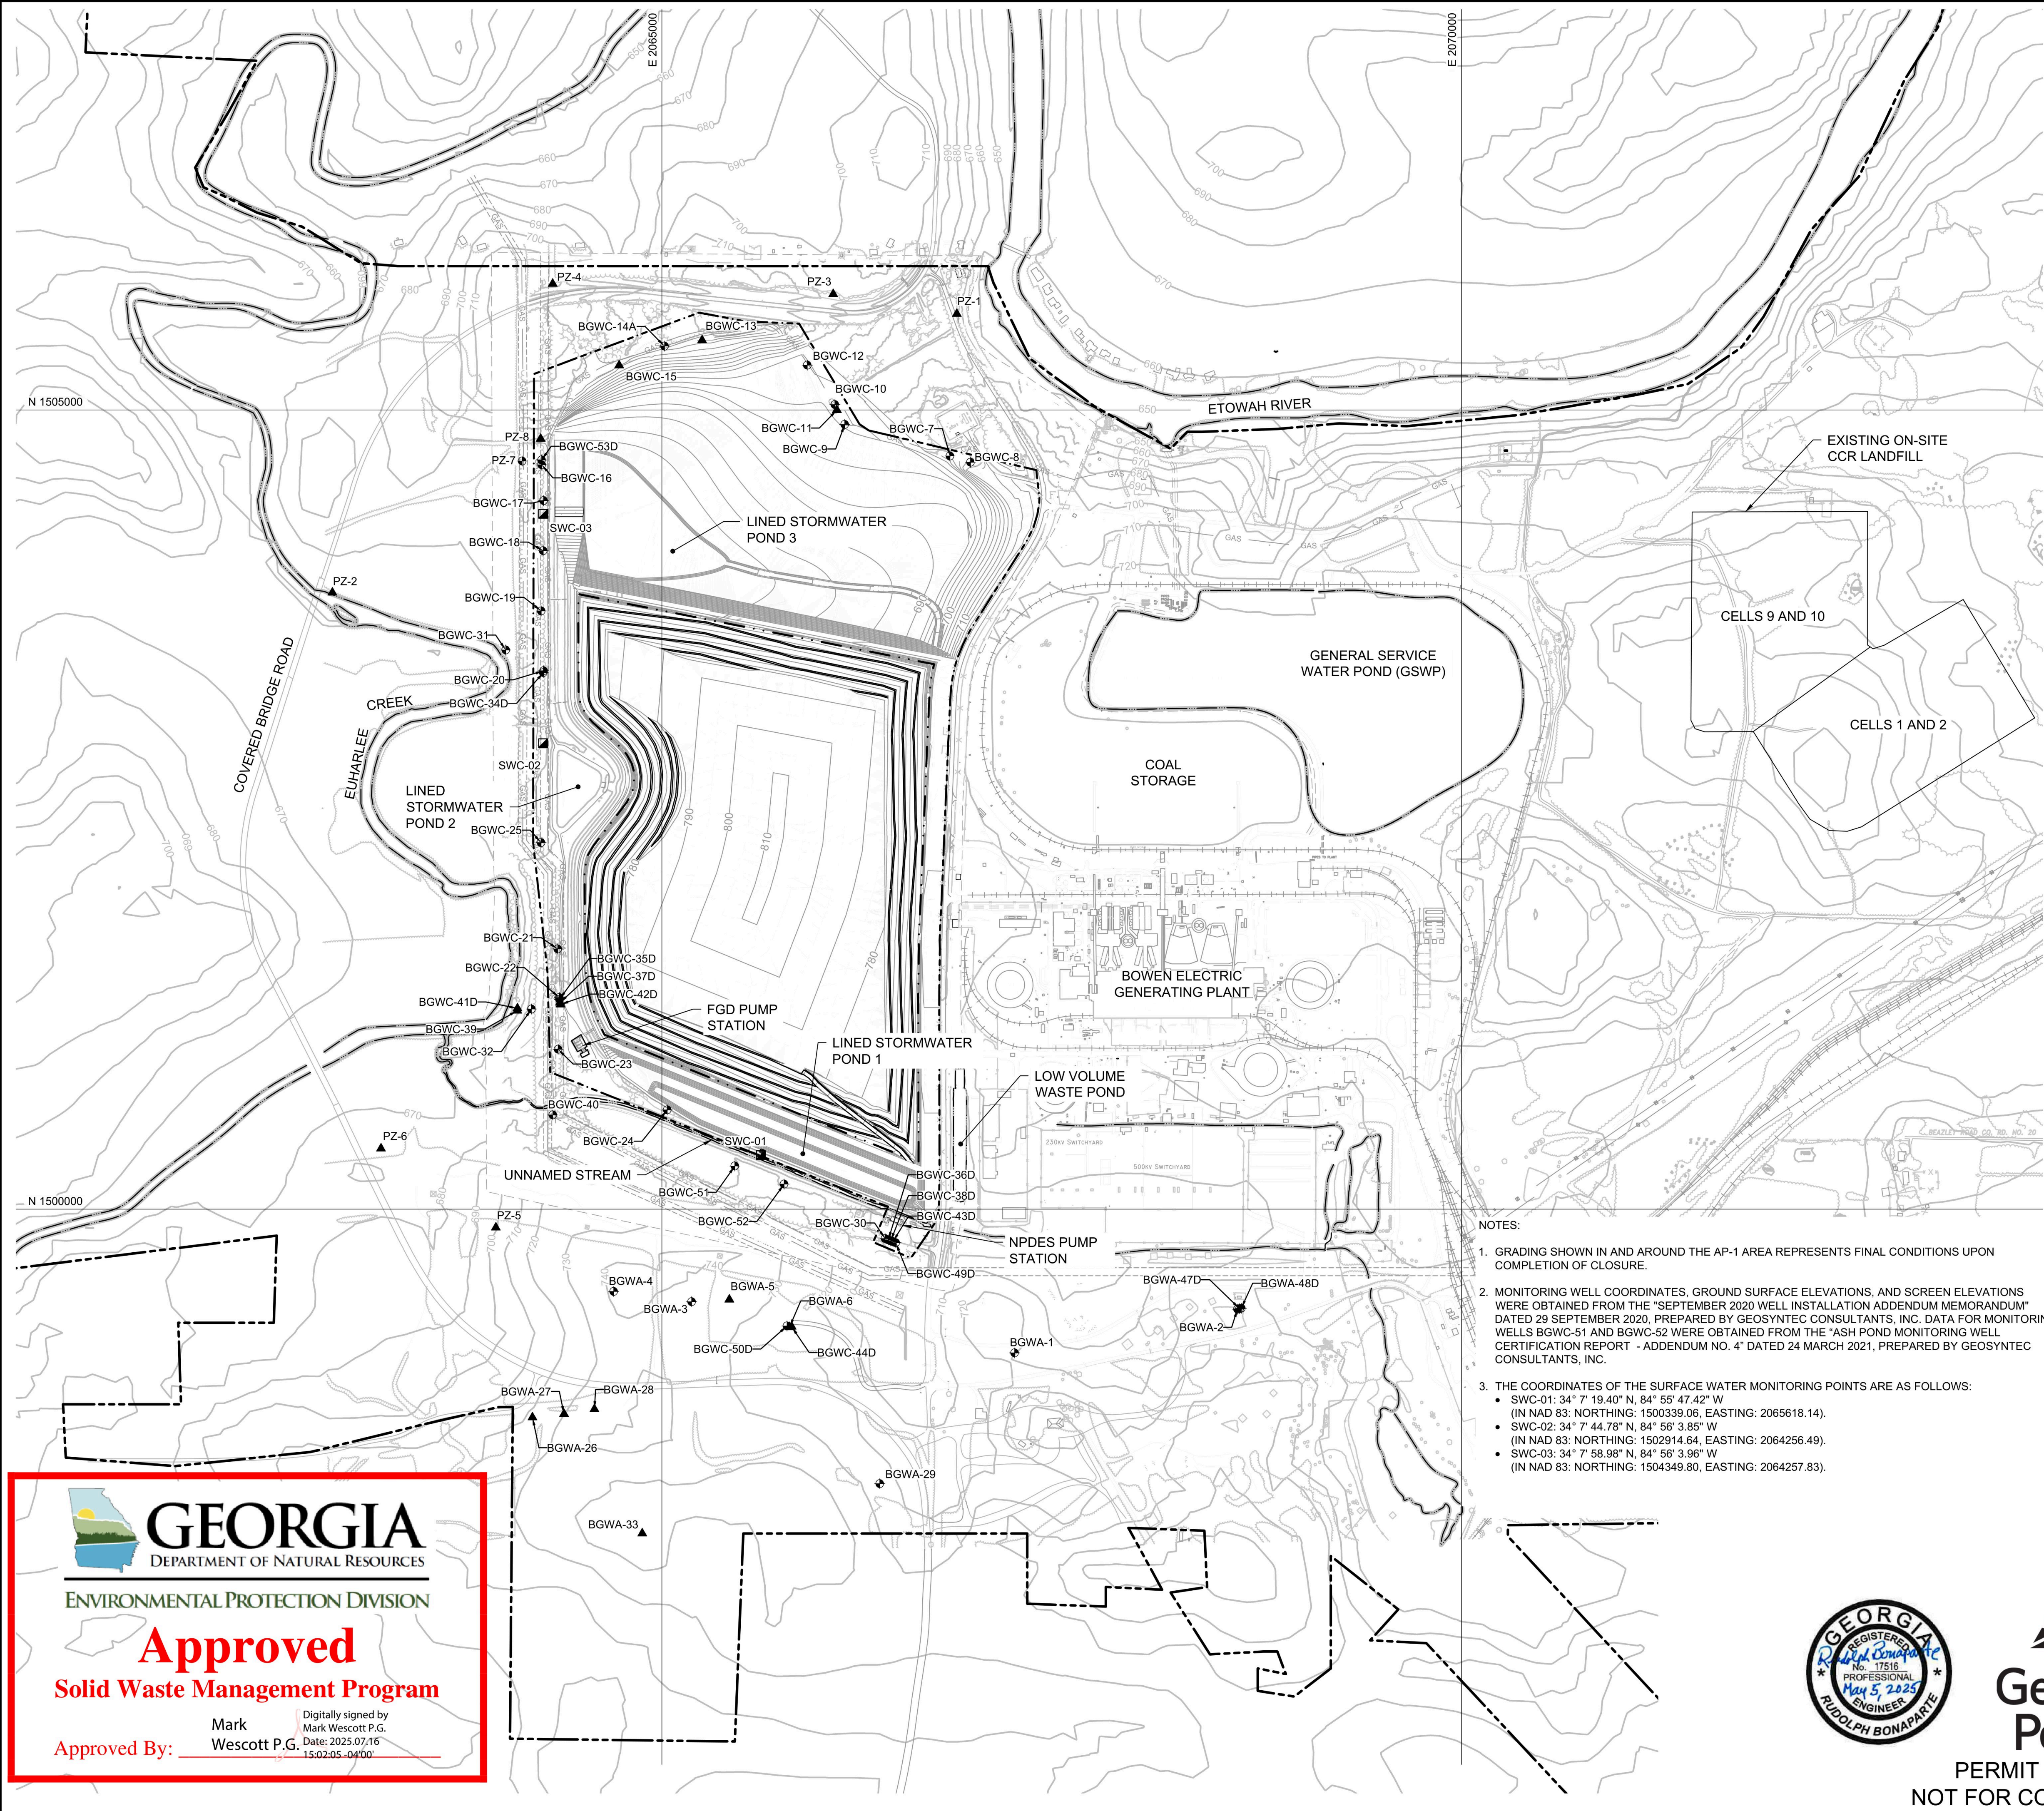

LEGEND	
	PROPERTY BOUNDARY
	PERMIT BOUNDARY
	FINAL LIMIT OF CCR (CONSOLIDATED FOOTPRINT)
	BGWA-7 CURRENT GROUNDWATER MONITORING WELL
	SWC-01 SURFACE WATER MONITORING POINT (NOTE 3)
	PZ-1 PIEZOMETER

COMPLIANCE MONITORING NETWORK					
MONITORING WELL ID	MONITORING PURPOSE	NORTHING	EASTING	GROUND SURFACE ELEVATION	SCREEN ELEVATIONS (TOP TO BOTTOM) (FT)
BGWA-2	DETECTION MONITORING	1499374.18	2068599.59	727.00	650.6 TO 640.6
BGWA-29	DETECTION MONITORING	1496283.04	2066362.32	718.84	632.9 TO 622.9
BGWA-47D	DETECTION MONITORING	1499377.79	2068612.48	726.93	585.9 TO 575.9
BGWA-48D	DETECTION MONITORING	1499380.09	2068623.31	726.64	545.0 TO 535.0
BGWC-7	DETECTION MONITORING	1504711.59	2066801.40	702.49	625.2 TO 615.2
BGWC-8	DETECTION MONITORING	1504671.82	2066929.46	703.71	636.8 TO 626.8
BGWC-9	DETECTION MONITORING	1504909.12	2066143.27	689.18	638.3 TO 628.3
BGWC-10	DETECTION MONITORING	1505033.22	2066081.09	683.39	633.7 TO 623.7
BGWC-12	DETECTION MONITORING	1505279.88	2065908.56	691.71	626.0 TO 616.0
BGWC-14A	DETECTION MONITORING	1505398.54	2065015.98	715.57	629.9 TO 619.9
BGWC-16	DETECTION MONITORING	1504656.42	2064247.67	671.65	635.3 TO 625.3
BGWC-17	DETECTION MONITORING	1504432.00	2064259.38	671.25	615.4 TO 605.4
BGWC-18	DETECTION MONITORING	1504118.73	2064257.00	670.32	645.1 TO 635.1
BGWC-19	DETECTION MONITORING	1503742.25	2064244.66	671.038	628.9 TO 618.9
BGWC-20	DETECTION MONITORING	1503367.73	2064259.55	672.29	635.1 TO 625.1
BGWC-21	DETECTION MONITORING	1501627.51	2064348.09	688.53	648.6 TO 638.6
BGWC-22	DETECTION MONITORING	1501323.76	2064358.05	692.64	662.6 TO 652.6
BGWC-23	DETECTION MONITORING	1501000.57	2064350.17	693.16	654.3 TO 644.3
BGWC-24	DETECTION MONITORING	1500621.22	2065032.84	699.46	646.3 TO 636.3
BGWC-25	DETECTION MONITORING	1502292.73	2064244.10	677.60	632.9 TO 622.9
BGWC-30	DETECTION MONITORING	1499815.93	2066395.86	698.39	651.6 TO 641.6
BGWC-51	DETECTION MONITORING	1500270.09	2065455.80	708.99	654.6 TO 644.6
BGWC-52	DETECTION MONITORING	1500156.97	2065764.13	707.77	638.9 TO 628.9
BGWC-61	ASSESSMENT MONITORING	1503497.94	2064022.71	668.12	631.1 TO 621.1
BGWC-32	ASSESSMENT MONITORING	1501252.25	2064184.30	696.36	658.5 TO 648.5
BGWC-34D	ASSESSMENT MONITORING	1503356.51	2064257.95	672.25	605.8 TO 595.8
BGWC-35D	ASSESSMENT MONITORING	1501312.20	2064358.63	693.13	625.1 TO 615.1
BGWC-38D	ASSESSMENT MONITORING	1499807.51	2066415.10	698.07	615.1 TO 605.1
BGWC-38D	ASSESSMENT MONITORING	1499802.36	2066430.17	697.52	584.9 TO 574.9
BGWC-40	ASSESSMENT MONITORING	1500589.93	2064317.38	687.12	637.4 TO 627.4
BGWC-43D	ASSESSMENT MONITORING	1499796.86	2066444.37	697.29	544.6 TO 534.6
BGWC-49D	ASSESSMENT MONITORING	1499790.13	2066461.96	696.95	399.0 TO 389.0
BGWC-50D	ASSESSMENT MONITORING	1499269.15	2065781.87	714.68	544.7 TO 534.7
BGWC-63D	ASSESSMENT MONITORING	1504685.89	2064247.38	671.46	584.4 TO 574.4
PZ-7	PIEZOMETER	1504679.33	2064125.75	672.43	636.5 TO 626.5
BGWA-1	PIEZOMETER	1499101.23	2067205.48	718.33	672.0 TO 662.0
BGWA-3	PIEZOMETER	1499420.87	2065185.74	721.80	645.1 TO 635.1
BGWA-4	PIEZOMETER	1499485.38	2064697.89	726.05	660.4 TO 650.4
BGWA-5	PIEZOMETER	1499434.58	2065421.43	718.53	661.5 TO 651.5
BGWA-6	PIEZOMETER	1499262.01	2065797.30	714.49	663.9 TO 653.9
BGWA-26	PIEZOMETER	1498697.63	2064189.94	726.09	663.6 TO 653.6
BGWA-27	PIEZOMETER	1498719.14	2064387.54	732.50	652.1 TO 642.1
BGWA-28	PIEZOMETER	1498749.21	2064577.55	734.88	661.4 TO 651.4
BGWA-33	PIEZOMETER	1497972.13	2064876.80	740.39	672.7 TO 662.7
BGWC-11	PIEZOMETER	1504998.94	2066093.83	683.91	619.2 TO 609.2
BGWC-13	PIEZOMETER	1505435.29	2065251.21	714.77	653.8 TO 643.8
BGWC-15	PIEZOMETER	1505278.19	2064732.18	715.39	654.5 TO 644.5
BGWC-37D	PIEZOMETER	1501293.16	2064362.70	693.50	595.8 TO 585.8
BGWC-39	PIEZOMETER	1501241.94	2064095.41	676.58	661.9 TO 651.9
BGWC-41D	PIEZOMETER	1501255.96	2064096.23	676.43	631.8 TO 621.8
BGWC-42D	PIEZOMETER	1501280.52	2064365.25	693.98	553.3 TO 543.3
BGWC-44D	PIEZOMETER	1499265.15	2065811.06	714.65	585.0 TO 575.0
PZ-1	PIEZOMETER	1505600.54	2066844.10	675.35	630.7 TO 620.7
PZ-2	PIEZOMETER	1503856.86	2062938.81	665.92	649.2 TO 639.2
PZ-3	PIEZOMETER	1505723.97	2066071.08	705.34	658.6 TO 648.6
PZ-4	PIEZOMETER	1505788.58	2064316.61	715.96	669.3 TO 659.3
PZ-5	PIEZOMETER	1498885.63	2063961.22	697.23	650.5 TO 640.5
PZ-6	PIEZOMETER	1500379.48	2063242.81	675.50	650.8 TO 640.8
PZ-8	PIEZOMETER	1504818.66	2064241.49	677.75	641.7 TO 631.7

- NOTES:
- GRADING SHOWN IN AND AROUND THE AP-1 AREA REPRESENTS FINAL CONDITIONS UPON COMPLETION OF CLOSURE.
  - MONITORING WELL COORDINATES, GROUND SURFACE ELEVATIONS, AND SCREEN ELEVATIONS WERE OBTAINED FROM THE "SEPTEMBER 2020 WELL INSTALLATION ADDENDUM MEMORANDUM" DATED 29 SEPTEMBER 2020, PREPARED BY GEOSYNTEC CONSULTANTS, INC. DATA FOR MONITORING WELLS BGWC-51 AND BGWC-52 WERE OBTAINED FROM THE "ASH POND MONITORING WELL CERTIFICATION REPORT - ADDENDUM NO. 4" DATED 24 MARCH 2021, PREPARED BY GEOSYNTEC CONSULTANTS, INC.
  - THE COORDINATES OF THE SURFACE WATER MONITORING POINTS ARE AS FOLLOWS:
    - SWC-01: 34° 7' 19.40" N, 84° 55' 47.42" W (IN NAD 83: NORTHING: 1500339.06, EASTING: 2065618.14).
    - SWC-02: 34° 7' 44.78" N, 84° 56' 3.85" W (IN NAD 83: NORTHING: 1502914.64, EASTING: 2064256.49).
    - SWC-03: 34° 7' 58.98" N, 84° 56' 3.96" W (IN NAD 83: NORTHING: 1504349.80, EASTING: 2064257.83).

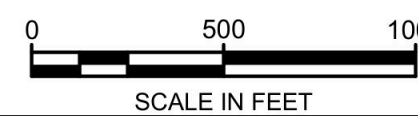

2	MAY 2025	UPDATE COMPLIANCE MONITORING NETWORK	JJV	RB
1	MAY 2024	UPDATE AND ADD GAS PIPELINES	JJV	RB
0	AUG. 2021	SUBMITTAL TO GA EPD	JV/KH	RB
REV	DATE	DESCRIPTION	DRN	APP
COMPLIANCE MONITORING NETWORK				
PLANT BOWEN ASH POND 1 (AP-1) CLOSURE DRAWINGS BARTOW COUNTY, GEORGIA				
<div>Geosyntec consultants</div>				
1255 ROBERTS BOULEVARD, NW, SUITE 200 KENNESAW, GEORGIA 30144 USA			PHONE: 678.202.9500 WWW.GEOSYNTEC.COM	
PROJ. NO.	GR6601	DWG.	GR6601-053	EDIT 5/5/2025
SCALE	1" = 500'	DRAWING 50 OF 50		
DATE	AUGUST 2021			

PERMIT DRAWING  
NOT FOR CONSTRUCTION