


PLANT WANSLEY ASH POND 1 CLOSURE BY REMOVAL


HEARD AND CARROLL COUNTIES, GEORGIA

CCR PERMIT DRAWINGS

NOVEMBER 2025

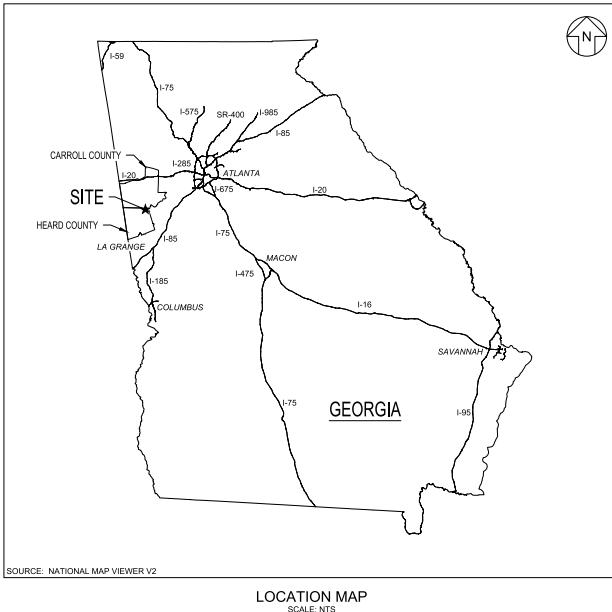

LIST OF DRAWINGS			
DWG NO.	DWG TITLE	CURRENT REV	DATE
01	COVER SHEET	2	11/10/2025
02	LEGENDS, SYMBOLS, AND ABBREVIATIONS	1	11/10/2025
03	PROPERTY BOUNDARY SURVEY AND LEGAL DESCRIPTION	1	7/9/2025
04	SITE GROUNDWATER MONITORING PLAN	2	11/10/2025
05	EXISTING SITE CONDITIONS - TOPOGRAPHY AND AP-1 BATHYMETRY	2	11/10/2025
06	CCR REMOVAL PLAN - OVERVIEW	2	11/10/2025
07	CCR REMOVAL PLAN - I	0	2/6/2025
08	CCR REMOVAL PLAN - II	0	2/6/2025
09	CCR REMOVAL PLAN - III	1	11/10/2025
10	CCR REMOVAL PLAN - IV	0	2/6/2025
11	CCR REMOVAL PLAN - V	1	7/9/2025
12	SITE RESTORATION GRADING PLAN	2	11/10/2025
13	SEPARATOR DIKE PLAN	1	11/10/2025
14	SITE SECTIONS - I	0	2/6/2025
15	SITE SECTIONS - II	0	2/6/2025
16	SEPARATOR DIKE SECTIONS	1	11/10/2025
17	CONSTRUCTION SEQUENCING PLAN - I	1	11/10/2025
18	CONSTRUCTION SEQUENCING PLAN - II	1	11/10/2025
19	FINAL STORMWATER AND ESC PLAN	2	11/10/2025
20	STORMWATER AND ESC DETAILS - I	1	11/10/2025
21	STORMWATER AND ESC DETAILS - II	1	11/10/2025
22	STORMWATER AND ESC DETAILS - III	1	11/10/2025

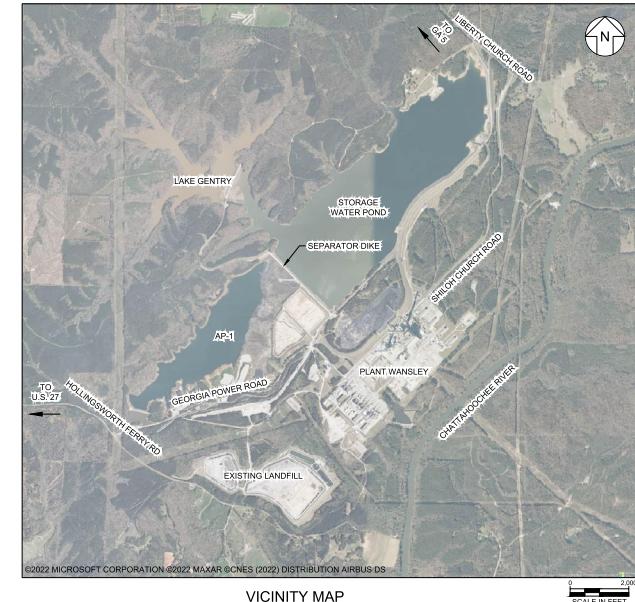

PREPARED FOR:



GEORGIA POWER ENVIRONMENTAL AFFAIRS
241 RALPH MCGILL BOULEVARD NE
ATLANTA, GEORGIA 30308-3374
TELEPHONE: 404.506.6505
EMAIL: GPCENV@SOUTHERNCO.COM

PHYSICAL SITE ADDRESS:
PLANT WANSLEY
1371 LIBERTY CHURCH ROAD
CARROLLTON, GA 30116

PREPARED BY:




1255 ROBERTS BOULEVARD NW, SUITE 200
KENNESAW, GEORGIA 30144-3694
TELEPHONE: 678.202.9500





Approved
Solid Waste Management Program
Approved by: Tammy Bushell



2	11/10/25	MINOR PERMIT MOD 2 - REVISION TO AP-1 DESIGN	WSA	AMG
1	07/09/25	MINOR PERMIT MOD 1 - REVISION TO AP-1 PERMIT BOUNDARY	WSA	AMG
0	02/06/25	GA EPD CCR PERMIT DRAWINGS	BSJ	AMG
REV	DATE	DESCRIPTION	DRN	APP
COVER SHEET				
PLANT WANSLEY ASH POND CLOSURE BY REMOVAL HEARD AND CARROLL COUNTIES, GEORGIA				
Geosyntec		Georgia Power		
consultants		Georgia Power		
1255 ROBERTS BOULEVARD, NW, SUITE 200 KENNESAW, GEORGIA 30144-3694 PHONE: 678.202.9500 WWW.GEOSYNTEC.COM				
PROJ. NO.	GW9155	DWG.	GW7306.13-C01	EDIT 11/10/25
SCALE	AS SHOWN	DATE	NOVEMBER 2025	DRAWING 01 OF 22

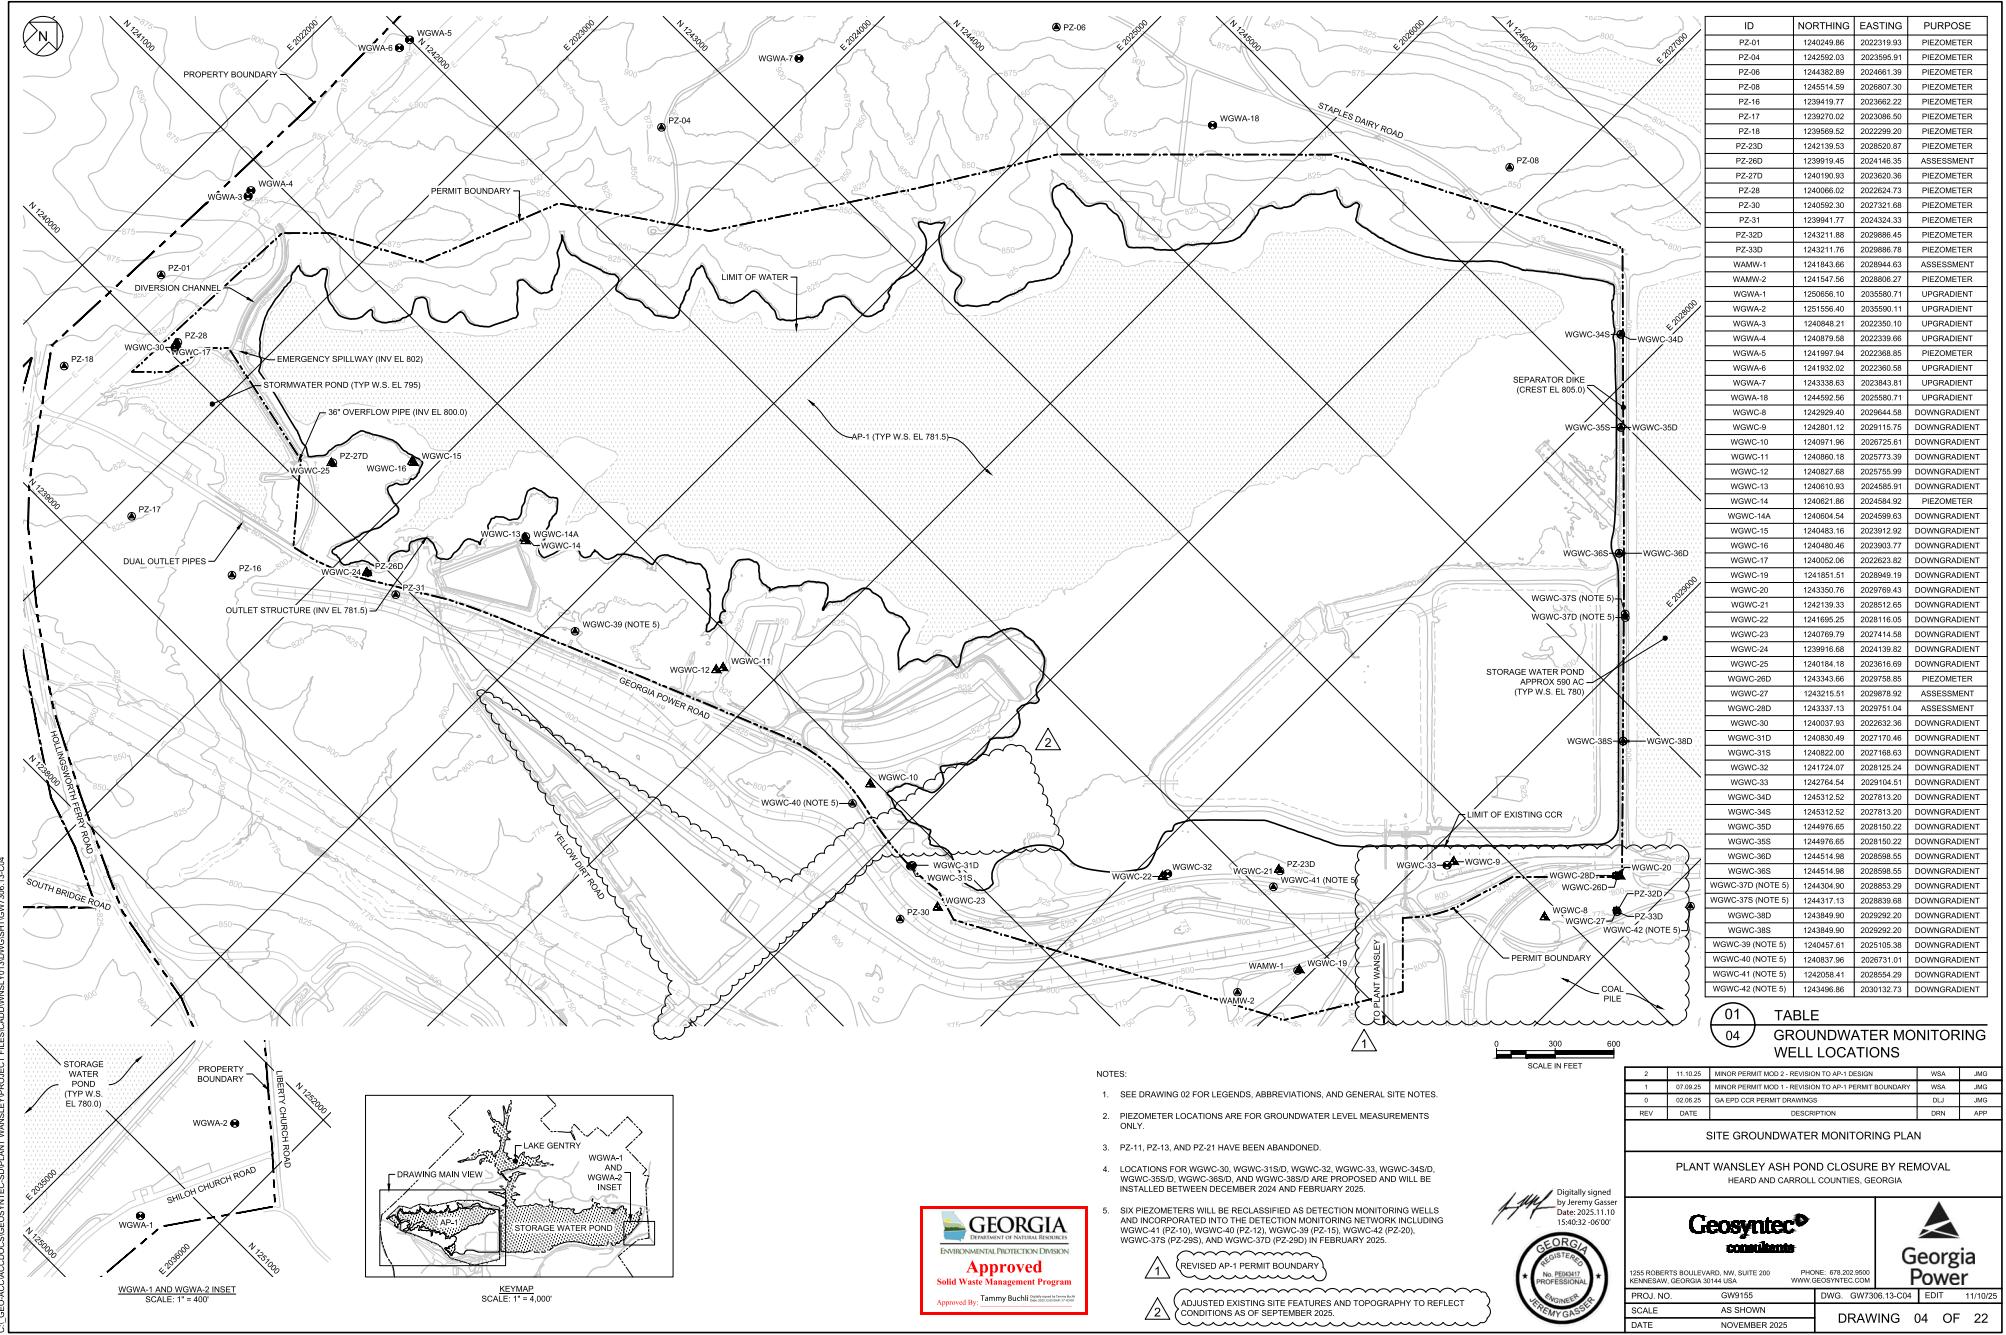


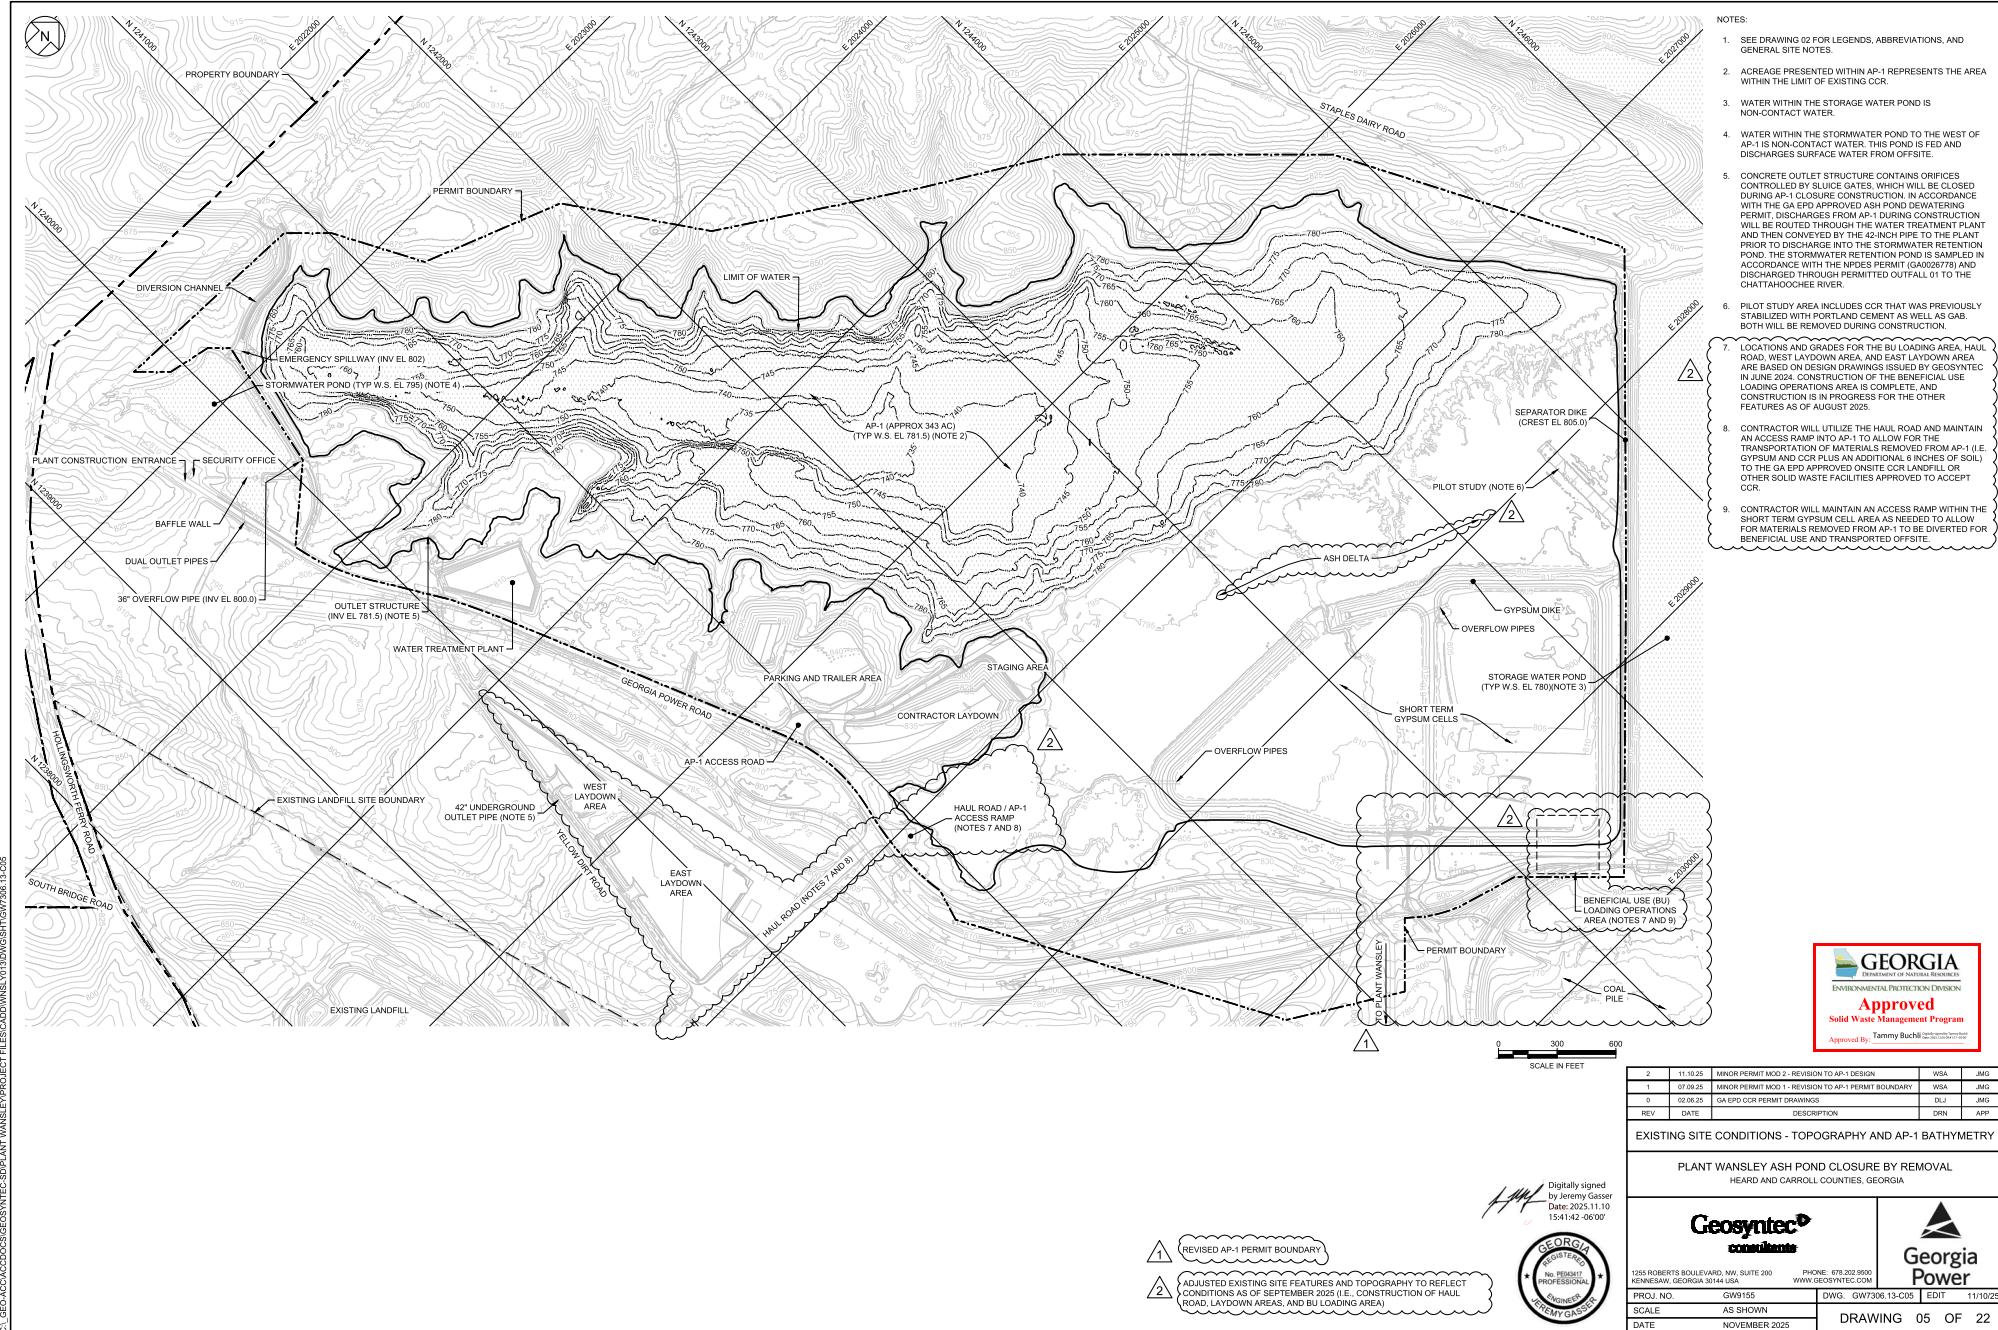

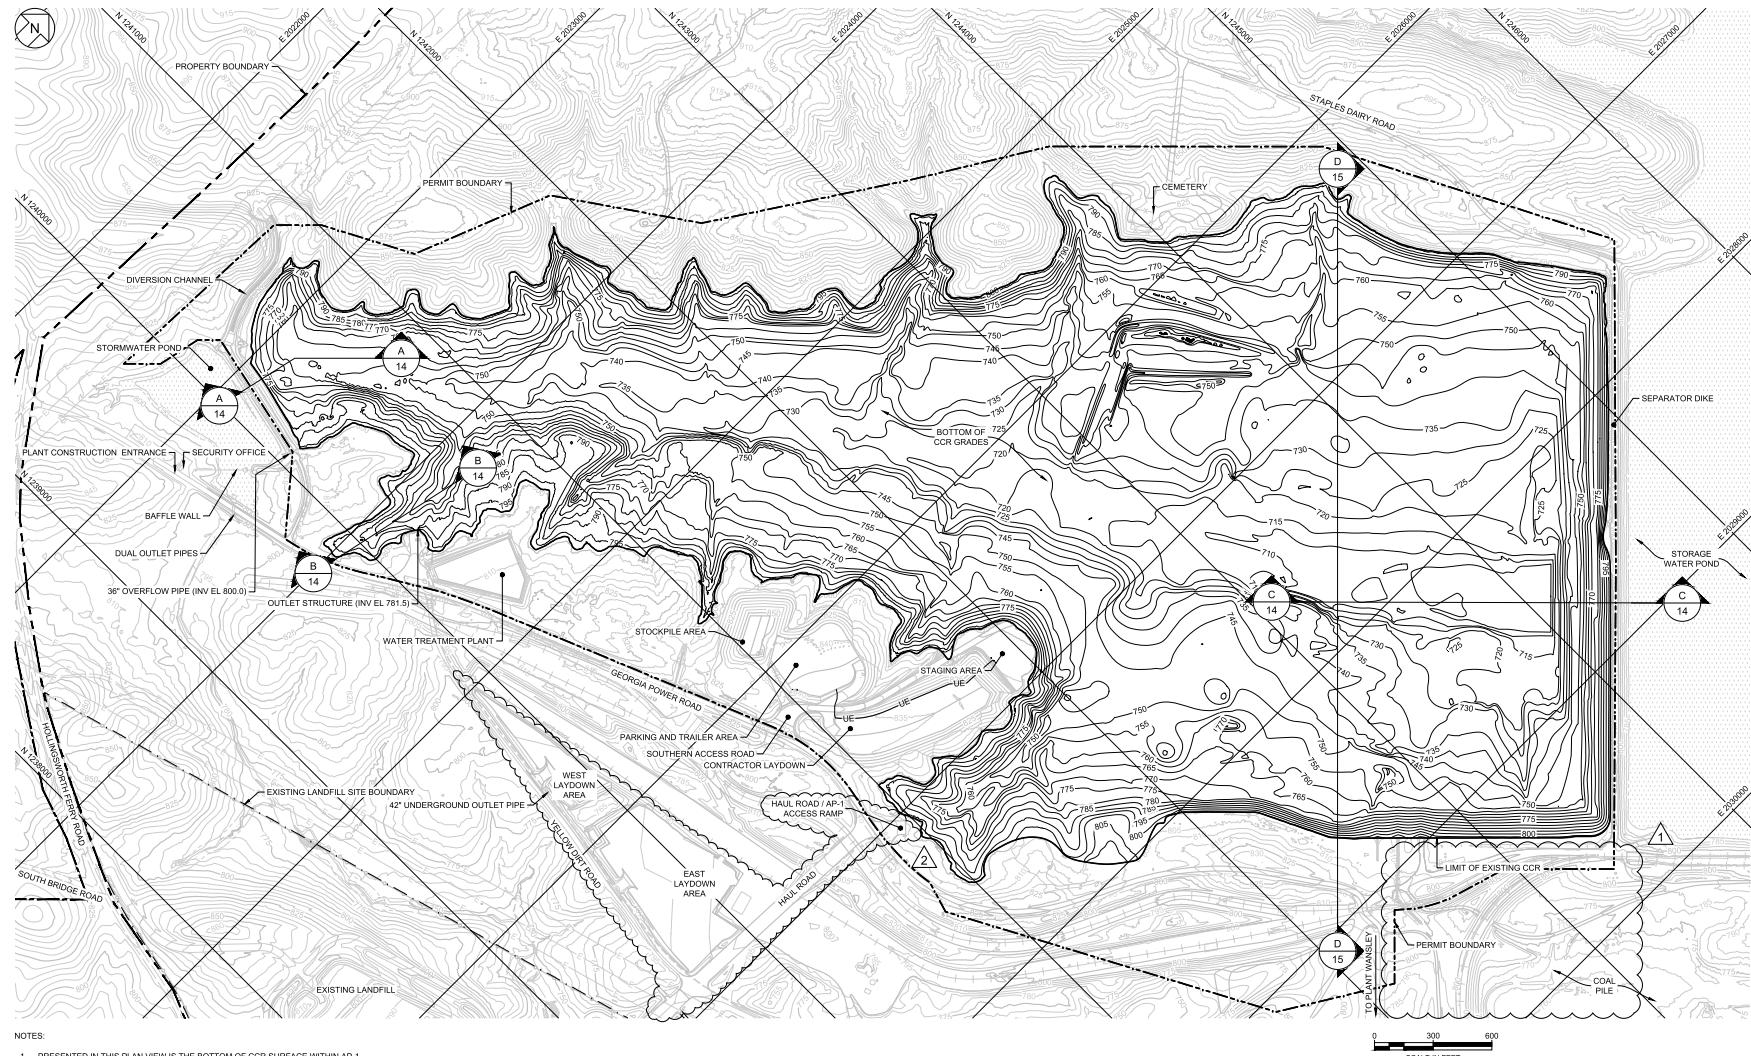

NOTES:

1. PRESENTED IN THIS PLAN VIEW IS THE BOTTOM OF CCR SURFACE WITHIN AP-1. ADDITIONAL 6-INCHES OF REMOVAL NOT SHOWN FOR CLARITY.
2. LATERAL AND VERTICAL LIMIT OF THE BOTTOM OF CCR IS APPROXIMATE AND IS TO BE FIELD VERIFIED DURING CONSTRUCTION.
3. BULK OF CCR REMOVAL MAY BE ACHIEVED BY CONTRACTOR MEANS AND METHODS (E.G., CONVENTIONAL EXCAVATION OR DREDGING). FINAL REMOVAL OF CCR AND VERIFICATION OF REMOVAL WILL BE COMPLETED IN THE DRY VIA CONVENTIONAL EXCAVATION.
4. DRAINING REQUIREMENT FOR IN-TERM CUT SLOPES TO MAINTAIN STABILITY OF CCR DURING CONSTRUCTION WILL BE ESTABLISHED AS PART OF THE DETAILED DESIGN AND CONTRACTOR WORK PLANS.
5. CCR VERIFICATION OF REMOVAL WILL BE COMPLETED BY THE COA CONSULTANT ON A 100-FT BY 100-FT GRID SYSTEM. FOLLOWING VERIFICATION OF CCR REMOVAL, THE CONTRACTOR WILL REMOVE 6-INCHES OF NATIVE SOIL AND COA CONSULTANT WILL AGAIN COMPLETE THE VERIFICATION PROCESS TO CERTIFY CCR REMOVAL.
6. 100-FT BY 100-FT GRID SYSTEM IS NOT SHOWN ON THIS DRAWING FOR CLARITY. SEE DRAWINGS 07 THROUGH 11.

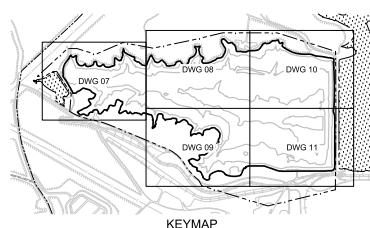

REVISED AP-1 PERMIT BOUNDARY

ADJUSTED EXISTING SITE FEATURES AND TOPOGRAPHY TO REFLECT CONDITIONS AS OF SEPTEMBER 2025 (I.E., CONSTRUCTION OF HAUL ROAD AND LAYDOWN AREAS)




CCR REMOVAL PLAN - OVERVIEW

PLANT WANSLEY ASH POND CLOSURE BY REMOVAL
HEARD AND CARROLL COUNTIES, GEORGIA



2	11-10-05	MINOR PERMIT MOD 2 - REVISION TO AP-1 DESIGN	WSA	APP
1	02-09-05	MINOR PERMIT MOD 1 - REVISION TO AP-1 PERMIT BOUNDARY	WSA	APP
0	02-06-25	GA EPD COR PERMIT DRAWINGS	BJJ	JMG
REV DATE DESCRIPTION				
09/26/2025 DRN APP				
GW7306-13-C06				
DRAWING 06 OF 22				

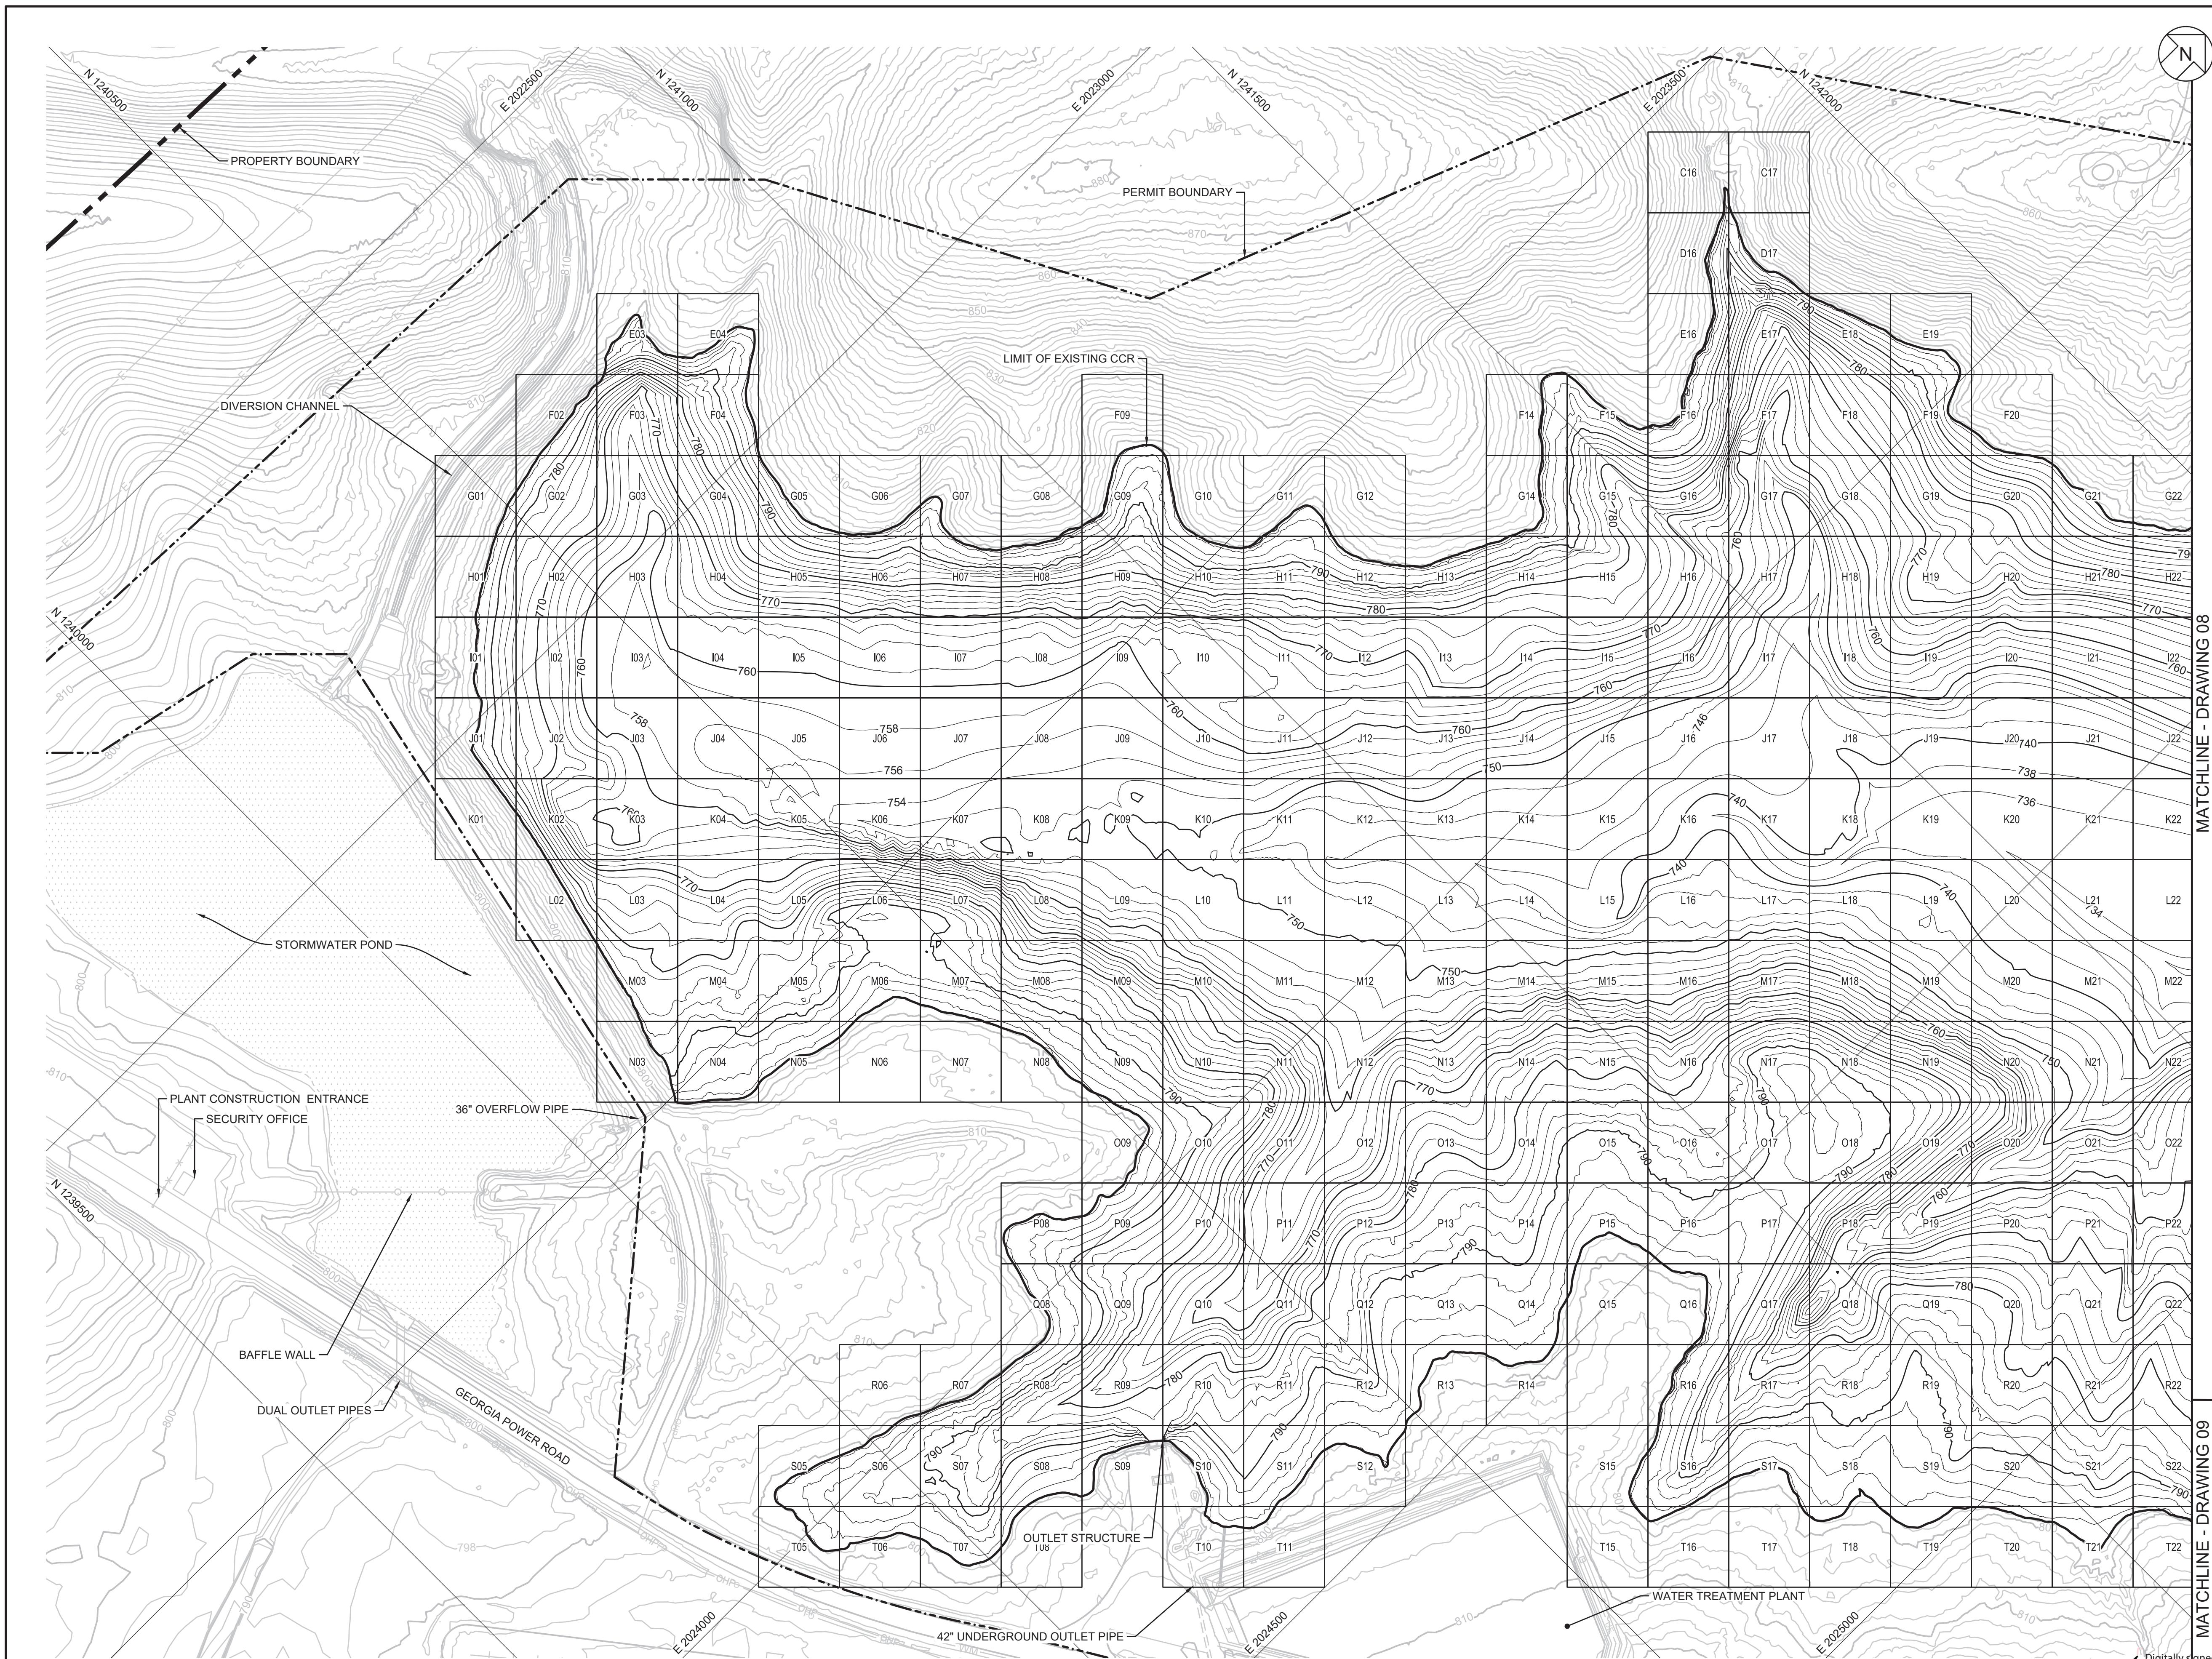

NOTES:

1. PRESENTED IN THIS PLAN VIEW IS THE BOTTOM OF CCR SURFACE WITHIN AP-1. ADDITIONAL 6-INCHES OF REMOVAL NOT SHOWN FOR CLARITY.
2. LATERAL AND VERTICAL LIMIT OF THE BOTTOM OF CCR IS APPROXIMATE AND IS TO BE FIELD VERIFIED DURING CONSTRUCTION.
3. BULK OF CCR REMOVAL MAY BE ACHIEVED BY CONTRACTOR MEANS AND METHODS (E.G., CONVENTIONAL EXCAVATION OR DREDGING). FINAL REMOVAL OF CCR AND VERIFICATION OF REMOVAL WILL BE COMPLETED IN THE DRY VIA CONVENTIONAL EXCAVATION.
4. GRADING REQUIREMENTS FOR INTERIM CUT SLOPES TO MAINTAIN STABILITY OF CCR DURING CONSTRUCTION WILL BE ESTABLISHED AS PART OF THE DETAILED DESIGN AND CONTRACTOR WORK PLANS.
5. CCR VERIFICATION OF REMOVAL WILL BE COMPLETED BY THE CQA CONSULTANT ON A 100-FT BY 100-FT GRID SYSTEM. FOLLOWING VERIFICATION OF CCR REMOVAL, THE CONTRACTOR WILL REMOVE 6-INCHES OF NATIVE SOIL AND CQA CONSULTANT WILL AGAIN COMPLETE THE VERIFICATION PROCESS TO CERTIFY CCR REMOVAL.

MATCHLINE DRAWING 08

MATCHINE DRAWING 00

0	02.06.25	GA EPD CCR PERMIT DRAWINGS	DLJ	JMG
REV	DATE	DESCRIPTION	DRN	APP

CCR REMOVAL PLAN - I

Digitized by srujanika@gmail.com

**PLANT WANSLEY ASH POND CLOSURE BY REMOVAL
HEARD AND CARROLL COUNTIES, GEORGIA**

WILHELM AND CARINNE SOHNKE, GERMANY

Digitized by srujanika@gmail.com

Geosyntec

consultants

consultants


PO BOX 200000 • ATLANTA, GA 30320-4000 • 678.202.9500 • WWW.GEOSYNTEC.COM

GW9155 DWG. GW7306.13-C07 EDIT

AS SHOWN


FEBRUARY 2025 DRAWING 07



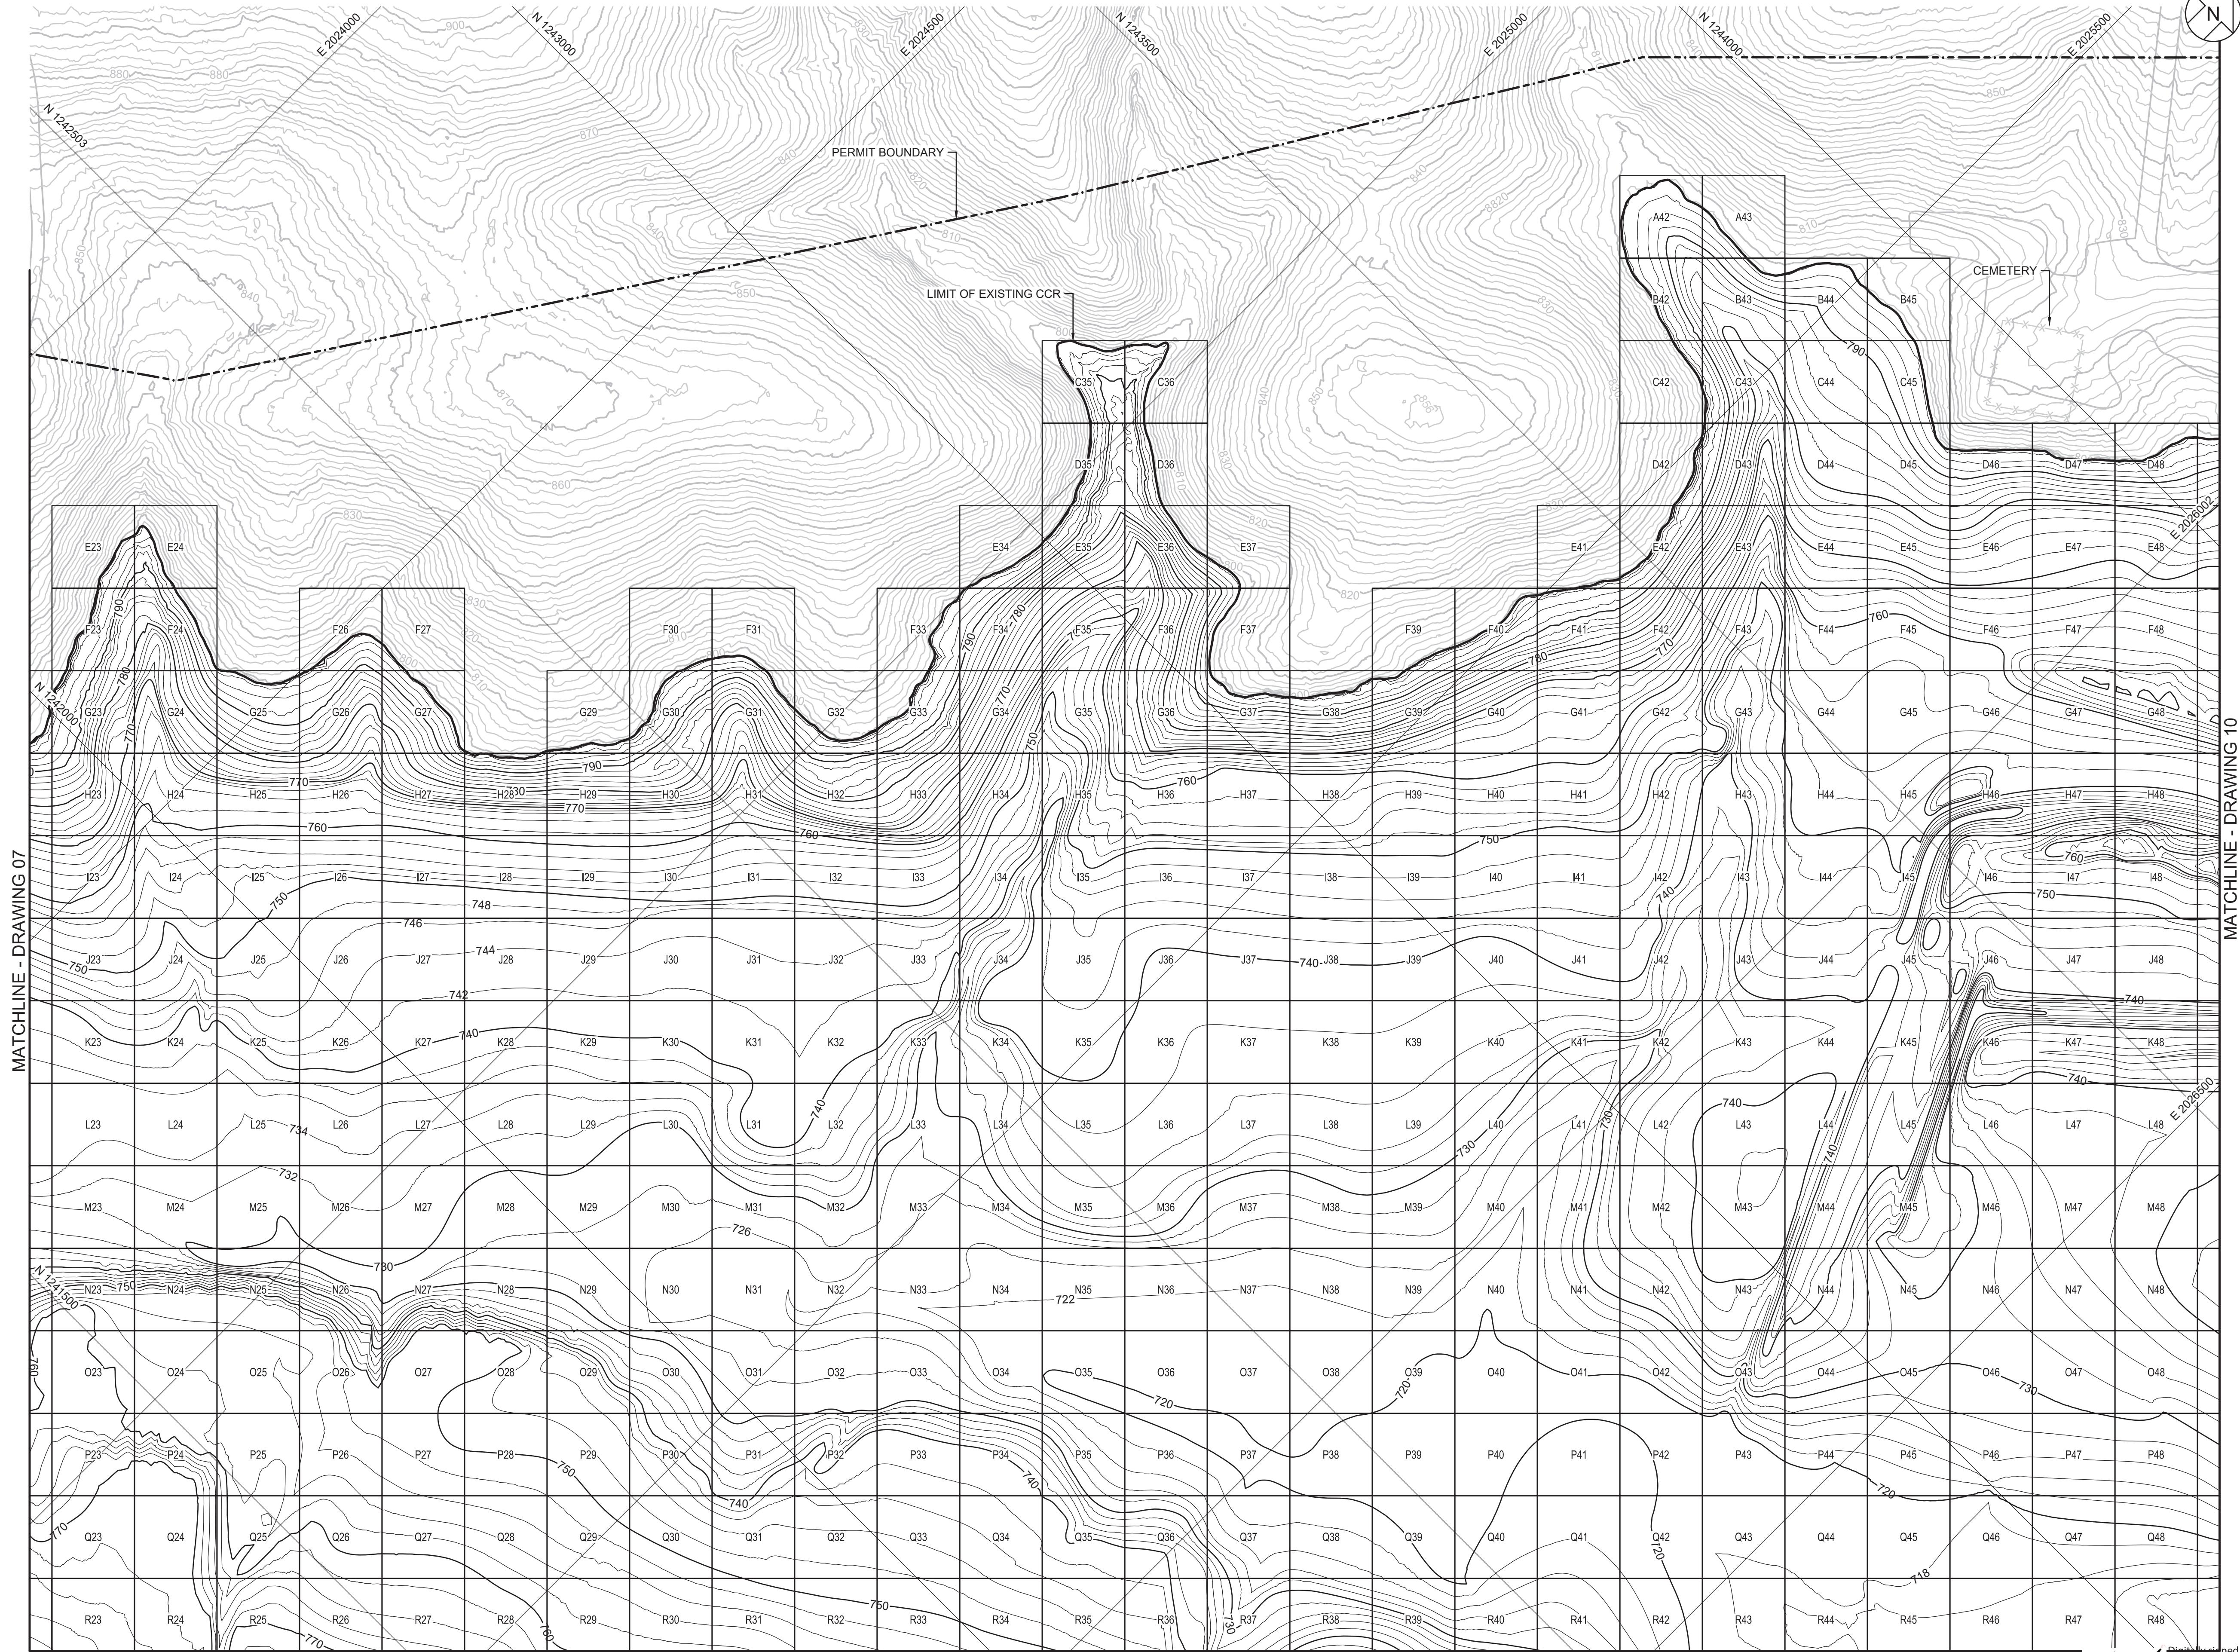


NOTES:

- PRESENTED IN THIS PLAN VIEW IS THE BOTTOM OF CCR SURFACE WITHIN AP-1. ADDITIONAL 6-INCHES OF REMOVAL NOT SHOWN FOR CLARITY.
- LATERAL AND VERTICAL LIMIT OF THE BOTTOM OF CCR IS APPROXIMATE AND IS TO BE FIELD VERIFIED DURING CONSTRUCTION.
- BULK OF CCR REMOVAL MAY BE ACHIEVED BY CONTRACTOR MEANS AND METHODS (E.G., CONVENTIONAL EXCAVATION OR DREDGING). FINAL REMOVAL OF CCR AND VERIFICATION OF REMOVAL WILL BE COMPLETED IN THE DRY VIA CONVENTIONAL EXCAVATION.
- GRADING REQUIREMENTS FOR INTERIM CUT SLOPES TO MAINTAIN STABILITY OF CCR DURING CONSTRUCTION WILL BE ESTABLISHED AS PART OF THE DETAILED DESIGN AND CONTRACTOR WORK PLANS.
- CCR VERIFICATION OF REMOVAL WILL BE COMPLETED BY THE CQA CONSULTANT ON A 100-Ft BY 100-Ft GRID SYSTEM. FOLLOWING VERIFICATION OF CCR REMOVAL, THE CONTRACTOR WILL REMOVE 6-INCHES OF NATIVE SOIL AND CQA CONSULTANT WILL AGAIN COMPLETE THE VERIFICATION PROCESS TO CERTIFY CCR REMOVAL.

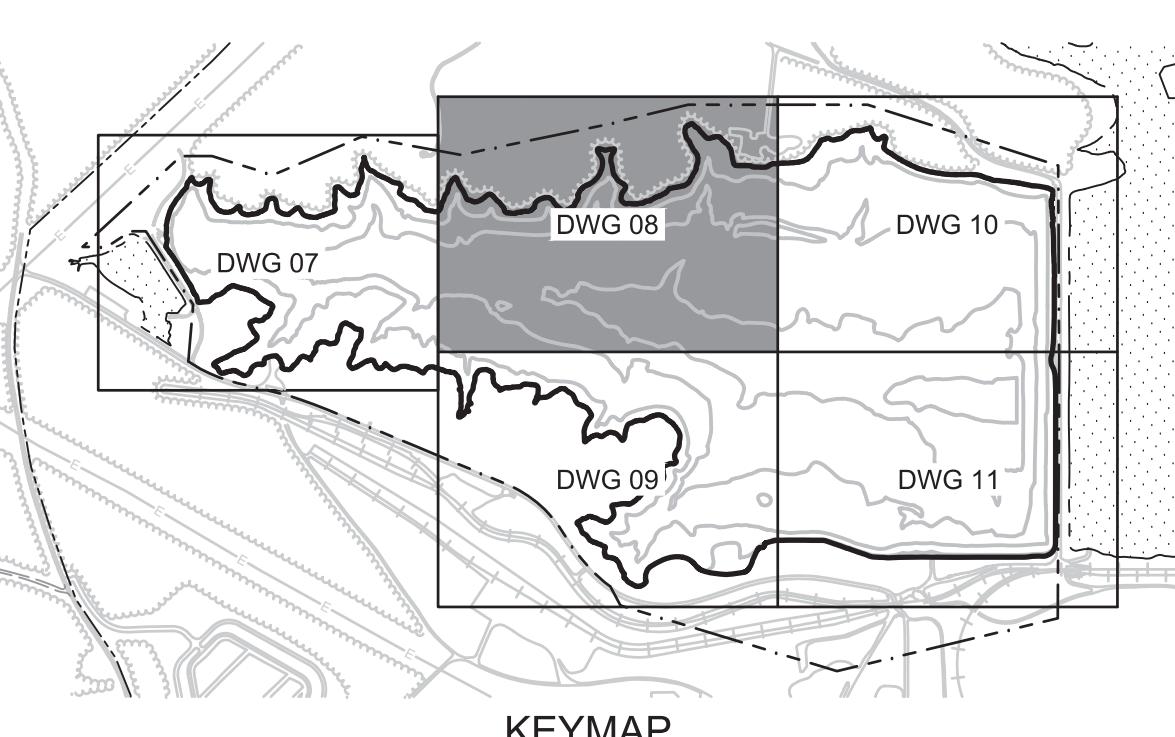

0	02.06.25	GA EPD CCR PERMIT DRAWINGS	DLJ	JMG
REV	DATE	DESCRIPTION	DRN	APP
CCR REMOVAL PLAN - II				


PLANT WANSLEY ASH POND CLOSURE BY REMOVAL
HEARD AND CARROLL COUNTIES, GEORGIA

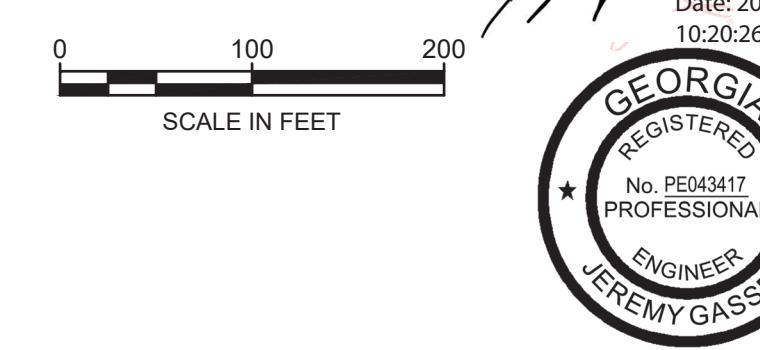


Geosyntec
consultants

Georgia
Power


PROJ. NO.	GW9155	DWG. GW7306.13-C08	EDIT	5/2/24
SCALE	AS SHOWN			
DATE	FEBRUARY 2025	DRAWING 08 OF 22		

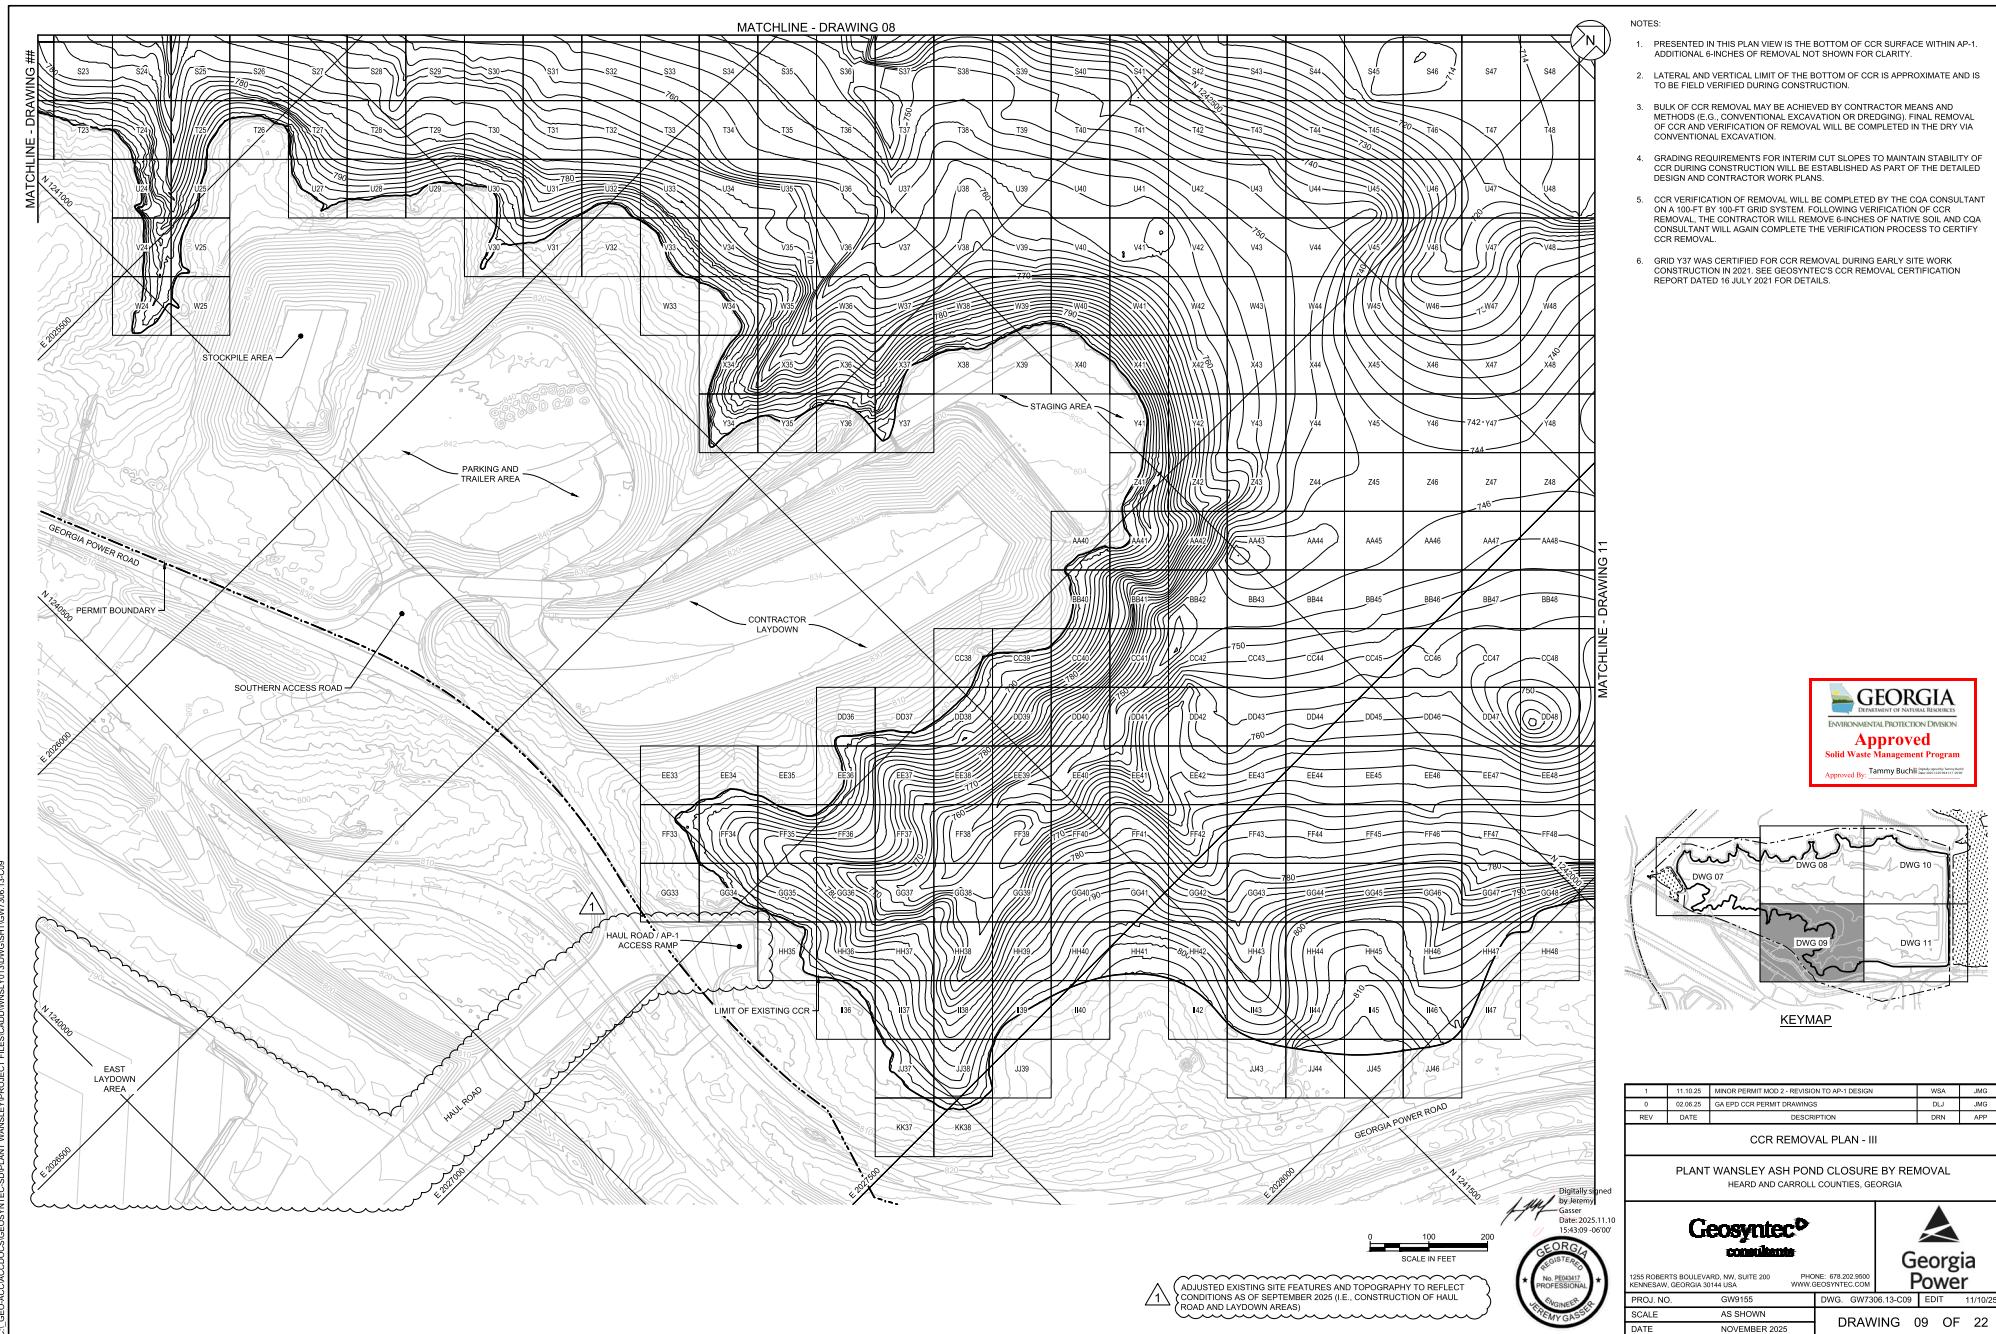

MATCHLINE - DRAWING 08

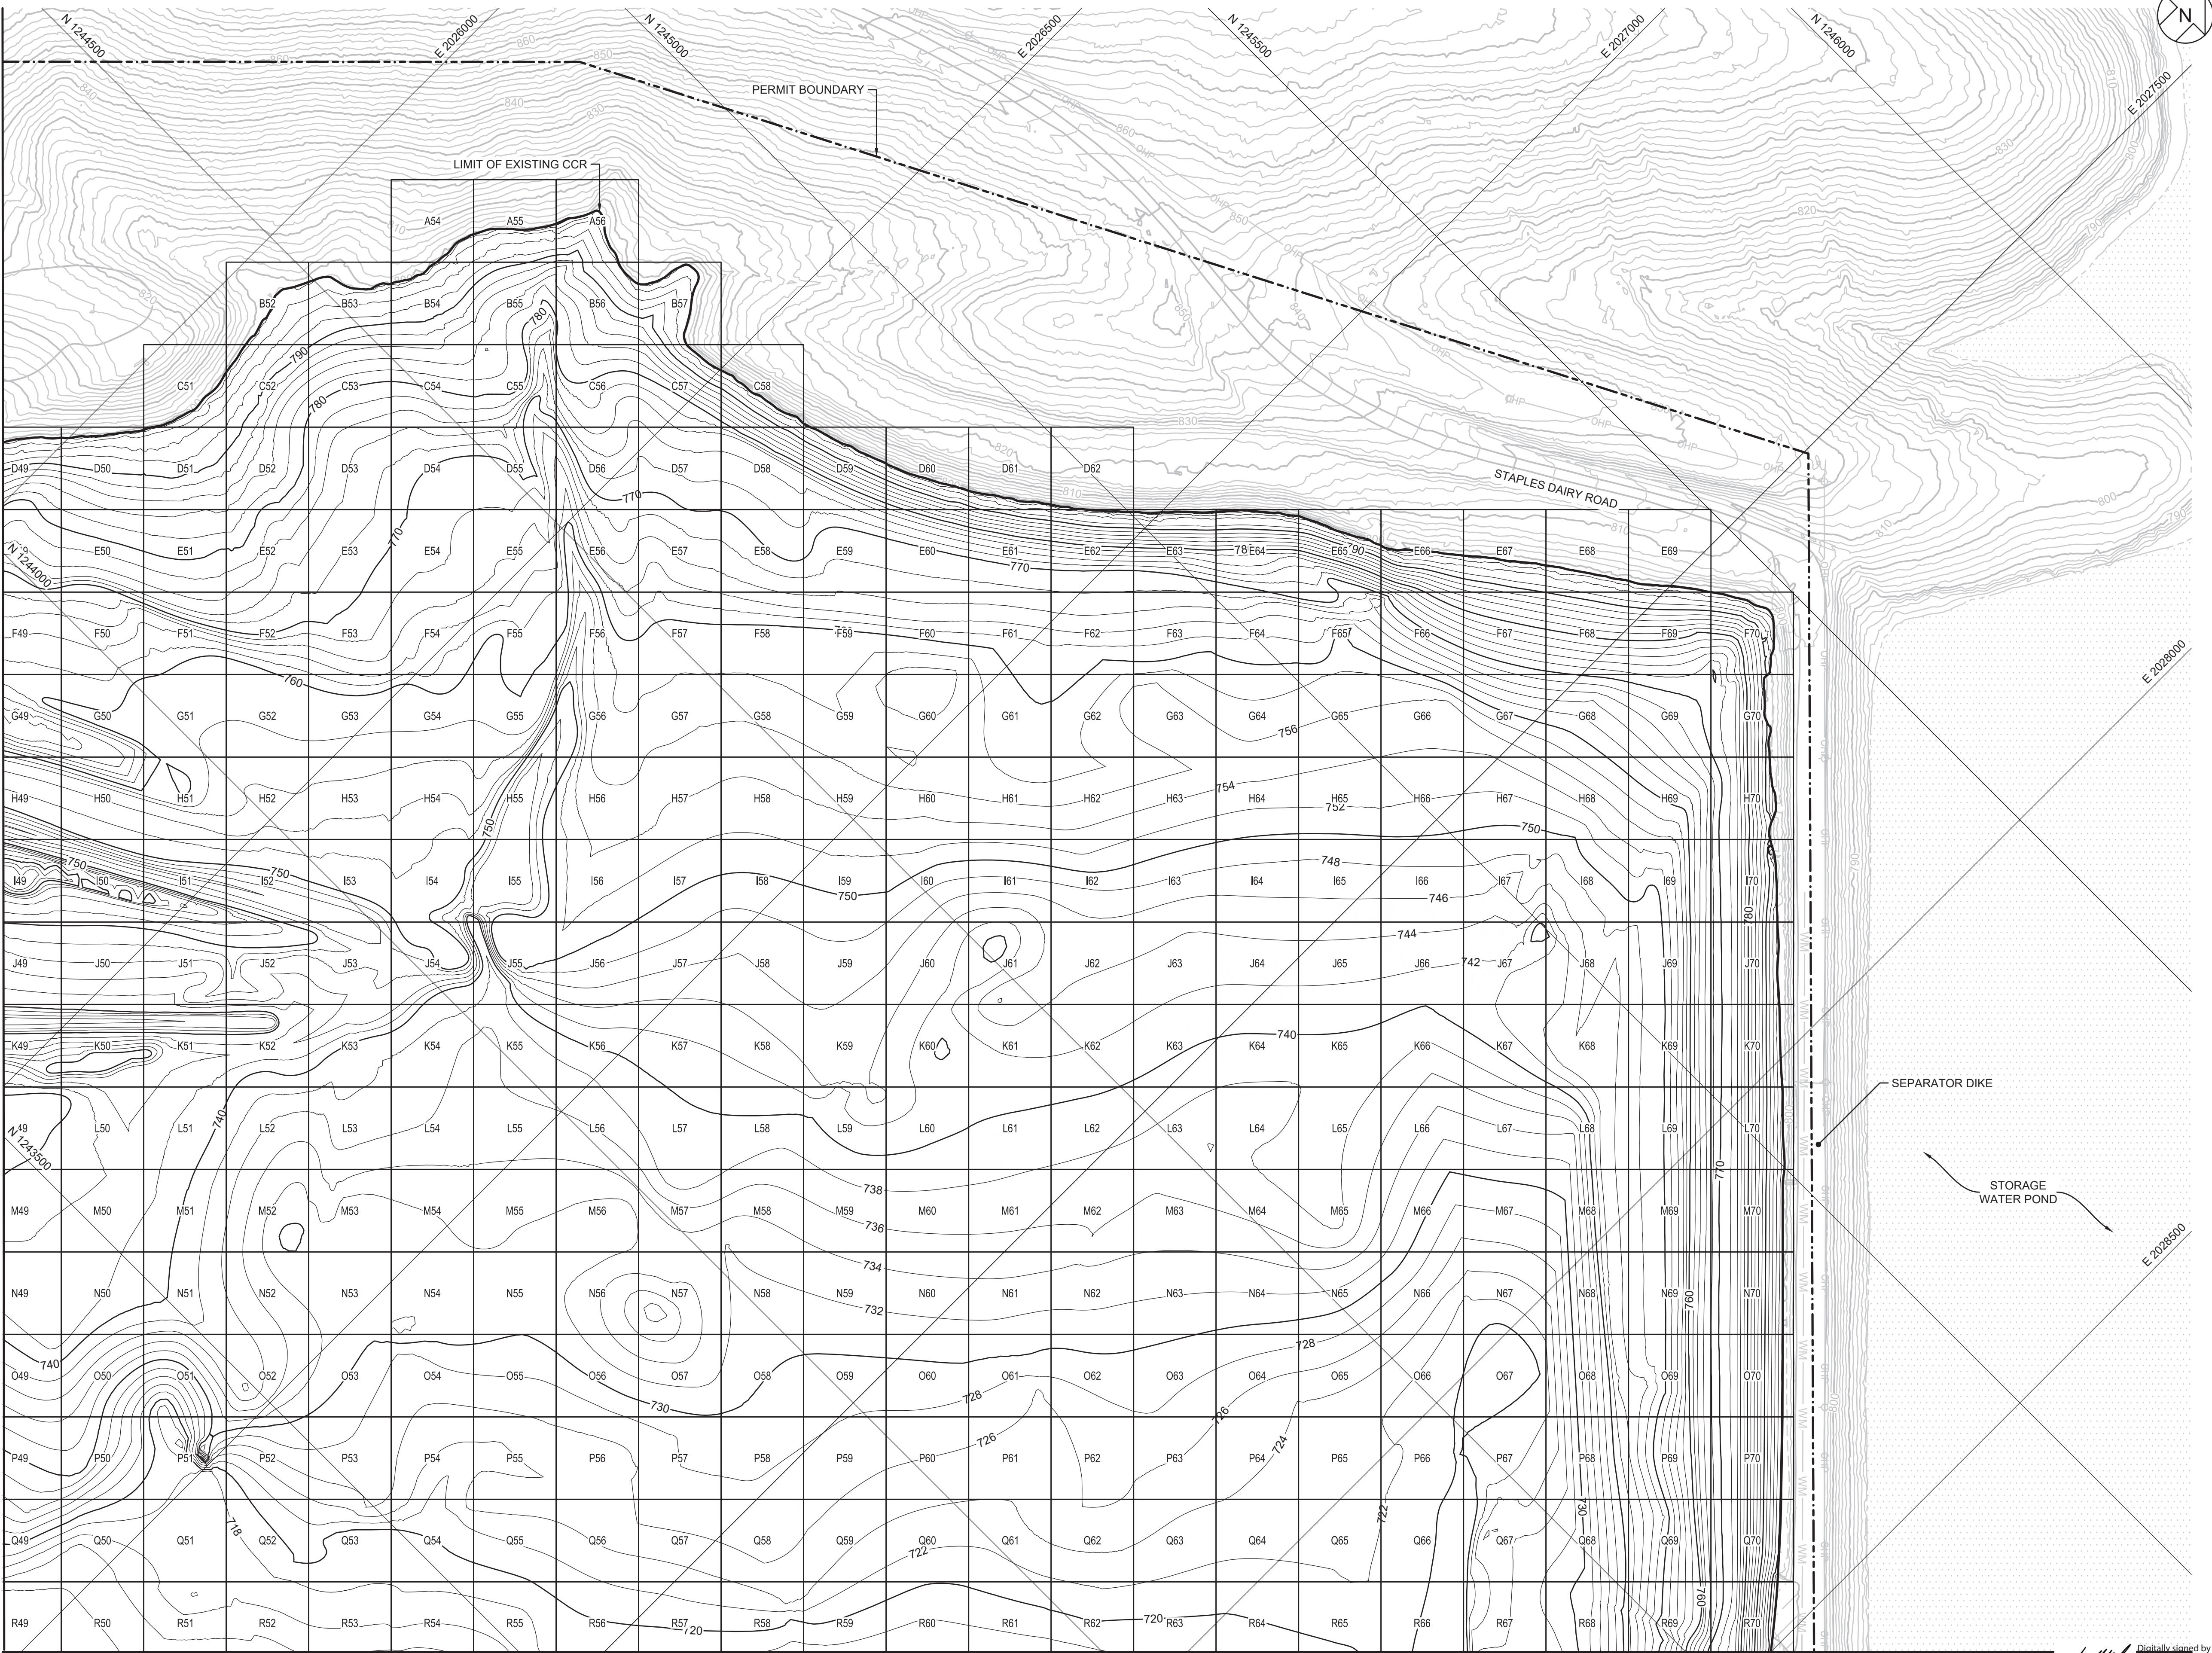


MATCHLINE - DRAWING 11

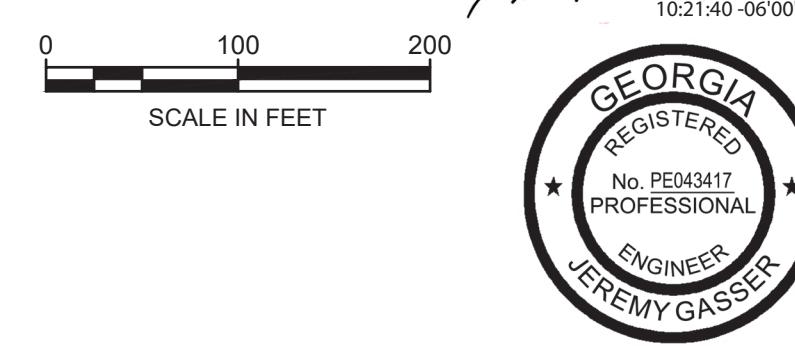

NOTES:

1. PRESENTED IN THIS PLAN VIEW IS THE BOTTOM OF CCR SURFACE WITHIN AP-1. ADDITIONAL 6-INCHES OF REMOVAL NOT SHOWN FOR CLARITY.
2. LATERAL AND VERTICAL LIMIT OF THE BOTTOM OF CCR IS APPROXIMATE AND IS TO BE FIELD VERIFIED DURING CONSTRUCTION.
3. BULK OF CCR REMOVAL MAY BE ACHIEVED BY CONTRACTOR MEANS AND METHODS (E.G., CONVENTIONAL EXCAVATION OR DREDGING). FINAL REMOVAL OF CCR AND VERIFICATION OF REMOVAL WILL BE COMPLETED IN THE DRY VIA CONVENTIONAL EXCAVATION.
4. GRADING REQUIREMENTS FOR INTERIM CUT SLOPES TO MAINTAIN STABILITY OF CCR DURING CONSTRUCTION WILL BE ESTABLISHED AS PART OF THE DETAILED DESIGN AND CONTRACTOR WORK PLANS.
5. CCR VERIFICATION OF REMOVAL WILL BE COMPLETED BY THE CQA CONSULTANT ON A 100-FT BY 100-FT GRID SYSTEM. FOLLOWING VERIFICATION OF CCR REMOVAL, THE CONTRACTOR WILL REMOVE 6-INCHES OF NATIVE SOIL AND CQA CONSULTANT WILL AGAIN COMPLETE THE VERIFICATION PROCESS TO CERTIFY CCR REMOVAL.

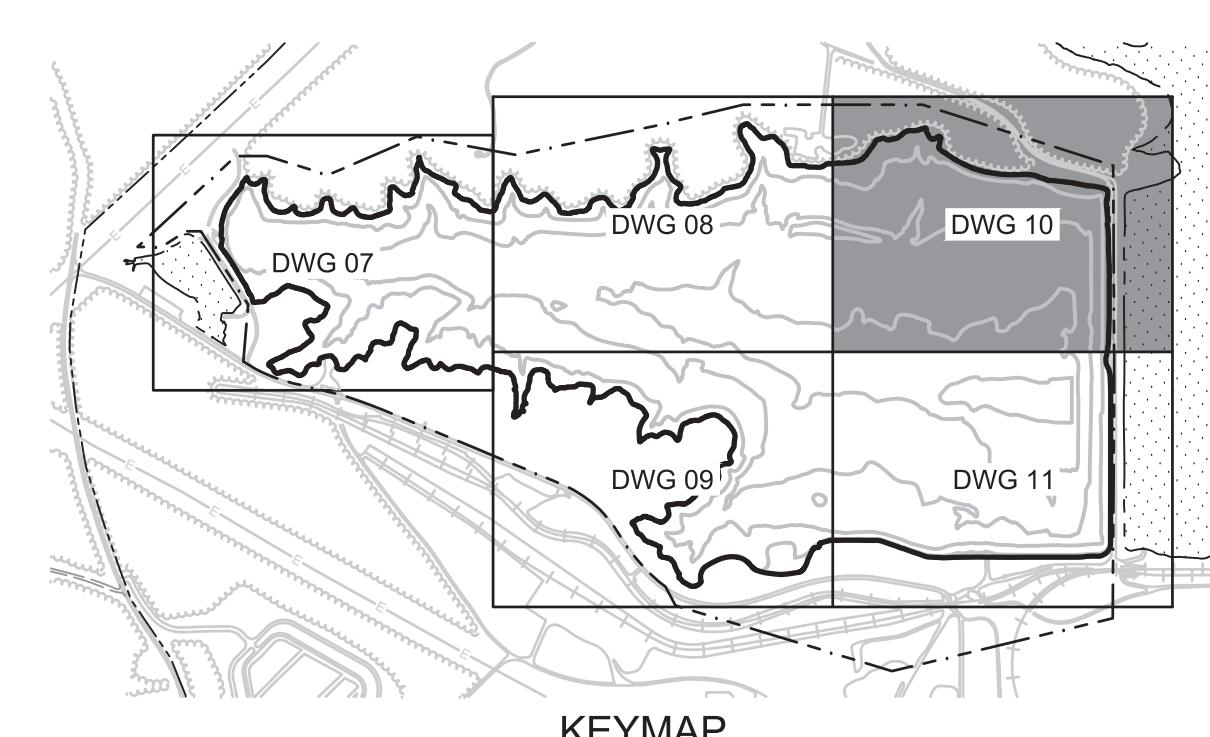

0	02.06.25	GA EPD CCR PERMIT DRAWINGS	DLJ	JMG
REV	DATE	DESCRIPTION	DRN	APP


CCR REMOVAL PLAN - IV

PLANT WANSLEY ASH POND CLOSURE BY REMOVAL
HEARD AND CARROLL COUNTIES, GEORGIA

PROJ. NO.	GW9155	DWG. GW7306.13-C10	EDIT	5/2/24
SCALE	AS SHOWN			
DATE	FEBRUARY 2025	DRAWING	10	OF 22

MATCHLINE - DRAWING 10

MATCHLINE - DRAWING 09

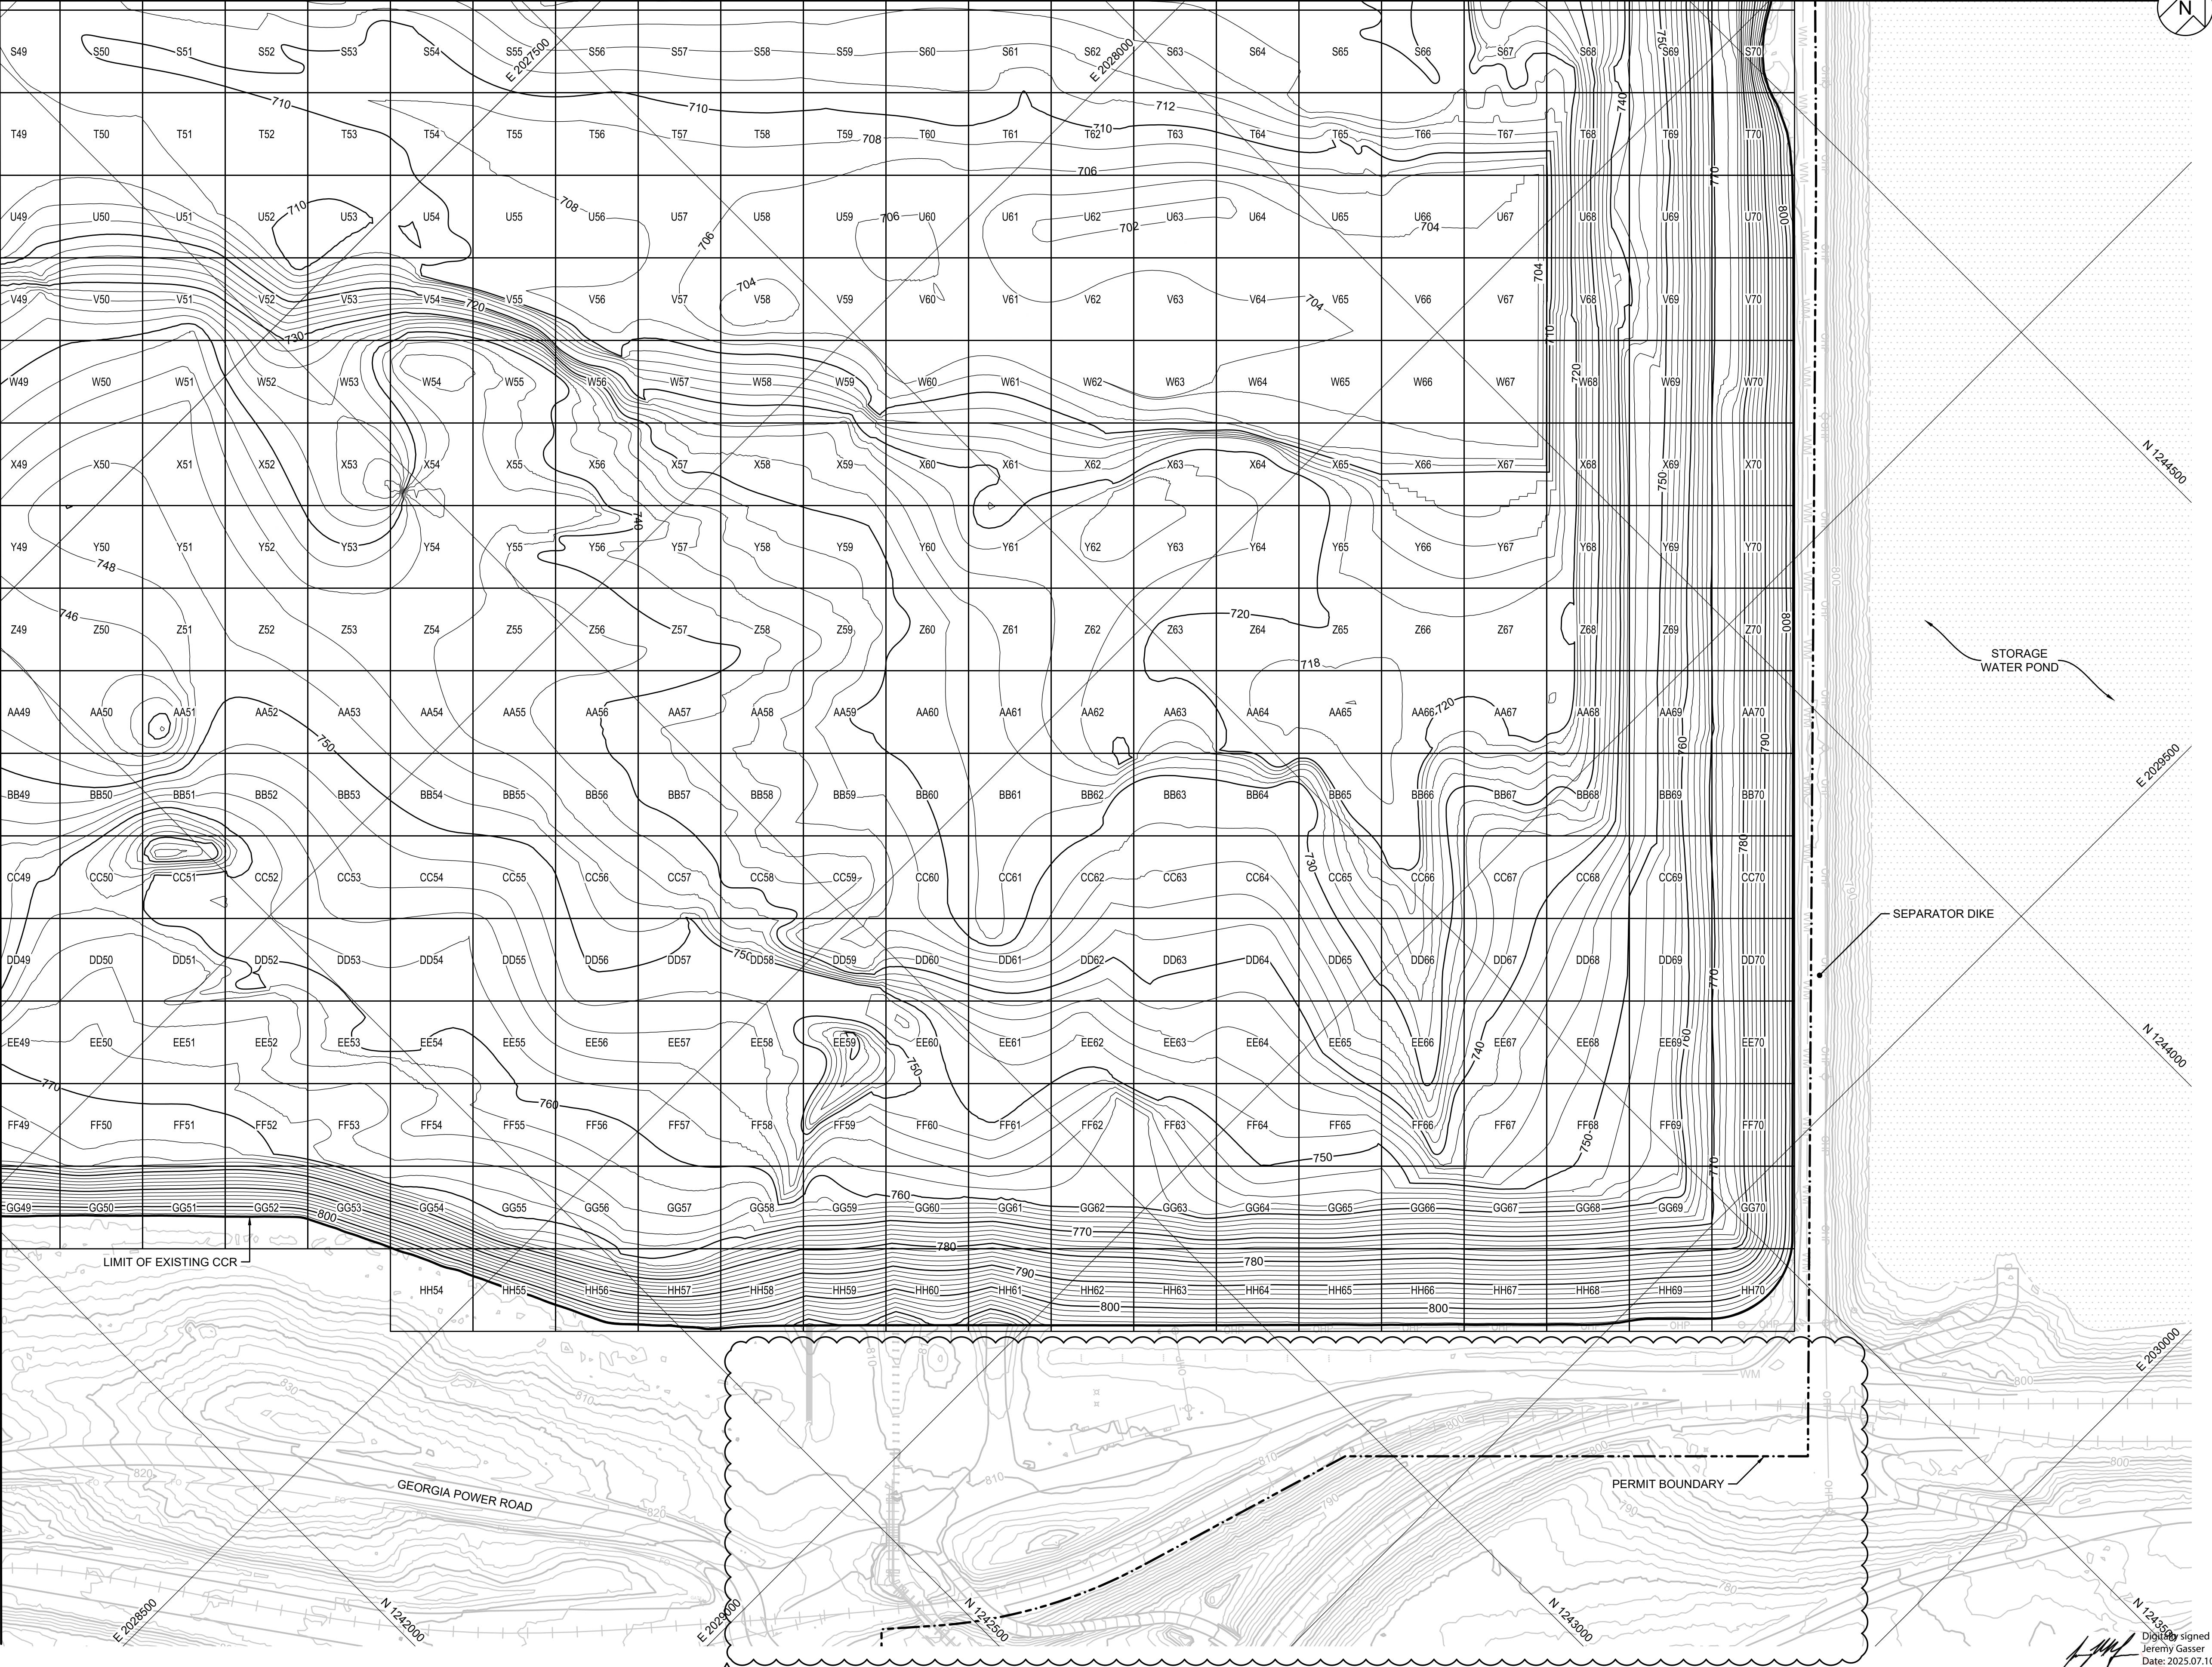

NOTES:

1. PRESENTED IN THIS PLAN VIEW IS THE BOTTOM OF CCR SURFACE WITHIN AP-1. ADDITIONAL 6-INCHES OF REMOVAL NOT SHOWN FOR CLARITY.
2. LATERAL AND VERTICAL LIMIT OF THE BOTTOM OF CCR IS APPROXIMATE AND IS TO BE FIELD VERIFIED DURING CONSTRUCTION.
3. BULK OF CCR REMOVAL MAY BE ACHIEVED BY CONTRACTOR MEANS AND METHODS (E.G., CONVENTIONAL EXCAVATION OR DREDGING). FINAL REMOVAL OF CCR AND VERIFICATION OF REMOVAL WILL BE COMPLETED IN THE DRY VIA CONVENTIONAL EXCAVATION.
4. GRADING REQUIREMENTS FOR INTERIM CUT SLOPES TO MAINTAIN STABILITY OF CCR DURING CONSTRUCTION WILL BE ESTABLISHED AS PART OF THE DETAILED DESIGN AND CONTRACTOR WORK PLANS.
5. CCR VERIFICATION OF REMOVAL WILL BE COMPLETED BY THE CQA CONSULTANT ON A 100-FT BY 100-FT GRID SYSTEM. FOLLOWING VERIFICATION OF CCR REMOVAL, THE CONTRACTOR WILL REMOVE 6-INCHES OF NATIVE SOIL AND CQA CONSULTANT WILL AGAIN COMPLETE THE VERIFICATION PROCESS TO CERTIFY CCR REMOVAL.


1	07.09.25	MINOR PERMIT MOD 1 - REVISION TO AP-1 PERMIT BOUNDARY	WSA	JMG
0	02.06.25	GA EPD CCR PERMIT DRAWINGS	DLJ	JMG

CCR REMOVAL PLAN - V

PLANT WANSLEY ASH POND CLOSURE BY REMOVAL
HEARD AND CARROLL COUNTIES, GEORGIA

PROJ. NO.	GW9155	DWG. GW7306.13-C11	EDIT	7/9/25
SCALE	AS SHOWN			
DATE	FEBRUARY 2025			
DRAWING	11	OF	22	



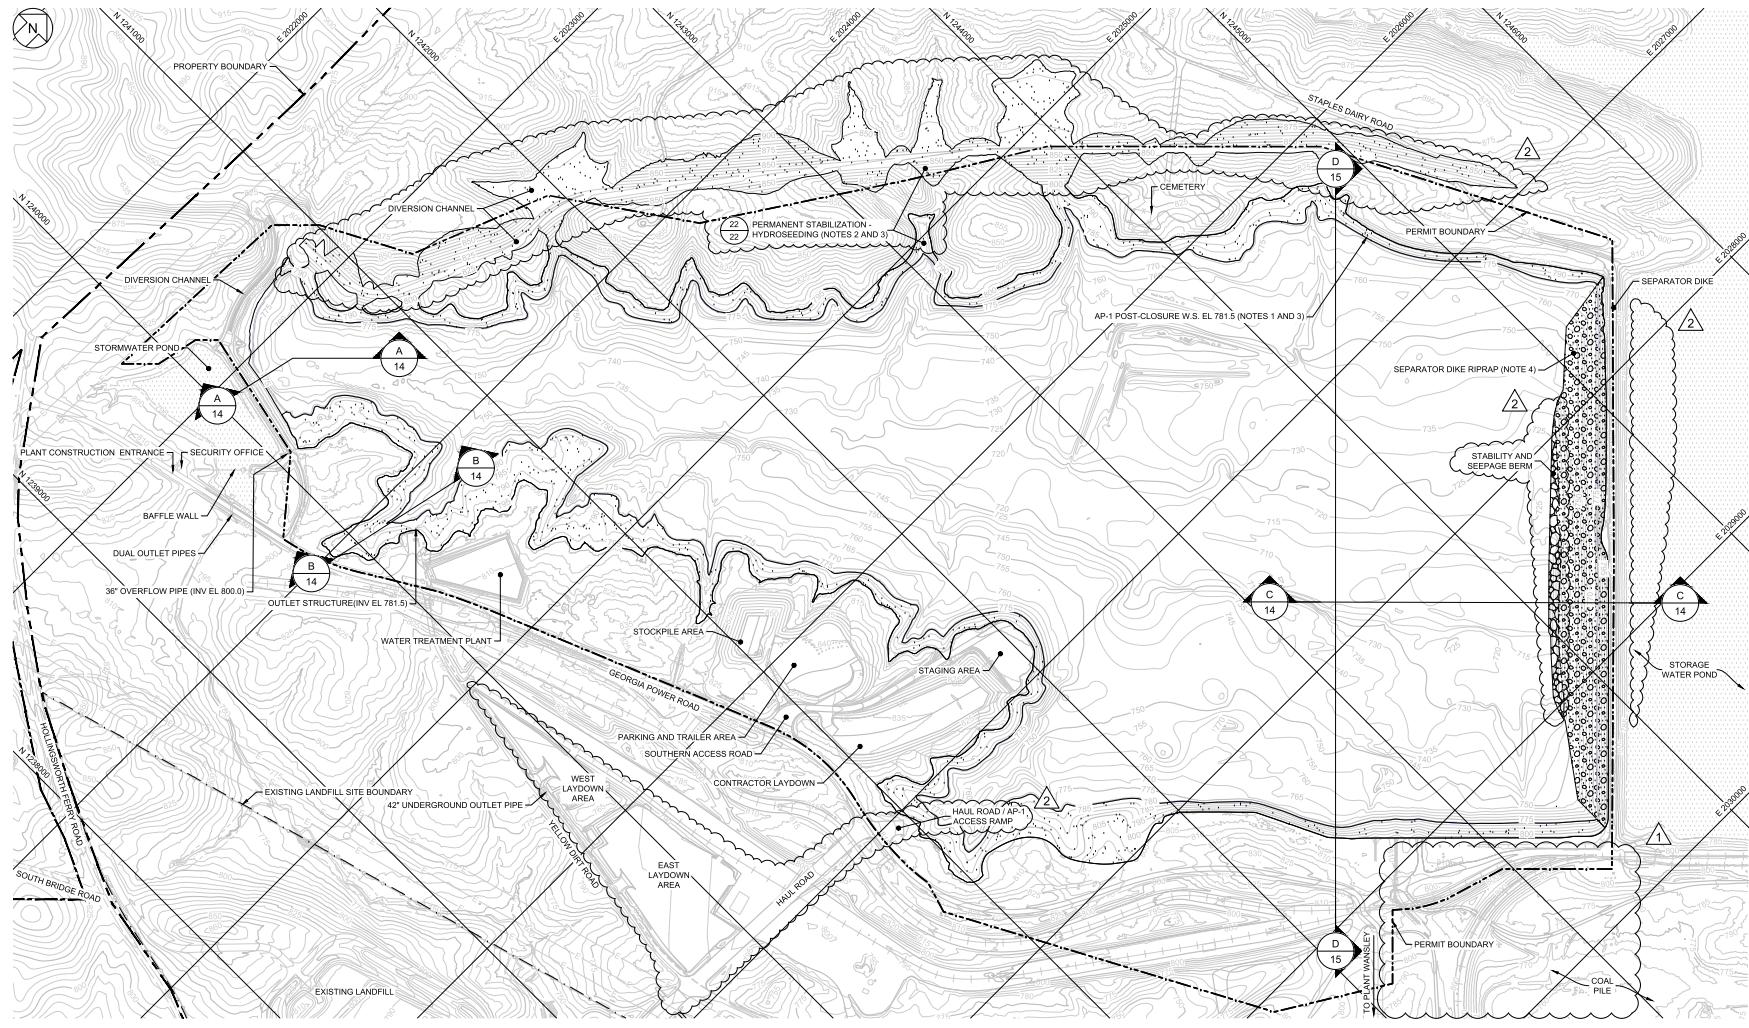

NOTES:

1. FOLLOWING COMPLETION OF CONTRACTOR'S WORK, THE FORMER AP-1 WILL NATURALLY REFILL WITH WATER TO A LEVEL OF 781.5 FT. ANY DIVERSION BERMS THAT THE CONTRACTOR CONSTRUCTS DURING CONSTRUCTION WILL NEED TO BE REMOVED OR BREACHED BY THE CONTRACTOR AS NECESSARY TO NOT RETAIN WATER. AT A MINIMUM, THIS WILL INCLUDE THE BREACHING OF THE DIVERSION CHANNEL PRESENTED IN THE CONSTRUCTION SEQUENCING PLAN DRAWINGS 16 AND 17.
2. UPON VERIFICATION OF COR REMOVAL AND AN ADDITIONAL 5 INCHES OF SOIL WITHIN AP-1, FINAL GRADES ABOVE 781.5 FT MUST RESTRIKE HYDROSEED AS PERMANENT STABILIZATION TO BE COMPLETED IN PHASES AS THE VERIFICATION PROCESS PROGRESSES. ANY AREAS OUTSIDE THE LIMITS OF COR THAT ARE DISTURBED AS PART OF THIS WORK MUST ALSO BE HYDROSEED OR OTHERWISE STABILIZED IN ACCORDANCE WITH APPLICABLE CONSTRUCTION STORMWATER PERMIT AND DETAILED DESIGN DRAWINGS.
3. TEMPORARY STABILIZATION WILL BE UTILIZED ON AN AS-NEEDED BASIS BELOW 781.5 FT ACCORDING TO THE EROSION AND SEDIMENT CONTROL (ESC) PLAN ON DRAWING 19.
4. UPON VERIFICATION OF COR REMOVAL AND AN ADDITIONAL 5 INCHES OF SOIL WITHIN AP-1, CONTRACTOR SHALL PLACE BURRATI DETAFFER ALONG THE LENGTH OF THE UPGRADING (AP-1) SURF OF THE SEPARATOR DIKE, AS SHOWN ON DRAWING 16.



Approved
Solid Waste Management Program

Approved By: Tammy Buchli

REVISED AP-1 PERMIT BOUNDARY

2 ADJUSTED EXISTING SITE FEATURES AND TOPOGRAPHY TO REFLECT CONDITIONS AS OF SEPTEMBER 2025 (I.E., CONSTRUCTION OF HAUL ROAD, LAYDOWN AREAS, AND BU LOADING AREA).

REMOVED THE RIPRAP BUTTRESS WITHIN THE STORAGE WATER POND AND REVISED THE STABILITY AND SEEPAGE BERM EXTENTS.

ADDED GRADES AND APPROXIMATE EXTENTS FOR THE DIVERSION CHANNEL.

2	11.30.25	MINOR PERMIT MOD 2 - REVISION TO AP-1 DESIGN	WSA	JMG
1	07.09.25	MINOR PERMIT MOD 1 - REVISION TO AP-1 PERMIT BOUNDARY	WSA	JMG
0	02.06.25	GA EPD CCR PERMIT DRAWINGS	DLJ	JMG
REV	DATE	DESCRIPTION	DRN	APP



SITE RESTORATION GRADING PLAN

PLANT WANSLEY ASH POND CLOSURE BY REMOVAL
HEARD AND CARROLL COUNTIES, GEORGIA



Georgia
Power

Comments		Georgia Power	
1255 ROBERTS BOULEVARD, NW, SUITE 200 KENNESAW, GEORGIA 30144 USA		PHONE: 678.202.9500 WWW.GEODYNOSTIC.COM	
PROJ. NO.	GW9155	DWG.	GW7306.13-C12
SCALE	AS SHOWN	EDIT 10/23/25	
DATE	NOVEMBER 2025	DRAWING	12 OF 22

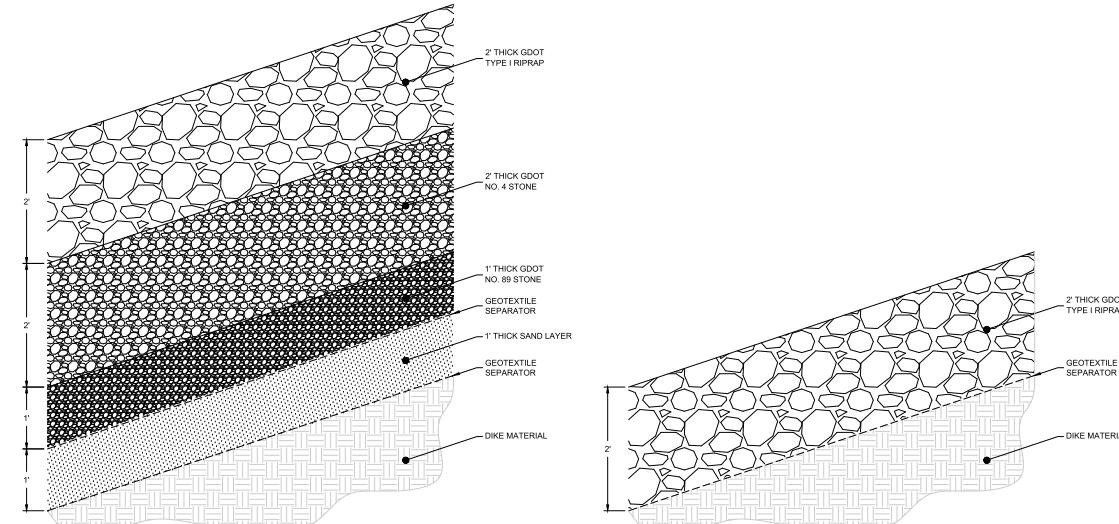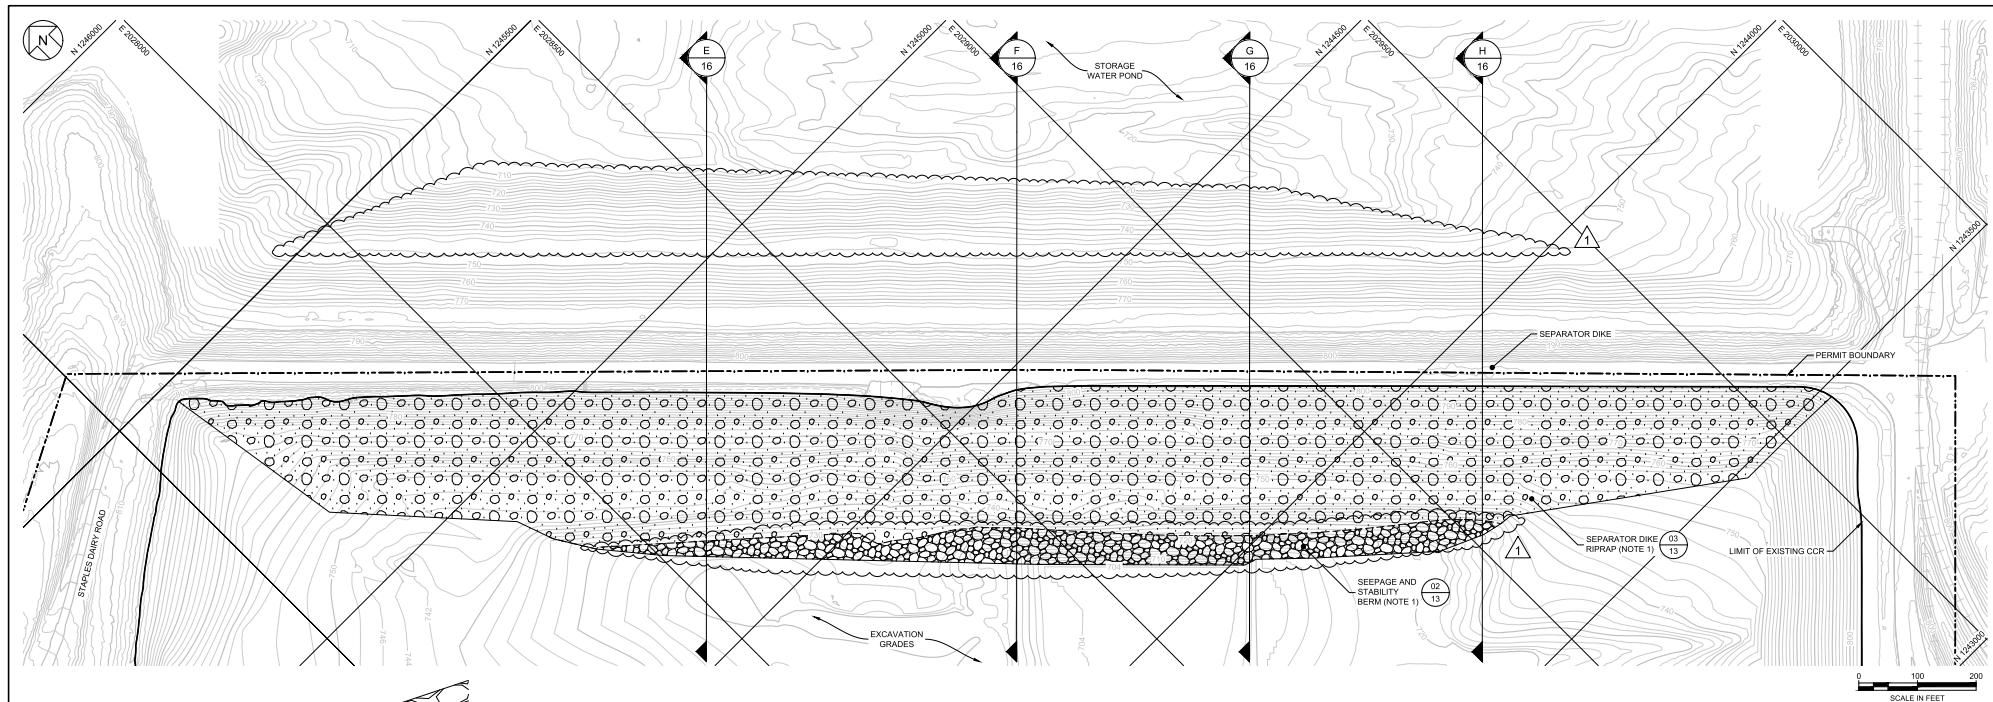

02 DETAIL
SEEPAGE AND STABILITY BERM
SCALE: 1' = 1'

03 DETAIL
SEPARATOR DIKE RIPRAP
SCALE: 1' = 1'



NOTES:
1. ON THE AP-1 SIDE OF THE SEPARATOR DIKE, FOLLOWING VERIFICATION OF CCR REMOVAL AND ADDITIONAL 6 INCHES OF SOIL REMOVAL, CONTRACTOR SHALL INSTALL SEEPAGE BERM AT THE BASE OF THE SEPARATOR DIKE AND RIPRAP ON THE TOP OF SEPARATOR DIKE.


11-10-25 MINOR PERMIT MOD-2: REVISION TO AP-1 DESIGN
0 02/06/25 GA EPD CCR PERMIT DRAWINGS
REV. DATE DRN APP
DESCRIPTION DRN APP

SEPARATOR DIKE PLAN


PLANT WANSLEY ASH POND CLOSURE BY REMOVAL
HEARD AND CARROLL COUNTIES, GEORGIA




125 ROBERTS BOULEVARD, NW, SUITE 200
KENNESAW, GEORGIA 30144, USA
PHONE: 678.562.8600
WWW.GEOSYNTEC.COM
PROJ. NO. GW9155 DWG. GW7306-13-C13 EDIT 9/16/25
SCALE AS SHOWN DRAWING 13 OF 22
DATE NOVEMBER 2025

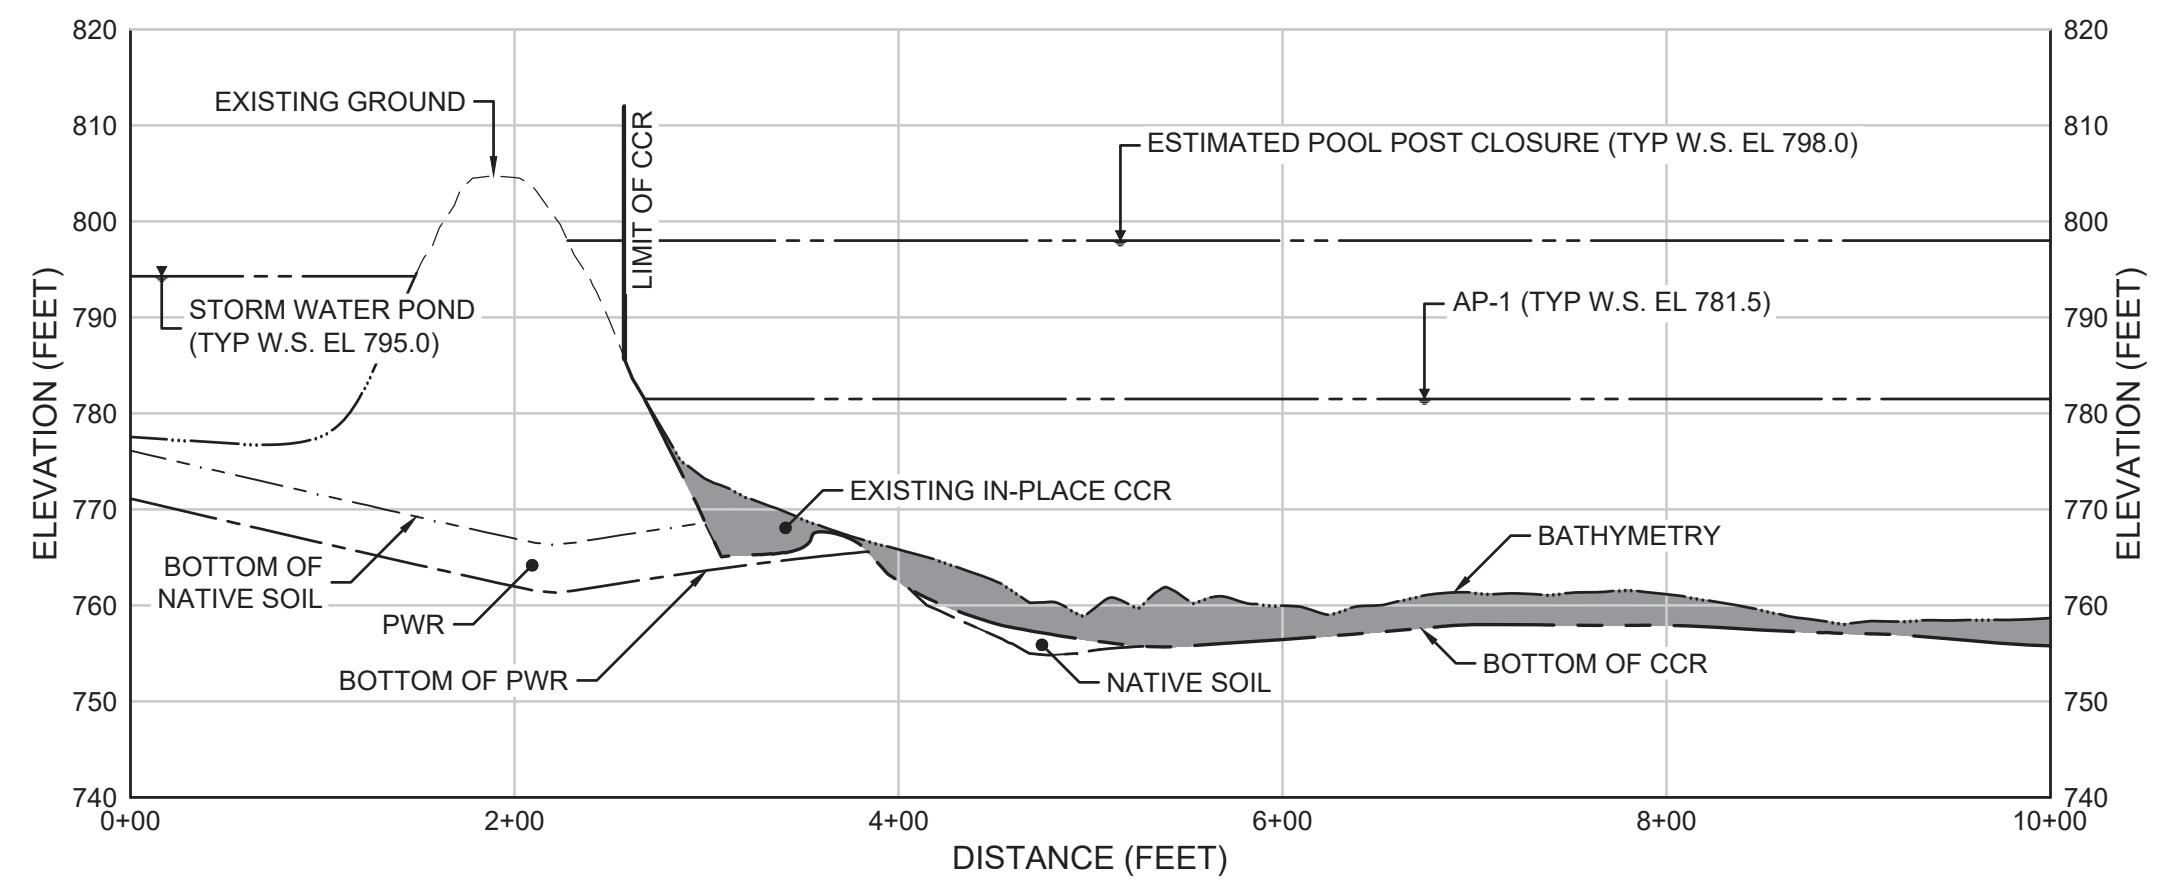

A
SECTION
06
SITE SECTION - A
SCALE: 1" = 100' (H); 1" = 20' (V)

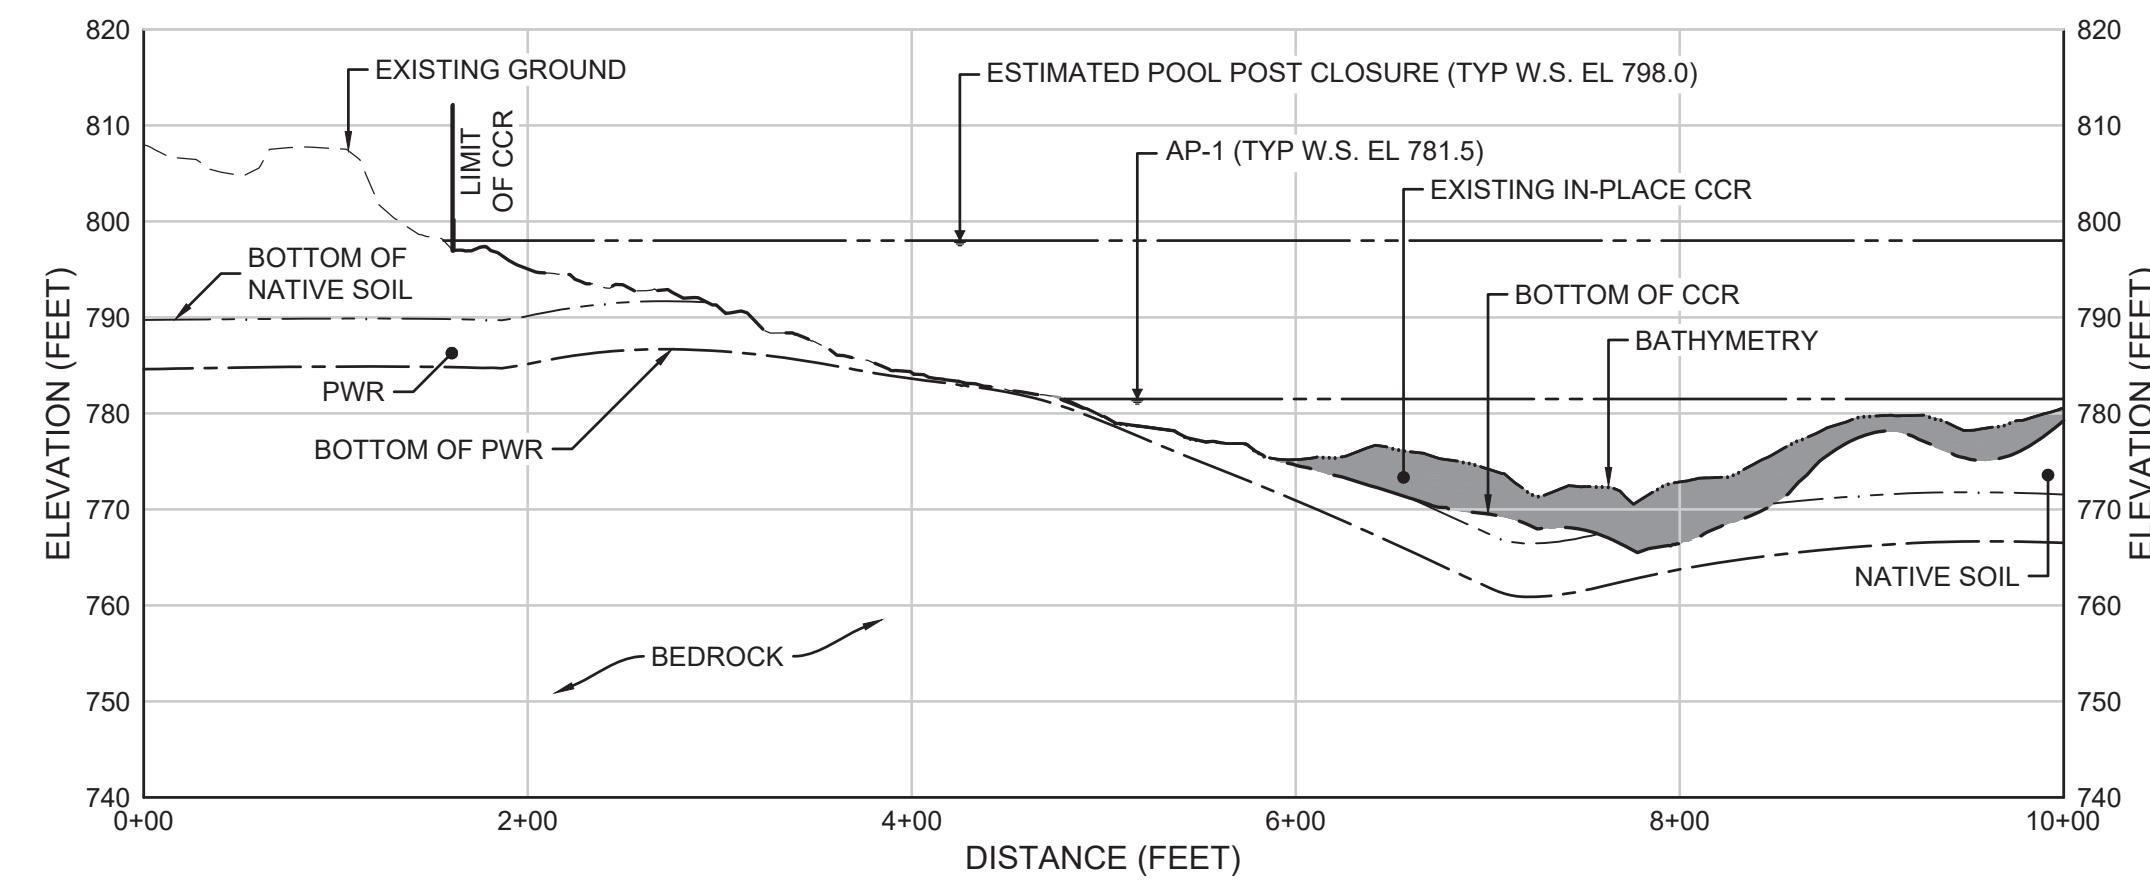

B
SECTION
06
SITE SECTION - B
SCALE: 1" = 100' (H); 1" = 20' (V)

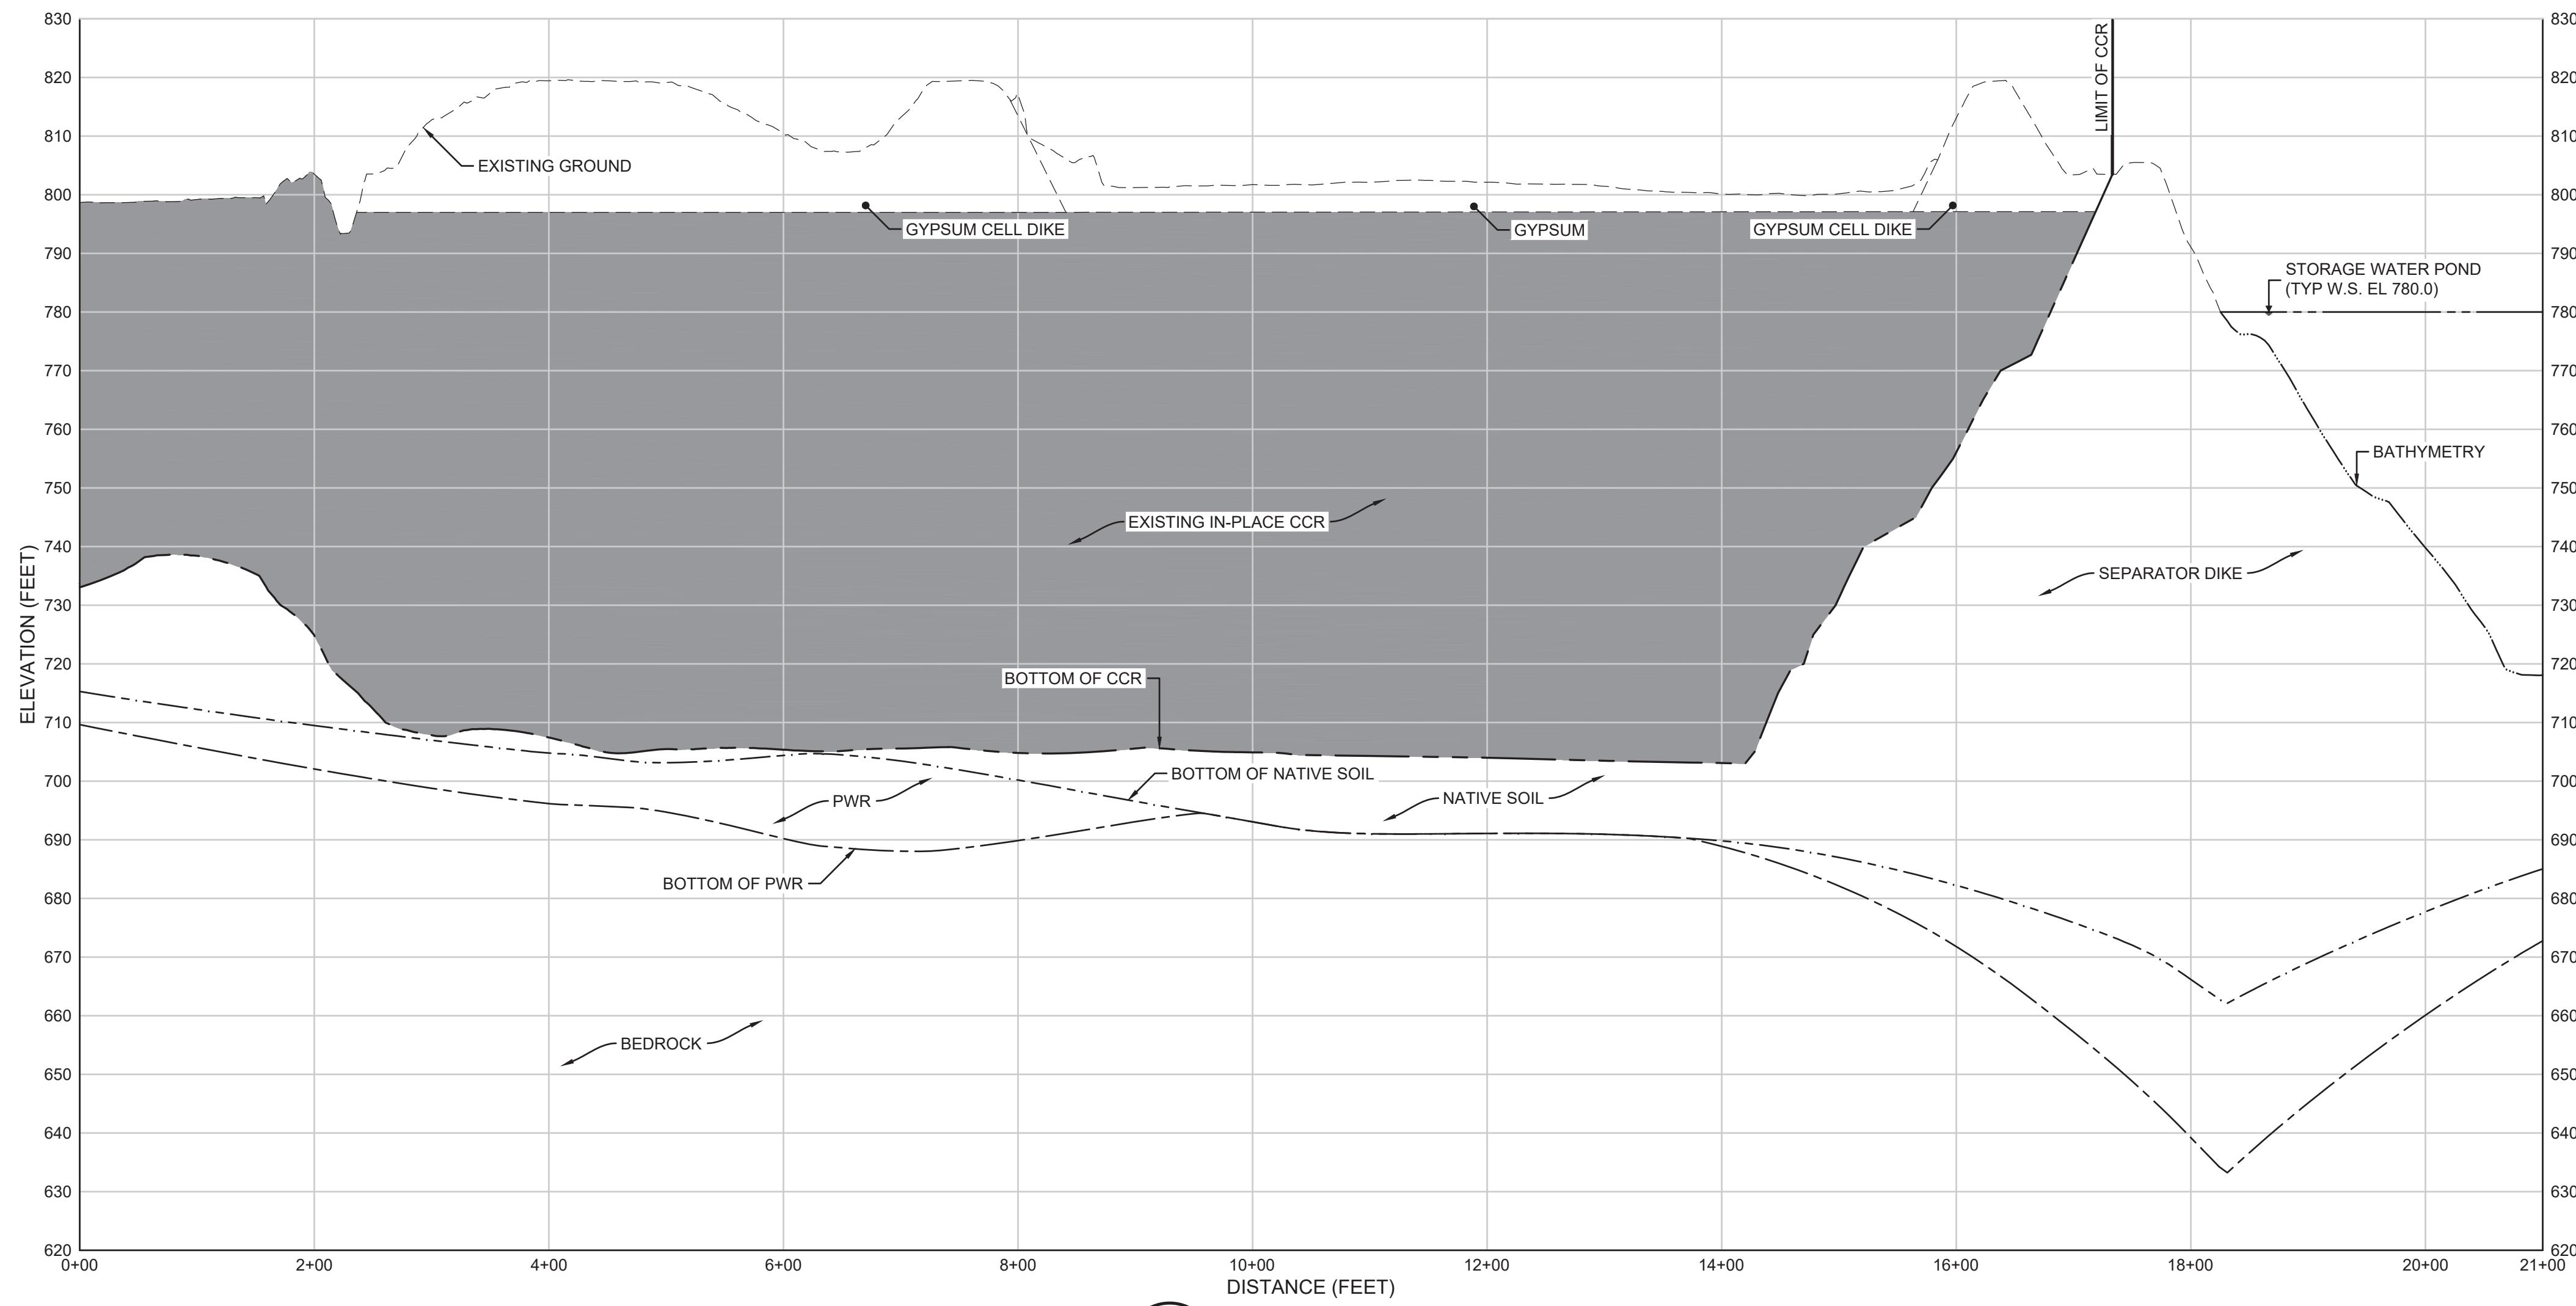

C
SECTION
06
SITE SECTION - C
SCALE: 1" = 100' (H); 1" = 20' (V)

NOTES:

1. BOTTOM OF CCR SURFACE IS SHOWN IN THESE SECTIONS. EXCAVATION SURFACE IS NOT SHOWN FOR CLARITY AND WILL BE 6 INCHES BELOW THE BOTTOM OF CCR SURFACE.
2. BATHYMETRY WITHIN THE STORMWATER POND IS ESTIMATED AND NOT SURVEYED.

0 100 200 0 20 40
SCALE IN FEET (H) SCALE IN FEET (V)

0	02.06.25	GA EPD CCR PERMIT DRAWINGS	DLJ	JMG
REV	DATE	DESCRIPTION	DRN	APP

SITE SECTIONS - I

PLANT WANSLEY ASH POND CLOSURE BY REMOVAL
HEARD AND CARROLL COUNTIES, GEORGIA

Digitally signed
by Jeremy Gasser
Date: 2025.02.07
10:23:41 -06'00'





1255 ROBERTS BOULEVARD, NW, SUITE 200 KENNESAW, GEORGIA 30144 USA	PHONE: 678.202.9500 WWW.GEOSYNTEC.COM
PROJ. NO. GW9155	DWG. GW7306.13-C14 EDIT 5/2/24
SCALE AS SHOWN	DRAWING 14 OF 22

1255 ROBERTS BOULEVARD, NW, SUITE 200 KENNESAW, GEORGIA 30144 USA	PHONE: 678.202.9500 WWW.GEOSYNTEC.COM
PROJ. NO. GW9155	DWG. GW7306.13-C14 EDIT 5/2/24
SCALE AS SHOWN	DRAWING 14 OF 22

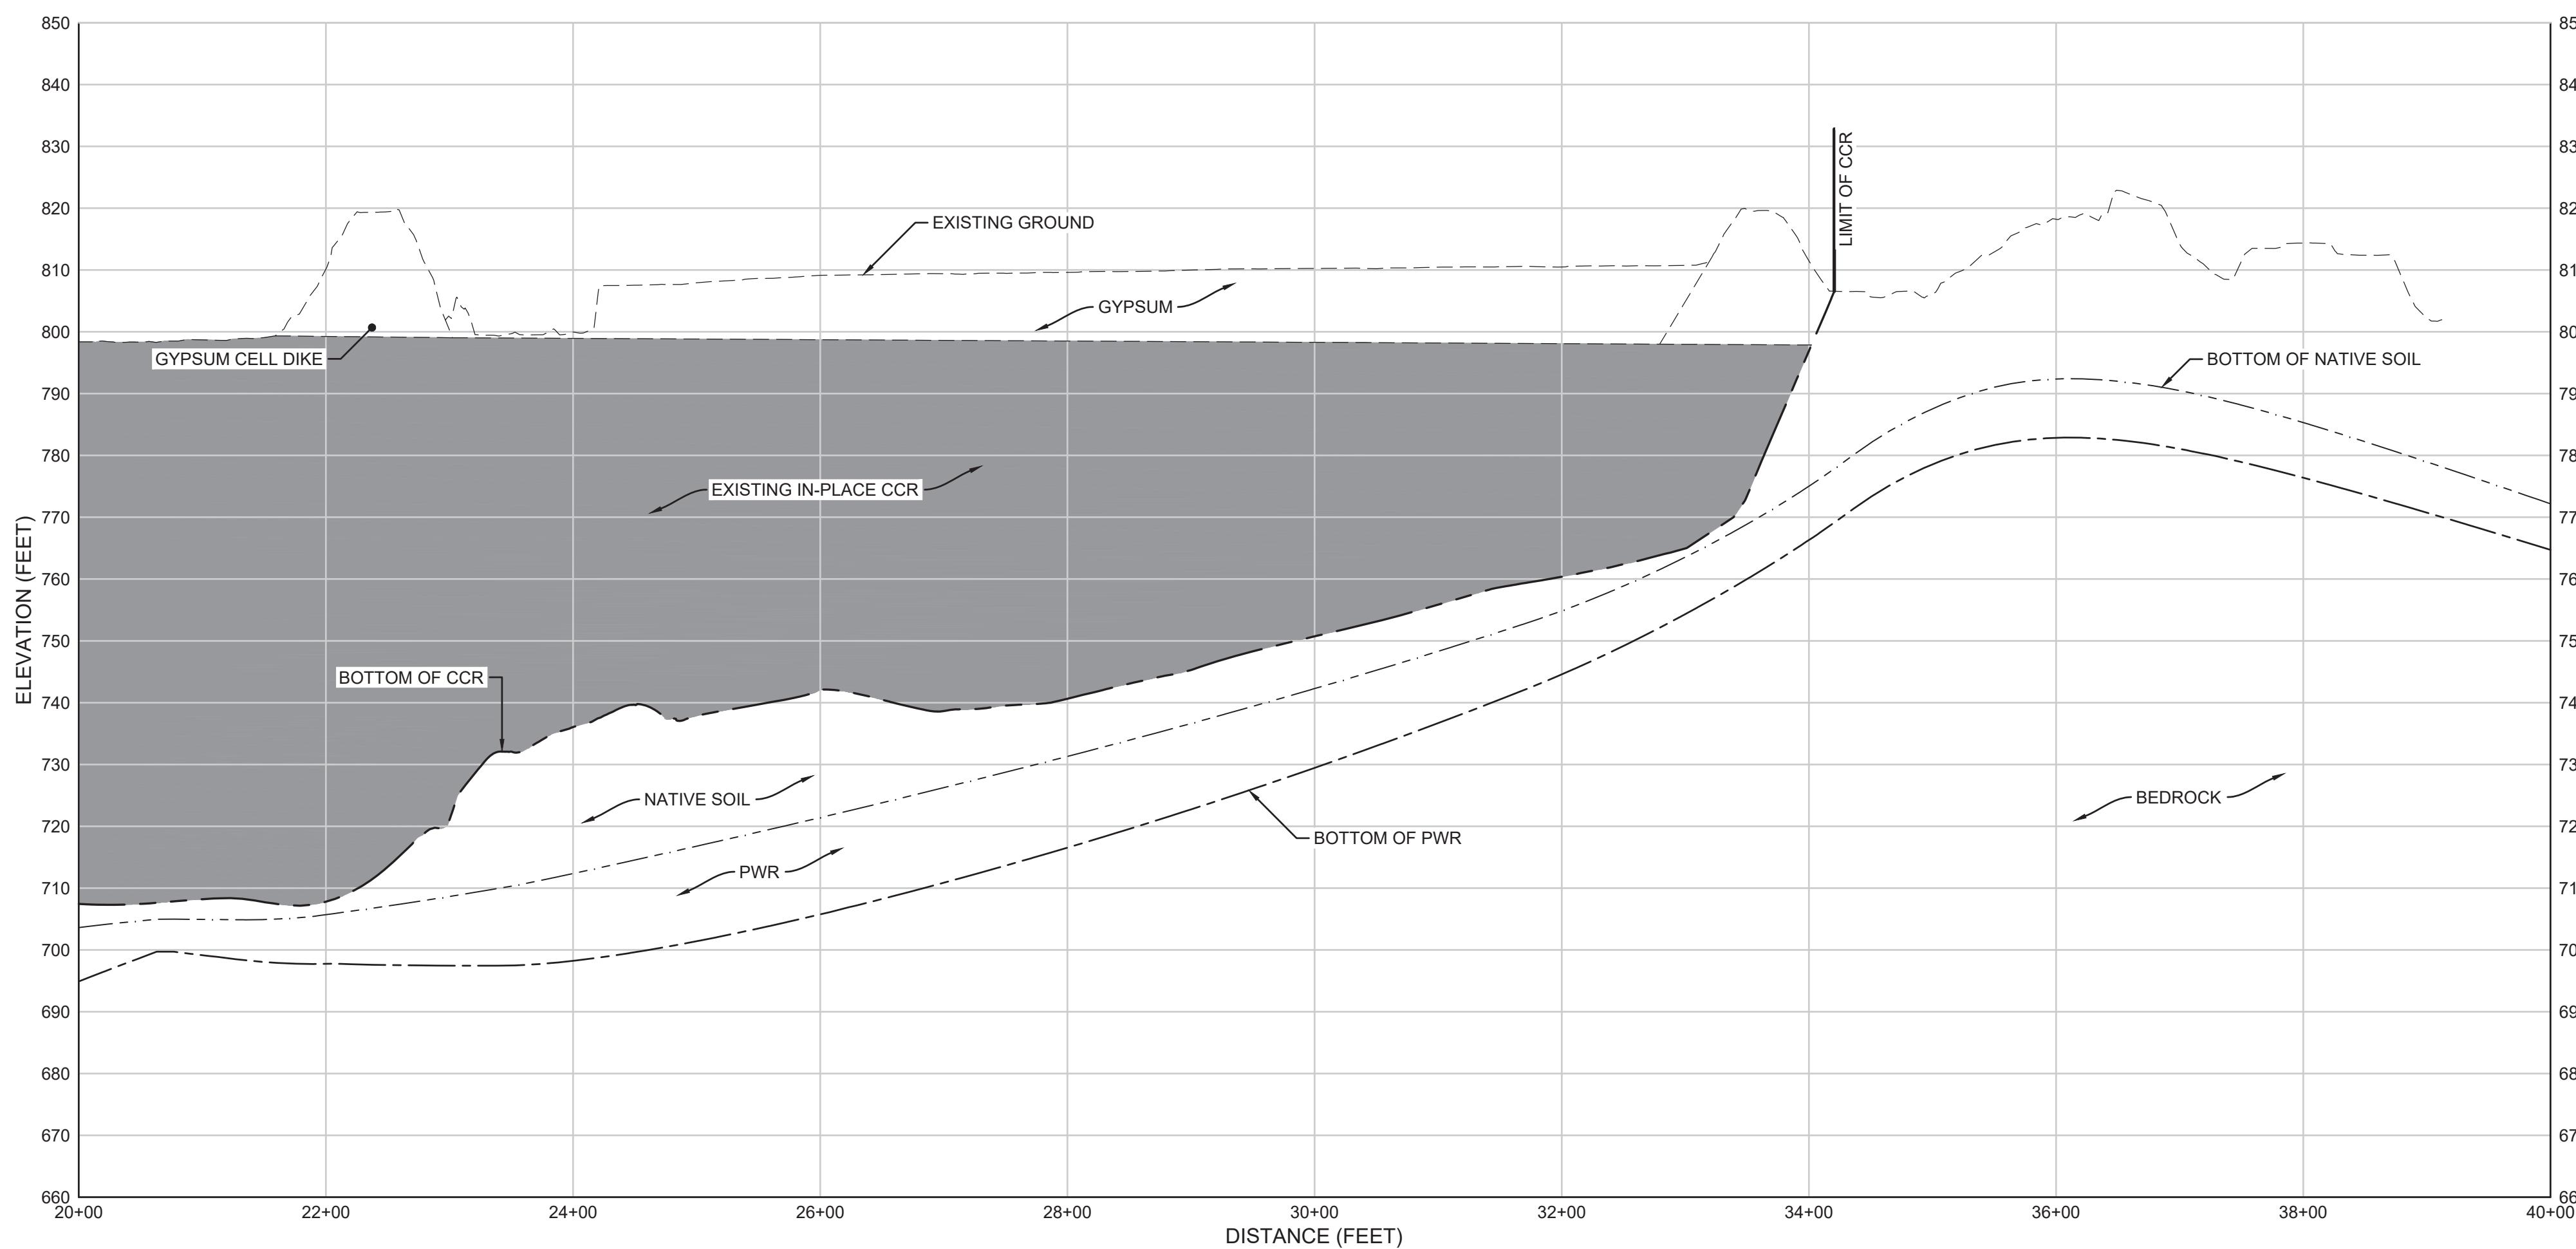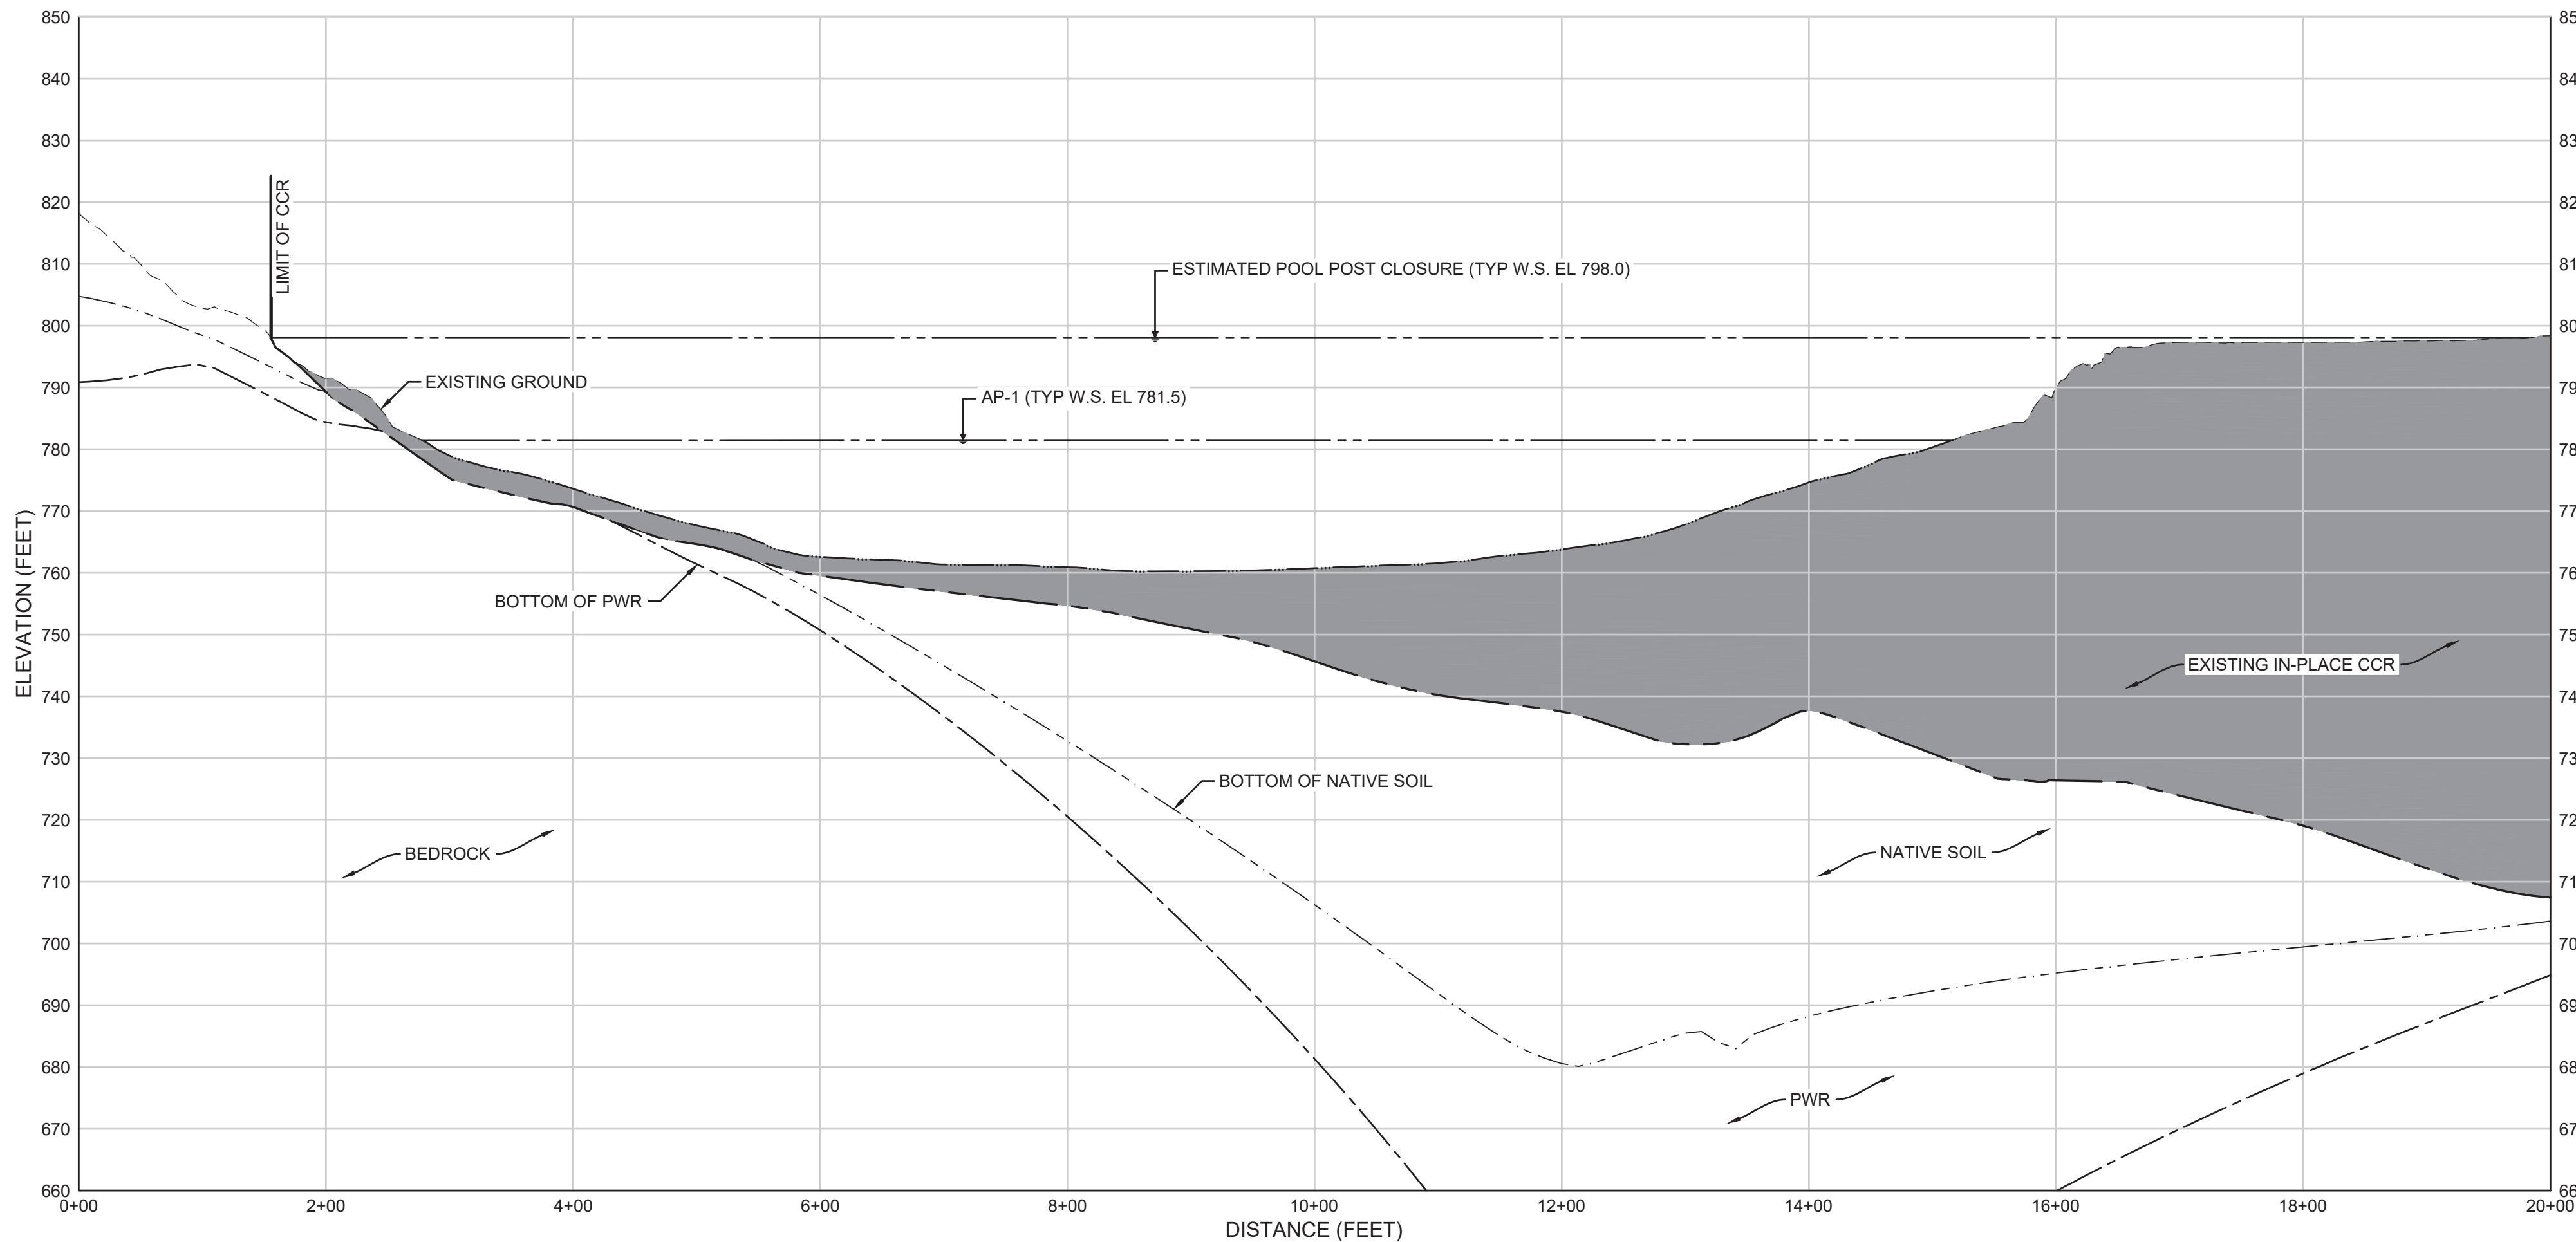

C:_GEO-ACC\ACCDOKS\GEOSYNTEC-SD\PLANT WANSLEY\PROJECT FILES\CADD\WNSLY013\DWG\SH\GW7306.13-C15

D
06

SECTION
SITE SECTION - D

SCALE: 1" = 100' (H); 1" = 20' (V)



DEPARTMENT OF NATURAL RESOURCES

ENVIRONMENTAL PROTECTION DIVISION


Approved

Solid Waste Management Program

A digital signature consisting of a stylized black 'J' and a pink 'G' is positioned at the top left. To its right, the text 'Digitally signed by Jeremy Gasser Date: 2025.02.07 10:24:10 -06'00' is displayed. Below this is a circular professional seal. The outer ring of the seal contains the word 'GEORGIA' at the top and 'REGISTERED' on the left, with 'PROFESSIONAL' on the right and 'ENGINEER' at the bottom. The inner circle contains the text 'No. PE043417' in the center, flanked by two five-pointed stars. At the bottom of the inner circle, the name 'JEREMY GASSER' is written. The entire seal is rendered in black and white.

NOTES:

1. BOTTOM OF CCR SURFACE IS SHOWN IN THESE SECTIONS.
EXCAVATION SURFACE IS NOT SHOWN FOR CLARITY AND WILL BE 6

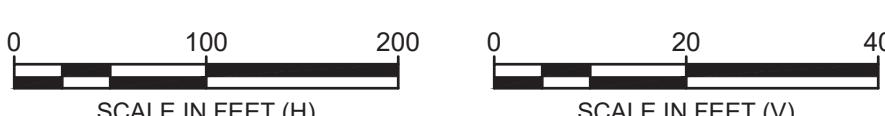



0	02.06.25	GA EPD CCR PERMIT DRAWINGS	DLJ	JMG
REV	DATE	DESCRIPTION	DRN	APP

SITE SECTIONS - II

**PLANT WANSLEY ASH POND CLOSURE BY REMOVAL
HEARD AND CARROLL COUNTIES, GEORGIA**


The image contains two logos. On the left is the 'Geosyntec consultants' logo, which features the word 'Geosyntec' in a large, bold, sans-serif font with a stylized 'y' that has a small arrow pointing right, and 'consultants' in a smaller, lowercase, sans-serif font below it. On the right is the 'Georgia Power' logo, which consists of a stylized mountain peak icon above the word 'Georgia' in a large, bold, sans-serif font, and 'Power' in a slightly smaller, bold, sans-serif font below it.

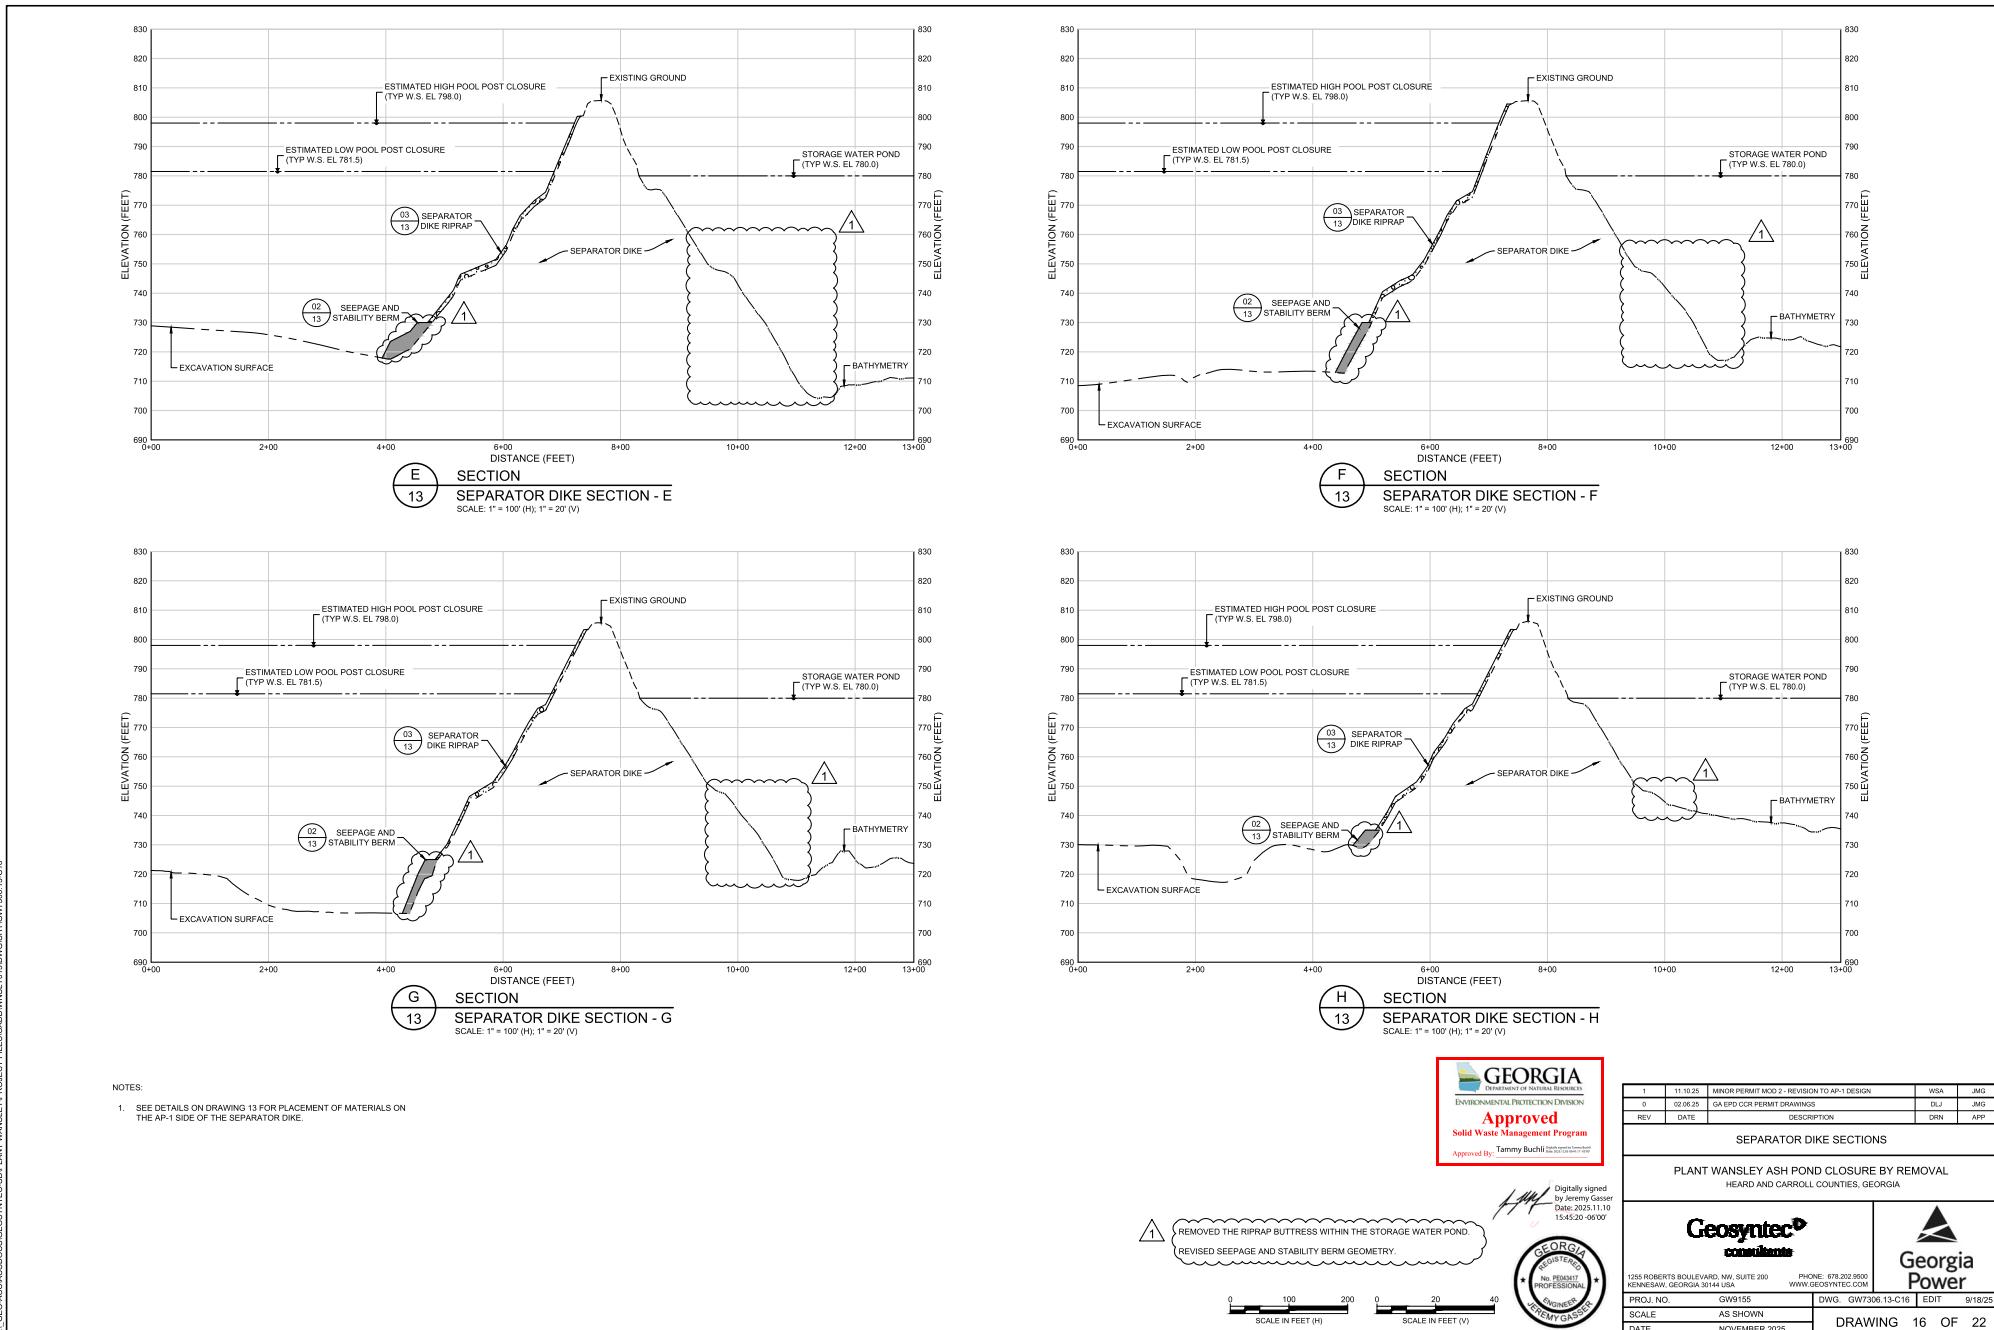

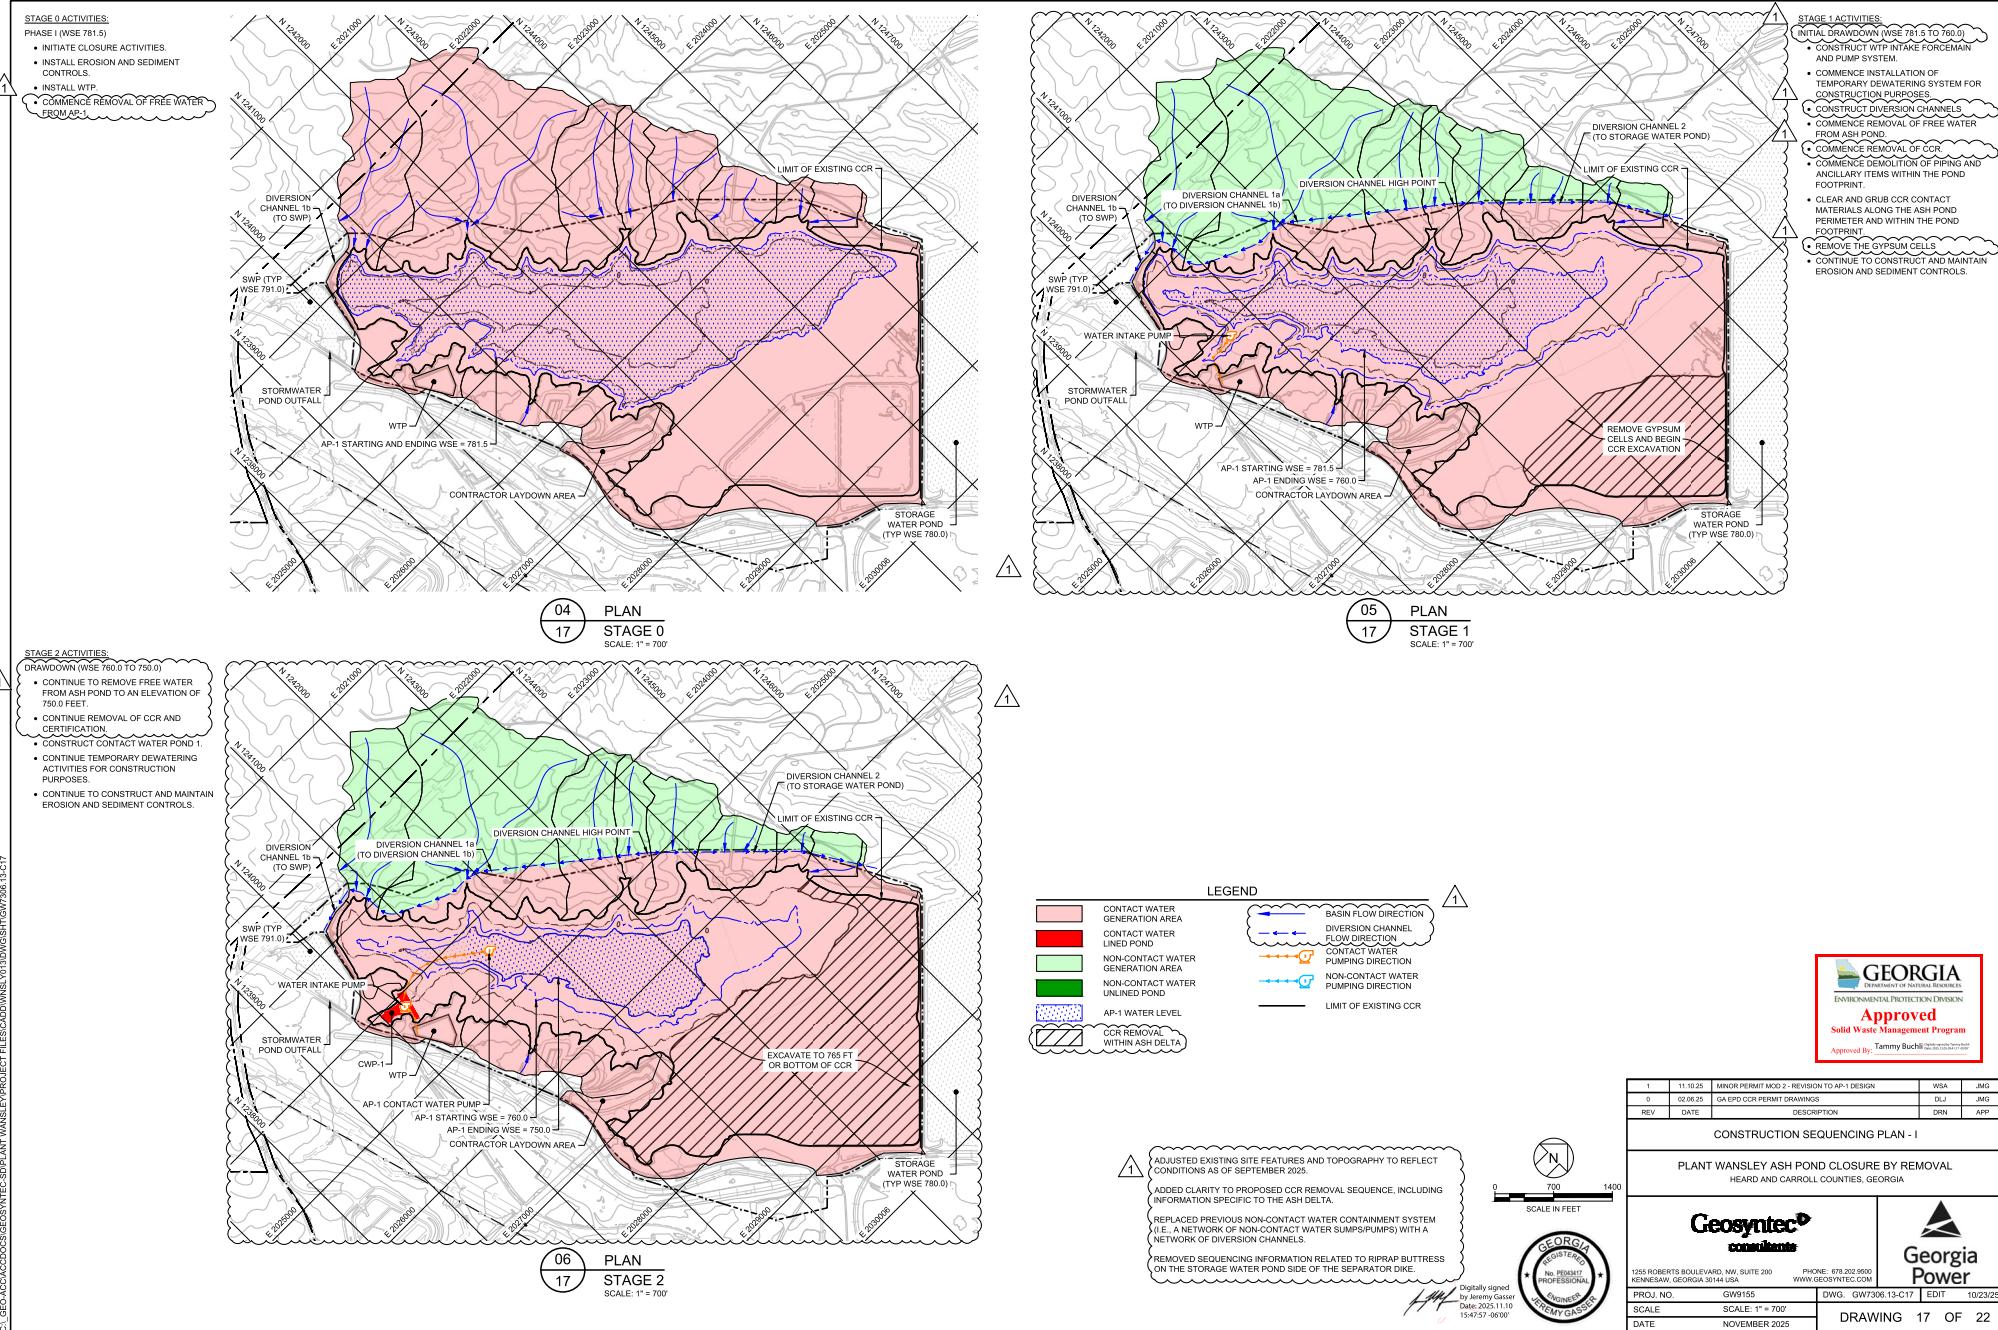

1

STAGE 3 ACTIVITIES:
 GRAVITY CONTINUED (WSE 760.0 TO 734.0)
 • CONTINUE TO REMOVE FREE WATER FROM ASH POND TO AN ELEVATION OF 734.0 FEET.
 • CONTINUE REMOVAL OF CCR AND CERTIFICATION.
 • CONTINUE TEMPORARY Dewatering ACTIVITIES FOR CONSTRUCTION PURPOSES.
 • CONTINUE TO CONSTRUCT AND MAINTAIN EROSION AND SEDIMENT CONTROLS.

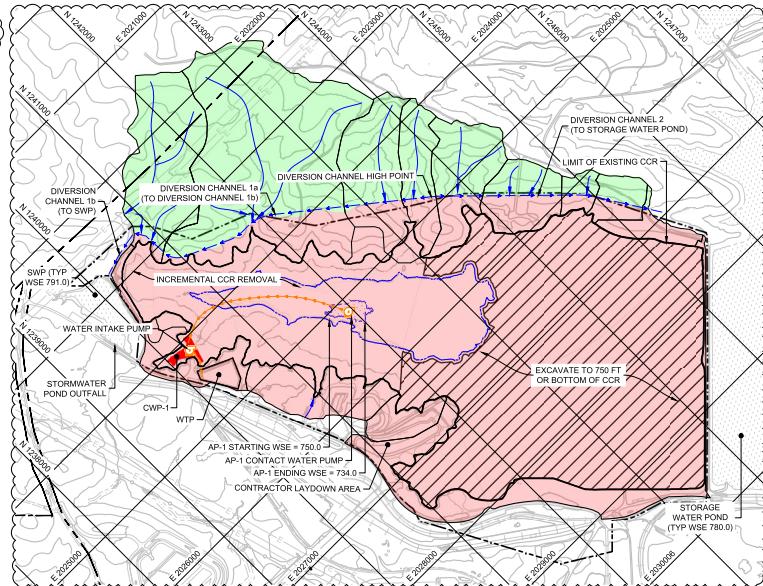

07

PLAN
18
STAGE 3

SCALE: 1" = 700'

1

STAGE 4 ACTIVITIES:
 CCR REMOVAL (WSE 734.0 TO 700.0)
 • COMPLETE FREE WATER REMOVAL WITHIN THE ASH POND.
 • CONSTRUCT NON-CONTACT WATER POND.
 • RELOCATE WTP INTAKE FORCEMAIN AND PUMP SYSTEM.
 • INSTALL NON-CONTACT WATER PUMP.
 • COMPLETE REMOVAL OF CCR AND CERTIFY.
 • COMMENCE CONTACT WATER MANAGEMENT WITHIN THE ASH POND.
 • CONTINUE TO CONSTRUCT AND MAINTAIN EROSION AND SEDIMENT CONTROLS.
 • PLACE CHANNEL BEDDING AND ARMORING MATERIALS FOR EROSION PROTECTION AS NEEDED.
 • COMPLETE SEPARATOR DIKE SLOPE ARMORING FOR EROSION PROTECTION.


08

PLAN
18
STAGE 4

SCALE: 1" = 700'

STAGE 5 ACTIVITIES:


STABILIZATION AND REFILL (WSE 700.0 TO 781.5)
 • BREACH/REMOVE NON-CONTACT WATER PONDS/BERMS.
 • BREACH DIVERSION CHANNEL IN LOCATIONS CORRESPONDING TO NATURAL VALLEYS IN THE ASH DIKE TO TOPOGRAPHY.
 • CLOSE AND REMOVE WTP.
 • REMOVE TEMPORARY CONSTRUCTION FACILITIES.
 • CONTINUE TO MAINTAIN EROSION AND SEDIMENT CONTROLS.
 • PERFORM VEGETATION MANAGEMENT AND RESEEDING AS NEEDED FOR STABILIZATION.
 • PLACE RIPRAP AND SEEPAGE BERM ON THE EAST SIDE OF THE SEPARATOR DIKE.
 • ASH POND 1 CLOSURE ACTIVITIES ARE COMPLETE.

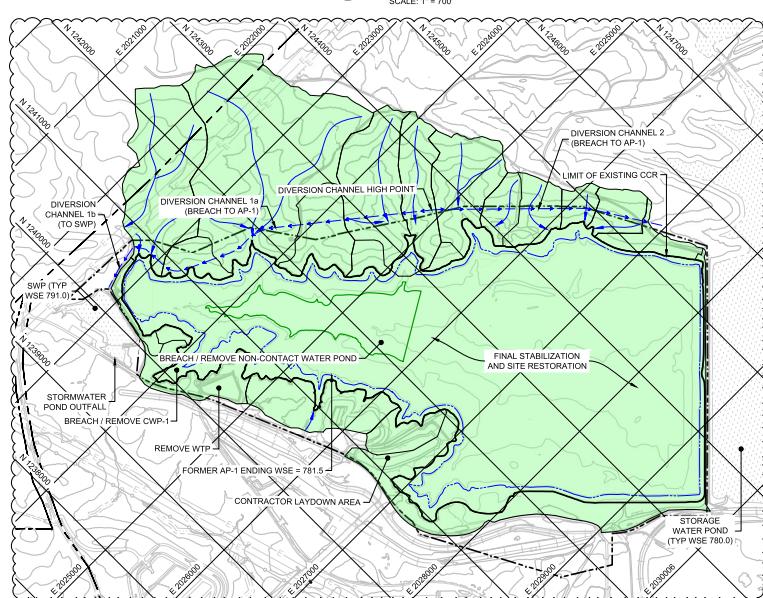


09

PLAN
18
STAGE 5


SCALE: 1" = 700'

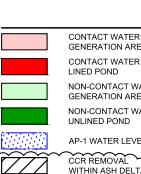

ADJUSTED EXISTING SITE FEATURES AND TOPOGRAPHY TO REFLECT CONDITIONS AS OF SEPTEMBER 2025.
 ADDED CLARITY TO PROPOSED CCR REMOVAL SEQUENCE, INCLUDING INFORMATION SPECIFIC TO THE ASH DELTA.
 REPLACED PREVIOUS NON-CONTACT WATER CONTAINMENT SYSTEM (i.e. A NETWORK OF NON-CONTACT WATER SUMPS/PUMPS) WITH A NETWORK OF DIVERSION CHANNELS.
 REMOVED SEQUENCING INFORMATION RELATED TO RIPRAP BUTTRESS ON THE STORAGE WATER POND SIDE OF THE SEPARATOR DIKE.

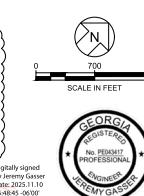

1	11-10-25	MINOR PERMIT MOD 2 - BREACH TO AP-1 DESIGN	DRN	MS
0	02/05/25	GA EPD CCR PERMIT DRAWINGS	DRN	JMG
REV	DATE	DESCRIPTION	DRN	APP
CONSTRUCTION SEQUENCING PLAN - II				
PLANT WANSLEY ASH POND CLOSURE BY REMOVAL HEARD AND CARROLL COUNTIES, GEORGIA				
Geosyntec consultants				
Georgia Power				
PROJ. NO.	GW9155	DWG.	GW7306-13-C18	EDIT 10/23/25
SCALE	SCALE: 1" = 700'			
DATE	NOVEMBER 2025			

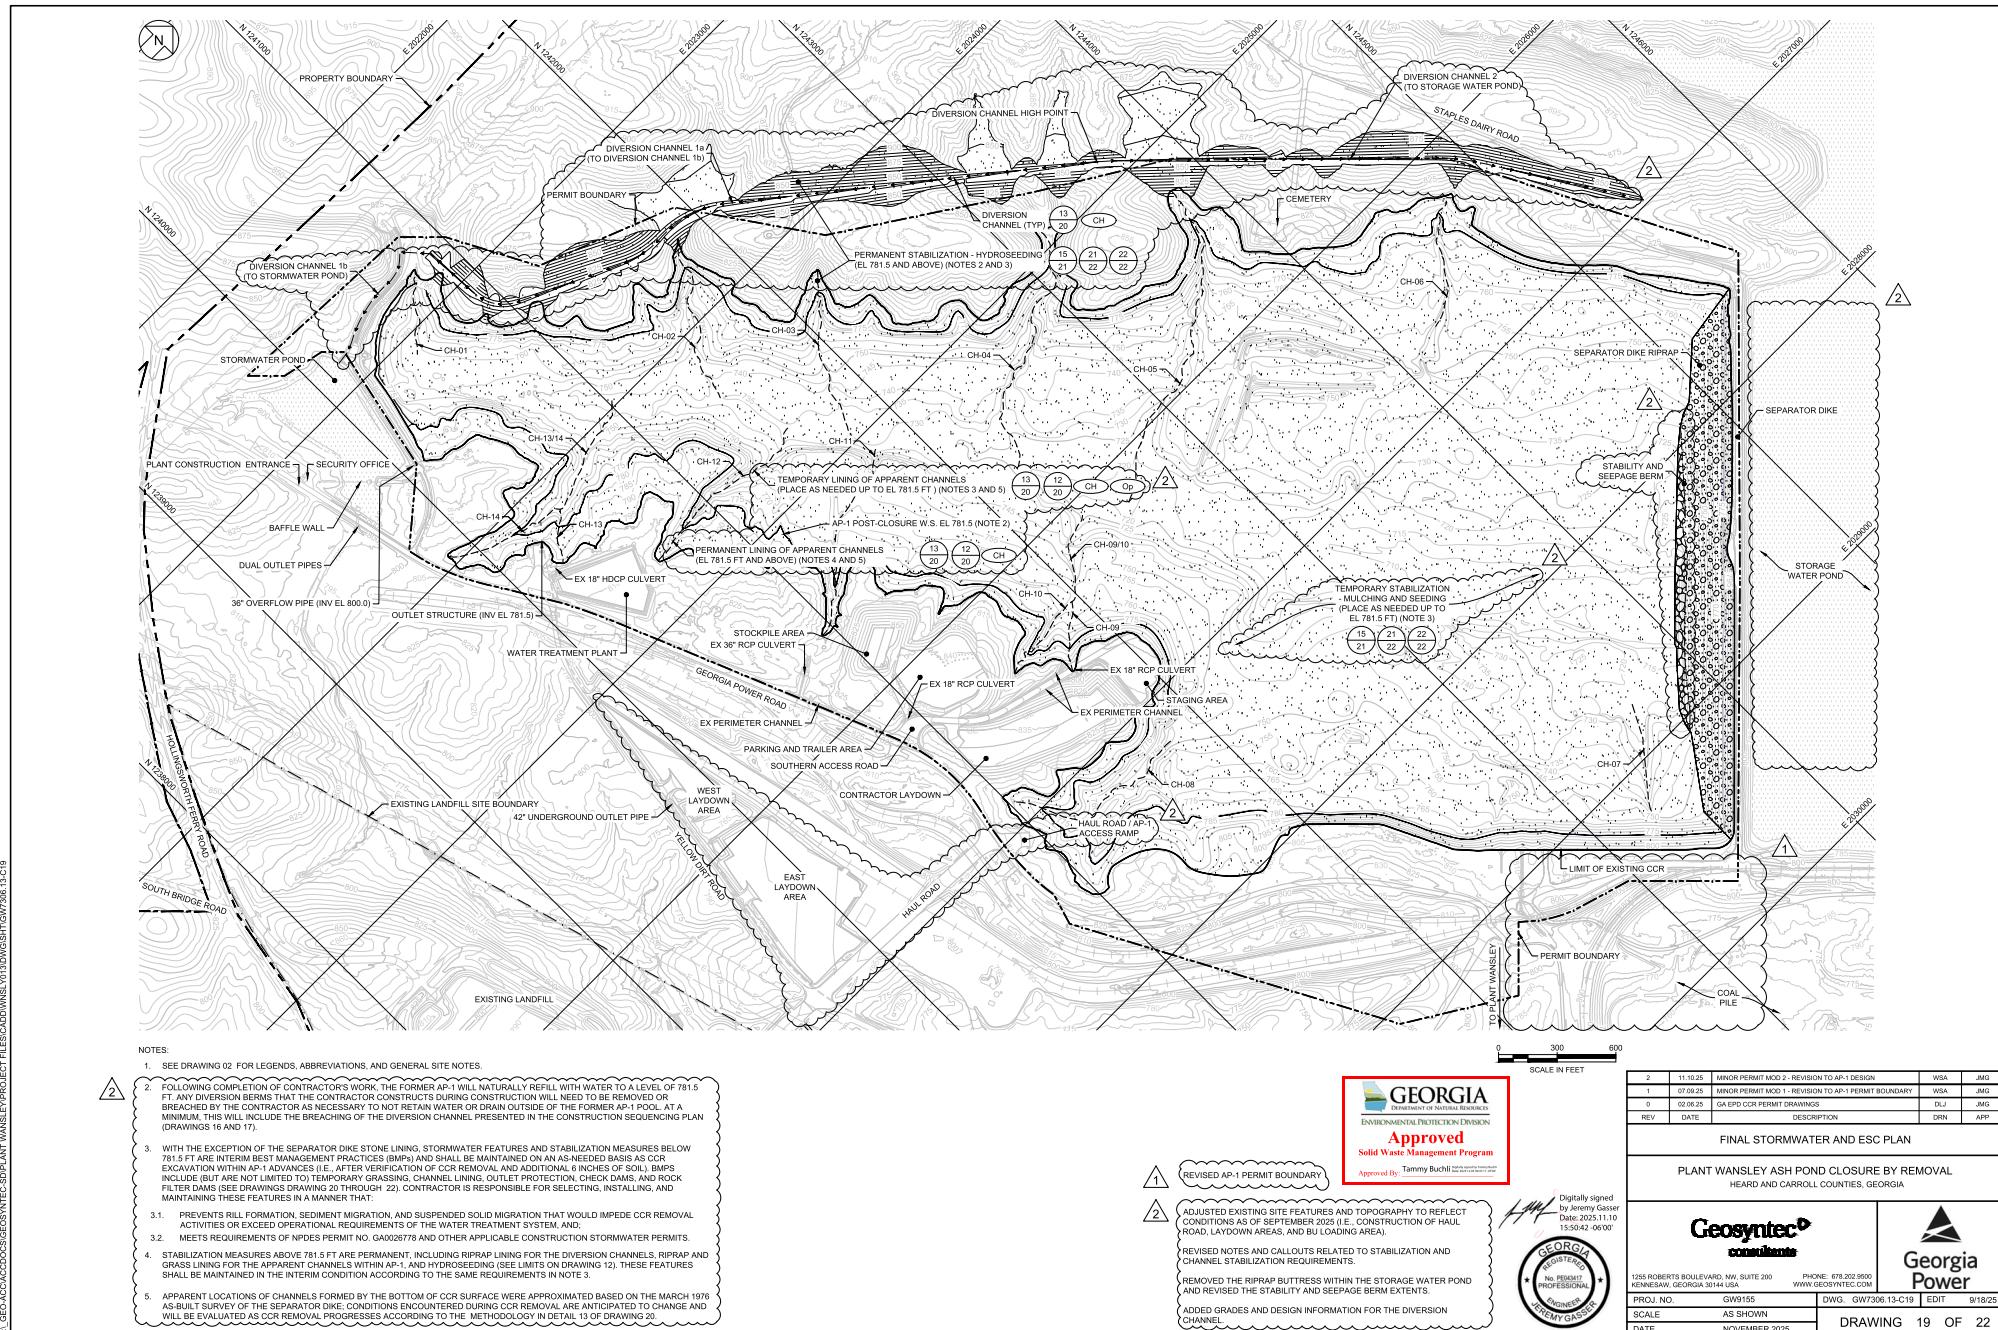

NOTES:

1. SEE DRAWING 02 FOR LEGENDS, ABBREVIATIONS, AND GENERAL SITE NOTES.
2. FOLLOWING COMPLETION OF CONTRACTOR'S WORK, THE FORMER AP-1 WILL NATURALLY REFILL WITH WATER TO A LEVEL OF 781.5 FT. AT ANY DENSITY BEING THAT THE CONTRACTOR CONSTRUCTS DURING CONSTRUCTION WILL NEED TO BE REMOVED OR BREACHED BY THE CONTRACTOR AS NECESSARY TO NOT RETAIN WATER OR DRAIN OUTSIDE OF THE FORMER AP-1 POOL AT A MINIMUM. THIS WILL INCLUDE THE BREACHING OF THE DIVERSION CHANNEL PRESENTED IN THE CONSTRUCTION SEQUENCING PLAN (DRAWINGS 16 AND 17).
3. WITH THE EXCEPTION OF THE SEPARATOR DIKE STONE LINING, STORMWATER FEATURES AND STABILIZATION MEASURES BELOW 781.5 FT ARE INTERIM BEST MANAGEMENT PRACTICES (BMPs) AND SHALL BE MAINTAINED ON AN AS-NEEDED BASIS AS COR EXCAVATION WORK AP-1 ADVANCES (1 FT AFTER VERTIFICATION OF COR REMOVAL AND ADDITIONAL 6 INCHES OF SOIL). BMPS INCLUDE, BUT ARE NOT LIMITED TO, TEMPORARY GRASSING, CHANNEL LINING, OUTLET PROTECTION, CHECK DAMS, AND ROCK FILTER DAMS (SEE DRAWINGS 20 THROUGH 22). CONTRACTOR IS RESPONSIBLE FOR SELECTING, INSTALLING, AND MAINTAINING THESE FEATURES IN A MANNER THAT:
 1. PREVENTS RILL FORMATION, SEDIMENT MIGRATION, AND SUSPENDED SOIL MIGRATION THAT WOULD IMPEDE CCR REMOVAL ACTIVITIES OR EXCEED OPERATIONAL REQUIREMENTS OF THE WATER TREATMENT SYSTEM, AND;
 2. MEETS REQUIREMENTS OF NPDES PERMIT NO. GA0026778 AND OTHER APPLICABLE CONSTRUCTION STORMWATER PERMITS.
4. STABILIZATION MEASURES ABOVE 781.5 FT ARE PERMANENT, INCLUDING RIPRAP REPAIR FOR THE DIVERSION CHANNELS, RIPRAP AND GRASS LINING FOR THE APPARENT CHANNELS WITHIN AP-1, AND HYDROSEEDING (SEE LIMITS ON DRAWING 12). THESE FEATURES SHALL BE MAINTAINED IN THE INTERIM CONDITION ACCORDING TO THE SAME REQUIREMENTS IN NOTE 3.
5. APPARENT LOCATIONS OF CHANNELS FORMED BY THE BOTTOM OF COR SURFACE WERE APPROXIMATED BASED ON THE MARCH 1976 AS-BUILT SURVEY OF THE SEPARATOR DIKE. CONDITIONS ENCOUNTERED DURING CCR REMOVAL ARE ANTICIPATED TO CHANGE AND WILL BE EVALUATED AS CCR REMOVAL PROGRESSSES ACCORDING TO THE METHODOLOGY IN DETAIL 13 OF DRAWING 20.



Approved
Solid Waste Management Program

Approved By: Tammy Buchli

REVISED AP-1 PERMIT BOUNDARY

1 REVISED API-1 PERMIT BOUNDARIES

△

2 ADJUSTED EXISTING SITE FEATURES
CONDITIONS AS OF SEPTEMBER

ROAD, LAYDOWN AREAS, AND BU

 
REVISED NOTES AND CALLOUTS




CHANNEL STABILIZATION REQUIREMENTS

REMOVED THE RIPRAP BUTTRESS AND REDUCED THE STABILITY AND

AND REVISED THE STABILITY AND

{ ADDED GRADES AND DESIGN INFO
CHANNEL }

2	11.10.25	MINOR PERMIT MOD 2 - REVISION TO AP-1 DESIGN	WSA	JMG
1	07.09.25	MINOR PERMIT MOD 1 - REVISION TO AP-1 PERMIT BOUNDARY	WSA	JMG
0	02.06.25	GA EPP CCR MODIFICATION	DLJ	JMG
REV	DATE	DESCRIPTION	DRN	APP
FINAL STORMWATER AND ESC PLAN				
PLANT WANSLY ASH POND CLOSURE BY REMOVAL				
HEARD AND CARROLL COUNTIES, GEORGIA				
				
1955 ROBERT BOUDREAU RD, MIL. SUITE 200 KENNESAW, GEORGIA 30141 USA			PHONE: 477.202.0900 WWW.GEOSYNTEC.COM	
PROJ. NO.	GW19155	DWG.	GWJ306.13-C19	EDIT
SCALE	AS SHOWN	DRAWING	19	OF 22
DATE	NOVEMBER 2025			

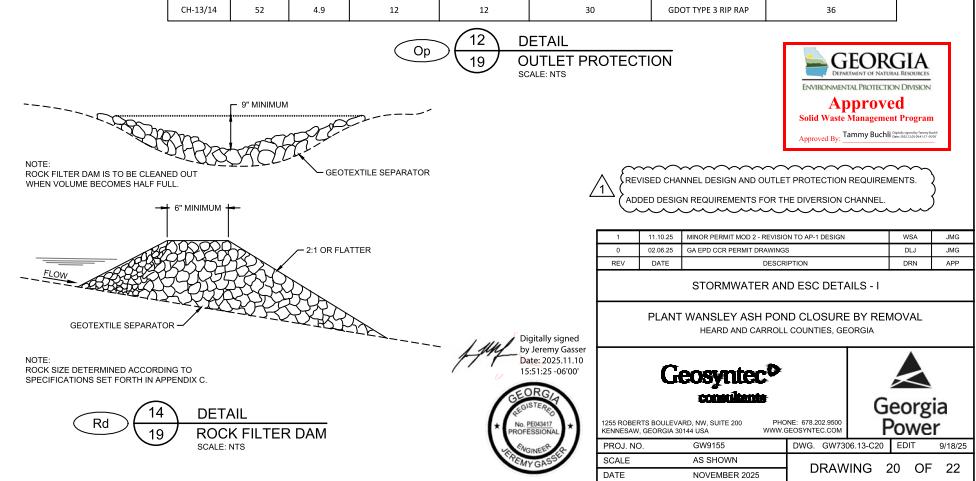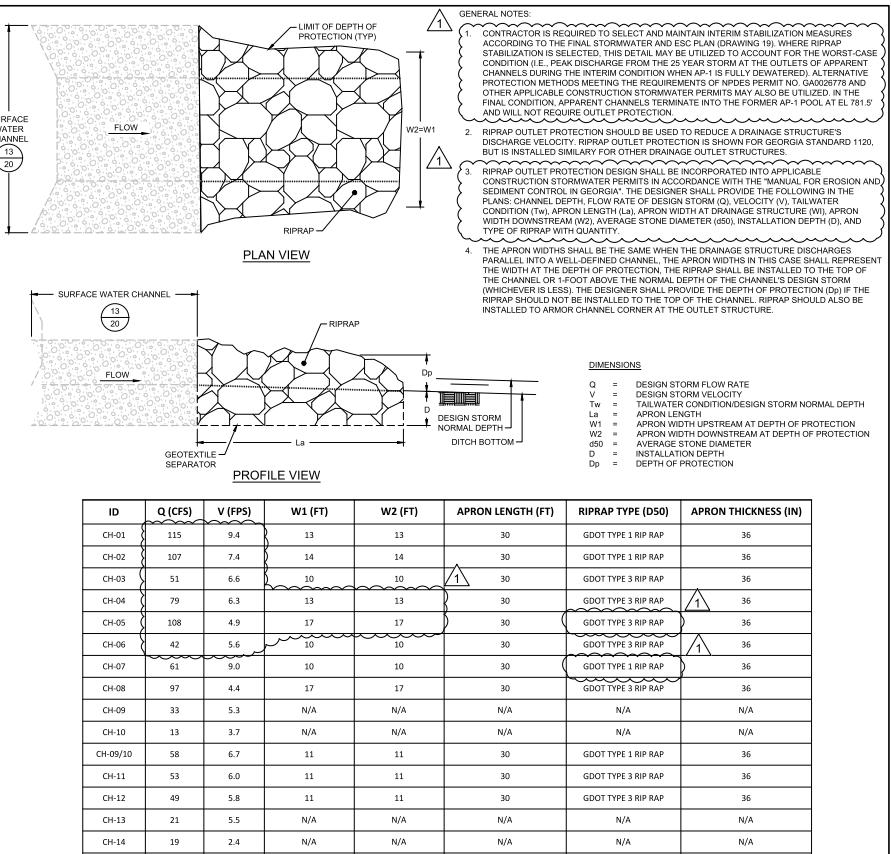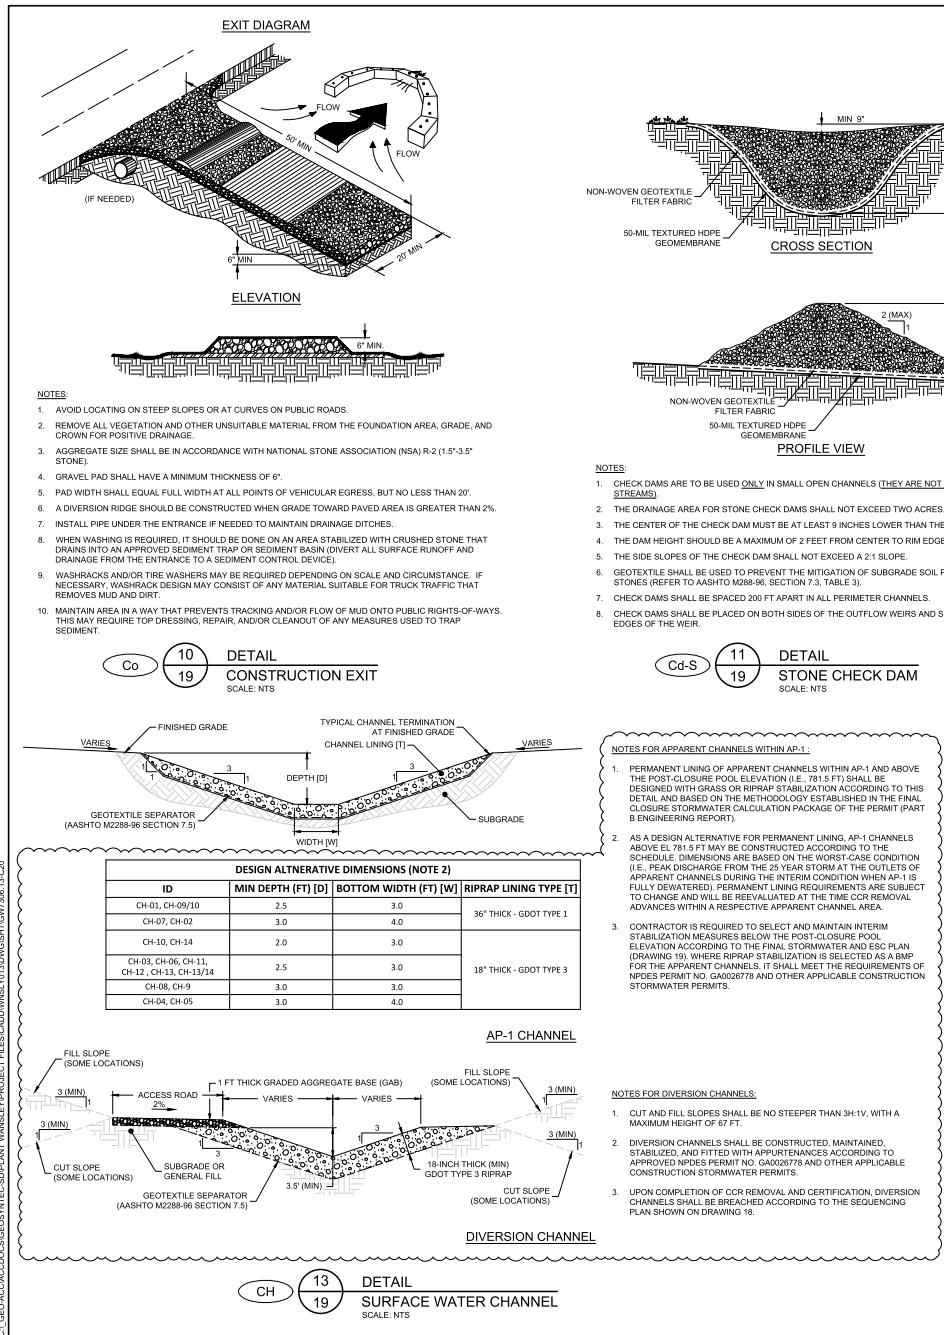

PLANT, PLANTING RATE & PLANTING DATE FOR TEMPORARY SEEDING

BROADCAST		PLANTING DATES											
SPECIES	RATES	J	F	M	A	M	J	J	A	S	O	N	D
BARLEY ALONE	144 LBS/AC												
BARLEY IN MIXTURE	24 LBS/AC												
LESPEDIZA, ANNUAL ALONE	40 LBS/AC
LESPEDIZA, ANNUAL IN MIXTURE	10 LBS/AC
LOVEGRASS, WEEPING ALONE	4 LBS/AC
LOVEGRASS, WEEPING IN MIXTURE	2 LBS/AC
MILLET, BROWNTOP ALONE	40 LBS/AC
MILLET, BROWNTOP IN MIXTURE	10 LBS/AC
MILLET, PEARL ALONE	50 LBS/AC
OATS ALONE	128 LBS/AC
OATS IN MIXTURE	32 LBS/AC
RYE ALONE	168 LBS/AC
RYE IN MIXTURE	28 LBS/AC
RYEGRASS, ANNUAL ALONE	40 LBS/AC
SUDANGRASS ALONE	60 LBS/AC
TRITCALE ALONE	144 LBS/AC
TRITCALE IN MIXTURE	24 LBS/AC
WHEAT ALONE	180 LBS/AC
WHEAT WITH OTHER PERENNIALS	30 LBS/AC

SOLID LINES INDICATE OPTIMUM DATES. DOTTED LINES INDICATE PERMISSIBLE BUT MARGINAL DATES.

DEFINITION
THE ESTABLISHMENT OF TEMPORARY VEGETATION COVER WITH FAST GROWING SEEDINGS FOR SEASONAL PROTECTION ON DISTURBED OR DENUDED AREAS.

CONDITIONS
TEMPORARY VEGETATIVE MEASURES SHOULD BE COORDINATED WITH PERMANENT PLANTING PLANS. THE USE OF TEMPORARY SEEDING FOR STABILIZATION MOST TYPES OF TEMPORARY VEGETATION ARE IDEAL TO USE AS COMPANION CROPS UNTIL THE PERMANENT VEGETATION IS ESTABLISHED. NOTE: SOME SPECIES OF TEMPORARY VEGETATION ARE NOT APPROPRIATE FOR USE AS COMPANION CROPS BECAUSE OF THEIR TENDENCY TO OUT-COMPETE THE DESIRED SPECIES (E.G. ANNUAL RYEGRASS). CONTACT NATURAL RESOURCE CONSERVATION SERVICE OR THE LOCAL SOIL WATER CONSERVATION DISTRICT FOR MORE INFORMATION.

SPECIFICATIONS
GRADING AND SHAPING
EXCESSIVE WATER RUNOFF SHALL BE REDUCED BY PROPERLY DESIGNED AND INSTALLED EROSION CONTROL PRACTICES SUCH AS CLOSED DRAINS, DITCHES, DIKES, DIVERSIONS, SEDIMENT BARRIERS AND OTHERS. NO SHADING OR GRAZING IS REQUIRED IF SLOPES CAN BE STABILIZED BY HAND-SEEDED VEGETATION OR IF HYDRAULIC SEEDING EQUIPMENT IS TO BE USED.

SEEDBED PREPARATION
WHEN A HYDRAULIC SEEDER IS USED, SEEDBED PREPARATION IS NOT REQUIRED. WHEN USE CONVENTIONAL OR HAND-SEEDED, SEEDBED PREPARATION IS NOT REQUIRED IF THE SOIL MATERIAL IS LOOSE AND NOT SEALED BY RAINFALL. WHEN SOIL HAS BEEN SEALED BY RAINFALL OR CONSTRUCTION OF SMOOTH CUT SLOPES, THE SOIL SHALL BE PITTED, TRENCHED, OR OTHERWISE SCARIFIED TO PROVIDE A PLACE FOR SEED TO LEDGE AND GERMINATE.

LIME AND FERTILIZER
AGRICULTURAL LIME IS REQUIRED UNLESS SOIL TESTS INDICATE OTHERWISE. APPLY AGRICULTURAL LIME AT A RATE DETERMINED BY SOIL TEST FOR pH.

Ds2 15 19 DETAIL DISTURBED AREA STABILIZATION (WITH TEMPORARY SEEDING)
SOURCE: GSWCC

Tac 17 19 DETAIL TACKIFIER
SCALE: NTS
SOURCE: GSWCC

REvised Stormwater Pond Requirements to Reflect the Replacement of the Previous Non-Contact Water Containment System (i.e. a network of non-contact water sums/pumps) (WSP)

TYPICAL INSTALLATION GUIDELINES FOR ROLLED EROSION CONTROL PRODUCTS (RECP)

BLANKET AND MATTING CROSS-SECTIONS

SLOPE STABILIZATION
SLOPE STABILIZATION CAN BE APPLIED TO FLAT AREAS OR SLOPES WHERE THE EROSION HAZARD IS HIGH AND SLOPE PROTECTION IS NEEDED DURING THE ESTABLISHMENT OF VEGETATION.

PERFORMANCE EVALUATION
FOR A PROJECT TO BE APPROVED AS SLOPE STABILIZATION, THAT PRODUCE OR PRACTICE MUST HAVE A DOCUMENTED C-FACTOR OF 0.010, AS SPECIFIED BY GSWCC. FOR COMPLETE TEST PROCEDURES AND APPROVED PRODUCTS LIST PLEASE VISIT WWW.GSWCC.GEORGIA.GOV

PLANNING CONSIDERATIONS
CARE MUST BE TAKEN TO CHOOSE THE TYPE OF SLOPE STABILIZATION PRODUCT THAT IS APPROPRIATE FOR THE SPECIFIC NEEDS OF A PROJECT. TWO GENERAL TYPES OF SLOPE STABILIZATION PRODUCTS ARE DISCUSSED WITHIN THIS SPECIFICATION.

ROLLED EROSION CONTROL PRODUCTS (RECP)
A NATURAL FIBER BLANKET WITH SINGLE OR DOUBLE POLYPROPYLENE FIBERS HELD TOGETHER BY A SCOUR BINDING AGENT WHICH WORKS TO STABILIZE SOIL PARTICLES. PAPER MULCH SHOULD NOT BE USED FOR EROSION CONTROL.

HYDRAULIC EROSION CONTROL PRODUCTS (HECP)
HECP SHALL UTILIZE STRAW, COTTON, WOOL OR OTHER NATURAL BASED FIBERS HELD TOGETHER BY A SCOUR BINDING AGENT WHICH WORKS TO STABILIZE SOIL PARTICLES. PAPER MULCH SHOULD NOT BE USED FOR EROSION CONTROL.

CRITERIA
ROLLED EROSION CONTROL PRODUCTS (RECPs) AND HYDRAULIC EROSION CONTROL PRODUCTS (HECPs):

- INSTALLATION AND STAPLING OF RECPs AND APPLICATION RATES FOR THE HECPs SHALL CONFORM TO MANUFACTURER'S GUIDELINES
- PRODUCTS SHALL HAVE A MAXIMUM C-FACTOR (ASTM D6490) FOR THE FOLLOWING GRADE: C-FACTOR (MAX) 3.1 OR GREATER

SITE PREPARATION
AFTER THE SITE HAS BEEN SHAPED AND GRADED TO THE APPROVED DESIGN, PREPARE A FRAGGLE FLOOR. THE FRAGGLE FLOOR IS A GRID OF COATED METAL OR PLASTIC COATED WIRE ONE INCH IN DIAMETER, AND ANY FORGE MATERIAL THAT WILL PREVENT CONTACT OF THE SOIL STABILIZATION MAT WITH THE SOIL SURFACE. SURFACE MUST BE SMOOTH TO ENSURE PROPER SPACING OF BLANKETS OR MULCH TO THE SOLID SURFACE. IF NECESSARY, REDIRECT ANY RUNOFF FROM THE DITCH OR SLOPE DURING INSTALLATION.

Detail Slope Protection
Slope Protection
SCALE: NTS
SOURCE: GSWCC

METHODS AND MATERIALS

A. TEMPORARY METHODS

MULCHES SEE STANDARD D4 - DISTURBED AREA STABILIZATION (WITH MULCHING ONLY). SYNTHETIC RESINS MAY BE USED INSTEAD OF ASPHALT TO BIND MULCH MATERIAL. REFER TO SPECIFICATION TAG-TACKIFIERS IN THE MANUAL FOR EROSION AND SEDIMENT CONTROL IN GEORGIA, LATEST EDITION. RESINS SUCH AS CURASOL OR TERRATAK SHOULD BE USED ACCORDING TO MANUFACTURER'S RECOMMENDATIONS.

VEGETATIVE COVER. REFER TO Ds2 - DISTURBED AREA STABILIZATION (WITH TEMPORARY SEEDING).

B. PERMANENT METHODS

PERMANENT VEGETATION, SEE SPECIFICATION D3-3 - DISTURBED AREA STABILIZATION (WITH PERMANENT VEGETATION) IN THE MANUAL FOR EROSION AND SEDIMENT CONTROL IN GEORGIA, LATEST EDITION. EXISTING TREES AND LARGE SHRUBS MAY AFFORD VALUABLE PROTECTION IF LEFT IN PLACE.

TOPSOILING THIS ENTAILS COVERING THE SURFACE WITH LESS EROSIONAL SOIL MATERIAL. SEE SPECIFICATION TP - TOPSOILING IN THE MANUAL FOR EROSION AND SEDIMENT CONTROL IN GEORGIA, LATEST EDITION.

CONDITIONS
THIS PRACTICE IS APPLICABLE TO AREAS SUBJECT TO SURFACE AND AIR MOVEMENT OF DUST WHERE ON AND OFF-SITE DAMAGE MAY OCCUR WITHOUT TREATMENT.

Du 18 19 DETAIL STORMWATER PONDS
SCALE: NTS
SOURCE: GSWCC

Du 19 19 DETAIL DUST CONTROL ON DISTURBED AREAS
SCALE: NTS
SOURCE: GSWCC

THE FOLLOWING MEASURES SHALL BE IMPLEMENTED TO MINIMIZE CCR FROM BECOMING AIRBORNE AT THE FACILITY, INCLUDING CCR FUGITIVE DUST ORIGINATING FROM CCR UNITS, ROADS, AND OTHER CCR MANAGEMENT AND MATERIAL HANDLING ACTIVITIES.

- FUGITIVE DUST ORIGINATING FROM THE CLOSURE OF AP-1 WILL BE CONTROLLED USING WATER SUPPRESSION, COMPACTION, SYNTHETIC OR VEGETATIVE COVERS, OR DUST SUPPRESSION AGENTS.
- CCR THAT IS TRANSPORTED VIA TRUCK TO THE EXISTING ON SITE LANDFILL WILL BE CONDITIONED TO APPROPRIATE MOISTURE CONTENT TO REDUCE THE POTENTIAL FOR FUGITIVE DUST.
- WATER SUPPRESSION WILL BE USED, AS NEEDED, TO CONTROL FUGITIVE DUST ON FACILITY ROADS USED TO TRANSPORT CCR AND OTHER CCR MANAGEMENT AREAS.
- SPEED LIMITS WILL BE USED TO REDUCE THE POTENTIAL FOR FUGITIVE DUST.
- TRUCKS USED TO TRANSPORT CCR WILL BE FILLED TO OR UNDER CAPACITY TO REDUCE THE POTENTIAL FOR MATERIAL SPILLAGE.

GPC PERSONNEL AND/OR THEIR CONTRACTORS SHALL PERFORM VISUAL OBSERVATIONS OF AP-1 AND SURROUNDING AREAS. APPROPRIATE CORRECTIVE ACTION FOR FUGITIVE DUST WILL BE IMPLEMENTED AS NECESSARY. LOGS WILL BE USED TO RECORD THE USE OF WATER SUPPRESSION. AMENDMENTS TO THE FUGITIVE DUST CONTROL PLAN MAY BE MADE AT ANY TIME AS REQUIRED DUE TO A CHANGE IN CONDITIONS THAT WOULD AFFECT THE IN-PLACE PLAN. ALL REVISIONS TO THE FUGITIVE DUST CONTROL PLAN WILL BE DOCUMENTED AND PLACED IN THE OPERATING RECORD. REFER TO THE CLOSURE PLAN SECTION 6.3.

1 31-10-25 MINOR PERMIT MOD-2: Revision to AP-1 Design
0 02/05/25 GA EPD COR PERMIT DRAWINGS
REV DATE DESCRIPTION DRN APP

STORMWATER AND ESC DETAILS - II

PLANT WANSLEY ASH POND CLOSURE BY REMOVAL
HEAD AND CARROLL COUNTIES, GEORGIA

Geosyntec
REGISTERED PROFESSIONAL ENGINEER
JEREMY GASSER

Georgia Power

125 ROBERTS BOULEVARD, NW, SUITE 200
KENNESAW, GEORGIA 30144 USA
PHONE: 678.522.9500
WWW.GEOSYNTEC.COM

PROJ. NO. GW9155 DWG. GW7306-13-C21 EDIT 9/16/25
SCALE AS SHOWN DRAWING 21 OF 22
DATE NOVEMBER 2025

